

Lynn Institute

Abbreviations

Ø	diameter
c	centerline
A	ampere
A/C	air conditioning
AV	audio/visual
ADA	Americans with Disabilities Act
AF	above finished floor
alt	alternate
amp	ampere
approx	approximately
C	conduit
CKT	circuit
cl	ceiling
clg	clear
cnstr	construction
d	depth/deep
dia	diameter
dmm	dimension
DN	down
DW	dishwasher
E	existing (device or fixture to remain)
Elev	elevator
eq	equal
EW	electric water cooler
EW/H	electric water heater
F.D.	floor drain
F.E.	fire extinguisher
F/A	fire alarm
FEC	fire extinguisher cabinet
FHC	fire hose connection
fin	finish or finished
ga	gauge
gyp	gypsum board
hd	height/high
H.C.	hollow core
H	hollow metal
HVAC	heating, ventilating, air conditioning
I.F.	inside face
I.T.	information technology
Jan.	janitor(s)/janitorial
J-Box	junction box
L	length/long
mfd.	manufactured
mil	mil
min	minimum or minute (per context)
mm	millimeter
mw	microwave
N	new (device or fixture)
NIC	not in contract
nom	nominal
NTS	not to scale
O.C.	on center
O.H.	opposite hand
Occ.	occupants
on	on
Pl	plastic laminate
R	relocated (device or fixture)
R.O.	rough opening
Re:	refer to:
reqd.	required
R/A	return air
RA	room
R/SF	Rentable Square Feet
S.C.	solid core
S.M.	surface mounted
S.Stl.	stainless steel
S/A	supply air
SDT	static dissipative tile
SF	square feet
sim	similar
sq yd	square yard
std	standard
T.O.	throughout
T.BD	to be determined
th	thickness/thick
typ	typical
U.L.	Underwriters Laboratory
UNO	unless noted otherwise
USF	Usable Square Feet
V	voit
VCT	vinyl composition tile
VIF	verify in field
w	width/wide
W.S.	work station
w/	with
WC	wallcovering
WF	water fountain

Reference Symbols

1	Keyed Note
CL	Center Line
PL	Detail Reference
PL	Detail Number Sheet
PL	Reference
PL	Section Reference
PL	Section Number Sheet
PL	Reference
PL	Elevation Reference
PL	Elevation Number Sheet
PL	Reference
PL	Door Reference Tag, refer to Door Schedule
PL	Plastic Laminate Reference, Refer to Finish Treatment Schedule
PL	Wall Treatment Reference, Refer to Finish Treatment Schedule
PL	Floor Treatments Reference, Refer to Finish Treatment Schedule

General Notes

- GENERAL STANDARDS:** All work defined herein shall be constructed in accordance with the approved drawings and specifications and shall be in compliance with all applicable codes, ordinances, and regulations. Work performed in the shop or on-site shall be performed by mechanics, craftsmen and workers skilled and experienced in the fabrication and installation of the work involved. The work shall be performed in accordance with the best established practices of the industry standard for the trade involved.
- FEES AND PERMITS:** The General Contractor shall obtain all licenses and permits required by the jurisdiction and/or its agencies, not withstanding licenses and permits that may be required of respective subcontractors. The cost of said licenses and permits shall be incurred by that contractor responsible for the procurement of same.
- DRAWINGS AND SPECIFICATIONS:** The General Contractor shall maintain a complete and current set of project documents, drawings and specifications on the job site at all times and shall include all approved shop drawings and submittals. The General Contractor shall be responsible for distribution of adequate copies of all drawings and specifications to all applicable trades. Upon completion of the work, the General Contractor shall submit one complete set of red-lined drawings to TPS indicating any and all changes, omissions, or modifications made.
- ENGINEERED DRAWINGS:** Refer to structural, mechanical, electrical and plumbing drawings (when provided) for detailed design of the structural, mechanical, electrical, and plumbing systems. Portions of this work may be shown on the architectural drawings for reference to, and in coordination with, other work.
 - When indicated on the drawings, the General Contractor shall provide engineering drawings on a design/build basis for mechanical systems, electrical systems and plumbing. Provide one copy of all drawings to TPS for review prior to construction.
 - The General Contractor is responsible for required permits and approvals necessary for the work as described above. Precedence: the architectural drawings shall precede the engineered drawings (if provided) relative to device and fixture locations.
- OMISSIONS AND DISCREPANCIES:** The General Contractor shall field verify all conditions and dimensions shown on the drawings, and shall notify TPS of any discrepancies, omissions or conflicts prior to commencing with construction.
- MATERIALS:** Unless otherwise specified, all materials shall be new, unused, and in compliance with the specifications set forth in these documents. All materials used throughout the project shall be of the same brand name and quality for consistency. All materials must meet the ASTM and ANSI standards and be in compliance with all applicable codes, ordinances and regulations. Unless authorized in writing by the owner or its representative, no existing fixture, device or component shall be removed from adjacent areas or buildings to facilitate this project.
- MATERIAL INVENTORY:** Upon award of the construction contract, and when building materials are stocked and made available for the project, coordinate with the Building Representative for purchase of materials. All materials shall be bid as new. Do not assume use of materials from building stock.
- SUBMITTALS/DEVIATIONS:** No substitutions, variations and deviations from these documents shall be permitted without prior approval of TPS, the Building and/or Tenant's Representative. Application for any substitutions and/or variations shall be submitted to TPS by the General Contractor for approval. Application shall be made in writing accompanied with product specifications and/or samples. Five complete sets of submittals are required.
- SHOP DRAWINGS:** When requested on the drawings, the General Contractor shall prepare, review, approve and submit shop drawings to TPS. The General Contractor shall check and coordinate all product data and samples and verify all materials, field measurements and related field construction criteria contained in such and shall conform to the requirements of the work, and the contract documents. Five complete sets of submittals are required.
 - Subcontractors shall coordinate all installations, schedules, locations, decisions, sizes, and resolve all conflicts and interferences of their trade with other trades.
 - Subcontractors shall be responsible for coordinating routes of water, sprinkler, mechanical and electrical services.
 - Light fixtures/ fittings, diffusers/ ducts, sprinkler heads, etc. as depicted on the drawings, both above and below the ceiling, which conflict with any existing services shall be reported immediately when it becomes apparent that a conflict will prevail. All costs incurred by the General Contractor or other subcontractors for failure to report conflicts immediately shall be borne by the contractor.
- TENANT VENDORS:** The General Contractor shall be responsible for coordinating with the Tenant and the Tenant's vendors for scheduling and providing access to the space for the Tenant's movable partition systems, communications/ data processing systems, security systems, and audio/ video systems.
- INSPECTIONS:** The General Contractor shall permit and facilitate inspection, by the owner and the architect or their representatives, during the course of construction.
- TENANT RESPONSIBILITIES:** Unless specified otherwise in the contract documents, the following items are not a part of these drawings and if so desired shall be provided by the Tenant:
 - Furnishings, files and accessories
 - Portable or movable office partitions
 - Racks, bins, prefabricated shelving systems
 - Coffee makers, microwaves, refrigerators, vending machines
 - Copy/ fax equipment and computer equipment
 - Security systems, sound systems, intercom systems
 - Telephone equipment including wiring/cabling
 - Clocks, time clocks
 - Connection of all equipment, furnishings and panels
 - Moving or relocation of Tenant's furnishings, fixtures, and equipment
 - Schedule and coordination of Tenant's vendors
- PROTECTION:** The General Contractor shall protect the work, adjacent space/property, common areas, public utilities, and the public, and shall be responsible for any damage or injury due to neglect. Protection shall include but not be limited to the following:
 - Draw window coverings and wrap or bag with plastic for dust protection.
 - Provide plywood or masonite floor protection with tape sealed joints completely along routes used for delivery and removal of materials.
 - Provide and/or use protective pads at designated freight elevator cab walls and around openings.
 - When necessary, x-ray the floor slab to confirm locations of objects embedded in the concrete prior to making any penetrations in the slab.
- DAMAGES:** Should the General Contractor or any associated subcontractor cause damage to any adjacent work or structure while completing or cleaning current construction, that contractor or subcontractor shall be responsible for repair or replacement of said damaged fixture or structure.
- INSURANCE:** The General Contractor shall purchase and maintain certifications of insurance with respect to workers compensation, public liability and property damage for the limits as required by law. The certificates shall name the client and Tenant Planning Services, Inc. as additional insured. The General Contractor and subcontractors performing work on-site shall conform to the Landlord's insurance requirements.
- GUARANTEE/WARRANTY:** The General Contractor shall enforce a specific and unconditional warranty on all materials, workmanship, equipment, fixtures and sub-assemblies subject to normal use and maintenance for a period not to exceed one (1) year from date of substantial completion. Said warranty shall not be exclusive of implied or specific warranties enforced by manufacturers and/or suppliers of aforementioned materials, equipment, fixtures and/or sub-assemblies.
- SECURITY:** The General Contractor shall be responsible for securing and controlling access to the job site during construction and for disconnecting power and lighting when not in use.
- INTERRUPTION OF SERVICES:** All work requiring dangerous, toxic, or noisy operations and installations which might affect the operation of the existing tenants shall be performed during non-business hours. Coordinate with Building Management.
- HAZARDOUS MATERIALS:** TPS has no knowledge of, and shall not be held liable for, any asbestos or other hazardous materials on the project site. Prior to commencing with the work on-site, it shall be the responsibility of the General Contractor to inspect and make a good faith effort to identify the presence of asbestos, toxic or other hazardous materials. Should hazardous materials be discovered at any time before or during construction, stop the work immediately and report to the Building Management for further instructions before proceeding.
- BUILDING RULES AND REGULATIONS:** The General Contractor shall be responsible for consulting with the Building Representative for rules and regulations governing the building and pertaining to deliveries, removal of materials and debris, use of building facilities, noise restrictions, protection of existing conditions, hours of operation, building access, etc.


- CLEANING:** The General Contractor shall clean the job site and adjoining areas during construction and upon completion. Cleaning includes, but is not limited to, vacuuming carpets, wet mopping floor tile and other resilient flooring, cleaning all glass, including interior side of exterior glazing, dusting and wiping clean all lint and sealed areas on doors, millwork, window coverings, baseboard, etc.; removing all construction debris, scraps, materials and equipment; and water seal all marble, granite and ceramic tile and grout.
- FIRE RESISTIVE STANDARDS:** Conform to the following:
 - Materials and assemblies required to be fire resistive shall bear a label affixed to the product indicating fire resistive rating and testing agency with approved test certification number.
 - All blocking and nailer strips used in connection with fire resistive partitions shall be fire retardant wood as defined by the Building Code.
 - All concealed wood shall be treated with an approved fire retardant.
 - Fire ratings of existing materials and/or systems which may become damaged or modified due to the work shall be maintained with a fire rating equal to or greater than the existing rating.
 - All pipe and conduit penetrations in fire rated partitions and floors/ceilings shall be sealed in accordance with a U.L. listed "fire stop" compatible with the material and fire rating required.
 - Flame-spread: minimum ratings for flame spread shall be as follows:
 - Enclosed vertical exit ways: Class I (0-25 F.S.I.)
 - Other exit ways: Class II (26-75 F.S.I.)
 - Rooms or areas: Class III (76-200 F.S.I.)
- ARCHITECTURAL WOODWORK:** Provide architectural woodwork as specified on the drawings. The "quality standards" of the architectural woodwork institute shall apply and hereby made a part of this document. All prefabricated work shall be economy grade. All other work shall be custom grade as defined by the quality standards of the AWI, unless noted otherwise.
- SURFACE PREPARATION:** Inspect existing conditions of all floor and wall surfaces for voids, holes, cracks, and other damages and make repairs. Grind and/or fill imperfections, fill holes, cracks, and other damages prior to installation. The General Contractor shall provide budget for floor prep as required. The General Contractor shall provide RH moisture testing for any concrete locations less than one year old and for all slab on grade (regardless of age) locations.
- CLEARANCES:** The General Contractor shall verify ceiling height and clearances above ceiling to the underside of structure above for installation of ductwork and diffusers; conduits and junction boxes; fire sprinkler pipes and heads; and light fixtures. All work shall be coordinated by all trades to avoid interference with methods of installation. Notify TPS of conflicts immediately and prior to commencing with construction.
- FIRE SPRINKLER SYSTEM:** In buildings equipped with fire sprinkler systems, furnish all labor, materials, fixtures, trim, equipment and services necessary for the installation of a complete and properly functioning fire sprinkler system. All work shall conform to the following:
 - Relocate and/or add fire sprinkler heads as required for new conditions as shown on the drawings.
 - Rework and/or add to existing pipes, fittings, hangers and support as necessary for new sprinkler head locations.
 - Design standards, materials and workmanship shall be compatible with existing conditions.
 - Install new sprinkler head locations in the center of the ceiling board or section and symmetrical throughout rooms and open areas.
- FIRE EXTINGUISHERS:** Provide portable, wall mounted fire extinguishers every 75' of exit travel distance throughout limit of construction or as required by the local fire department or life safety department. Portable fire extinguishers shall comply with uniform fire code standard 10-1.
- PLUMBING SYSTEM:** Furnish all labor, materials, fixtures, trim, equipment and services necessary for the installation of a complete and properly functioning plumbing system. All work shall conform to the following:
 - Refer to drawings for specific information pertaining to materials, fixtures, etc. scheduled as new and not contained herein.
 - Re-use existing plumbing piping and/or fixtures and components where possible. Inspect and confirm existing conditions are within specifications.
 - New materials shall be compatible with existing conditions, where possible.
 - Provide fixtures with all anchors, supports, traps and trim, for a complete installation.
 - Provide stop valves on all hot and cold water connections to fixtures.
 - Caulk around all fixtures with silicone based caulking compound.
 - Install all fixtures level and square with surrounding enclosure.
 - Install escutcheons for all pipes exposed to view passing through walls, floors and ceilings.
 - Provide templates or cut-outs of fixtures to the millwork subcontractor for cutting of doors, materials and workmanship shall be in compliance with state and local codes and ordinances, and the Americans with Disabilities Act (ADA).
- HVAC SYSTEM:** Furnish all labor, materials, fixtures, trim, equipment and services necessary for the installation of a complete and properly functioning HVAC system. All work shall conform to the following:
 - Standards: all standards and specifications established in the base building construction documents, or as evidenced in the existing conditions of construction shall govern, unless noted otherwise. All work shall be coordinated with the building maintenance manager. Refer to base building construction documents and specifications and existing conditions of system for equipment or materials not specified on the engineered drawings or contained herein. All materials and workmanship shall be in compliance with ASHRAE and SMACNA, state and local codes and ordinances, and the Americans with Disabilities Act (ADA).
 - Repairs and replacement: the contractor shall verify proper operation of existing ductwork for leaks and leaks. In the event that the contractor has observed system failure or defects, notify the Owner's construction manager immediately for further direction. For bid purposes, it shall be assumed that all HVAC equipment and associated ductwork and components are in proper operating condition. Repairs or replacement of materials and workmanship shall be performed as a separate portion of the work.
 - Abandoned equipment: all abandoned HVAC equipment and components within the area of construction shall be removed and all duct connections patched, capped and/or sealed.
 - Fire dampers shall be installed in all ducts which penetrate fire resistive partitions (one-hour rated and above). Fire dampers shall be 100% free area design.
 - Return air plenum: allow for transfer of air above Tenant demising partitions and spaces continuously and unobstructed to the building system return air shaft. Refer to engineered drawings (if provided) and detailed drawings with wall construction and opening size. During construction, the contractor shall place temporary filters over openings to the return air shaft. Remove filters upon completion of construction. Coordinate this work with the building maintenance manager.
 - Thermostats: locate thermostats so as not to interfere with the occupants' furnishings and systems, avoiding locations in the middle of walls, in traffic areas, in file/supply rooms, etc.
 - Air testing, adjusting, and balancing: adjust and balance terminal units, diffusers, dampers and registers to provide flow or to the design air flow and balance.
 - Work on the drawings (if provided). Balance work shall be performed in accordance with NEBB standards by a certified contractor. Submit a balancing report to TPS. Calibrate and adjust all thermostats.
- FIRE/SMOKE ALARM SYSTEMS:** In buildings equipped with fire and/or smoke alarm systems, furnish all labor, materials, fixtures, trim, equipment and services necessary for the installation of a complete and properly functioning fire/smoke alarm system. All work shall conform to the following:
 - Relocate and/or add fire alarms, smoke or heat detectors, strobe alarms, pull stations, remote indicator lights and other components of the system as required for new conditions of the space.
 - Re-work systems to be compatible with existing design standards and conditions.
 - Locations and specifications of alarms shall comply with the Americans with Disabilities Act (ADA).
- ELECTRICAL SYSTEM:** Furnish all labor, materials, fixtures, trim, equipment and services necessary for the installation of a complete and properly functioning electrical system. All work shall conform to the following:
 - Standards: all standards and specifications established in the base building construction documents, or as evidenced in the existing conditions of construction shall govern, unless noted otherwise. All work shall be coordinated with the building maintenance manager. Refer to base building construction documents and specifications and existing conditions of system for equipment or materials not specified on the engineered drawings or contained herein.
 - Repairs and replacement: the contractor shall verify proper operation of existing panels and switch-gear. In the event that the contractor has observed system failure or defects, notify the Owner's construction manager immediately for further direction. For bid purposes, it shall be assumed that all equipment and associated components are in proper operating condition. Repairs or replacement of materials and workmanship shall be performed as a separate portion of the work.
 - Panel: provide new typed panel circuit directory for each panel affected.

Definitions

- Approve:** where used in conjunction with TPS's or its consultant's response to submittals, requests, applications, inquiries, reports and claims by the contractor, the meaning of the term 'approved' will be held to the limitations of TPS's responsibilities and duties as specified in the general conditions and supplementary conditions. In no case will 'approved' by TPS be interpreted as an assurance to the contractor that the requirements of the contract documents have been fulfilled.
- Furnish:** except as otherwise defined in greater detail, the term 'furnish' is used to mean to supply and deliver to the project site, ready for unloading, unpacking, assembly and installation, etc. as applicable in each instance.
- Install:** except as otherwise defined in greater detail, the term 'install' is used to describe operations at the project site including unloading, unpacking, assembly, erection, placing, anchoring, applying, working to dimension, finish, curing protection, cleaning and similar operations, as applicable in each instance.
- Provide:** except as otherwise defined in greater detail, the term 'provide' means to furnish and install, complete and ready for the intended use as applicable in each instance.
- Products:** defined as products which must be substantially cut, shaped, worked, mixed, furnished, refined otherwise fabricated, processed, installed or applied to form units of work.
- Equipment:** defined as products with operational parts, regardless of whether motorized or manually operated, and particularly including connections (wiring, piping, etc.).
- Typical:** 'typical' or 'typ' means identical for all similar conditions.
- Similar:** 'similar' or 'sim' means comparable to characteristics for the condition noted. Verify dimensions used on this project.
- As required:** 'as required' means as required by regulatory requirements, by referenced standards, by existing conditions, by generally accepted construction practice, or by the contract documents.
- Align:** 'align' means accurately locate finish faces of materials in same plane.
- Relocate:** means to reuse a particular device, fixture, or item in a new location.
- Remain:** to continue unchanged.
- Reused:** to use again especially in a new way or in a new location.

Dimensional Conventions

- Except where directed to place items of the work at the "approximate location shown," do not scale drawings for dimensional information. All elements of the drawings may not be drawn to exact scale. All dimensions required are shown, or may be derived from those shown on the floor plans, elevations, sections, details, schedules, and specifications. See notes on this sheet and symbols on the 'Architectural Symbols' drawing for dimensions conventions used on this project.
- Do not scale drawings: dimensions shall govern, details shall govern over plans and elevations; large scale plans shall govern over small scale plans. Large scale details shall govern over small scale details. If unable to locate dimensions for any item of work, consult the Architect prior to construction.
- All heights are dimensioned from top of existing slab unless noted "AFF" (Above Finished Floor).

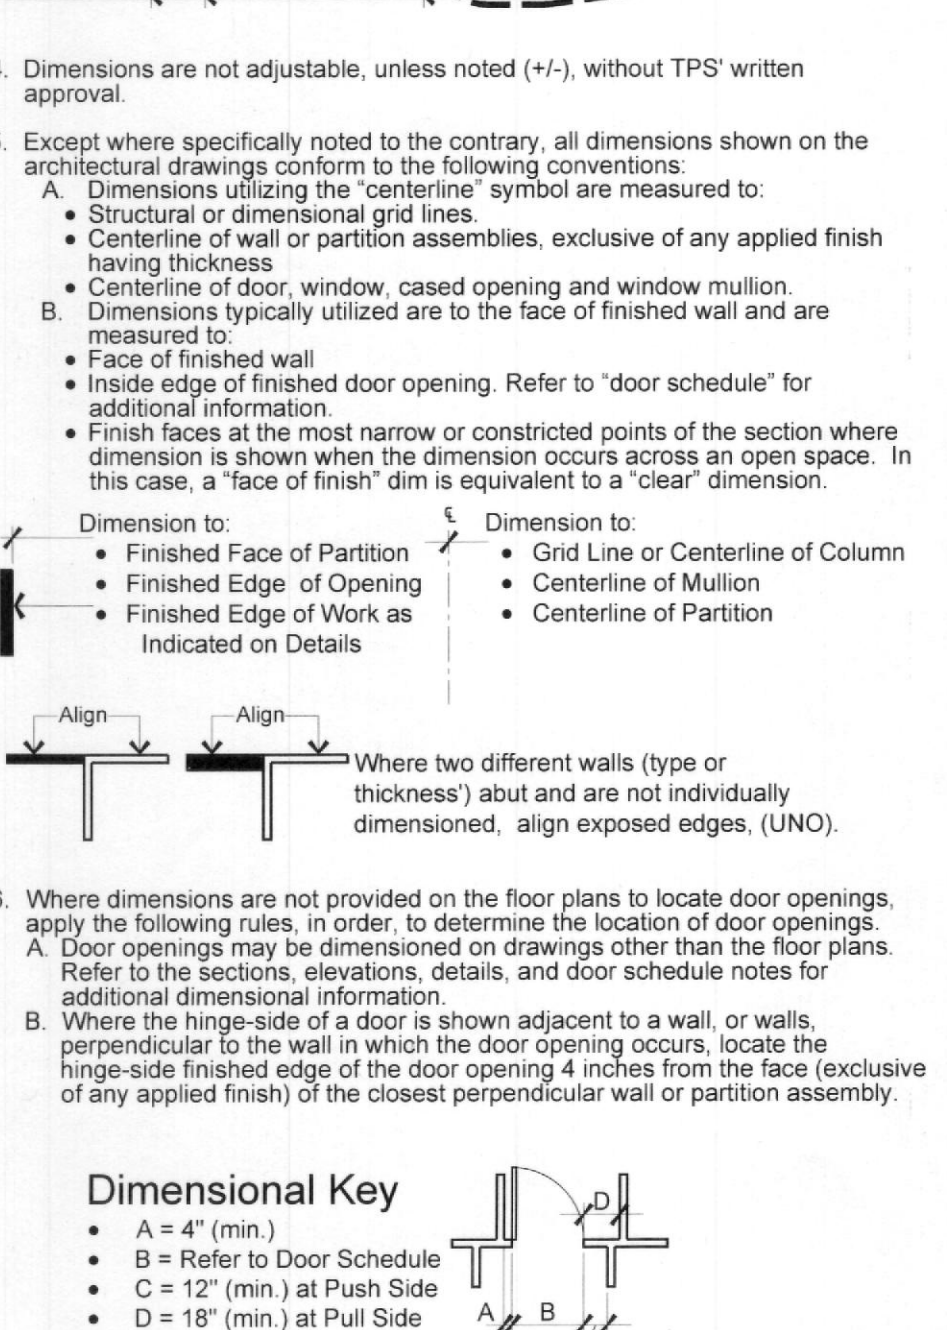


Project Alternates

- None
- Code violations that are found during inspection are required to be corrected. Permit issuance does not grant approval of a code violation.
- Failure to follow approved plans may result in an hourly fee to review the field changes for code compliance.
- Field Inspection consultation is available upon request. Call 303-739-7420 to request a consultation
- Provide U.L. Class **2A10BC** minimum rating fire extinguishers at a maximum 50'-0" travel distance prior to the Certificate of Occupancy issuance 2009 IFC Table 906.3(1) and 2007 NFPA 10

- SEPARATE FIRE SPRINKLER PERMIT REQUIRED**
 Due to the proposed work the general contractor is required to obtain the services of a fire sprinkler contractor to determine if a separate sprinkler permit is required. If it is determined that the spacing of the fire sprinkler heads is not in compliance, then a separate fire sprinkler permit is required. Approval of the documents is required prior to system installation or any request for inspection. A certificate of occupancy or final approval cannot be issued by the Building Division without this fire protection system. 2009 IFC, Section 105.7.1.
- SEPARATE FIRE ALARM PERMIT REQUIRED**
 Due to the proposed work the general contractor is required to obtain the services of a fire alarm contractor to determine if a separate alarm permit is required. If it is determined that the spacing of the fire alarm devices is not in compliance, then a separate fire alarm permit is required. Approval of the documents is required prior to system installation or any request for inspection. A certificate of occupancy or final approval cannot be issued by the Building Division without this fire protection system. 2009 IFC, Section 105.7.5.

Codes and Regulations

Building Profile			
City/ County: Aurora/ Arapahoe County			
Fire District: City of Aurora Fire Rescue			
Construction Classification: Type II-B			
Building Height / Levels: Unknown/ 4-stories			
Automatic Sprinklers Throughout			
Use and Occupancy			
Occupant Name: Lynn Institute			
Occupant Use: General Business Office			
Occupancy Classification: Business Group B			
Tenant Area			
(approx.) Useable SF: 1453			
Applicable Codes			
2015 IBC (International Building Code) with Amendments			
2015 IPC (International Plumbing Code)			
2015 IMC (International Mechanical Code)			
2015 IFC (International Fire Code)			
2015 IECC (International Energy Conservation Code)			
2017 NEC (National Electric Code)			
Interpretations			
Occupancy Load Analysis			
Suite	Function Per Table 1004.1.1	Floor Area (USF)	Floor Area (SF/Occ)
420	Business	1,453	~100 gross = 15
Means of Egress			
Required		Provided	
Egress Width:		min: 34" 34"	
Number of Exits:		min: 1 1	
Common Path of Travel:		max: 100' 7'	
Exit Access Travel Distance:		max: 300' 84'	

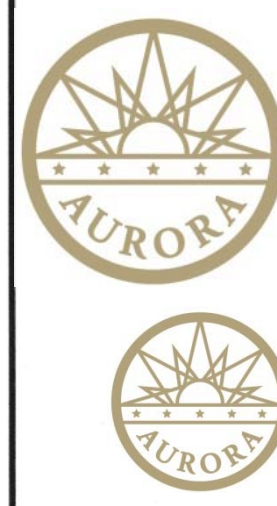

City of Aurora Building Division
 Project: **Lynn Institute**
 Address: **1411 S. Potomac St. #420**
 Occupancy Group: **IBC TYPE B**
 Construction Type: **IBC TYPE II-B SPK**
 RSN: **1268800**
 Permit: **18-1420046 TF**

City of Aurora Building Division
 Reviewed for Code Compliance
 Approved as Noted: **W. Griffin**
 Date: **Feb 21, 2018**
 2015 INTERNATIONAL CODES & 2017 NEC
 RSN: **1268800**
 Permit #: **18-1420046 TF**

Project Team


Designer/ Space Planner	
Tenant Planning Services 1660 Lincoln Street, Suite 100 Denver, Colorado 80264	
Contact: Gene Summers Phone: 303.861.4800 x108 Fax: 303.861.1621 email: gene@tps.design	
Building Representative	
CBRE 8390 East Crescent Parkway, Suite 300 Greenwood Village, Colorado 80111	
Contact: LiLa Walker Phone: 303.550.8319 Fax: 720.528.6333 email: lila.walker@cbre.com	
Mechanical Engineer	
Brian Seyferth & Associates 5583 Prince Street Littleton, Colorado 80125	
Contact: Brian Seyferth Phone: 303.797.7772 Fax: 303.797.7773 email: brian@seyferth.com	
Electrical Engineer	
Corey Electrical Engineering Inc. 7822 S. Wheeling Court, Ste. B Englewood, Colorado 80112	
Contact: Eric McCloskey Phone: 303.696.1257 email: emccloskey@coreyeng.com	

Drawing List

A0	Cover Sheet
A1	Demolition Plan Demolition Ceiling Plan Construction Plan Door Schedule Standard Interior Partition
A2.0	Reflected Ceiling Plan Power & Communications Plan Millwork & Finish Treatment Plan Finish Treatment Schedule
A2.1	Millwork Details
M1.0	Mechanical Plan
E.0	Electrical General Notes
E.1	Power Plan Lighting Plan Panel Schedules
E.2	One-Line Diagram Panel Schedules

TPS
TENANT PLANNING SERVICES INCORPORATED
 1660 Lincoln St, Ste. 100
 Denver, Colorado 80264
 (303) 861-4800
 fax (303) 861-1621
 www.TPS.design

1411 South Potomac
Potomac
 1411 South Potomac
 Aurora, CO 80012
Suite 420

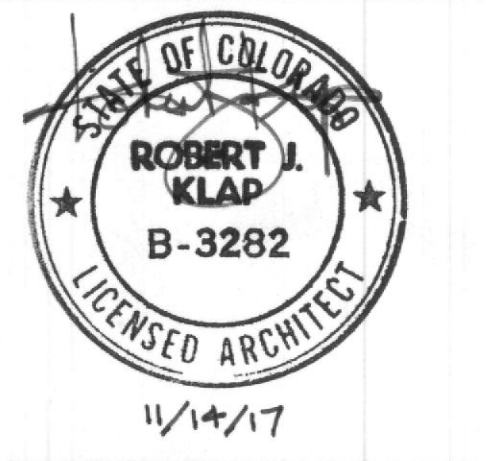

Lynn Institute

Dates of Record
 Project Start Date: 30 October 2017
 Issued On Issued For
 14 Nov 2017 Tenant Review & Approve
 426005 GBS
 14 Nov 2017 Construction

Approvals

Construction Document Approval	
Construction work shall not proceed until the Owner and the intended occupant have approved these Construction Documents. Approval by these parties shall be interpreted as approval of the drawings for content, scope of work, and all dimensions regulated by either party as being necessary to their operations, use of the space, furnishings, equipment installation, and any agreements between the Owner and the intended occupant.	
Construction and/or initiation of construction after return by the Owner from the intended occupant shall be interpreted by the Designer as approval in full of these Construction Documents by both the Owner and intended occupant.	
<input type="checkbox"/> Approved - No Exceptions Taken	
<input type="checkbox"/> Approved As Noted	
<input type="checkbox"/> Approved As Noted - Resubmit	
<input type="checkbox"/> Revise And Resubmit	
Signature	Date

Project # 426005 Proj Mgr GBS Designed by APC Drafted by TB Checked by GBS

A0

Wall Legend

Match existing construction. Field verify existing construction for extent of work and verify match to these partition types.



Refer to Engineering Drawings
for complete specifications

1	DEMO EXISTING CLERESTORY assembly. Prepare to infill existing partition.
2	TERMINATE PARTITION AT MULLION. Use Building Standard construction method. Refer to Detail.
3	NEW BACKBOARD. Provide 48" x 48" x 3/4" AD plywood board for telephone equipment. Mount bottom of board at 48" AFF. Paint to match wall.
4	NEW MILLWORK. Refer to Millwork Plan.
5	RELOCATE(D) MILLWORK. Remove millwork at "Old Location" and re-install at "New Location" as shown, reworking as necessary due to new configuration. Match existing construction and materials. Reuse of components which cannot be salvaged. Field verify existing conditions for extent of work. Refer to detail(s). Include backing in partition per Sheet A1 Plan Note 4.
6	Existing Clerestory assembly to remain. Clean and/or repair as necessary.
7	EXISTING RESTROOM to remain. Clean and/or repair fixtures/appliances as necessary. Field verify existing conditions for extent of work.
8	EXISTING MILLWORK & PLUMBING fixtures to remain. Clean and/or repair as necessary. Rework existing millwork as necessary due to demolition.
9	EXISTING MILLWORK fixtures to remain. Clean and/or repair.
10	Rework existing millwork as necessary for new layout. Refer to Construction Plan and Millwork Plan.
11	DEMO EXISTING MILLWORK. Return all millwork to Building Management. Patch/repair partitions as necessary.
12	SALVAGE DOORS. Remove existing door assemblies, and all associated components as shown and salvage as possible for re-use. Refer to Construction Plan.
13	REMOVE WALL COVERING THROUGHOUT Limit of Construction. Skim coat and prepare partitions for new finish treatments as indicated. Replace all face plates with new to match SUE Standard.
14	EXISTING VCT to remain. Clean and repair to "like new" conditions as possible. Demo existing rubber base trim.
15	Rework existing clerestory as necessary due to new layout.



<ul style="list-style-type: none"> - Hinges - Dust Proof Strike Plate - Silencers - Wall or Door Stop 	<p align="center"><u>Type "F"</u></p> <p align="center">Standard Flush Swinging Door</p>
<p>The General Contractor shall provide separate cost to label all keys (locksets). Coordinate with Tenant and Building Management on labeling numbers.</p>	

Structural plan review is limited to a general survey for code compliance. No review is implied nor was undertaken to verify structural adequacy.


3 Suite 420 Scale: 1/8" = 1'-0"

Project start date: 30 October 2017
dwg create date: 10/30/2017 3:37:09 PM
dwg save date: 11/14/2017 9:03:23 AM
p1 create date: 11/14/2017 9:03:23 AM

by: lmb to P: 426, 1411 South Potomac 426005, Lynn Institute Suite 420 drawings construction documents 426005c.dwg
by: Tim Berny input date: A2.0

Sheet A2.0 Plan Notes

- Refer to General Notes for additional requirements.
- The **SUSPENDED CEILING SYSTEM** is existing-to-remain throughout (unless noted otherwise), and shall be refurbished as follows:
 - Suspended grid and components shall be cleaned or touched-up where soiled or discolored. Repair and/or replace damaged members. Caulk fill all holes. Match existing conditions.
 - Clean, touch-up and/or replace soiled, discolored and damaged ceiling tiles. Replacement ceiling board shall be per specifications or building standards.
 - Inspect grid suspension system and adjust ceiling plane, if necessary. Provide additional support where necessary.
 - Replacement of materials, when required, shall occur consistently and completely in individual rooms and/or spaces for uniformity of appearance and aesthetics.
 - Installation of tiles shall be continuous over walls or individually cut-in at rooms or areas. Refer to drawings for specific requirements.
 - All tiles shall be seated tight, level and true within the grid system.
- CEILING HEIGHT:** 8'-0" AFF (UNO). Refer to construction details for ceiling construction and interface with partitions.
- FIXTURES AND DEVICES:** Provide and/or relocate light fixtures, switches, and controls indicated on the drawings.
 - Refer to Symbols Legend for fixture type and/or specification.
 - Install and support fixtures from the structure in accordance with the code.
 - Install all new light fixtures, sprinkler heads, diffusers, speakers, detectors, alarms, etc. in the center of the ceiling board or section and symmetrical throughout rooms and open areas, unless noted otherwise.
 - The contractor shall field verify all proposed locations of light fixtures prior to commencing construction and shall notify TPS of any discrepancies and/or conflicts with existing installations.
 - Existing fixtures scheduled to remain or be re-used shall be inspected and reworked, if necessary. Fixtures shall be cleaned, including lenses and lamps. Defective ballasts and other components shall be replaced. Match existing conditions.
 - All light fixtures, exit signs, and switch devices shown throughout are to be assumed existing to remain (unless noted otherwise).
 - 'R' indicates relocated fixture or device
 - 'N' indicates new fixture or device
- EXISTING FIRE SPRINKLER HEADS** mounted in the ceiling may be shown on the drawings, and are intended for informational purposes only. Drawings shall be submitted by the General Contractor for any new work required.
- MODIFY EXISTING FIRE SPRINKLER SYSTEM** on a **DESIGN-BUILD** basis. Conform to these drawings and documents and as required for obtaining a building permit. Refer to General Notes.
- PROVIDE ELECTRICAL POWER AND COMMUNICATIONS OUTLETS**, receptacles and devices indicated on the drawings.
 - Refer to symbols legend for device type and/or specification.
 - Install in locations as shown on the drawings.
 - All power and communications receptacles provided for general purposes shall be installed at 18" from the finished floor to the center of the device (unless noted otherwise).
 - Unless noted otherwise, all electrical power and communications outlets, receptacles and devices are dimensioned to the centerline of the device or pair of devices.
 - Confirm *all* box locations with Tenant prior to wiring.
 - All rectangular outlet boxes shall be installed with the long side in the horizontal position, except above counters and cabinets, or otherwise shown on the drawings.
 - All rectangular switch and control boxes for lighting and other devices shall be installed with the long side in the vertical position, recessed flush with the wall surface and at 48" above finished floor to the center of the control unit (unless noted otherwise).
 - Outlets shall not be installed back to back in sound insulated partition.
 - All outlets indicated to be installed in existing partitions or furred partitions or columns shall be cut-in or recessed flush with wall surface. Furr and/or remove sheathing, if necessary.
 10. All electrical power and communications outlets, receptacles and devices shown throughout are to be assumed existing to remain (unless noted otherwise).
 - 'R' indicates relocated outlet or device
 - 'N' indicates new fixture or device
- NEW WIRING DEVICES** shall be specification grade; 15 amp. For general application, 20 amp. or greater for dedicated circuits and as required by circuit load. Provide smooth nylon cover plates for all outlets and devices. Color: match existing
- COMMUNICATION/ DATA OUTLETS** shall conform to the following:
 - Communication/data outlets shall consist of an opening in the sheathing with a single gang plaster ring and pulwired with plastic bushing up through wall to the ceiling plenum.
 - When inaccessible by the method described above or when indicated on the drawings, include one (1) 3/4" conduit (min.) and 2" deep single gang box for outlet.
 - Where communications/data outlets are located in low height partitions or mounted in floors, a maximum of three (3) outlets shall be fed from one (1) 3/4" conduit.
 - All communication/data cables, plates, jacks, and final connections shall be provided under a separate contract by the Tenant. All materials shall be installed in compliance with all codes and ordinances and these documents. Cables and fittings installed above the ceiling in the return air plenum shall be rated and labeled for use in plenums. Cables shall be supported from the structure, independent of other support hangers.
- REMOVE ALL EXISTING FINISH TREATMENTS** including carpet, VCT, baseboard, and wall treatment and provide new finish treatments as specified throughout lease space (unless noted otherwise).
- COMMON AREA FINISH TREATMENTS:** Rework and/or add new finish treatments as necessary at all common areas of the building where construction occurs. All materials and workmanship shall match existing conditions (unless noted otherwise).
- RE-USE EXISTING WINDOW COVERINGS** at exterior glazing throughout. Wrap and bag all window coverings during construction.

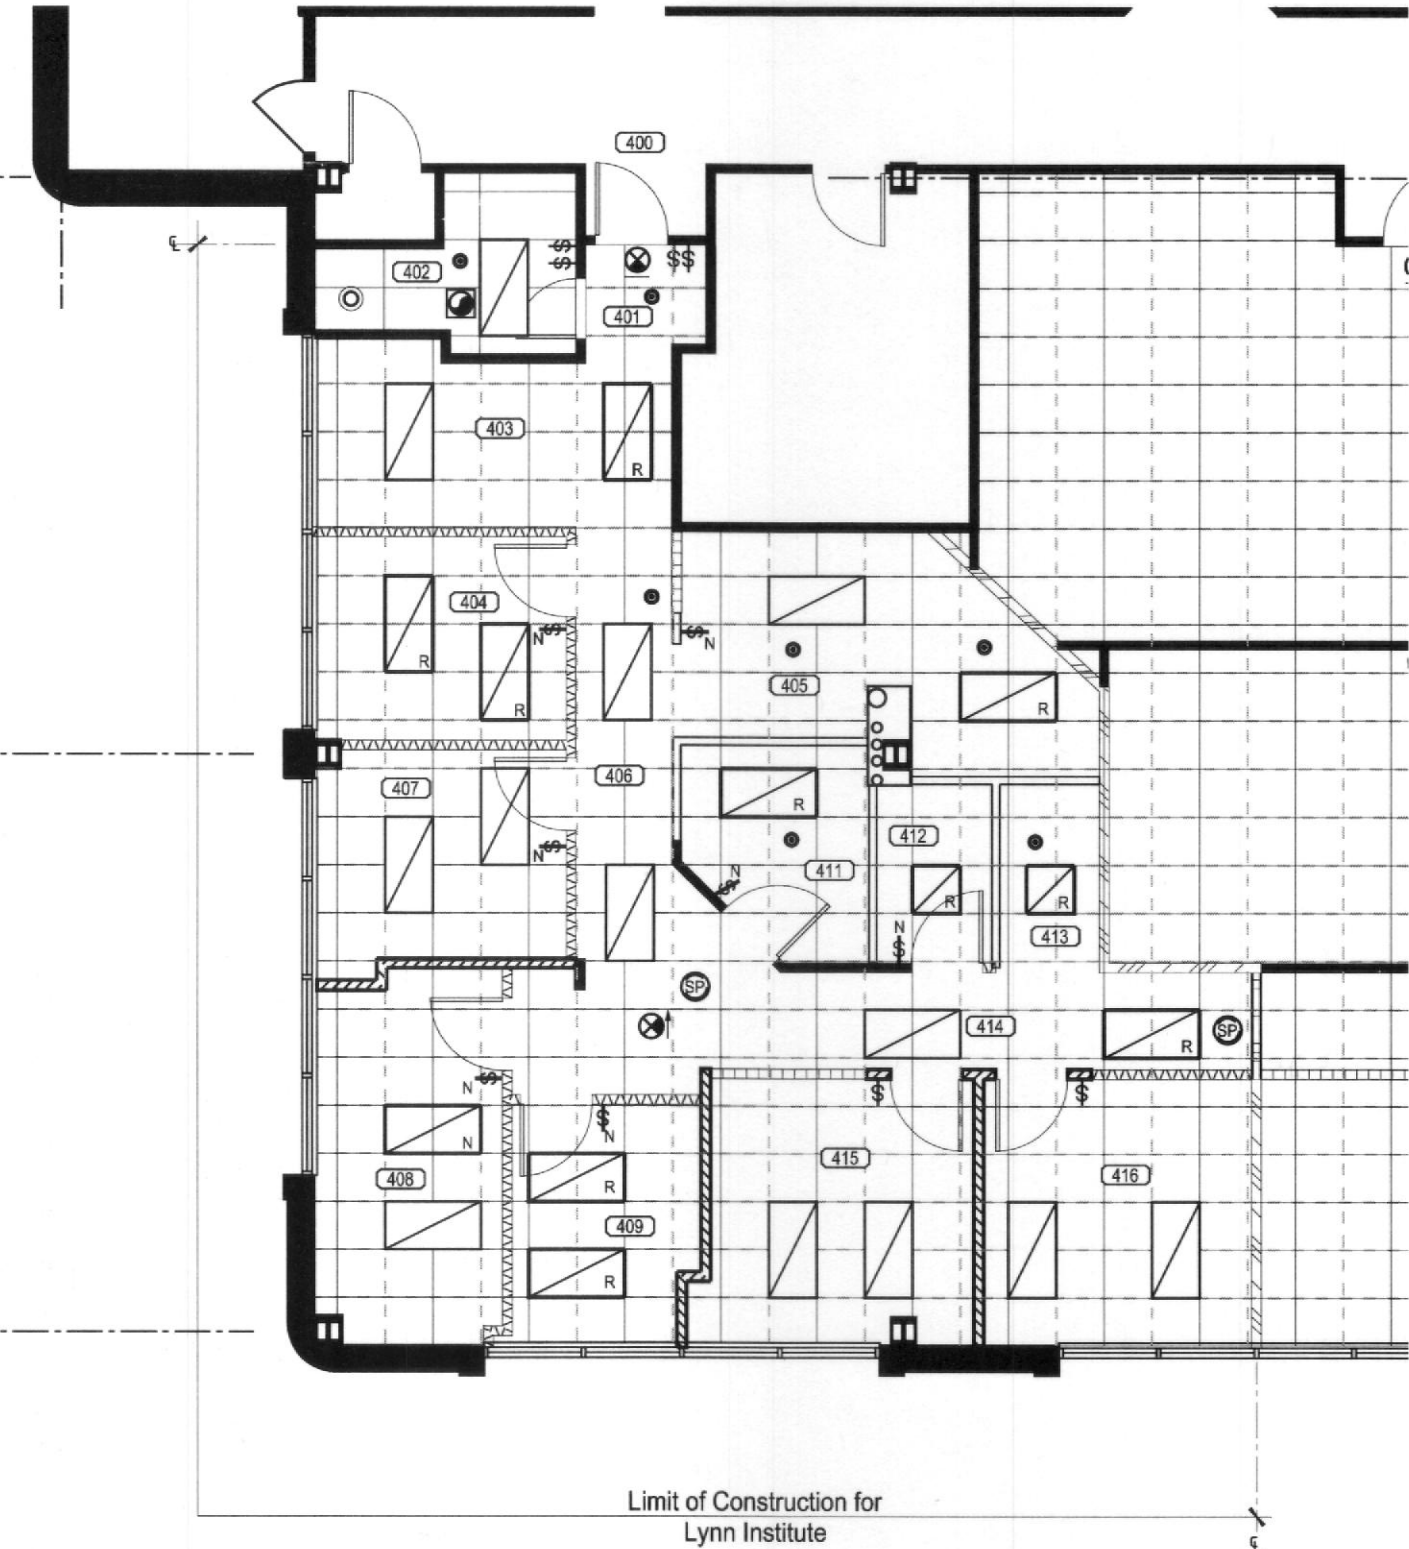


1 Reflected Ceiling Plan
Suite 420

Scale: 1/8" = 1'-0"




Finish Treatment Schedule					
NOTE: all surfaces must be clean, dull, and dry before coatings are applied. All product is assumed to be NEW, unless noted otherwise					
Material	Manufacturer	Style/ Line	Color	MARK	Remarks/Comments
Wallcovering	Primer	Sherwin-Williams ProMar 200 Zero VOC Primer	White	(Not Shown)	Primer for all new exposed gypsum board surfaces.
			White	--	Primer for new steel, galvanized or aluminum substrate
	Interior Paint	Sherwin-Williams ProMar 200 Zero VOC Interior Latex Eg-Shel B20-2600 Series	TBD	P1	Provide two (2) coats (minimum) at all new surfaces.
Millwork	Plastic Laminate	TBD	TBD	PL1	Countertops and Splashes, UNO
			TBD	PL2	Vertical Surfaces, UNO. Plastic laminate pattern shall run vertically on all surfaces, UNO. Confirm with Tenant Planning Services.
	TBD	TBD	TBD		
Floor covering	Broadloom patterned loop carpet	TBD	TBD	C1	Provide an allowance of \$22/sq.yd. material only (excluding tax and freight). Include schluter strip at flooring transition.
Base Trim	4" Coved Rubber Base Trim	TBD	TBD	RB1	Only coiled base trim approved (no 4" sections).

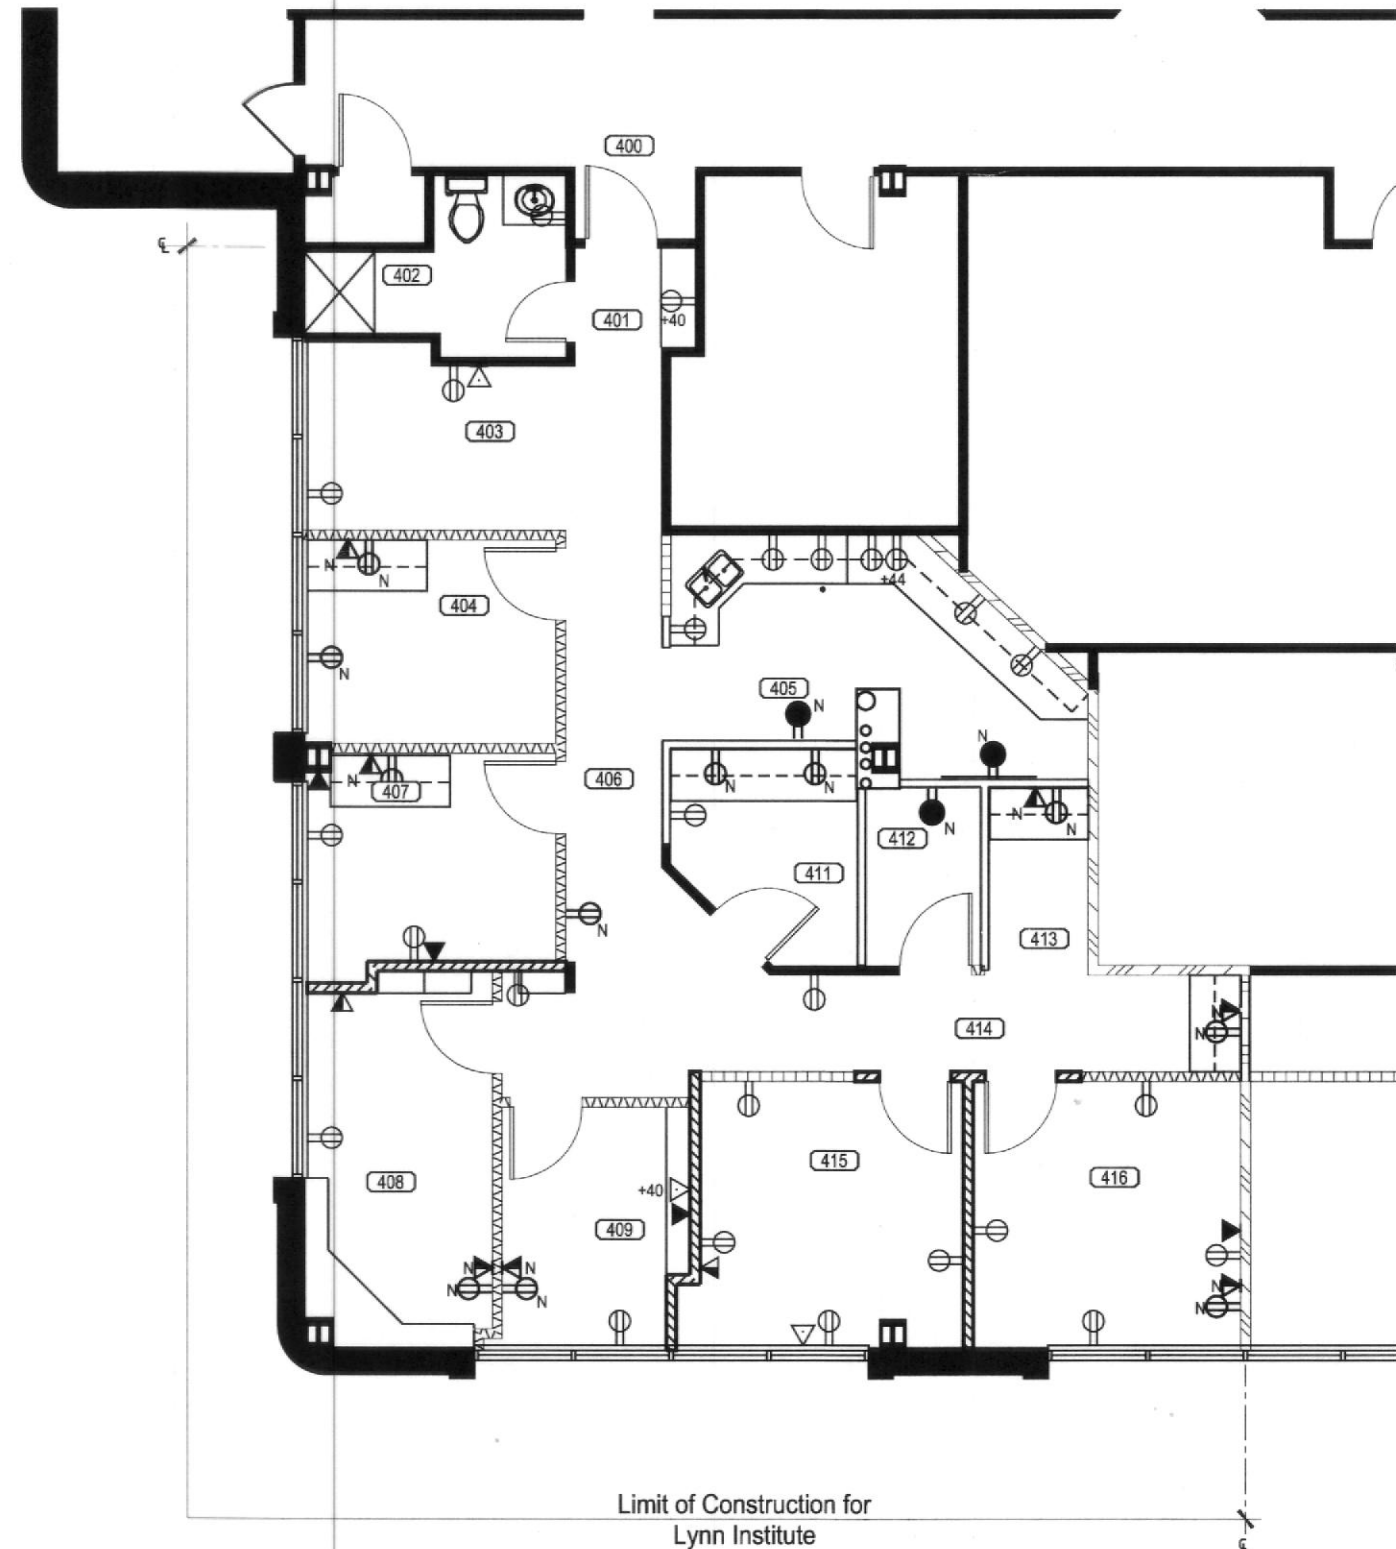


2 Power & Communications Plan
Suite 420

Scale: 1/8" = 1'-0"

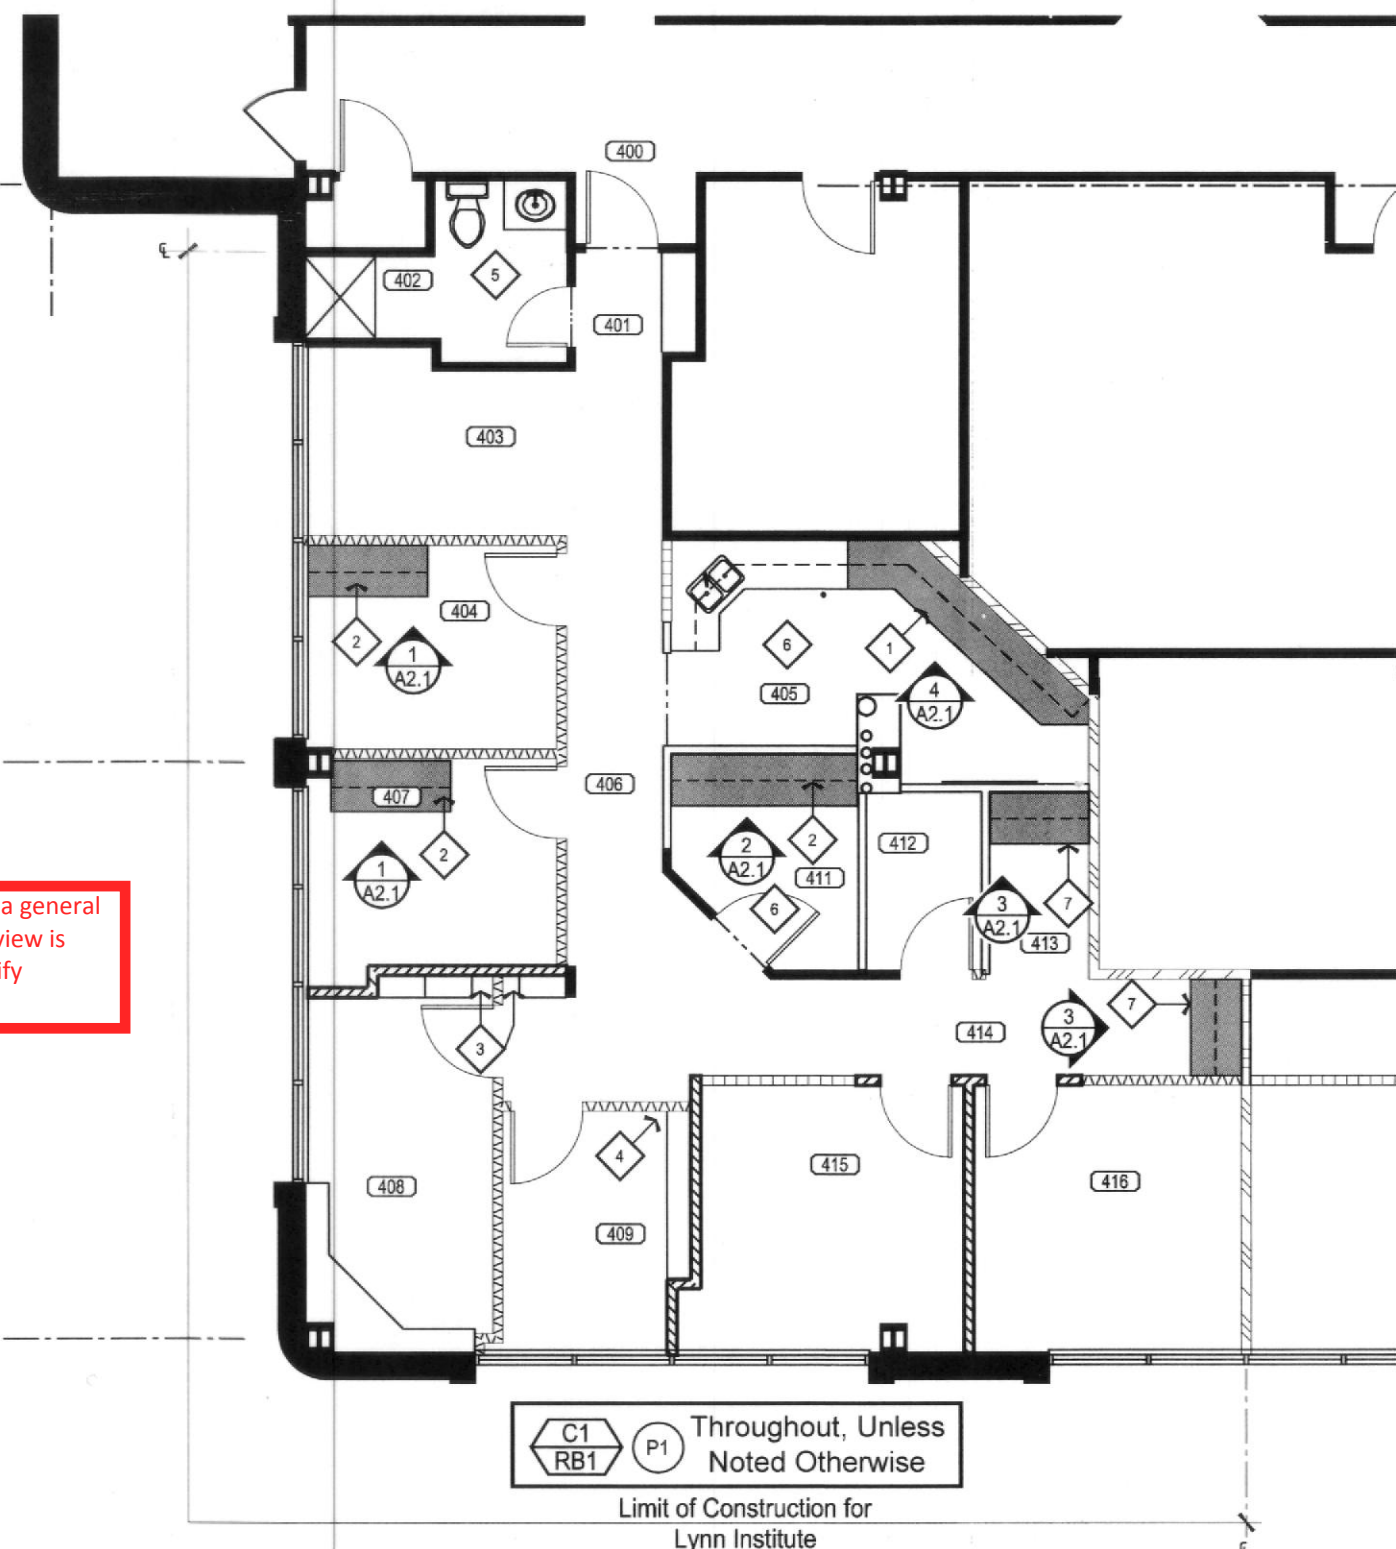


3 Millwork & Finish Treatment Plan
Suite 420

Scale: 1/8" = 1'-0"

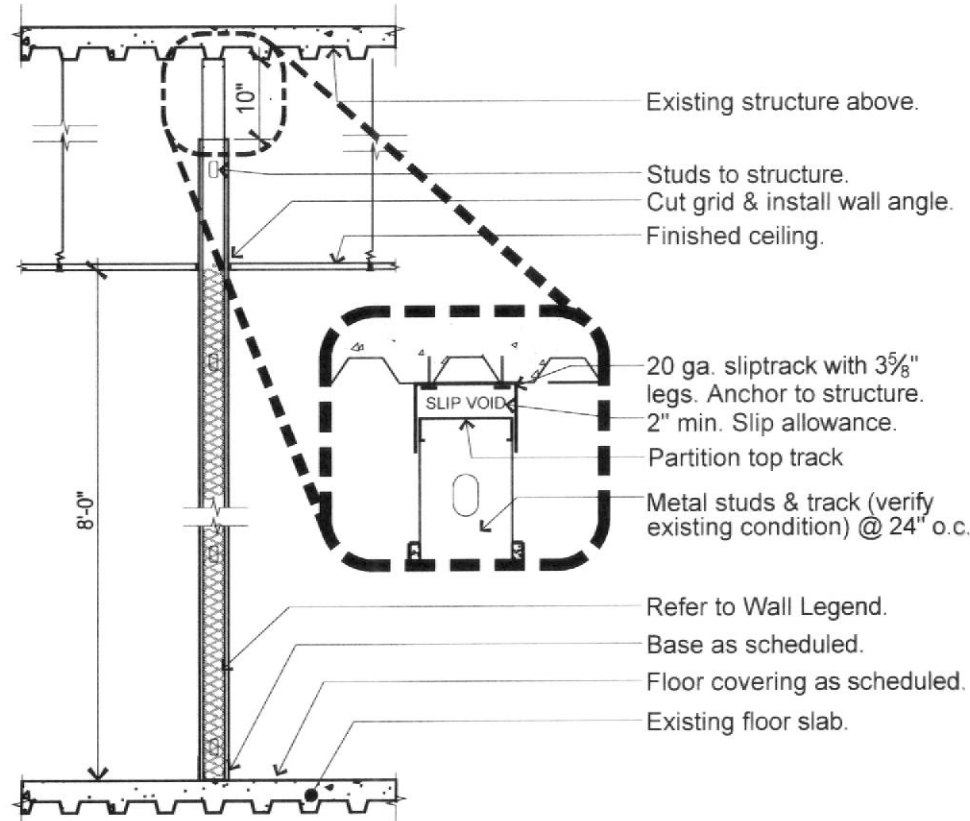


3 Section: Partition
Typical Demising Partition

Scale: 1/2" = 1'-0"

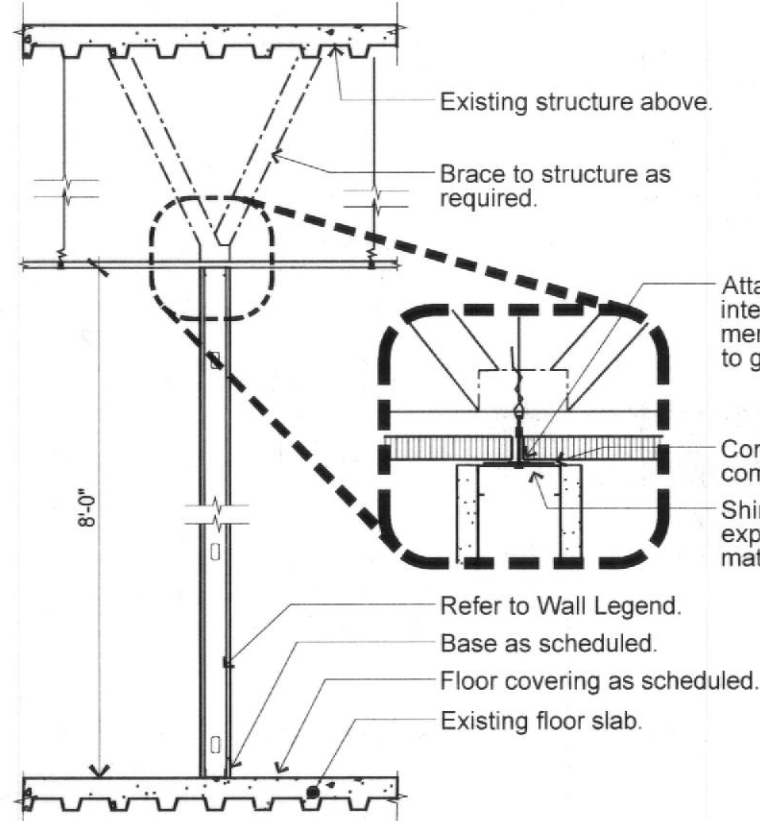

4 Section: Partition
Typical Standard Interior Partition

Scale: 1/2" = 1'-0"

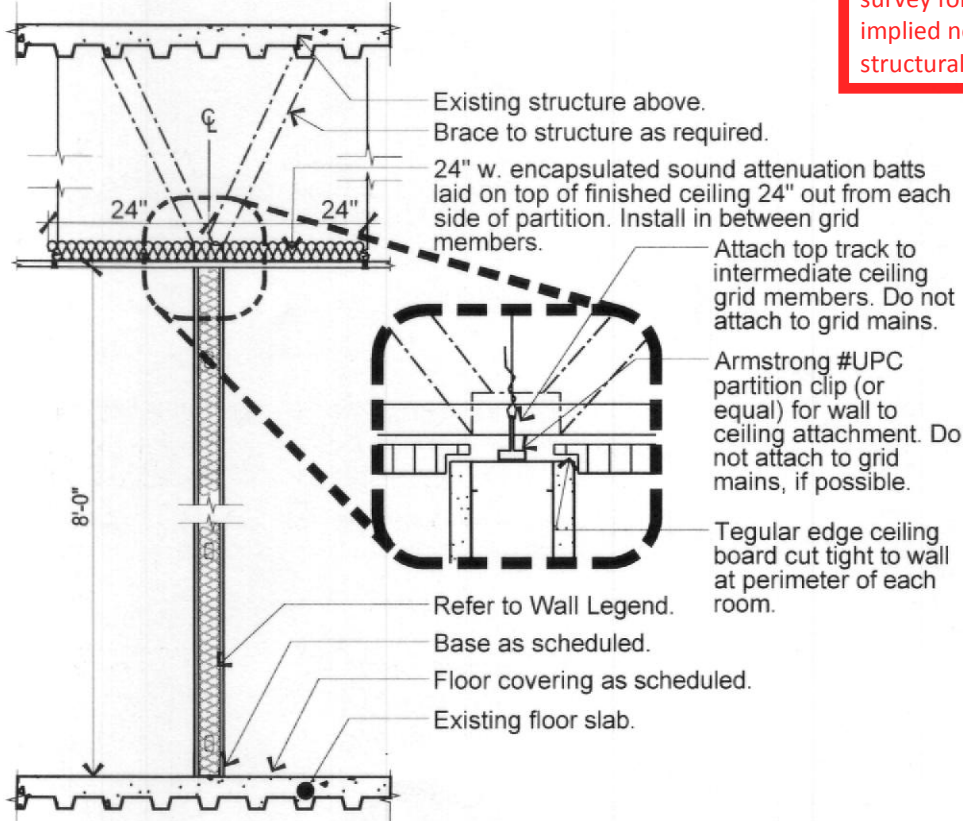

5 Section: Partition
Typical Sound Attenuating Partition

Scale: 1/2" = 1'-0"

Structural plan review is limited to a general survey for code compliance. No review is implied nor was undertaken to verify structural adequacy.

Room Schedule

400	Public Corridor	409	Office
401	Tenant Entrance	410	---
402	Unisex Restroom	411	Break Room
403	Waiting	412	Closet
404	Exam Room	413	Open Work Area
405	Work Room	414	Tenant Hallway
406	Tenant Hallway	415	Office
407	Exam Room	416	Office
408	Office	417	---

Sheet Keyed Notes


- RELOCATED MILLWORK: Refer to Demolition and Millwork plans.
- NEW WALL CABINETS & COUNTERTOP: Refer to detail(s). Include backing in partition per Sheet A1 Plan Note 16.
- At existing book shelves. Provide new finished end to match existing finish.
- Rework existing base cabinet. Cut down existing door and base cabinet as necessary for new layout, rework as necessary for new size and reattach door to existing millwork.
- At Restroom: EXISTING FINISH TREATMENTS TO REMAIN, including floorcovering, base trim, and wallcovering.
- At Work Room 405 & Break Rm 411: EXISTING FLOORCOVERING to remain in this area(s). Provide new base trim as scheduled.
- At Open Work Areas: NEW COUNTERTOP & SHELVING. Refer to detail(s). Include backing in partition per Sheet A1 Plan Note 16.

Symbol Legend

- Ceiling Mounted Fixtures/ Devices
- Building Standard 2x4 LED light fixture
 - Building Standard 2x2 LED light fixture
- NOTE: all fixtures shown half shaded shall have night light egress function.
- Vent fan assembly
 - Existing as-built sprinkler head location
 - Ceiling mounted audio speaker
 - Building Standard exit sign (UNO). Green letters on white face. Battery backup. Shade indicates face(s) and arrows (if any) indicate direction.
- Wall Mounted Fixtures/ Devices
- Building Standard single pole switch
 - Special function switches:
 - "OS" = occupancy sensor
 - Duplex electrical receptacle & face plate
 - Quadruplex electrical receptacle & faceplate
 - Duplex electrical receptacle & face plan on dedicated circuit
 - Single gang J-box with RJ-11 telephone outlet and face plate
 - Combination telephony/ data outlet rough-in (5/8" conduit) with double gang J-box and single gang plaster ring with pull string to above finished ceiling.
 - Existing J-Box with blank face plate
 - Water line
- "N" New fixture/ device to be installed
"R" Relocated fixture/ devices
Refer to Engineering Drawings for complete specifications

TPS
TENANT
PLANNING
SERVICES
INCORPORATED
1660 Lincoln St, Ste. 100
Denver, Colorado 80264
(303) 861-4800
fax (303) 861-1621
www.TPS.design

**1411 South
Potomac**
1411 South Potomac
Aurora, CO 80012
Suite 420

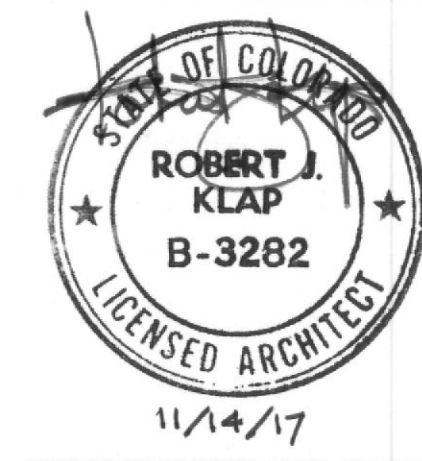

Lynn Institute

Dates of Record

Project Start Date: 30 October 2017
Issued On: Issued For:
14 Nov 2017 Tenant Review & Approval; and Construction



City of Aurora Building Division
Reviewed for Code Compliance
Approved as Noted: **W. Griffin**
Date: **Feb 21, 2018**
2015 INTERNATIONAL CODES & 2017 NEC


RSN: 1268800
Permit #: 18-1420046 TF

Sheet	Reflected Ceiling Plan
Contents	Power & Communications Plan
	Millwork & Finish Treatment Plan
	Finish Treatment Schedule
	Standard Partition Sections
Project #	426005
Proj Mgr	GBS
Designed by	APC
Drafted by	TB
Checked by	GBS

A2.0


1411 South Potomac • Lynn Institute

Project start date: 30 October 2017
dwg create date: 10/30/2017 3:37:09 PM
dwg save date: 11/14/2017 9:02:52 AM
pht create date: 11/14/2017 9:03:24 AM
by: tmb to P: A2.1, 1411 South Potomac 426005, Lynn Institute Suite 420 drawings construction documents 426005.dwg
by: tmb to tmb to P: A2.1, 1411 South Potomac 426005, Lynn Institute Suite 420 drawings construction documents 426005.dwg

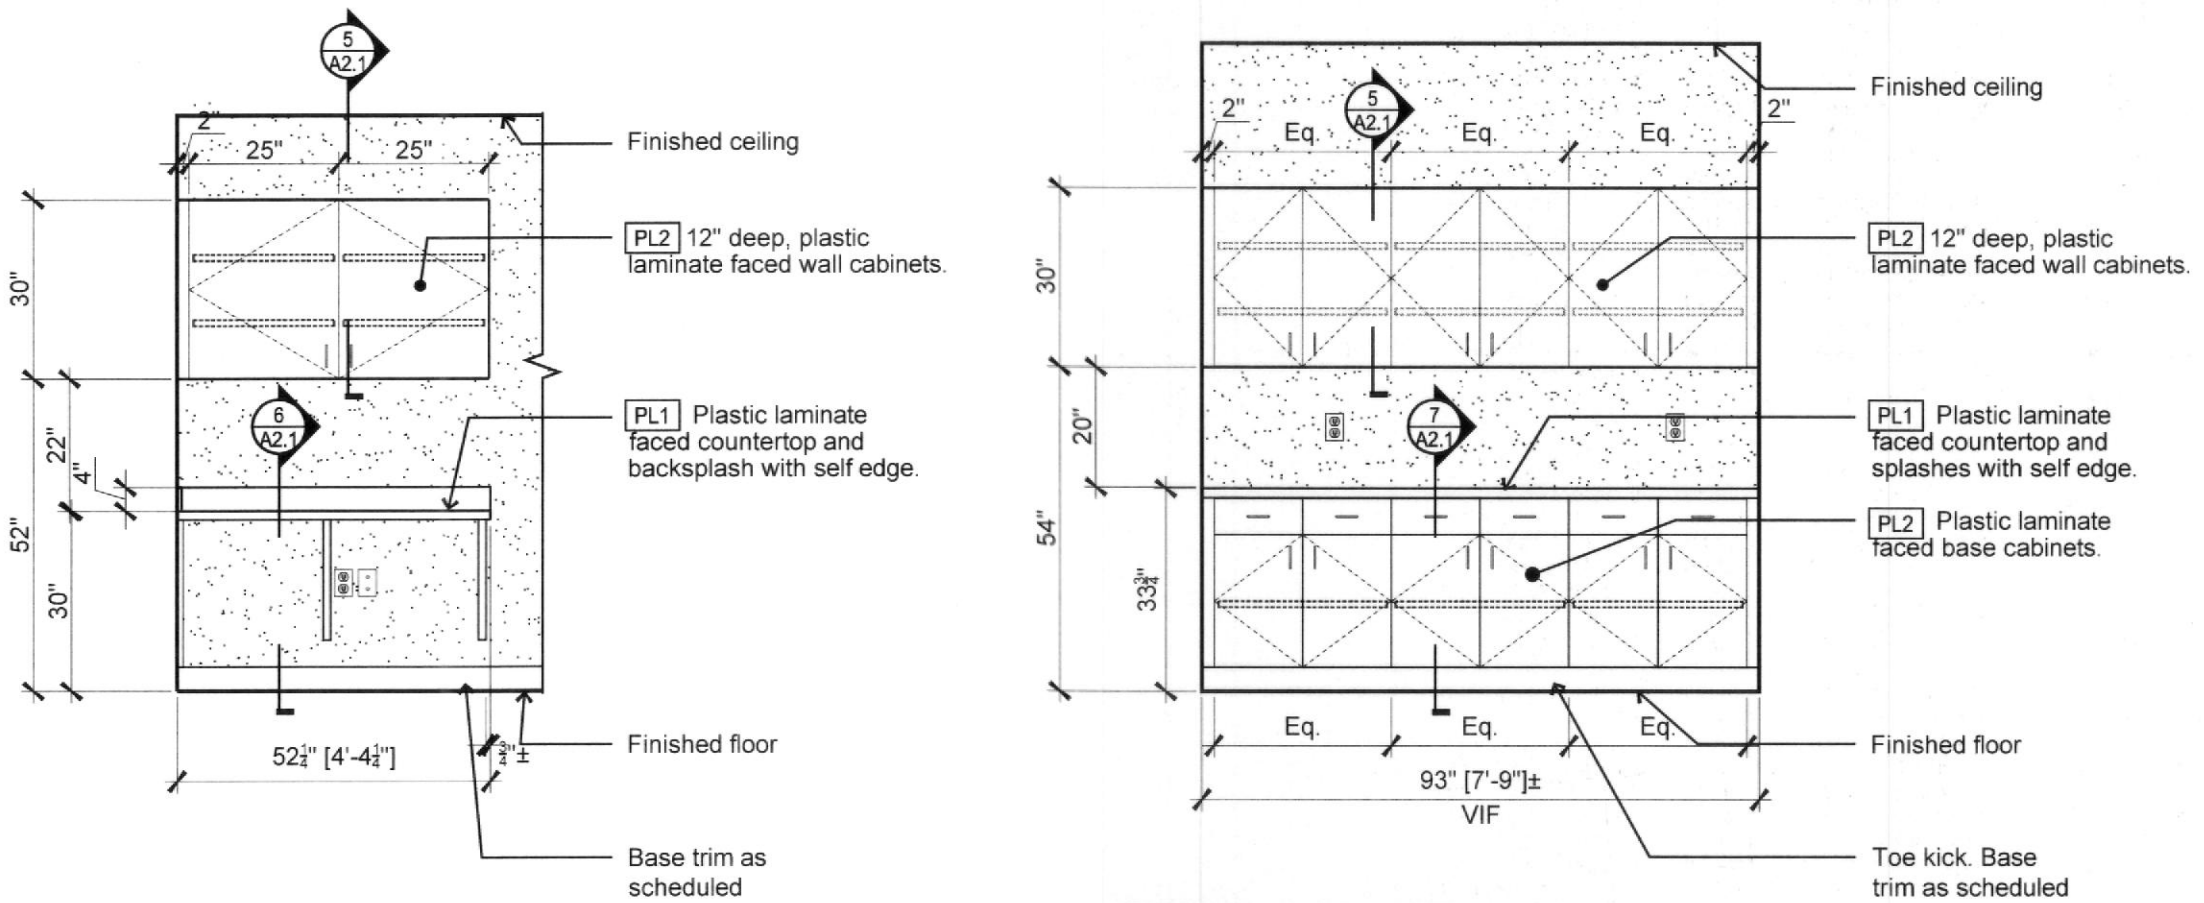


1 Millwork: Elevation
At Exam Room(s) 404 & 407
Scale: 3/8" = 1'-0"

2 Millwork: Elevation
At Break Room 411
Scale: 3/8" = 1'-0"

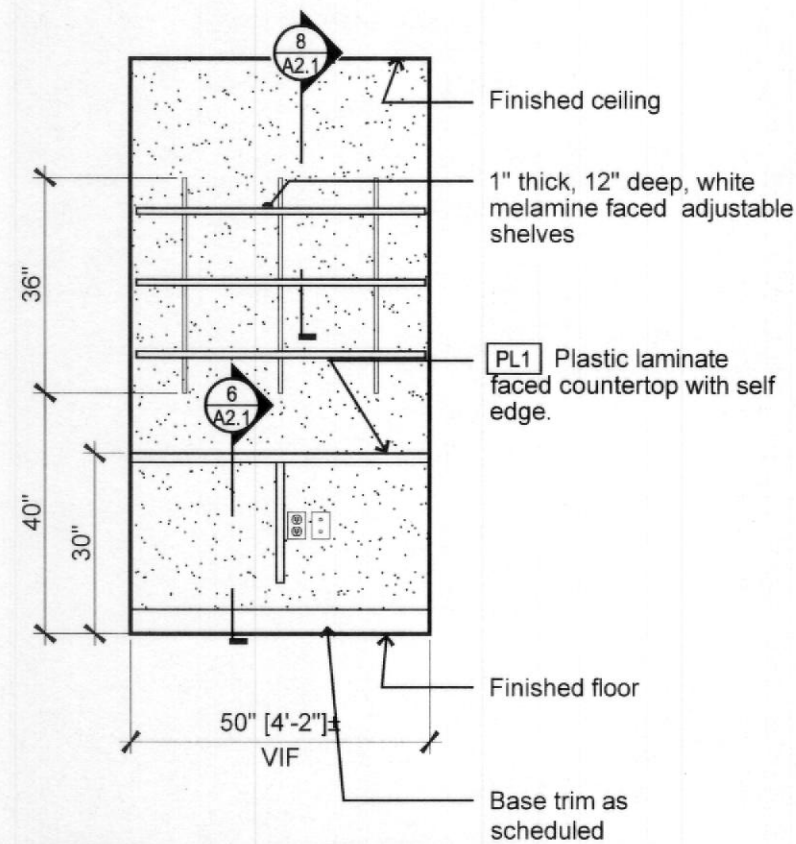

3 Millwork: Elevation
At Open Work Area 413 & 414
Scale: 3/8" = 1'-0"

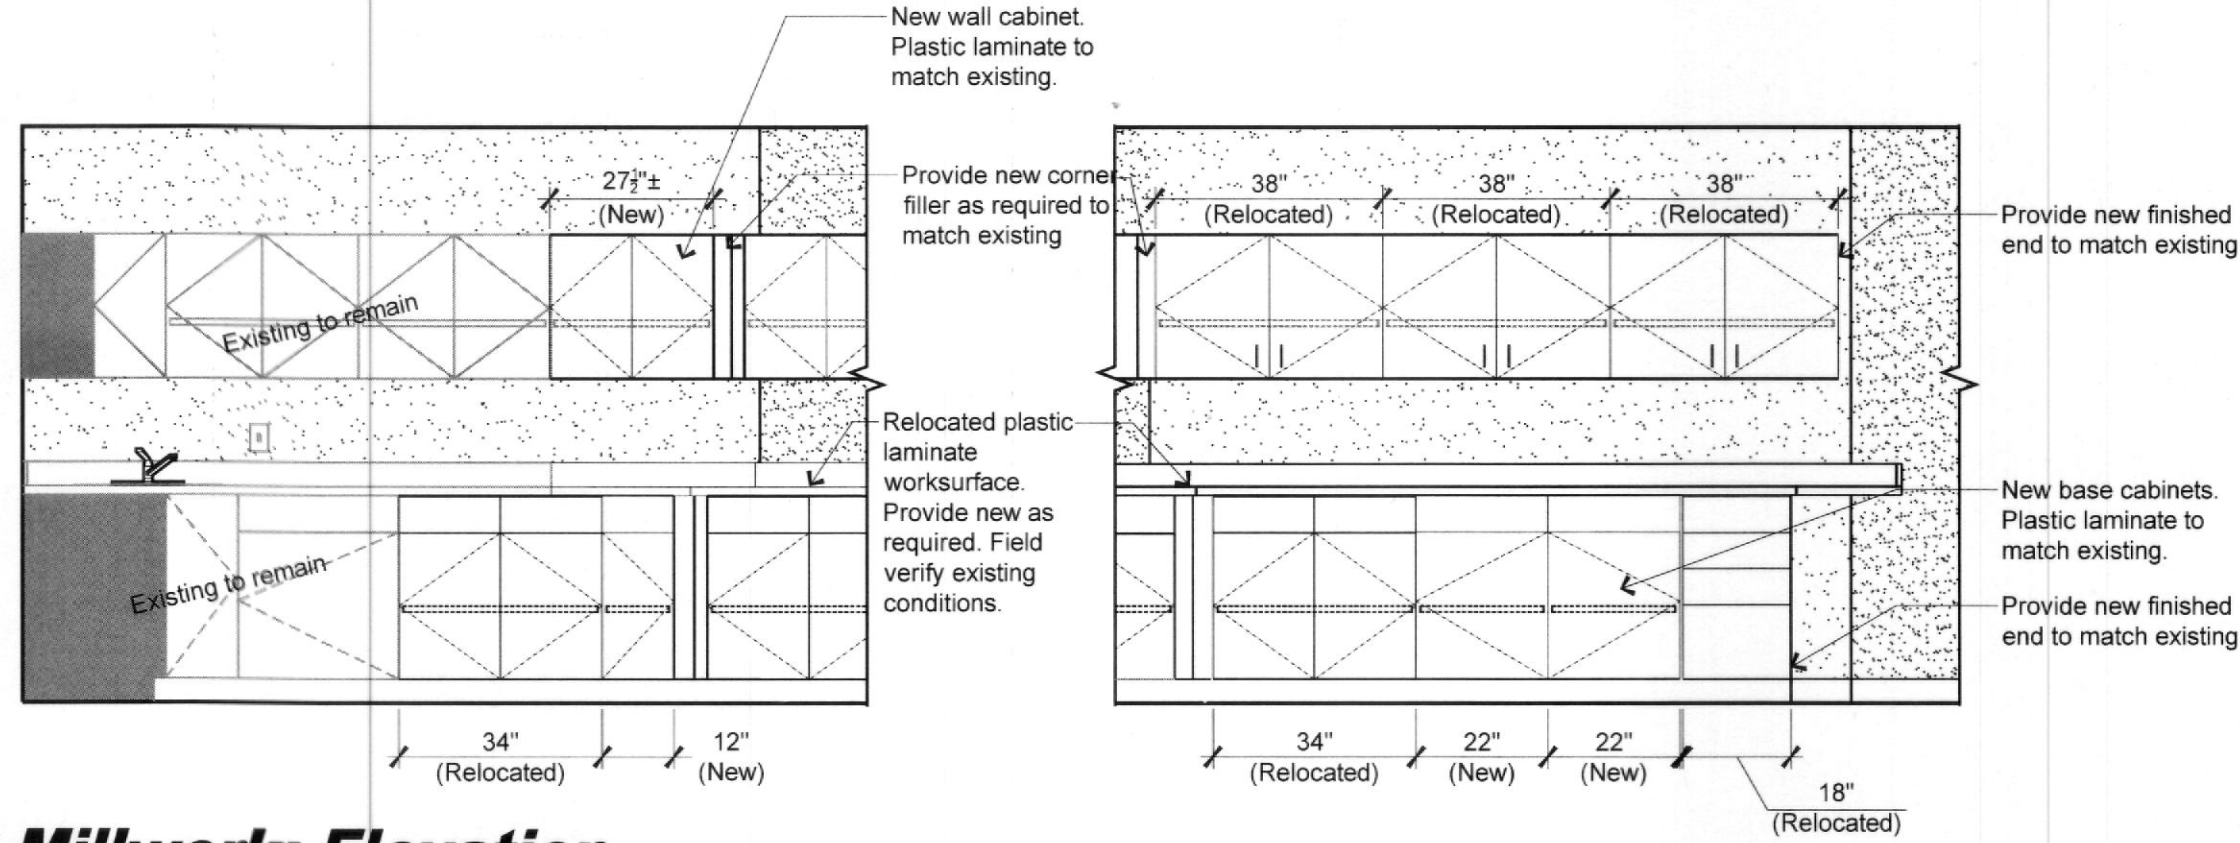

4 Millwork: Elevation
At Work Room 405
Scale: 3/8" = 1'-0"

Architectural Casework Specifications

Construction:

- Cabinet Casework:** All cabinet casework shall be 3/4" melamine covered particle board. All cabinet pieces shall be multiple doweled, using aliphatic resin glue and machine clamped under pressure for a square secure fit.
- Toeboard Assemblies:** Toe-board assemblies shall be assembled loose for base and tail units for field installation. Rubber base shall be furnished and installed by others. Toe-board material to be fabricated from mill option material.
- Cabinet Top and Bottom:** Cabinet top and bottom shall be 3/4" melamine covered particle board. Bottoms of upper cabinets to be melamine to match cabinets interior. Base cabinets shall have a 4 5/8" wide stretcher on top for fastening counter top. Edge banding to match cabinet ends.
- Cabinet Ends:** Ends shall be 3/4" thick melamine covered particle board interior. Exterior finished ends are to be high pressure laminate. Holes for adjustable shelf clips shall be 1 1/4" on center. Front edges to be banded with PVC. Color to match plastic laminate used on door faces.
- Adjustable Shelves:** Shelving shall be 3/4" thick melamine covered particle board both sides. Front edges shall be banded with matching color PVC material.
- Cabinet Back:** Backs shall be 1/4" thick melamine covered particle board, one face. Backs shall be rabbeted and securely glued into sides and bottom. A 1/2" hanger cleat is securely glued and nailed through cabinet back into top of wall cabinets and into back stretcher of base cabinets.
- Cabinet Doors and Drawer Fronts:** Doors and drawer fronts shall be 3/4" thick particle board laminated on both faces with high pressure laminate. All edges shall be banded with PVC material coordinating with face color. Maximum door width to be 24".
- Drawers:** Sides, back and subfront shall be 5/8" melamine covered particle board. Bottom shall be 1/4" melamine covered particle board to match cabinet interiors. Drawer sides are machined with a lock joint and glued and stapled together for secure fit. Bottom to be rabbeted into sides and subfront.
- Counter Top:** Cabinets shall have continuous one piece counter tops up to 12'-0" length constructed of 3/4" particle board with 1 1/2" shelf edge. Tops over 12'-0" long shall be splined and joined together with metal fasteners.
- Fillers:** All fillers shall be 3/4" particle board material covered on one face with high pressure laminate to match door and drawer fronts.


Materials:

- Plastic Laminate:** Shall be used on all door and drawer faces. All laminate shall meet all NEMA standards. Colors to be selected from full range of colored laminates by Wilsonart, Formica or Nevamar. Refer to Finish Schedule.
- Counter Tops:** Counter tops shall be horizontal grade high pressure laminate with a suitable backing sheet on a 45 pound industrial particle board.
- Casework Interiors:** Covered 45 pound industrial particle board. Color of interiors shall be white, unless noted otherwise.
- Plastic Edging:** Edge banding on all casework to be PVC to match plastic laminate on door and drawer faces. Edge banding on doors and drawer fronts to be PVC material coordination.


Hardware:

- Hinges:** Hinges shall be concealed steel type, chrome finish, 110", with automatic spring (heavy duty).
- Pulls:** Pulls for doors and drawers shall be a metal wire pull in satin aluminum, anodized.
- Drawer Slides:** Drawer suspension shall be of a side-bottom mounted white epoxy type with 3/4" extension. Load rating of 100 pounds. Files drawers shall be full extension.
- Door Catches:** Door catches shall be European style, self-closing concealed hinge with adjustment.
- Shelf Supports:** Adjustable shelf supports shall be a nylon covered 5mm diameter steel pin for predrilled holes in cabinet ends.


CONTRACTOR TO PROVIDE SHOP DRAWINGS TO TPS FOR REVIEW AND APPROVAL PRIOR TO CONSTRUCTION.

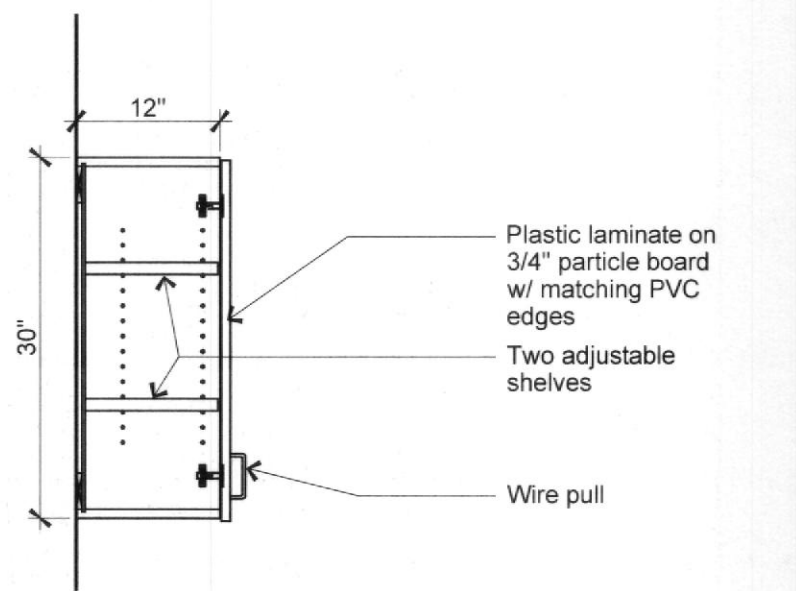


5 Section
Wall Cabinet
Scale: 3/4" = 1'-0"

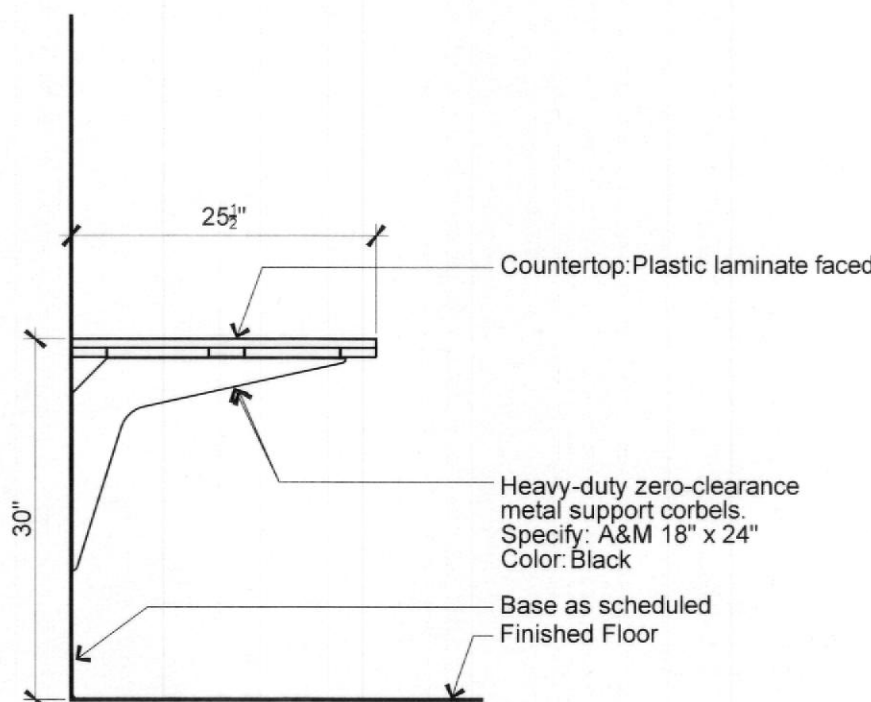

6 Section
Worksurface
Scale: 3/4" = 1'-0"

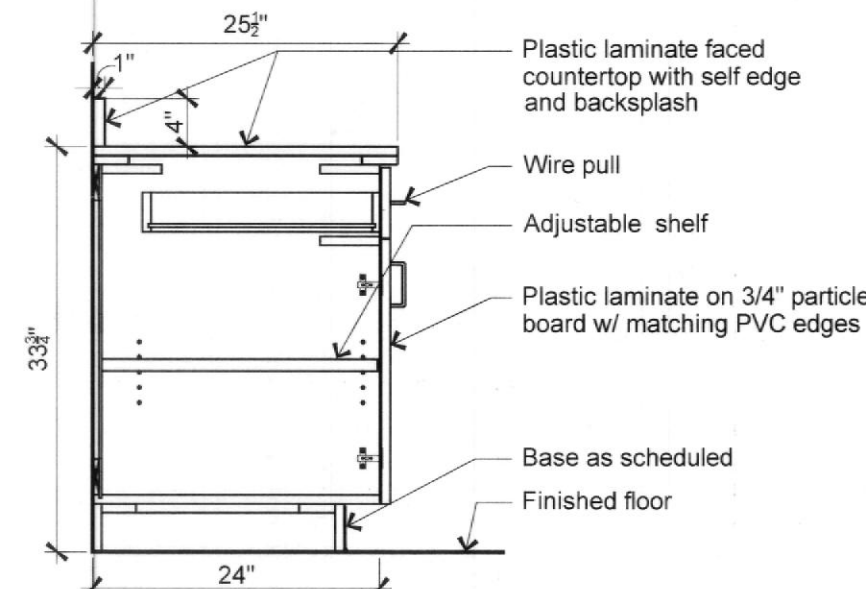

7 Section
Base Cabinet
Scale: 3/4" = 1'-0"

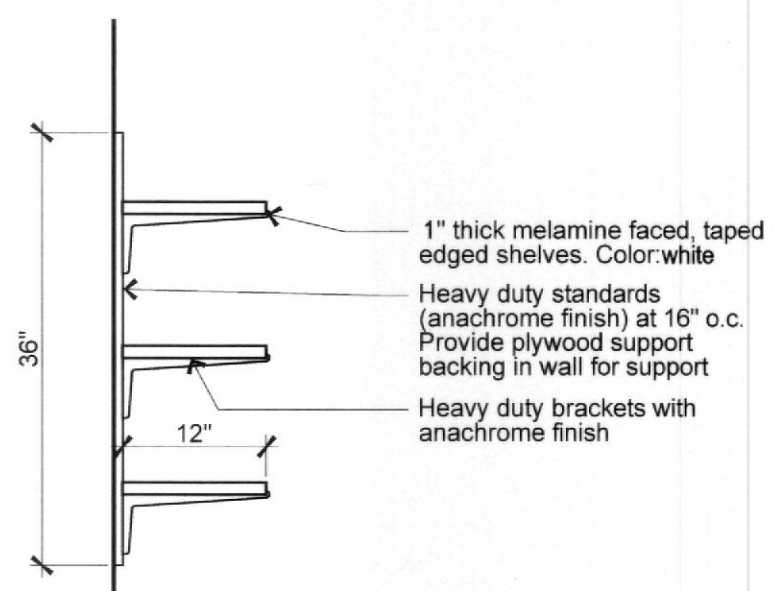


8 Section
Adjustable Shelves
Scale: 3/4" = 1'-0"

This sheet of drawings has not been reviewed for code compliance.

TPS
TENANT
PLANNING
SERVICES
INCORPORATED
1660 Lincoln St, Ste. 100
Denver, Colorado 80264
(303) 861-4800
fax (303) 861-1621
www.TPS.design

**1411 South
Potomac**
1411 South Potomac
Aurora, CO 80012
Suite 420

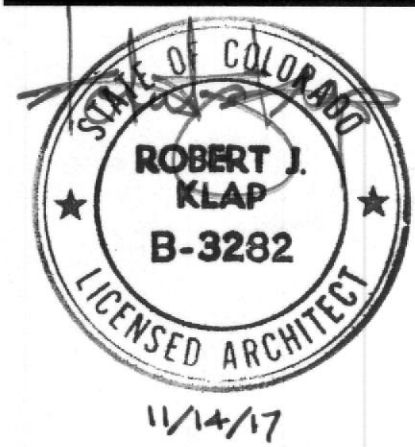

Lynn Institute

Dates of Record

Project Start Date: 30 October 2017

Issued On: 14 Nov 2017
Issued For: Tenant Review & Approval, and Construction

Sheet	Millwork Details
Contents	
Project #	426005
Proj Mgr	GBS
Designed by	APC
Drafted by	TB
Checked by	GBS

RSN: 1268800
Permit #: 18-1420046 TF

A2.1

1411 South Potomac • Lynn Institute

MECHANICAL GENERAL NOTES

GENERAL

SCOPE

THE INTENT OF THE SPECIFICATION AND THE DRAWINGS IS TO PROVIDE A COMPLETE AND FULLY OPERATIONAL MECHANICAL SYSTEM. THE MECHANICAL CONTRACTOR SHALL FURNISH AND INSTALL ALL LABOR, MATERIAL AND EQUIPMENT NECESSARY TO COMPLETE THE MECHANICAL WORK.

SITE EXAMINATION

THE MECHANICAL CONTRACTOR SHALL THOROUGHLY EXAMINE ALL AREAS WHERE EQUIPMENT, DUCTWORK, AND PIPING WILL BE INSTALLED AND WILL REPORT ANY CONDITION THAT, IN HIS OPINION, PREVENTS THE PROPER INSTALLATION OF THE MECHANICAL WORK.

STANDARDS

EQUIPMENT AND MATERIALS SHALL CONFORM WITH APPROPRIATE PROVISIONS OF ARL, ASME, ASTM, UL, NEMA, ANSI, SMACNA, ASHRAE, AND NFPA, AS APPLICABLE TO EACH INDIVIDUAL UNIT OR ASSEMBLY.

CODES

ALL WORK SHALL BE PERFORMED IN STRICT ACCORDANCE WITH ALL APPLICABLE STATE AND LOCAL CODES AND ORDINANCES. IN CASE OF CONFLICT BETWEEN THE DRAWINGS AND SPECIFICATION AND THE CODES AND THE ORDINANCES, THE HIGHEST STANDARDS SHALL APPLY. THE MECHANICAL CONTRACTOR SHALL SATISFY CODE REQUIREMENTS AS A MINIMUM STANDARD WITHOUT ANY EXTRA COST TO OWNER/TENANT.

PERMITS AND FEES

THE MECHANICAL CONTRACTOR SHALL PROCURE AND PAY FOR ALL PERMITS, FEES AND INSPECTORS NECESSARY TO COMPLETE THE MECHANICAL WORK.

WARRANTY

THE MECHANICAL CONTRACTOR SHALL UNCONDITIONALLY WARRANT ALL WORK TO BE FREE OF DEFECTS IN MATERIAL AND WORKMANSHIP FOR A PERIOD OF ONE (1) YEAR FROM THE DATE OF FINAL ACCEPTANCE BY OWNER/TENANT AND WILL REPAIR OR REPLACE ANY DEFECTIVE WORK PROMPTLY AND WITHOUT CHARGE AND RESTORE ANY OTHER EXISTING WORK DAMAGED IN THE COURSE OF REPAIRING DEFECTIVE MATERIAL AND WORKMANSHIP.

DUCTWORK & ACCESSORIES

SHEETMETAL DUCTWORK

ALL DUCTWORK TO BE RIGID SHEETMETAL CONSTRUCTED FROM GALVANIZED SHEET STEEL IN ACCORDANCE WITH SMACNA 1" PRESSURE CLASS DUCT CONSTRUCTION STANDARDS. ALL EXPOSED DUCTWORK TO BE ROUND, SPIRAL, OR RECTANGULAR LOCK-SEAM TYPE, AS SHOWN ON HVAC PLAN. ASSEMBLE AND INSTALL DUCTWORK IN ACCORDANCE WITH RECOGNIZED INDUSTRY PRACTICE FOR ACHIEVING AIR TIGHT (5% LEAKAGE) AND NOISELESS (NO OBJECTIONABLE NOISE) SYSTEMS, CAPABLE OF PERFORMING EACH INDICATED SERVICE. FURNISH ALL REQUIRED DAMPERS, TRANSITIONS, CONNECTIONS TO AIR TERMINALS, AND OTHER ACCESSORIES NECESSARY FOR A COMPLETE OPERATING SYSTEM. NO VARIATION OF DUCT CONFIGURATION OR SIZES WILL BE PERMITTED EXCEPT BY PERMISSION FROM THE ENGINEER.

DUCT SEALANT

SEAL ALL CONCEALED LONGITUDINAL AND TRANSVERSE JOINTS WITH A NON-HARDENING, NON-MIGRATING MASTIC OR LIQUID ELASTIC SEALANT OF A TYPE RECOMMENDED BY THE MANUFACTURER FOR SEALING JOINTS AND SEAMS IN SHEET METAL DUCTWORK. COVER ALL FIELD JOINTS, JOINTS AROUND SPIN-IN FITTINGS AND FASTENING SCREWS WITH MASTIC. DO NOT SEAL EXPOSED DUCT.

SUPPORTS

PROVIDE HOT-DIPPED GALVANIZED STEEL FASTENERS, ANCHORS, RODS, STRAPS, TRIM, AND ANGLES FOR SUPPORT OF DUCTWORK.

DAMPERS

PROVIDE OPPOSED-BLADE, MULTI-LEAF VOLUME CONTROL DAMPERS WHERE INDICATED ON DRAWINGS AND AT POINTS ON LOW PRESSURE SUPPLY, RETURN AND EXHAUST DUCTS WHERE BRANCHES ARE TAKEN FROM LARGER DUCTS. PROVIDE UL LISTED FIRE DAMPERS WHERE REQUIRED AND IN ACCORDANCE WITH NFPA AND LOCAL CODES. PROVIDE CONVENIENTLY LOCATED ACCESS DOORS OF AMPLE SIZE AND QUANTITY FOR SERVICING THE DAMPERS.

GRILLES, REGISTERS, & DIFFUSERS

GRILLES, REGISTERS AND DIFFUSERS SHALL BE MANUFACTURED BY PRICE. DIFFUSERS SHALL BE INSTALLED AS INDICATED ON THE DRAWINGS AND SCHEDULES. THE MECHANICAL CONTRACTOR SHALL PROVIDE ALL MISCELLANEOUS ITEMS NECESSARY FOR A COMPLETE AND PROPER INSTALLATION IN THE TYPE OF CEILING AND WALLS USED IN THIS PROJECT.

CONTROLS AND OPERATIONS

CONTROL WIRING

THE MECHANICAL CONTRACTOR SHALL PROVIDE ALL CONTROL WIRING NECESSARY FOR THE COMPLETE AND PROPER OPERATING TEMPERATURE CONTROL SYSTEM.

CONTROLS

MOUNT ALL CONTROLS @ 48" ABOVE FINISH FLOOR. UNLESS OTHERWISE NOTED.

TESTING, ADJUSTING, AND BALANCING

TESTING, ADJUSTING, BALANCING

MECHANICAL CONTRACTOR OR AN INDEPENDENT NEBB OR AABC CERTIFIED AIR BALANCE CONTRACTOR SHALL ACCURATELY BALANCE THE AIR SYSTEM TO PROVIDE AIR QUANTITIES INDICATED ON THE DRAWINGS AND IN THE SPECIFICATION. OPERATE AUTOMATIC CONTROLS SYSTEM AND VERIFY SET POINTS DURING BALANCING. SUBMIT TWO (2) COPIES OF THE BALANCE REPORT TO THE ENGINEER FOR APPROVAL. INCLUDE A COPY OF THE BALANCE REPORT AS APPROVED BY THE ENGINEER WITH APPLICATION FOR FINAL CONTRACT PAYMENT.

Heating system shall be capable of maintaining 68 degrees F a 3'0" above the floor.
2015 IMC 309, IRC 303.9 and IBC 1204.1

Provide proof of a flame spread less than 26 and a smoke development less than 50 for any material used in a plenum.
2015 IMC 602.2.1

VAV TERMINAL SCHEDULE

MARK	MANUFACTURER	MODEL	AIR INLET SIZE	MAX. PRIMARY AIR CFM COOLING	MIN. PRIMARY AIR CFM (% OF MAX. SETTING)	REMARKS
A VAV-17	TRANE	VCCE17	10"Ø	1350	25%	1

NOTES:
1. EXISTING TO REMAIN.

Room Schedule

400	Public Corridor	409	Office
401	Tenant Entrance	410	—
402	Unisex Restroom	411	Break Room
403	Waiting	412	Closet
404	Exam Room	413	Open Work Area
405	Work Room	414	Tenant Hallway
406	Tenant Hallway	415	Office
407	Exam Room	416	Office
408	Office	417	—

DETAIL NOTES:

- 1 (E) MEDIUM PRESSURE SUPPLY AIR.
2 RELOCATE (E) THERMOSTAT.
3 (N) MANUAL VOLUME DAMPER.

ALL GRILLES/DIFFUSERS & DUCTWORK ARE EXISTING TO REMAIN UNLESS OTHERWISE NOTED.

CLEAN ALL EXISTING GRILLES/DIFFUSERS.

OUTSIDE AIR COMPLIANCE

DESCRIPTION	ROOM NUMBER	AREA SF	PEOPLE/1000SF	POPULATION	CFM/PERSON	AREA AIRFLOW RATE	Ez	REQUIRED OUTSIDE AIR CFM	SUPPLY AIR	% OUTSIDE AIR	OUTSIDE AIR PROVIDED	EXHAUST AIR PROVIDED
WAITING	403	75	30	2	5	0.06	0.8	20	200	25%	50	0
EXAM ROOM	404	85	5	0	0	0.06	0.8	6	200	25%	50	0
WORK ROOM	405	130	5	1	5.0	0.06	0.8	14	105	25%	26	0
TENANT HALLWAY	406	135	0	0	0.0	0.06	0.8	10	40	25%	10	0
EXAM ROOM	407	90	5	0	5.0	0.06	0.8	10	220	25%	55	0
OFFICE	408	115	5	1	5.0	0.06	0.8	12	215	25%	54	0
OFFICE	409	70	5	0	5.0	0.06	0.8	7	275	25%	69	0
BREAK ROOM	411	60	5	0	5.0	0.06	0.8	6	65	25%	16	0
OPEN WORK AREA	413	70	5	0	5.0	0.06	0.8	7	80	25%	20	0
TENANT HALLWAY	414	60	0	0	0.0	0.06	0.8	5	20	25%	5	0
OFFICE	415	120	5	1	5.0	0.06	0.8	13	320	25%	80	0
OFFICE	416	115	5	1	5.0	0.06	0.8	12	320	25%	80	0
TOTALS		1125		7				123	2060		515	0

FAN TERMINAL UNIT SCHEDULE


MARK	MFR. & MODEL NUMBER	AIR INLET SIZE	PRIMARY AIR		HEATING			FAN MOTOR			MCA	REMARKS
			MAX. CFM	MIN. CFM	VOLTAGE	KW	HEATING CFM	VOLTAGE	HP	FLA		
B-VAV-11	VFPE11C2	8"Ø	835	210	277/1	7.5	835	277/1	1/3HP	1.9	36.4	1
C-VAV-17	VFPE17D2	10"Ø	1700	425	277/1	10.0	1130	277/1	-	-	48.3	1

NOTES:
1. EXISTING TO REMAIN.

DIFFUSER SCHEDULE

MARK	SERVICE	FACE SIZE	NECK SIZE	FIRE DAMPER	VOLUME DAMPER	MFR	MODEL	REMARKS
A	SUPPLY	-	-	-	-	-	-	EXISTING TO REMAIN OR BE RELOCATED
B	SUPPLY	24" x 24"	6"Ø	NO	NO	PRICE	PDF	NEW
C	SUPPLY	24" x 24"	8"Ø	NO	NO	PRICE	PDF	NEW
D	SUPPLY	24" x 24"	10"Ø	NO	NO	PRICE	PDF	NEW
R	RETURN	-	-	-	-	-	-	EXISTING TO REMAIN OR BE RELOCATED
R1	RETURN	24" x 12"	22" x 10"	NO	NO	PRICE	PRF	NEW

LEGEND	
	DIFFUSER, SEE SCHEDULE
	GRILLE, SEE SCHEDULE
	NEW RIGID RECTANGULAR DUCTWORK
	EXISTING RIGID RECTANGULAR DUCTWORK
	NEW RIGID ROUND DUCTWORK
	EXISTING RIGID ROUND DUCTWORK
	EXPOSED SPIRAL DUCTWORK
	DUCTWORK TO BE REMOVED
	FLEX, DUCTWORK.
	THERMOSTAT TO MATCH EQUIPMENT
	CFM, BALANCE WITHIN 10%
	EQUIPMENT DESIGNATION
	SPIN-IN WITH DAMPER
	RETURN AIR ARROW
	SUPPLY AIR ARROW
	CONNECT TO EXISTING

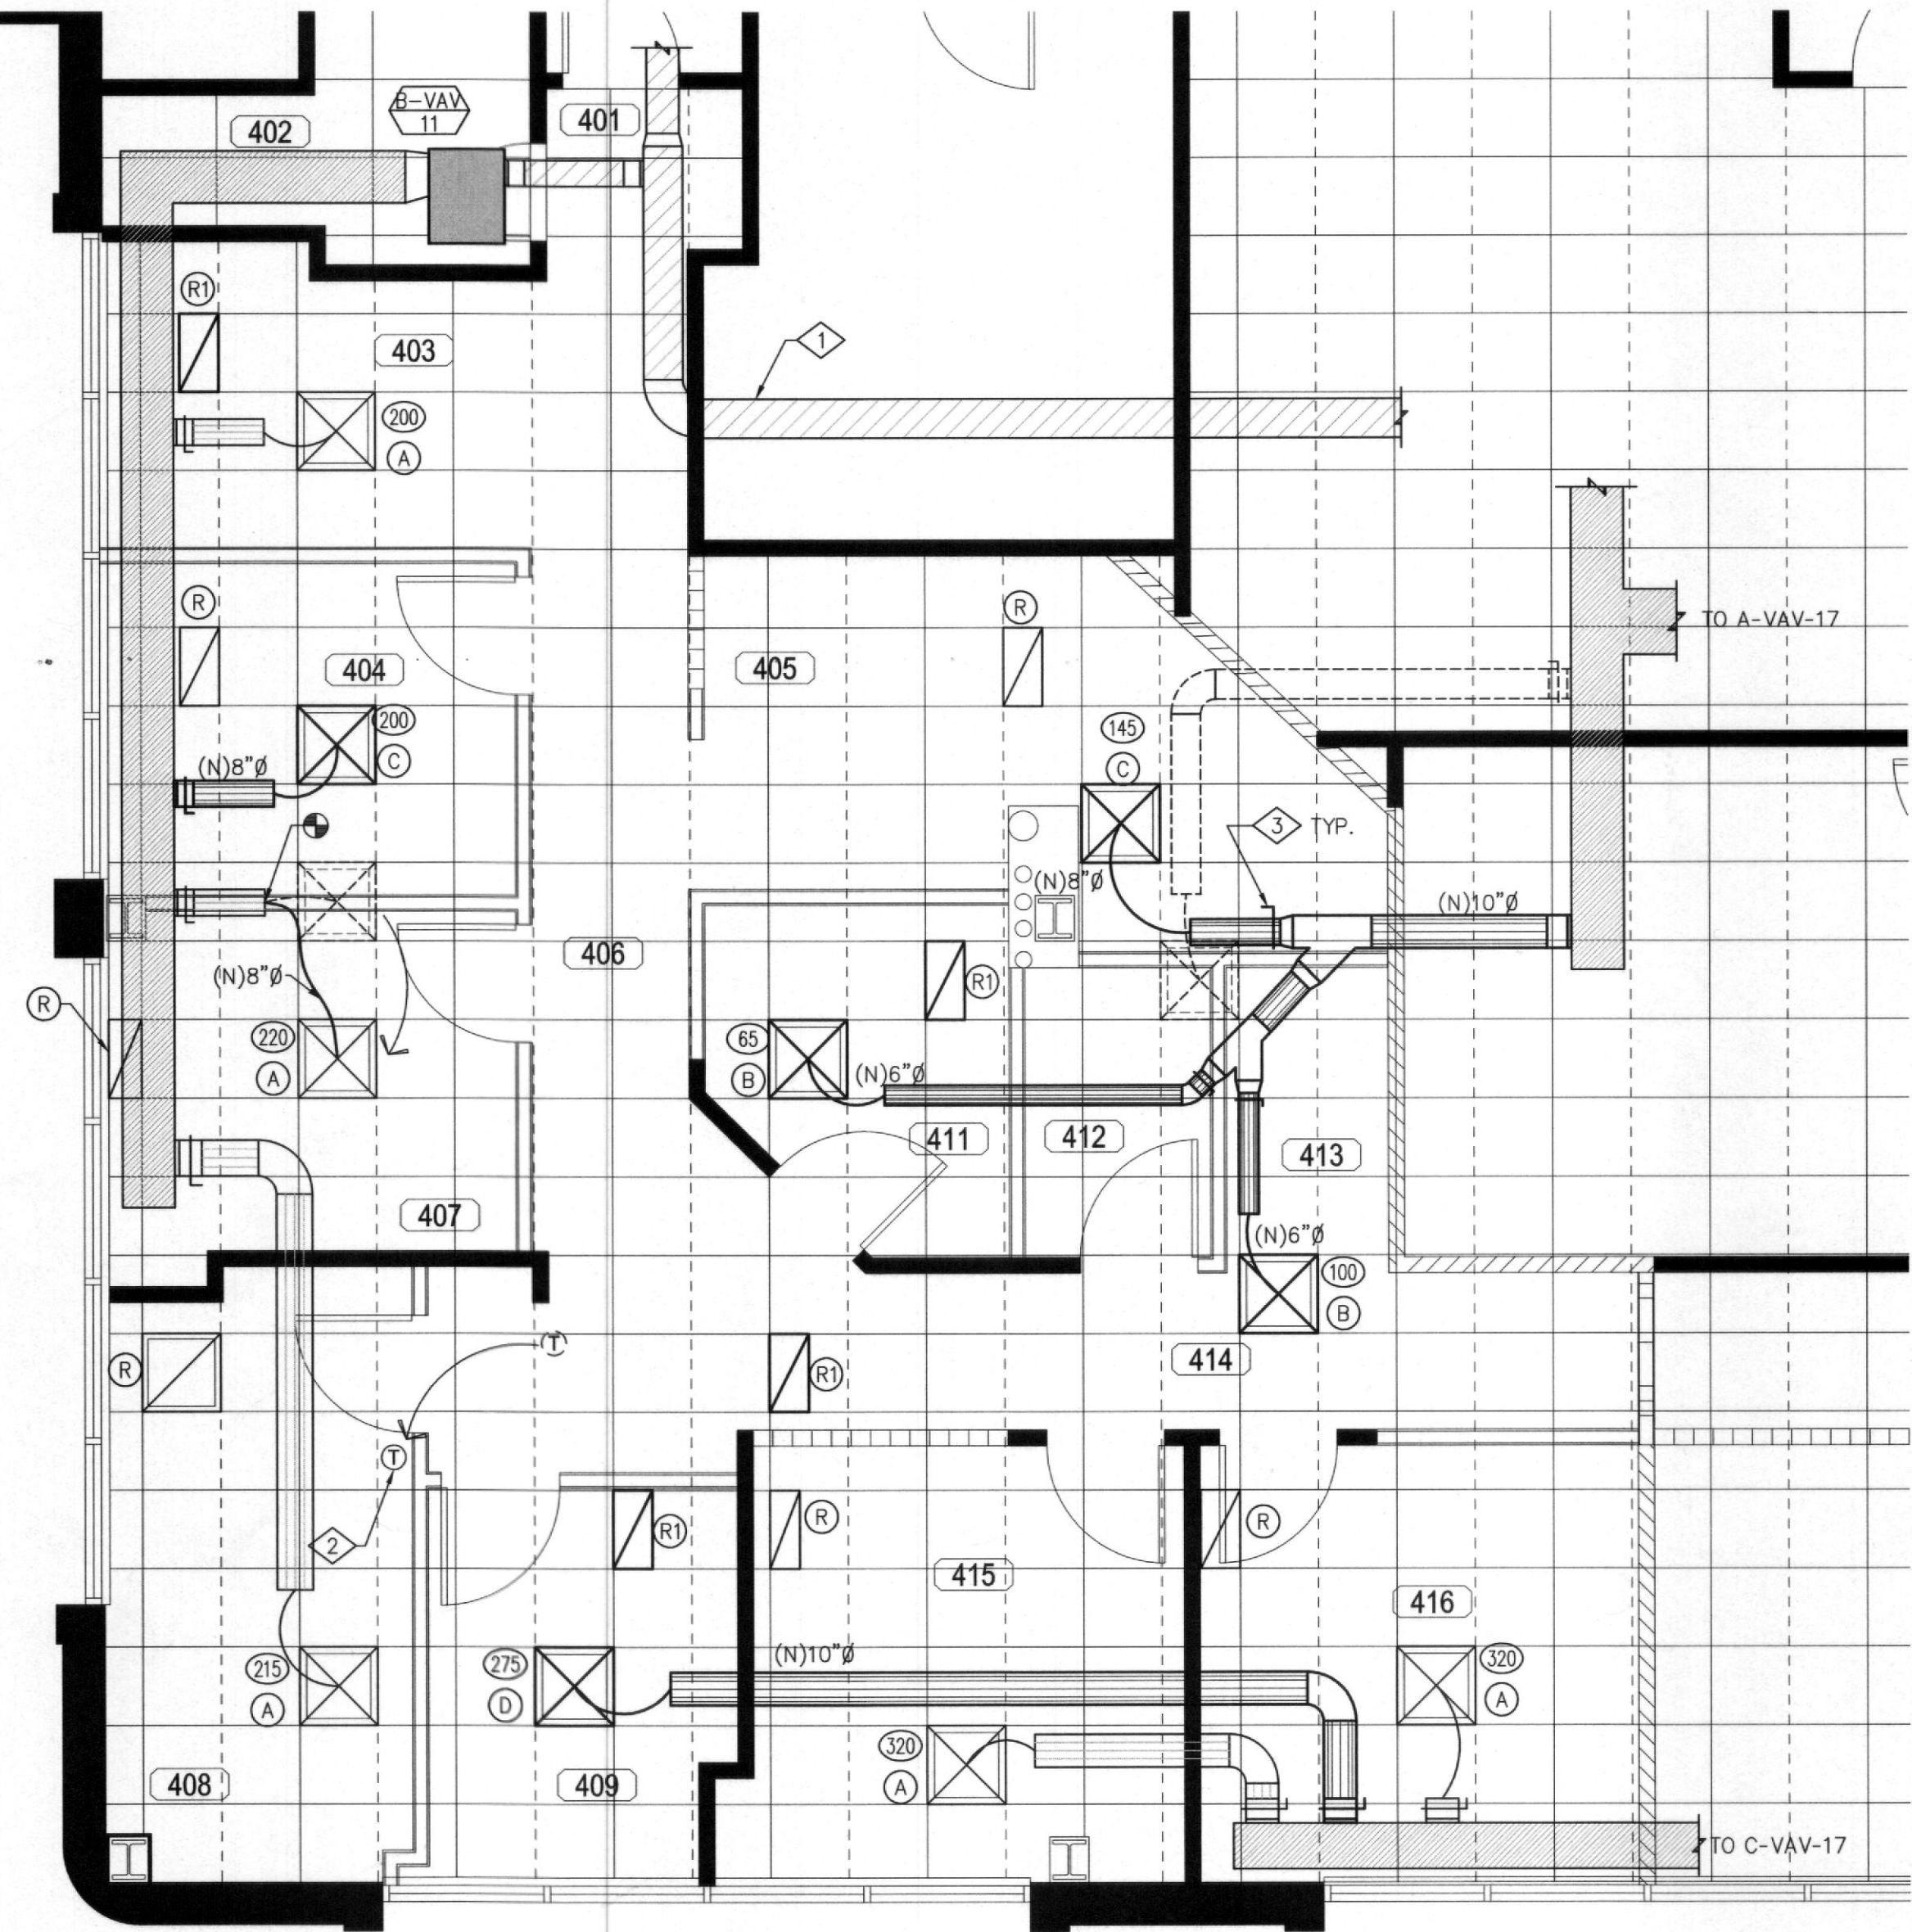

1 MECHANICAL PLAN
M1.0 SCALE: 1/4" = 1'-0"



City of Aurora Building Division
Reviewed for Code Compliance
Approved as Noted: **W. Griffin**
Date: **Feb 21, 2018**
2015 INTERNATIONAL CODES & 2017 NEC

RSN: 1268800
Permit #: 18-1420046 TF

BRIAN SEYFERTH & ASSOCIATES, INC.



PROFESSIONAL ENGINEER
5583 South Prince Street
Littleton, Colorado 80120
Phone: (303) 797-7772
Fax: (303) 797-7773
BSA # 17435

1411 South Potomac
1411 South Potomac
Aurora, CO 80012
Suite 420



Lynn Institute

Dates of Record

Project Start Date:

Issued On: 16 NOV 2017 Issued For: Tenant's Review & Approval, and Construction

Sheet
Contents

Project Team
Project Number
Sheet
Mark


MECHANICAL
PLAN
& SCHEDULES
BSLC

M1.0

ELECTRICAL GENERAL NOTES - APPLICABLE TO ALL ELECTRICAL SHEETS

1. PRIOR TO SUBMITTING BIDS THE ELECTRICAL CONTRACTOR SHALL VISIT THE SITE TO VERIFY EXISTING ELECTRICAL EQUIPMENT CONDITIONS AND DIFFICULTIES THAT WILL AFFECT EXECUTION OF THE WORK. FIELD VERIFY QUANTITIES OF EXISTING ELECTRICAL EQUIPMENT AND ELECTRICAL DEVICES. FIRE ALARM DEVICES, AND ELECTRICAL EQUIPMENT. NOTIFY THE ARCHITECT AND ENGINEER OF ANY EXISTING CONDITIONS WHICH MODIFY THE SCOPE OF WORK AS SHOWN ON THE CONSTRUCTION DOCUMENTS. SUBMISSION OF A BID PROPOSAL WILL BE CONSIDERED AS EVIDENCE THAT SUCH AN EXAMINATION HAS BEEN MADE AND LATER CLAIMS FOR MOBILIZATION, LABOR, EQUIPMENT, AND/OR MATERIALS REQUIRED BECAUSE OF DIFFICULTIES ENCOUNTERED WILL NOT BE RECOGNIZED.
2. THE ELECTRICAL CONTRACTOR SHALL EXAMINE THE DRAWINGS OF ALL TRADES WHOSE WORK RELATES TO OR IS DEPENDENT ON ELECTRICAL WORK TO BECOME FULLY INFORMED OF THE EXTENT AND CHARACTER OF THEIR SPECIFIED WORK AND BE ABLE TO COORDINATE IT WHILE AVOIDING POSSIBLE INTERFERENCE WITH THE ELECTRICAL WORK.
3. IT IS THE INTENTION OF THESE SPECIFICATIONS AND DRAWINGS TO CALL FOR FINISHED WORK, TESTED AND READY FOR OPERATION. WHEREVER THE WORD "PROVIDE" IS USED, IT SHALL MEAN "FURNISH AND INSTALL COMPLETE AND READY FOR USE." "REPLACE" SHALL MEAN TO PUT NEW IN PLACE OF EXISTING. THE ARCHITECTURAL GENERAL AND SPECIAL CONDITIONS FOR THE WORK OF THIS PROJECT AND BASE BUILDING SPECIFICATIONS SHALL BE PART OF THE ELECTRICAL SPECIFICATIONS. THE ELECTRICAL CONTRACTOR SHALL EXAMINE THE GENERAL AND SPECIAL CONDITIONS BEFORE SUBMITTING A BID.
4. ALONGSIDE SUBMISSION OF THE BID, THE ELECTRICAL CONTRACTOR SHALL GIVE WRITTEN NOTICE TO THE ARCHITECT/ENGINEER OF ANY EXISTING ELECTRICAL OR WORK THAT HAVE BEEN OMITTED FROM THE DRAWINGS OR SPECIFICATIONS. IN THE ABSENCE OF SUCH WRITTEN NOTICE, IT IS MUTUALLY AGREED THAT THE ELECTRICAL CONTRACTOR HAS INCLUDED THE COST OF ALL REQUIRED ITEMS IN HIS BID, AND THAT THE ELECTRICAL CONTRACTOR SHALL BE RESPONSIBLE FOR THE APPROVED SATISFACTORY FUNCTIONING OF THE ENTIRE SYSTEM WITHOUT EXTRA COMPENSATION.
5. THE CONTRACTOR IS RESPONSIBLE FOR THE COMPLETE AND SATISFACTORY ELECTRICAL INSTALLATION IN ACCORDANCE WITH THE TRUE INTENT OF THE DRAWINGS AND SPECIFICATIONS. HE SHALL PROVIDE, WITHOUT EXTRA CHARGE, ALL INCIDENTAL ITEMS REQUIRED, AS A PART OF THIS ELECTRICAL INSTALLATION. THE INSTALLATION SHALL BE SO MADE THAT ITS SEVERAL COMPONENT PARTS WILL FUNCTION TOGETHER AS A WORKABLE SYSTEM AND SHALL BE LEFT WITH ALL PARTS ADJUSTED AND IN WORKING ORDER.
6. ELECTRICAL CONTRACTOR SHALL OBTAIN AND PAY FOR ALL LOCAL FEES, PERMITS, AND SERVICES OF INSPECTION AUTHORITIES REQUIRED BY ELECTRICAL WORK FOR THIS ELECTRICAL CONSTRUCTION. FILE ALL NECESSARY PLANS, PREPARE ALL DOCUMENTS, AND OBTAIN ALL NECESSARY APPROVALS REQUIRED BY ALL LOCAL, STATE, AND FEDERAL GOVERNMENT DEPARTMENTS HAVING JURISDICTION. ALL WORK PERFORMED UNDER THIS CONTRACT SHALL REMAIN EXPOSED TO NEW UNTIL APPROVED BY THE INSPECTION AUTHORITY.
7. ELECTRICAL CONTRACTOR SHALL FULLY COORDINATE WITH OWNER REPRESENTATIVES. ALL ELECTRICAL WORK PERFORMED UNDER THIS CONTRACT SHALL CONFORM WITH LATEST EDITIONS OF THE NATIONAL ELECTRICAL CODE, INTERNATIONAL BUILDING CODE, AND LOCAL BUILDING DEPARTMENT REQUIREMENTS. PERFORM WORK IN ACCORDANCE WITH REQUIREMENTS OF OWNER REPRESENTATIVE.
8. ELECTRICAL CONTRACTOR SHALL NOTIFY THE ARCHITECT AND ENGINEER OF ANY CHANGES REQUIRED BY THE BUILDING MANAGEMENT AND TENANT REPRESENTATIVES.
9. BEFORE STARTING WORK, ELECTRICAL CONTRACTOR SHALL PREPARE AND SUBMIT TO THE ARCHITECT/ENGINEER FIVE (5) SETS OF SHOP DRAWINGS, BROCHURES, INSTALLATION INSTRUCTIONS, AND DESCRIPTIVE EQUIPMENT DATA RELATED TO SPECIFIED EQUIPMENT, WIRING DEVICES, AND ACCESSORIES FOR APPROVAL. ELECTRONIC SUBMITTALS ARE NOT ACCEPTABLE WITHOUT THE APPROVAL OF THE ARCHITECT/ENGINEER. THE CONTRACTOR SHALL IDENTIFY ANY "LONG LEAD TIME" ITEMS WHICH MAY IMPACT THE OVERALL PROJECT SCHEDULE. ALL BIDS SHALL INCLUDE COSTS ASSOCIATED WITH THE PURCHASE AND DELIVERY OF EQUIPMENT TO MEET THE PROJECT SCHEDULE. NO EQUIPMENT SHALL BE PURCHASED OR ORDERED WITHOUT THE APPROVAL OF THE ARCHITECT/ENGINEER. DRAWINGS, BROCHURES, INSTALLATION INSTRUCTIONS, AND SCHEDULES. APPROVAL BY THE ARCHITECT/ENGINEER IS INTENDED TO ESTABLISH CONFORMANCE WITH THE PROJECT DESIGN CONCEPT AND THE REQUIREMENTS OF THE DRAWINGS AND SPECIFICATIONS.
10. THE NAMING OF THE MANUFACTURER OR BRAND WITH CATALOG NUMBER OR OTHER PRODUCT IDENTIFICATION WITHOUT THE WORDS "OR EQUAL" IN THE SPECIFICATIONS OR NOTES SHALL INDICATE THAT IT IS THE ONLY QUALITY PRODUCT APPROVED FOR PURCHASE. IF THE WORDS "OR EQUAL" ARE USED THEY SHALL BE INTERPRETED AS ESTABLISHING A QUALITY OR PERFORMANCE STANDARD FOR THE MATERIAL OR PRODUCT TO BE PURCHASED. THIS SHALL INDICATE THAT THE ELECTRICAL CONTRACTOR IS NOT RESTRICTED TO THE IDENTIFICATION OF THE IDENTIFIED PRODUCT IF A SUBSTITUTE APPROVED BY THE ARCHITECT/ENGINEER IS AVAILABLE. HOWEVER, WHERE A SUBSTITUTION IS REQUESTED, IT WILL BE PERMITTED ONLY WITH THE WRITTEN APPROVAL OF THE ARCHITECT/ENGINEER. NO SUBSTITUTE MATERIAL OR PRODUCT SHALL BE ORDERED, FABRICATED, SHIPPED OR PROCESSED IN ANY MANNER PRIOR TO THE APPROVAL OF THE ARCHITECT/ENGINEER. THE ELECTRICAL CONTRACTOR SHALL ASSUME ALL RESPONSIBILITY FOR ADDITIONAL EXPENSES AS REQUIRED MAKING CHANGES FROM THE ORIGINAL MATERIAL OR PRODUCT SPECIFIED.
11. THE ELECTRICAL DRAWINGS ARE DIAGRAMMATIC AND INDICATE THE GENERAL ARRANGEMENT OF ELECTRICAL WORK. LOCATIONS ARE APPROXIMATE AND SHALL BE SUBJECT TO MINOR MODIFICATIONS AS DIRECTED BY THE GENERAL CONTRACTOR AND OWNER REPRESENTATIVES. THE ELECTRICAL CONTRACTOR SHALL BE RESPONSIBLE FOR THE EXACT FITTING OF ALL MATERIALS, EQUIPMENT, ETC., IN THE BUILDING AND TENANT SPACE. ALL DIMENSIONS SHALL BE VERIFIED ON THE JOB.
12. DRAWINGS SHALL NOT BE SCALED FOR ROUGH-IN MEASUREMENTS OR USED AS SHOP DRAWINGS, WHERE DIMENSIONS ARE SHOWN ON PLANS OR DETAILS, THESE DIMENSIONS ARE TO BE FIELD-VERIFIED BY THE ELECTRICAL CONTRACTOR AGAINST EXISTING FIELD CONDITIONS, INSTALLATION REQUIREMENTS, AND OTHER TRADES AND THE MANUFACTURER'S SUBMITTALS FOR EQUIPMENT TO BE INSTALLED. SHOULD ANY CONFLICTS ARISE WHICH CANNOT BE EASILY RESOLVED IN THE FIELD WITHOUT CHANGING THE DESIGN INTENT, THE ELECTRICAL CONTRACTOR SHALL NOTIFY THE ENGINEER IMMEDIATELY.
13. WHILE ALL WORK IS IN PROGRESS, EXCEPT FOR SHORT DESIGNATED INTERVALS DURING WHICH CONNECTIONS ARE TO BE MADE, CONTINUITY OF SERVICE TO ALL EXISTING SYSTEMS SERVING OCCUPIED SPACES SHALL BE MAINTAINED. THE CONTRACTOR SHALL COORDINATE AND COOPERATE WITH OWNER AT ALL TIMES FOR ALL NEW-TO-EXISTING CONNECTIONS, SYSTEM SHUTDOWNS, AND RESTART-UP.
14. ANY WORK WHICH WILL AFFECT THE BUILDING OCCUPANTS, INCLUDING, BUT NOT LIMITED TO WORK WHICH GENERATES EXCESSIVE NOISE, DUST, SMOKE, OR INCONVENIENCE TO BUILDING OCCUPANTS, SHALL BE PERFORMED AFTER BUSINESS HOURS. UNLESS PRIOR APPROVAL HAS BEEN OBTAINED FROM THE BUILDING MANAGER OR OWNER.
15. ELECTRICAL ITEMS AFFECTED BY REMODEL WORK ARE SHOWN ON DRAWINGS ALONG WITH EXISTING ELECTRICAL INSTALLATION SHOWN WITH LIGHT LINE WEIGHT. EXISTING ELECTRICAL INSTALLATION SHOWN IS NOT NECESSARILY ALL-INCLUSIVE. RETAIN CIRCUIT CONTINUITY FOR EXISTING ELECTRICAL EQUIPMENT, FIXTURES, AND DEVICES THAT ARE TO REMAIN. SUCH EQUIPMENT SHALL BE RECONNECTED TO EXISTING CIRCUITS OR CONNECTED TO NEW CIRCUITS AS INDICATED ON THE DRAWINGS. ENSURE ALL ELECTRICAL DEVICES IN WORK AREA ARE FULLY FUNCTIONAL. FOR DEVICES OR JUNCTION BOXES LOCATED IN WALLS, THAT MUST REMAIN IN PLACE FOR CIRCUIT CONTINUITY, PROVIDE BLANK COVER PLATES TO MATCH WALL PLATES STYLE IN THE AREA OF WORK. FOR ALL OTHER UNUSED JUNCTION BOXES, REMOVE WIRING AND PROVIDE BLANK COVER PLATE, OR COORDINATE WITH GENERAL CONTRACTOR FOR PATCHING OF WALL TO MATCH ADJACENT SURFACE AS DIRECTED BY ARCHITECT. WHERE EXISTING DEVICES CONFLICT WITH NEW WALL CONSTRUCTION, RELOCATE EXISTING DEVICES AND REWORK CIRCUITRY AS REQUIRED TO MAINTAIN CIRCUIT CONTINUITY. DEVICES MAY ONLY BE REMOVED WITH PRIOR APPROVAL FROM THE DESIGN TEAM AND BUILDING MANAGEMENT. COORDINATE FINAL DIRECTIONS WITH ARCHITECT PRIOR TO DEMOLITION.
16. REPORT ANY EXISTING DAMAGED EQUIPMENT OR SYSTEMS TO THE OWNER PRIOR TO BEGINNING THE PROJECT.
17. BEFORE ANY EQUIPMENT IS INSTALLED, DETERMINE THAT SAID EQUIPMENT WILL PROPERLY FIT WITHIN THE SPACE ALLOCATED. INSTALL ALL EQUIPMENT AND MATERIALS IN SUCH A MANNER AS TO PROVIDE REQUIRED ACCESS FOR SERVICING AND MAINTENANCE. ALLOW AMPLE SPACE FOR REMOVAL OF ALL PARTS THAT REQUIRE REPLACEMENT OR SERVICING.
18. MINIMUM WORKING CLEARANCES PER THE LATEST EDITION OF THE NATIONAL ELECTRICAL CODE SHALL BE PROVIDED AROUND AND IN FRONT OF ALL ELECTRICAL EQUIPMENT.
19. ALL CIRCUIT BREAKER LUGS SHALL BE RATED FOR A MINIMUM OF 75 DEGREES CELSIUS.
20. ALL MATERIALS AND EQUIPMENT SHALL BE NEW, UNDamaged, BEAR THE UL LABEL WHERE APPLICABLE, AND BE AS SPECIFIED FOR USE IN EACH SPECIFIC LOCATION. ANY INCIDENTAL ACCESSORIES NECESSARY TO COMPLETE THE WORK IN ALL RESPECTS AND SHALL BE INSTALLED SYMMETRICALLY WITH OTHER PANELS OR DEVICES AND SHALL BE MINIMUM SIZE REQUIRED. "MUD-IN" TYPE, AND FIRE RATED, IF REQUIRED. ACCESS PANELS IN FIRE-RATED WALLS AND CEILINGS SHALL HAVE PROPER UL LABEL AND FIRE RATING LISTING.
21. MINOR DETAILS NOT USUALLY SHOWN OR SPECIFIED, BUT NECESSARY FOR THE PROPER INSTALLATION AND OPERATION OF A SYSTEM OR EQUIPMENT, SHALL BE INCLUDED IN THE ELECTRICAL CONTRACTOR'S ESTIMATE, AS IF SPECIFIED HEREIN OR SHOWN.
22. ALL NEW, RELOCATED AND EXISTING MATERIALS, IN CEILING PLenums, NOT ENCLOSED IN CONDUIT SHALL HAVE CLASS, FLAME SPREAD AND SMOKE DEVELOPMENT RATINGS AS REQUIRED FOR USE IN OPEN PLenums. REMOVE AND REPLACE ALL EXISTING MATERIALS IN WORK AREA NOT IN COMPLIANCE.
23. COORDINATE THE INSTALLATION OF ELECTRICAL MATERIALS AND EQUIPMENT ABOVE AND BELOW CEILINGS WITH SUSPENSION SYSTEM, MECHANICAL EQUIPMENT, AND OTHER BUILDING COMPONENTS. ALL COMPONENTS SHALL BE LOCATED AS CLOSE TO STRUCTURE AS POSSIBLE. COORDINATE CEILING CAVITY SPACE CAREFULLY WITH ALL TRADES.
24. NEUTRALS, RACEWAYS, AND NON-CURRENT CARRYING PARTS OF ELECTRICAL EQUIPMENT AND ASSOCIATED ENCLOSURES SHALL BE GROUNDED IN FULL ACCORDANCE WITH THE NATIONAL ELECTRICAL CODE. PROVIDE HARD WIRE GROUND CONNECTIONS TO ALL DEVICES AND SEPARATE, CONTINUOUS, INSULATED GROUND WIRE IN EACH CIRCUIT (#12 CU MINIMUM "GREEN" TRACER GROUND). COORDINATE EQUIPMENT GROUNDING CONDUCTOR WIRE SIZE WITH MANUFACTURER REQUIREMENTS.
25. CONDUIT JOINTS SHALL BE CUT SQUARE, THEADED, REAMED SMOOTH, AND DRAIN UP TIGHT. BENDS OR OFFSETS SHALL BE MADE WITH AN APPROVED BENDER OR HICKEY, OR HUB-TYPE CONDUIT FITTINGS. THE NUMBER OF BENDS PER RUN SHALL CONFORM TO THOSE STATED IN CURRENT NEC.
26. WHERE POSSIBLE ALL WIRING SHALL BE RUN CONCEALED. ALL HOME RUNS SHALL BE EMIT CONCEALED CONDUIT SYSTEMS SHALL BE RUN IN A DIRECT LINE WITH LONG SWEET BENDS AND OFFSETS. EXPOSED CONDUIT RUNS SHALL BE PARALLEL TO AND AT RIGHT ANGLES TO BUILDING LINES, USING CONDUIT FITTINGS FOR ALL TURNS AND OFFSETS. ALL EMPTY CONDUITS SHALL BE "MUCED" WITH PULL WIRES AND BUSHINGS.
27. "M1" AND "M2" TYPE CABLE WITH INTERNAL GROUND WIRES SHALL BE PERMITTED FOR BRANCH CIRCUIT WIRING WHERE APPROVED IN WRITING BY BUILDING MANAGEMENT AND THE LOCAL AUI ONLY AND INSTALLED PER NATIONAL ELECTRICAL CODE AND LOCAL BUILDING DEPARTMENT REQUIREMENTS. USE LISTED AND APPROVED TYPE COUPLINGS AND CONNECTORS. PROVIDE CONDUIT SUPPORTS AS REQUIRED BY THE NATIONAL ELECTRICAL CODE AS A MINIMUM.
28. ALL ROOF PENETRATIONS SHALL BE SEALED WATER TIGHT, PROVIDE FLASHING AND COUNTER FLASHING AS REQUIRED. COORDINATE ROOFING WORK WITH THE GENERAL CONTRACTOR.
29. ELECTRICAL CONTRACTOR SHALL FURNISH AND INSTALL JUNCTION AND PULL BOXES TO PROVIDE ACCESS POINTS FOR PULLING AND FEEDING CONDUCTORS INTO A RACEWAY SYSTEM. JUNCTION AND PULL BOXES AND THEIR COVERS SHALL BE FORMED FROM SHEET STEEL AND SHALL BE FINISHED IN GRAY ENAMEL PAINT. BOXES SHALL BE IN INDUSTRY STANDARD SIZES. OUTLET BOXES WITH THE CORRECT FITTING FOR THE APPLICATION SHALL BE LOCATED AT EACH CONDUCTOR SPLIT POINT, AT EACH OUTLET, SWITCH POINT, OR JUNCTION POINT, AND AT EACH PULL POINT FOR THE CONNECTION OF CONDUIT AND OTHER RACEWAYS. OUTLET BOXES FOR CONDUIT WIRING SHALL BE MADE FROM GALVANIZED OR CADMIUM-PLATED SHEET STEEL, AND THEY SHALL HAVE A DEPTH OF AT LEAST 1.5 INCHES, WHETHER SINGLE OR GANGED. THE BOXES SHALL BE LARGE ENOUGH SIZE TO ACCOMMODATE THE NUMBER OF WIRING DEVICES AND CONDUCTORS AS SPECIFIED IN THE FILL SCHEDULE OF THE CURRENT NEC. SECURE BOXES WITH MOUNTING BRACKET, BRACES, HANGER OR BOX MOUNTING SUPPORT.
30. ALL NEW SWITCHES, POWER OUTLETS, TELEPHONE OUTLETS, FIRE ALARM DEVICES, AND COMMUNICATIONS OUTLETS SHALL MEET THE REQUIREMENTS FOR AMERICANS WITH DISABILITIES (ADA) MOUNTING HEIGHTS AND ORIENTATIONS, TYPICAL UNLESS OTHERWISE NOTED. RECEPTABLES SHALL BE A MINIMUM OF 15" A.F.F. AND SWITCHES A MAXIMUM OF 48" A.F.F. TO CENTERLINE, TYPICAL UNLESS OTHERWISE NOTED.
31. ALL WALL MOUNTED OUTLETS SHALL BE OFFSET SO THEY ARE NOT BACK TO BACK, FOR SOUND TRANSMISSION PURPOSES. A HORIZONTAL DISTANCE OF AT LEAST 6 INCHES SHALL SEPARATE OUTLET BOXES ON OPPOSITE SIDES OF WALLS AND PARTITIONS. MOUNT ELECTRICAL AND COMMUNICATIONS OUTLETS ON WALLS AS CLOSE TOGETHER AS POSSIBLE.
32. WIRING DEVICES SHALL BE SPECIFICATION GRADE. MINIMUM DEVICE RATING SHALL BE 20 AMPS FOR ALL WIRING DEVICES UNLESS SPECIFICALLY NOTED OTHERWISE. DEVICES WITH DESIGNATED CIRCUITS SHALL BE RATED AS REQUIRED BY CIRCUIT LOAD. ISOLATED GROUND RECEPTABLES SHALL BE ORANGE. WIRE COLOR CODING IS TO EXISTING BUILDING STANDARD. BUILDING MATCHING NYLON COVER PLATES FOR ALL OUTLETS. ELECTRICAL CONTRACTOR SHALL VERIFY ALL OUTLETS WITH ARCHITECTURAL PLANS AND TENANT BEFORE ORDERING AND PURCHASING OF MATERIALS.
33. FIRE RESISTIVE WALLS AND PARTITIONS MAY HAVE OPENINGS FOR STEEL ELECTRICAL OUTLET BOXES NOT EXCEEDING 16 SQUARE INCHES IN AREA. PROVIDED THE ADEQUATE AREA OF SUCH OPENINGS IS NOT MORE THAN 100 SQUARE INCHES FOR ANY 100 SQUARE FEET OF WALL. A HORIZONTAL DISTANCE OF AT LEAST 24 INCHES SHALL SEPARATE OUTLET BOXES ON OPPOSITE SIDES OF FIRE RESISTIVE WALLS AND PARTITIONS.
34. ALL JUNCTION BOX COVERS SHALL BE INDENIBLY LABELED WITH PANEL DESIGNATION AND BRANCH CIRCUIT NUMBER OF EACH WIRE WITHIN THE JUNCTION BOX.
35. ALL WIRING SHALL BE COPPER, TYPE THHN OR THWN INSULATION, UNLESS SPECIFICALLY NOTED OTHERWISE. MINIMUM SIZE SHALL BE #12 AWG. CONDUCTORS SHALL BE FACTORY COLOR-CODED WITH WIRE COLOR CODING AS REQUIRED BY THE NATIONAL ELECTRICAL CODE AND USING STANDARD CONDUCTOR COLOR CODES:
- 120/208 VOLTS: A: BLACK B: RED C: BLUE D: WHITE E: GREEN ISO: G: GREEN W/YELLOW STRIPE
- 277/480 VOLTS: A: BROWN B: ORANGE C: YELLOW D: WHITE E: GRAY G: GREEN
36. RECEPTABLES FOR COMPUTERS, COPIERS, AND PRINTERS, WHICH ARE SEMI-DEDICATED, DEDICATED, OR ISOLATED, SHALL HAVE A SEPARATE NEUTRAL AND DEDICATED GROUND CONDUCTOR RUN FROM THE BRANCH CIRCUIT PANEL BOARD.
37. ALL JOINTS OR SPLICES FOR 10 AWG. CONDUCTORS OR SMALLER SHALL BE MADE WITH UL-APPROVED WIRE NUTS, OR COMPRESSION-TYPE CONNECTORS.
38. ALL JOINTS OR SPLICES FOR CONDUCTORS 8 AWG AND LARGER SHALL BE MADE WITH A MECHANICAL COMPRESSION OR BOLTED CONNECTION. AFTER THE CONDUCTORS HAVE BEEN MADE MECHANICALLY AND ELECTRICALLY SECURE, THE ENTIRE JOINT OR SPLICE SHALL BE COVERED WITH 3M SCOTCH BRAND NO. 33 TAPE OR APPROVED EQUAL, TO MAKE THE INSULATION VALUE AT THE JOINT OR SPLICE EQUAL TO THE VALUE OF THE CONDUCTOR INSULATION. ALL CONNECTORS SHALL BE UL APPROVED.
39. ALL NEW MULTI-WIRE BRANCH CIRCUITS SHALL INCLUDE SEPARATE NEUTRAL CONDUCTORS OR BREAKER TIES AS REQUIRED BY CURRENT NEC SECTION 210.4 (B).
40. VOLTAGE DROP: THE ELECTRICAL CONTRACTOR SHALL ENSURE THAT VOLTAGE DROP FOR FEEDERS TO DISTRIBUTION EQUIPMENT DOES NOT EXCEED 2% AND VOLTAGE DROP IN BRANCH CIRCUITS DOES NOT EXCEED 3% FOR OVERALL VOLTAGE DROP OF 5% (MAXIMUM). FEEDERS LISTED ON SCHEDULES AND THE ELECTRICAL ONE-LINE DIAGRAM ARE A BASE FEEDER/BRANCH CIRCUIT SIZE AND SHALL BE ADJUSTED AS NEEDED BASED ON ACTUAL LENGTHS OF CONDUCTORS.
41. ELECTRICAL CONTRACTOR SHALL UP SIZE SHARED NEUTRAL CONDUCTOR WITHIN FURNITURE SYSTEMS TO A #10 AWG CU CONDUCTOR. ELECTRICAL CONTRACTOR TO CONSIDER THE NEUTRAL CONDUCTOR AS A CURRENT CARRYING CONDUCTOR WHEN FEEDING ELECTRONIC LOADS.
42. ALL LIGHT FIXTURES SHALL BE SUPPORTED INDEPENDENTLY FROM STRUCTURE. REFER TO ARCHITECTURAL PLANS FOR EXACT LOCATIONS OF LIGHT FIXTURES AND ELECTRICAL DEVICES.
43. FOR ALUMINUM CONDUCTOR TERMINATIONS, ALUMINUM BI-METALLIC PIN CONNECTORS ARE REQUIRED UNLESS COMPACT CONDUCTORS ARE USED. THESE CONNECTORS SHALL BE UL LISTED FOR USE AND RATED FOR USE UP TO 600V AND TEMPERATURE UP TO 90°C. CONNECTORS SHALL BE INSTALLED WITH MANUFACTURER'S SPECIFIED CRIMPING TOOLS AND DIES.
44. INSTALLATION IN AREAS OF DRYWALL CEILING SHALL BE COORDINATED SUCH THAT

- ACCESS PANELS ARE NOT REQUIRED. ELEMENTS REQUIRING ACCESS SHALL BE LOCATED IN THE AREAS OF ACCESSIBLE CEILING OR IN THE LOCATIONS COORDINATED WITH ARCHITECT. ACCESS PANELS REQUIRED WITHIN DRYWALL CEILINGS SHALL BE INSTALLED SYMMETRICALLY WITH OTHER PANELS OR DEVICES AND SHALL BE MINIMUM SIZE REQUIRED. "MUD-IN" TYPE, AND FIRE RATED, IF REQUIRED. ACCESS PANELS IN FIRE-RATED WALLS AND CEILINGS SHALL HAVE PROPER UL LABEL AND FIRE RATING LISTING.
45. WALL AND CEILING ROUGH-IN INSTALLATIONS FOR LOW-VOLTAGE CONTROL WIRING OF ANY TYPE SUCH AS DATA/TELECOMMUNICATIONS WIRING, FIRE ALARM WIRING, HVAC CONTROL WIRING, SECURITY SYSTEMS WIRING, TV CABLING, OPTICAL FIBER CABLES, ETC. SHALL BE COMPLETELY AND FULLY INSTALLED PRIOR TO TIME ELECTRICAL ROUGH-IN INSPECTIONS ARE REQUESTED. ALL SHARP EDGES, CONDUIT ENDS AND METAL STUDS, ETC. FOR LOW-VOLTAGE CABLING SHALL BE PROTECTED BY INSULATED BUSHINGS OR GROMMETS AND SECURELY FASTENED IN THE OPENINGS FOR THE WALL, ROUGH-IN INSPECTIONS. WORK SHALL BE INSTALLED IN A NEAT AND WORKMANLIKE MANNER (GROUPED CABLES ROUTED WITH SQUARE CORNERS AND PARALLEL TO BUILDING LINES). CABLES SHALL BE INSTALLED PER NEC REQUIRED SEPARATIONS AND SUPPORTED FROM THE BUILDING STRUCTURE. CABLE TIES IN DUCTS, PLenums, AND OTHER AIR-HANDLING SPACES ARE REQUIRED TO HAVE A TESTING LABORATORY LISTING NUMBER AND LABEL ON EACH UNOPENED PACKAGE AS BEING APPROVED FOR USE IN THESE LOCATIONS.
46. COORDINATE MOUNTING HEIGHTS AND LOCATIONS OF ALL ELECTRICAL DEVICES LOCATED WITHIN, ABOVE, OR NEAR MILLWORK WITH ARCHITECTURAL DRAWINGS, APPROVED "SHOP DRAWINGS", AND MILLWORK CONTRACTOR. MAINTAIN CONSISTENT MOUNTING PRACTICES FOR A UNIFORM APPEARANCE. VERIFY ALL OUTLET REQUIREMENTS PRIOR TO ROUGH IN.
47. ELECTRICAL CONTRACTOR SHALL COORDINATE EXACT LOCATIONS OF LIGHTING FIXTURES IN MECHANICAL ROOMS/SPACES WITH MECHANICAL DUCT WORK INSTALLER PRIOR TO ROUGH IN. LOCATE BELOW DUCT WORK (8"-0" A.F.F. MIN.) CENTERED IN ROOM AS MUCH AS POSSIBLE.
48. ELECTRICAL CONTRACTOR SHALL COMPLY WITH NEC AND LOCAL CODES FOR CONDUIT FILL REQUIREMENTS DEPENDING ON WIRE SIZES, QUANTITY, AND CORRECTION FACTORS. COORDINATE WITH LOCAL AUTHORITY HAVING JURISDICTION IF UPGRADE OF THE EXISTING ELECTRICAL INSTALLATION IS REQUIRED. THIS UPGRADE INCLUDES REPLACEMENT OF THE EXISTING CONDUITS AND WIRING AFFECTED BY THIS PROJECT TO ACCOMMODATE CURRENT CODE CONDUIT FILL AND CORRECTION REQUIREMENTS. INCLUDE COST ASSOCIATED WITH THIS UPGRADE IN THE BID.
49. ELECTRICAL CABINETS AND ENCLOSURES LOCATED IN PUBLIC AREAS SHALL BE LOCKABLE TYPE.
50. PENETRATIONS THROUGH STRUCTURAL MEMBERS SHALL NOT BE PERMITTED WITHOUT SPECIFIC WRITTEN PERMISSION FROM STRUCTURAL ENGINEER AND ARCHITECT. SUBMIT REQUESTS FOR PENETRATIONS TO ARCHITECT FOR REVIEW AND DISPOSITION. PRIOR TO CORE, DRILLING THROUGH FLOORS, VERIFY CLEARANCE OF BEAMS, JOISTS, AND OTHER STRUCTURAL MEMBERS. X-RAY FOR CONDUIT AND/OR REBAR IN SLAB. COORDINATE WITH BUILDING MANAGEMENT/OWNER TO INFORM TENANT BELOW FOR SCHEDULING OF CORE DRILLING AND TO ADVISE CONCERNING PROTECTION FOR ANY SENSITIVE EQUIPMENT PRIOR TO COMMENCEMENT OF WORK. ALL X-RAYS AND CORE DRILLS MUST BE SCHEDULED FOR AFTER 9 AM UNLESS BUILDING MANAGEMENT/OWNER AUTHORIZES OTHERWISE.
51. RACEWAYS SHALL BE PROVIDED WITH EXPANSION FITTINGS WHERE NECESSARY TO COMPENSATE FOR THERMAL EXPANSION AND CONTRACTION TO ALLOW FOR MINOR MOVEMENT OF THE STRUCTURAL ELEMENTS OF THE BUILDING EXPANSION FITTINGS FOR METAL RACEWAYS SHALL BE MADE ELECTRICALLY CONTINUOUS BY EQUIPMENT BONDING JUMPERS OR OTHER MEANS.
52. PROVIDE TYPEWRITTEN, UPDATED PANELBOARD DOOR DIRECTORIES FOR ALL APPLIED PANELS PER NEC 408.4, REFLECTING ACCURATE BRANCH CIRCUIT DESTINATIONS. CLEARLY MARK JUNCTION BOXES IN CEILING SPACE WITH PANEL DESIGNATIONS AND CIRCUIT NUMBERS. PROVIDE NEW ENGRAVED PLASTIC LABELS TO REPLACE ANY DAMAGED MISLABELLED, TEMPORARY OR OTHERWISE ILLEGIBLE EXISTING IDENTIFICATION LABELS FOR DISTRIBUTION EQUIPMENT AFFECTED BY THIS CONTRACT. ATTACH THESE LABELS TO THE GENERAL CONTRACTOR AND ARCHITECT/ENGINEER. THIS CONTRACT WILL NOT BE CONSIDERED COMPLETED UNTIL THESE RECORD DRAWINGS HAVE BEEN RECEIVED AND REVIEWED BY THE ENGINEER.
53. CLEAN EXPOSED PANEL BOARD SURFACES AND CHECK TIGHTNESS OF ELECTRICAL CONNECTIONS. REPLACE DAMAGED CIRCUIT BREAKERS AS REQUIRED AND PROVIDE CLOSURE PLATES FOR VACANT SPACES. ALL NEW PANELS PROVIDED UNDER THIS CONTRACT SHALL BE DOOR-IN-DOOR CONSTRUCTION TYPE, WITH BOLT-ON CIRCUIT BREAKERS AND COVER BUSHING, UNLESS SPECIFICALLY NOTED OTHERWISE.
54. PROVIDE FIRE STOPPING MATERIAL AND SYSTEMS AS LISTED IN THE UL FIRE RESISTIVE DIRECTORY EQUAL TO THE FIRE RESISTIVE RATING OF THE RESPECTIVE WALL OR FLOOR ASSEMBLY FOR ALL PENETRATIONS OF CONDUIT, SLEEVES, WIRING, CABLES AND OTHER ELECTRICAL ITEMS THROUGH FIRE-RATED CORRIDOR WALLS, FIRE RESISTIVE WALLS, FIRE RESISTIVE SHAFTS, AND FLOOR PENETRATIONS.
55. VERIFY ALL SPECIFIC KITCHEN AND BREAK ROOM EQUIPMENT REQUIREMENTS WITH EQUIPMENT SUPPLIER PRIOR TO ROUGH IN. COORDINATION SHALL INCLUDE MOUNTING HEIGHTS, CONNECTION TYPE, AND POWER REQUIREMENTS. ALL CONNECTIONS FOR KITCHEN EQUIPMENT SHALL BE IN ACCORDANCE WITH EQUIPMENT MANUFACTURER'S AND SUPPLIER'S RECOMMENDATIONS. PROVIDE CORD AND PLUG FOR DISHWASHERS AND GARBAGE DISPOSER PER NEC 422.16(B)(1) AND (2).
56. SECURITY: ELECTRICAL CONTRACTOR SHALL COORDINATE EXACT LOCATIONS AND REQUIREMENTS FOR J-BOX ROUGH-INS, CONDUIT RUNS WITH PULL WIRE AND POWER REQUIREMENTS FOR AN INDIVIDUAL DISCONNECTING MEANS WITH SECURITY SYSTEM CONTRACTOR PRIOR TO ROUGH-IN. THE SECURITY SYSTEM CONTRACTOR SHALL ALSO COORDINATE WORK WITH FIRE ALARM CONTRACTOR FOR COORDINATION OF THE INTERCONNECTION OF THE SECURITY SYSTEM WITH FIRE ALARM SYSTEM AS REQUIRED PER LOCAL CODES AND FIRE DEPARTMENT REGULATIONS.
57. AUDIO-VISUAL EQUIPMENT: ELECTRICAL CONTRACTOR SHALL COORDINATE EXACT LOCATIONS AND REQUIREMENTS FOR J-BOX ROUGH-INS, CONDUIT RUNS WITH PULL WIRE, REQUIRED PENETRATIONS, AND POWER REQUIREMENTS FOR AUDIO-VISUAL EQUIPMENT WITH AUDIO-VISUAL CONTRACTOR PRIOR TO ROUGH-IN.
58. COORDINATE CONTROL OF LUMINAIRES IN BUILDING COMMON CORRIDOR AREAS WITH BUILDING MANAGEMENT.
59. EXISTING LIGHT FIXTURES TO BE RELOCATED: LUMINAIRES SCHEDULED TO BE RELOCATED ARE CONSIDERED AS NEW INSTALLATION AND SHALL BE EITHER RETROFITTED WITH AN INDIVIDUAL DISCONNECTING MEANS WHICH SIMULTANEOUSLY DISCONNECTS ALL BALLAST CONDUCTORS FROM THE SOURCE OF SUPPLY OR RETROFITTED WITH NEW BALLASTS AND LAMP POSTS COMPLYING WITH THE REQUIREMENTS SET IN NEC 410.130 (G) THE ELECTRICAL CONTRACTOR SHALL INCLUDE IN THEIR BID A SEPARATE LINE ITEM COST FOR EACH LUMINAIRE RETROFIT. FIELD VERIFY QUANTITY UPON AWARD OF BID AND ADJUST PRICE ACCORDINGLY.
60. UNLESS OTHERWISE INDICATED ON THE PLANS, ELECTRICAL CONTRACTOR SHALL PROVIDE A #6 STRANDED COPPER INSULATED EQUIPMENT GROUNDING CONDUCTOR AT EACH PERMANENTLY INSTALLED SERVER RACK IN THE PROJECT AREA. THIS EQUIPMENT GROUNDING CONDUCTOR SHALL BE BONDED TO THE RACK STRUCTURE, INCLUDING WITH AN INDEPENDENT MANNER, AND TO THE ACCESSIBLE CEILING, AND BONDED TO BUILDING STEEL OR THE COPPER WATER SERVICE, WHICHEVER IS CLOSER.

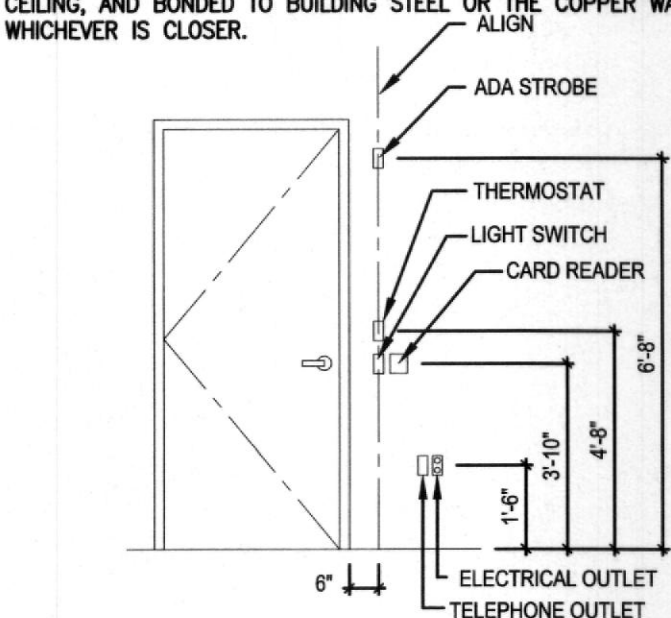

TYPICAL DETAIL FOR DEVICES AT DOOR LOCATION

SCALE: NONE

FIRE ALARM SYSTEM

1. GENERAL CONTRACTOR SHALL SOLICIT BIDS FROM BUILDING OWNER'S DESIGNATED FIRE ALARM CONTRACTOR FOR DESIGN AND INSTALLATION OF AN APPROVED FIRE ALARM SYSTEM AND DEVICES WHICH SHALL COMPLY WITH ALL APPLICABLE CODES AND ALL REQUIREMENTS OF AUTHORITIES HAVING JURISDICTION. (GENERAL CONTRACTOR SHALL VERIFY WITH BUILDING MANAGEMENT/OWNER CONCERNING DESIGNATED FIRE ALARM CONTRACTOR).
2. REQUIRED MODIFICATIONS TO EXISTING FIRE ALARM SYSTEM SHALL BE PROVIDED ON A DESIGN/BUILD BASIS BY FIRE ALARM CONTRACTOR. PRIOR TO BIDDING, FIRE ALARM CONTRACTOR SHALL FIELD VERIFY EXISTING FIRE ALARM SYSTEM CAPABILITY AND FIRE ALARM DEVICE LOCATIONS IN THIS SCOPE OF WORK. IF REQUIRED BY LOCAL JURISDICTION, FIRE ALARM SYSTEM SHALL BE UPGRADED TO MEET CURRENT CODES. FIRE ALARM CONTRACTOR SHALL PREPARE AND SUBMIT ALL SHOP DRAWINGS AND EQUIPMENT BROCHURES TO AUTHORITIES HAVING JURISDICTION, SUCH AS FIRE DEPARTMENT, BUILDING DEPARTMENT, ETC., AS REQUIRED, FOR REVIEW AND APPROVAL. CONTRACTOR SHALL ALSO PROVIDE THE ENGINEER WITH ONE (1) SET OF DRAWINGS, CALCULATIONS AND EQUIPMENT SUBMITTALS FOR HIS REVIEW AND RECORD.
3. IF REQUIRED, RELOCATE EXISTING SMOKE DETECTORS, REMOTE INDICATOR LIGHTS, FIRE ALARM HORNS, STROBES, SPEAKERS, ETC., BASED ON REMODELED AREA MODIFICATION, AND RECONNECT TO EXISTING SYSTEM AS REQUIRED. NEW FIRE ALARM DEVICES SHALL BE OF THE SAME MANUFACTURER AS THE EXISTING DEVICES AND SHALL BE COMPATIBLE WITH EXISTING FIRE ALARM SYSTEM. PROVIDE ADDITIONAL CONDUCTORS, ZEM'S IAW'S AND OTHER EQUIPMENT NECESSARY IN ORDER TO EXPAND SYSTEM AS REQUIRED. PROVIDE SYNCHRONIZING MODULES FOR STROBES. IF REQUIRED, REPLACE EXISTING FIRE ALARM DEVICES THAT ARE NOT CURRENTLY BUILDING STANDARD OR COMPATIBLE WITH NEW BUILDING STANDARD FIRE ALARM DEVICES. PRIOR TO PURCHASING FIRE ALARM DEVICES, PROVIDE CUT SHEETS, SHOP DRAWINGS, AND SEQUENCE OF OPERATION TO BUILDING MANAGEMENT AND FIRE PREVENTION BUREAU FOR THEIR APPROVAL AND TO ENGINEER FOR HIS REVIEW.
4. PROVIDE NEW BUILDING STANDARD FIRE ALARM STROBES, ADA HIGH INTENSITY, CONTRAST WITH EXISTING OR NEW FIRE ALARM SYSTEM AS REQUIRED. MODIFY EXISTING FIRE ALARM CIRCUIT CONDUCTORS AND FIRE ALARM PANELS PER







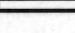



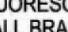
 



COMMUNICATIONS SYSTEMS

1. ELECTRICAL CONTRACTOR SHALL FULLY FIELD COORDINATE COMMUNICATIONS SYSTEM INSTALLATION (DEVICES AND CABLING) WITH TENANT REPRESENTATIVE PRIOR TO ROUGH IN AND PURCHASING OF MATERIALS.
2. AT TELEPHONE AND DATA SERVICE POINT FOR EACH MODULAR FURNITURE GROUPING, THE ELECTRICAL CONTRACTOR SHALL PROVIDE 4" SQUARE DEEP STEEL JUNCTION BOX WITH TWO 1" CONDUITS (OR AS OTHERWISE SPECIFIED ON PLAN, OR BY DATA/TELECOMMUNICATIONS CONTRACTOR) WITH PULL WIRE. STUB CONDUITS ABOVE CEILING LINE AND WIREDE PLEASTIC BUSHINGS ON CONDUIT ENDS. CABLING SHALL BE PULLED AND WROED BY OTHERS. COORDINATE ALL WORK WITH DATA/TELECOMMUNICATIONS CONTRACTOR PRIOR TO ROUGH-IN.
3. ALL DATA AND TELECOMMUNICATIONS CABLING SHALL BE INSTALLED BY TENANT'S VENDOR.
4. FOR EACH NEW SINGLE TELEPHONE/DATA OR TV CABLE OUTLET SHOWN MOUNTED IN WALL, ELECTRICAL CONTRACTOR SHALL PROVIDE A 4" SQUARE DOUBLE-GANG STEEL JUNCTION BOX WITH SINGLE-1/2" PLASTER RING AND A 3/4" CONDUIT (OR AS OTHERWISE SPECIFIED BY SYSTEM INSTALLER) WITH PULL WIRE. STUB CONDUIT 6" INTO CEILING SPACE AND PROVIDE PLASTIC BUSHINGS. CABLING SHALL BE PULLED BY OTHERS. COORDINATE ALL WORK WITH DATA/TELECOMMUNICATIONS CONTRACTOR PRIOR TO ROUGH-IN.
5. IF REQUESTED, ELECTRICAL CONTRACTOR SHALL REMOVE ALL ABANDONED AND UNUSED DATA/TELECOMMUNICATIONS CABLING, CONDUIT, JUNCTION BOXES, AND

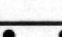RECORD DOCUMENTS

 


























1. RECORD DOCUMENTS: THE ELECTRICAL CONTRACTOR SHALL MAINTAIN ACCURATE RECORDS OF ALL DEVIATIONS IN WORK AS INSTALLED FROM WORK SPECIFIED ON THE DRAWINGS OR IN THE SPECIFICATIONS AND IDENTIFY ORIGIN OF CHANGE.
2. KEEP A COMPLETE SET OF RECORD DOCUMENT PRINTS IN CUSTODY DURING ENTIRE PERIOD OF CONSTRUCTION AT THE CONSTRUCTION SITE. ON COMPLETION OF THE PROJECT, TWO COMPLETE SETS OF MARKED-UP PRINTS SHOWING THESE DEVIATIONS SHALL BE DELIVERED TO THE GENERAL CONTRACTOR AND ARCHITECT/ENGINEER. THIS CONTRACT WILL NOT BE CONSIDERED COMPLETED UNTIL THESE RECORD DRAWINGS HAVE BEEN RECEIVED AND REVIEWED BY THE ENGINEER.

ELECTRICAL SYMBOLS LEGEND

LIGHTING					
SYMBOL		DESCRIPTION			
<div><div>SURFACE</div><div>RECESSED</div></div>		<div>SHADING INDICATES CONNECTION TO EMERGENCY CIRCUIT OR 90-MINUTE BATTERY BACKUP</div> <div>2x4' FLUORESCENT LIGHT FIXTURE</div> <div>2x2' FLUORESCENT LIGHT FIXTURE</div> <div>1x4' FLUORESCENT LIGHT FIXTURE</div>			
<div><div>WALL</div><div>CEILING</div></div>					
<div><div></div><div></div></div>				<div>EXIT SIGN</div> <div>EMERGENCY BATTERY PACK FIXTURE</div>	
SYMBOL				DESCRIPTION	
<div><div></div><div>PENDANT FLUORESCENT FIXTURE</div></div> <div><div></div><div>FLUORESCENT WALL BRACKET</div></div> <div><div></div><div>DOWNLIGHT FIXTURE</div></div> <div><div></div><div>WALL MOUNTED FIXTURE</div></div> <div><div></div><div>TRACK LIGHTING</div></div> <div><div></div><div>COMBINATION LIGHT AND EXHAUST FAN</div></div> <div><div></div><div>PHOTOCCELL</div></div>				SYMBOL	
<div></div> <div>FLUORESCENT STRIP FIXTURE</div>		<div></div> <div>UNDER CABINET FLUORESCENT FIXTURE</div>			
<div></div> <div>PENDANT FIXTURE</div>		<div></div> <div>WALLWASH FIXTURE</div>			
<div></div> <div>POLE MOUNTED OUTDOOR FIXTURE</div>		<div></div> <div>REMOTE EMERGENCY LIGHT HEAD</div>			

SWITCHING	
SYMBOL	DESCRIPTION
	S SINGLE POLE SWITCH
	S2 DOUBLE POLE SWITCH
	S3 THREE WAY SWITCH
	S4 FOUR WAY SWITCH
	Sd DIMMER SWITCH
	Sk KEYED SWITCH
	S10 THERMAL OVERLOAD SWITCH
	Ss GANGED SWITCHES

ABBREVIATIONS	
ABBR.	DESCRIPTION
AFF	ABOVE FINISHED FLOOR
AC	ABOVE COUNTER
GI	GROUND FAULT CIRCUIT INTERRUPTER
GD	GROUND
IG	ISOLATED GROUND
NL	NIGHT LIGHT
RP	RELOCATED DEVICE OR EQUIPMENT
WP	WEATHER PROOF
EM	EMERGENCY
HD	HEAVY DUTY
TR	TAMPER RESISTANT
EG	EGRESS LIGHTING

POWER			DESCRIPTION
WALL	CEILING	FLOOR	
			JUNCTION BOX
			DUPLEX RECEPTACLE
			DEDICATED DUPLEX RECEPTACLE
			DOUBLE DUPLEX RECEPTACLE
			DEDICATED DOUBLE RECEPTACLE
			SPECIAL PURPOSE RECEPTACLE
			COVER PLATE
			CONTACTOR
			SIMPLEX RECEPTACLE

CIRCUITING	
SYMBOL	DESCRIPTION
	COMBINATION DATA/ TELEPHONE OUTLET
	CRT OR DATA OUTLET
	TELEPHONE OUTLET
	TV OUTLET
CIRCUITING	
SYMBOL	DESCRIPTION
	HOMERUN, SOLID 120/208 V, 0-100% (277/480)
	CIRCUIT, RUN CONCEALED IN WALL OR CEILING
	CIRCUIT, RUN CONCEALED IN FLOOR OR GRADE
	CONDUIT RISER, TURNED UP, TURNED DOWN


COMMUNICATION	
SYMBOL	DESCRIPTION
	COMBINATION DATA/ TELEPHONE OUTLET
	CRT OR DATA OUTLET
	TELEPHONE OUTLET
	TV OUTLET

CIRCUITING	
SYMBOL	DESCRIPTION
	HOMERUN, SOLID 120/208 V, 0-100% (277/480)
	CIRCUIT, RUN CONCEALED IN WALL OR CEILING
	CIRCUIT, RUN CONCEALED IN FLOOR OR GRADE
	CONDUIT RISER, TURNED UP, TURNED DOWN

- MANUFACTURER'S REQUIREMENTS. MOUNT STROBES +80" A.F.F. OR 6" BELOW THE CEILING, WHICHEVER IS LOWER. REPLACE EXISTING STROBES WITH NEW BUILDING STANDARD STROBE LIGHTS, AND ENSURE ALL STROBE LIGHTS ARE SYNCHRONIZED.
5. FIRE ALARM CONTRACTOR SHALL FURNISH DUCT DETECTORS (120V OR 24V), WITH REMOTE INDICATING LIGHT AND TEST SWITCH, FOR ALL MECHANICAL AIR-MOVING SYSTEMS WHERE REQUIRED BY CODE OR LOCAL AUTHORITIES. DETECTORS SHALL BE OF THE SAME MANUFACTURER AS THE EXISTING OR NEW FIRE ALARM SYSTEM. MECHANICAL CONTRACTOR SHALL INSTALL DETECTORS IN THE MECHANICAL DUCTWORK, AS REQUIRED BY CODE, TO FACILITATE MOTOR SHUTDOWN UPON DETECTION OF SMOKE. ELECTRICAL CONTRACTOR SHALL PROVIDE DETECTOR TO THE FAN MOTOR (THROUGH A POWER-INTERRUPTING RELAY). THE SHUTDOWN UPON DETECTION OF SMOKE; AND IF REQUIRED BY CODE, THE FIRE ALARM CONTRACTOR SHALL CONNECT TO FIRE ALARM SYSTEM AS TROUBLE ALARM. COORDINATE ALL REQUIREMENTS AND SPECIFICATIONS WITH BUILDING ENGINEER OR BUILDING FIRE ALARM REPRESENTATIVE. SUBMIT DRAWINGS AND EQUIPMENT CUT SHEETS FOR ENGINEERS' REVIEW AND FIRE DEPARTMENT APPROVAL.

6. IF A PRE-ACTION DRY PIPE SPRINKLER SYSTEM IS REQUIRED FOR THIS PROJECT, THE PRE-ACTION FIRE ALARM SYSTEM CONTROL PANEL SHALL BE ANNUNCIATED ON THE BUILDING MAIN FIRE ALARM CONTROL PANEL (FACP) IN THE FIRE COMMAND CENTER (FCC.).
7. IF THE PROJECT REQUIRES A UPS SYSTEM AND COMPUTER ROOM AIR CONDITIONING (CRAC) UNITS, THE UPS SYSTEM AND CRAC UNITS SHALL BE CONNECTED TO THE BUILDING FIRE ALARM SYSTEM AND TO THE PRE-ACTION FIRE ALARM CONTROL PANEL. THE UPS SYSTEM, CRAC UNITS, AND FIRE/SMOKE DAMPERS SERVING THE COMPUTER ROOM SHALL BE SHUT DOWN UPON ACTIVATION OF FIRE ALARM SYSTEM. STARTERS/DISCONNECT SWITCHES, WHEN EQUIPMENT DELIVERED TO JOB SITE, IN ACCORDANCE WITH EQUIPMENT MANUFACTURER'S AND SUPPLIER'S RECOMMENDATIONS

- ASSOCIATED WIRING LOCATED IN THE CEILING SPACE BACK TO POINT OF ORIGIN, UNLESS THE TENANT DATA/TELECOMMUNICATIONS CONTRACTOR IS CONTRACTED TO REMOVE THE DATA/TELECOMMUNICATIONS CABLING UNDER A SEPARATE CONTRACT. THE GENERAL CONTRACTOR SHALL COORDINATE WITH OTHER APPROPRIATE CONTRACTOR FOR THE REMOVAL OF THE PHONE/DATA CABLING. PRIOR TO DISCONNECTING AND REMOVING ANY EQUIPMENT, DEVICES OR CABLING, THE APPROPRIATE CONTRACTOR SHALL COORDINATE WITH OWNER AND ARCHITECT TO ENSURE EQUIPMENT SHALL BE REMOVED.
6. ELECTRICAL CONTRACTOR SHALL VERIFY QUANTITY AND TYPE OF DATA/PHONE/AUDIO/VIDEO PORTS TO BE INCLUDED IN FLOOR POKE-THRU DEVICES WITH DATA/TELECOMMUNICATIONS CONTRACTOR PRIOR TO ORDERING.
7. VERIFY ALL SPECIFIC COMPUTER AND COMMUNICATIONS EQUIPMENT REQUIREMENTS WITH EQUIPMENT SUPPLIER PRIOR TO ROUGH IN. COORDINATION SHALL INCLUDE MOUNTING HEIGHTS, CONNECTION TYPE, AND POWER REQUIREMENTS. ALL CONNECTIONS FOR COMPUTER AND COMM

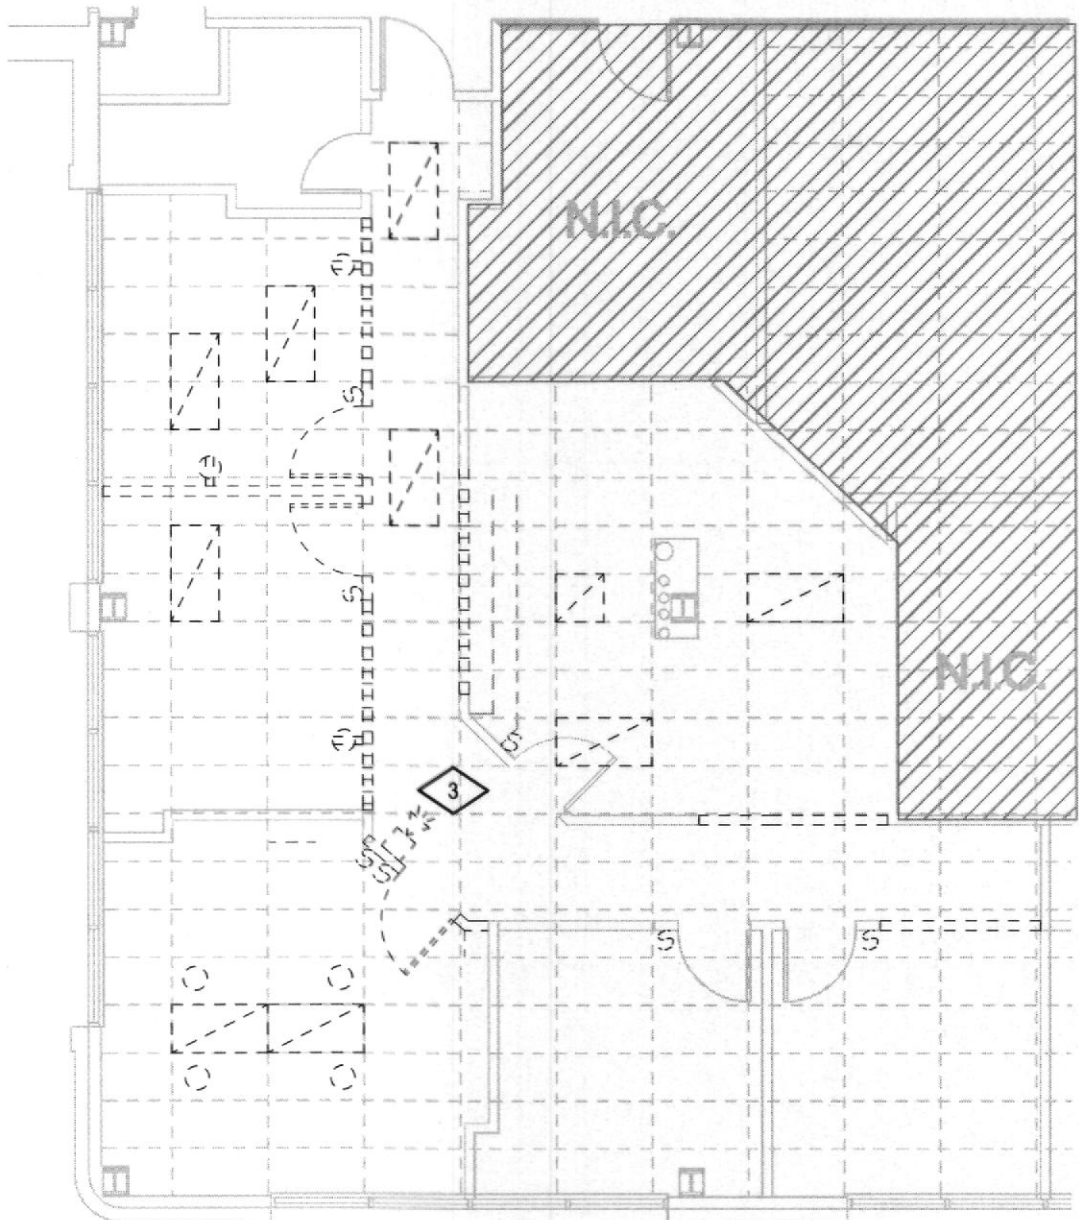

DEMOLITION PLAN

SCALE: 1/8"=1'-0"

GENERAL NOTES:

- A. REMOVED ITEMS SHOWN AS DASHED AND LIGHT - - - -


DETAIL NOTES

- E.C. TO REMOVE ALL ABANDONED CONDUIT/CABLING/WIRING FROM SPACE INCLUDING ABOVE THE CEILING BACK TO SOURCE. ANY CIRCUITS MADE SPARE TO BE TURNED OFF AND LABELED AS SUCH WITH NEW TYPED PANEL SCHEDULES.
- RETURN LIGHTING NOT RE-USED TO BUILDING MANAGEMENT.
- SALVAGE ALL FIRE ALARM DEVICES AND EXIT SIGNS FOR RE-USE. RETURN ITEMS NOT RE-USED TO BUILDING MANAGEMENT STOCK.

Room Schedule			
400	Public Corridor	409	Office
401	Tenant Entrance	410	-----
402	Unisex Restroom	411	Break Room
403	Waiting	412	Closet
404	Exam Room	413	Open Work Area
405	Work Room	414	Tenant Hallway
406	Tenant Hallway	415	Office
407	Exam Room	416	Office
408	Office	417	-----

Install electrical connections per 2017 NEC 110.14, identify disconnects per 2017 NEC 110.22 and provide working space around electrical equipment per 2017 NEC 110.26.

Wiring in air handling spaces must comply with 2017 NEC 300.22. Firestop penetrations per 2017 NEC 300.21. Secure and support equipment per 2017 NEC 300.11.

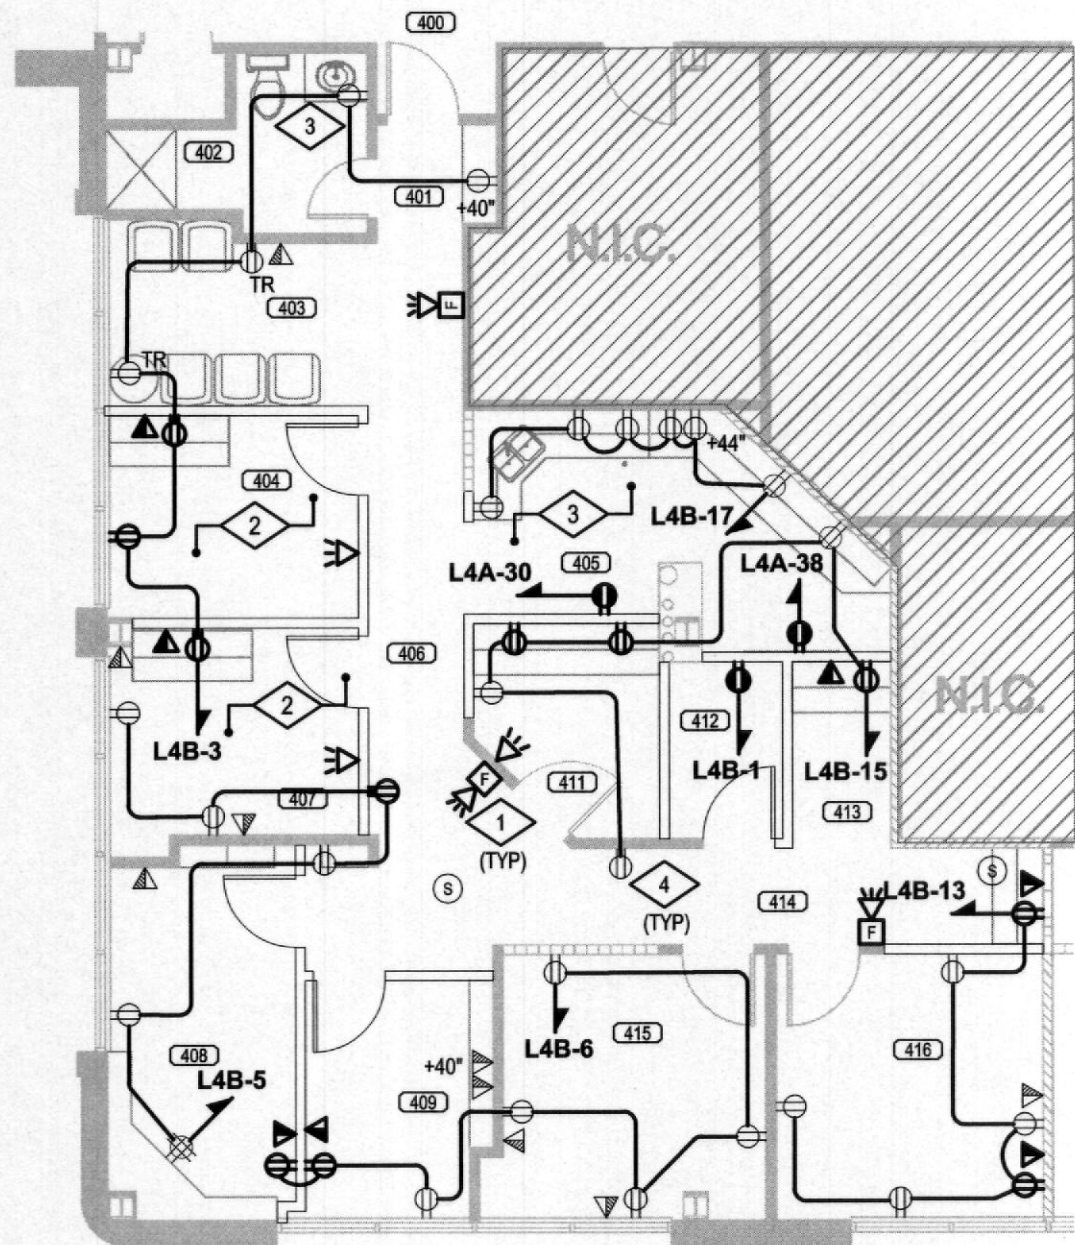

POWER PLAN

SCALE: 1/8"=1'-0"

GENERAL NOTES:

- A. NEW AND RELOCATED ITEMS SHOWN AS BOLD
EXISTING ITEMS SHOWN AS LIGHT

DETAIL NOTES


- NEW/RELOCATED FIRE ALARM DEVICE, SEE FIRE ALARM GENERAL NOTES.
- PROVIDE HOSPITAL-GRADE RECEPTACLES FOR ALL DEVICES IN EXAM ROOMS. ALL BRANCH CIRCUITS IN THIS AREA SHALL BE RUN ENTIRELY IN EMT CONDUIT IN ORDER TO UTILIZE CONDUIT AS REDUNDANT GROUND PER CODE REQUIREMENTS OR PROVIDE GREEN HOSPITAL-GRADE AC/MC CABLE FOR REDUNDANT GROUND. PROVIDE GFCI DEVICES THROUGHOUT. PROVIDE EQUIPMENT GROUNDING CONDUCTOR THROUGHOUT.
- E.C. TO ENSURE RECEPTACLES WITHIN 6' OF SINK EDGE HAVE ACCESSIBLE GFCI PROTECTION. PROVIDE IF NEEDED.
- RE-CIRCUIT EXISTING RECEPTACLE AS SHOWN.

Legibly identify each breaker or switch for it's use or purpose on the circuit directory in the panel/switchboard per 2017 NEC 408.4.

Provide emergency illumination equipment that complies with 2017 NEC 700.12 (F) or 2017 NEC 700.

Suspended ceiling systems and the luminaires they support shall meet the requirements of 2017 NEC 410.36(B).

After hours inspection to verify required egress illumination may be required during field inspection. 2015 IBC 1006.

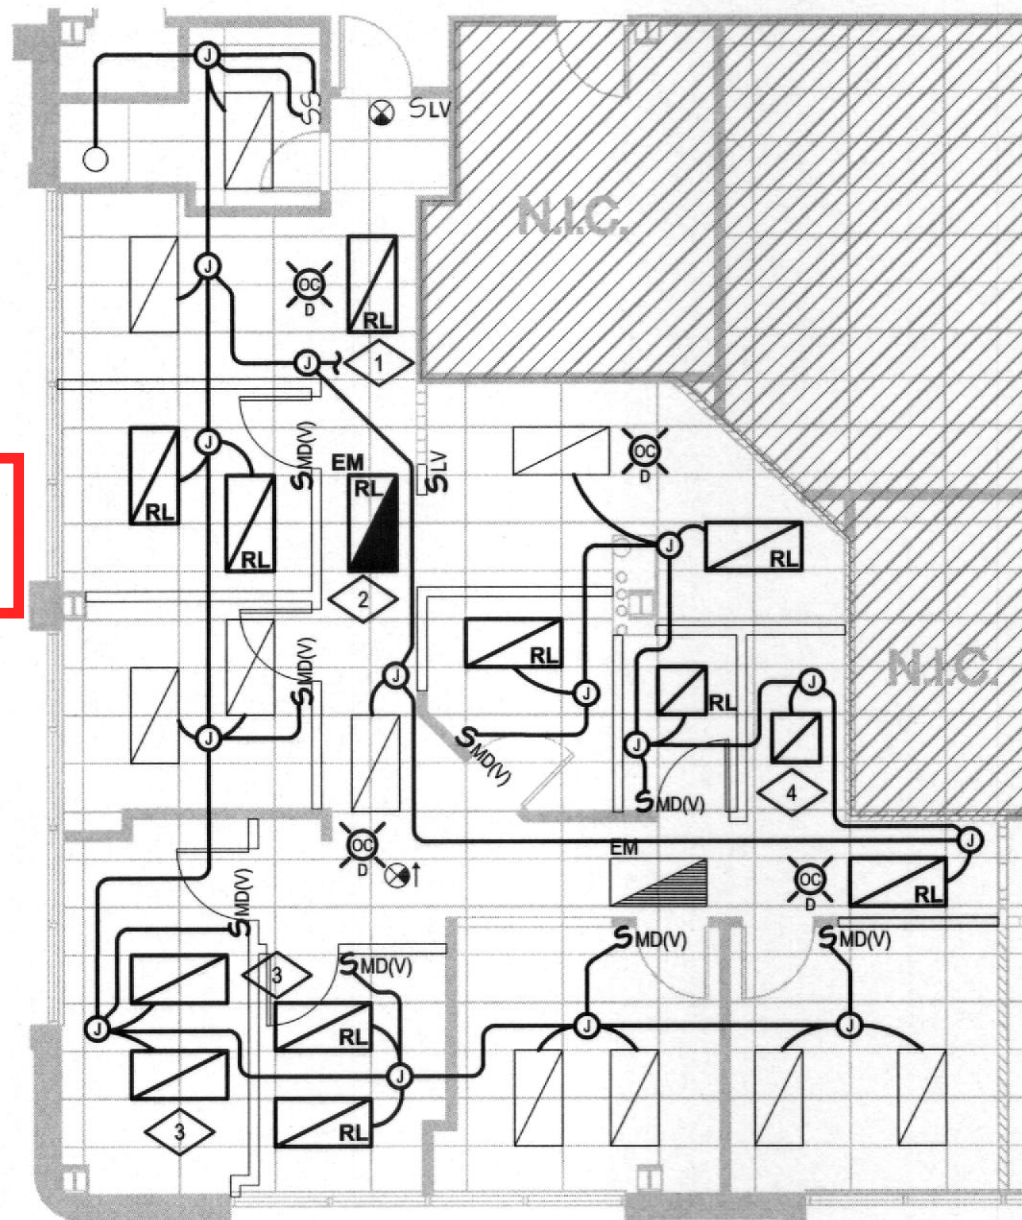

LIGHTING PLAN

SCALE: 1/8"=1'-0"

GENERAL NOTES:


- A. NEW AND RELOCATED ITEMS SHOWN AS BOLD
EXISTING ITEMS SHOWN AS LIGHT

DETAIL NOTES

- CONNECT TO LOCAL LIGHTING CIRCUIT (AND CONTROLS, AS APPLICABLE). E.C. TO VERIFY NO MORE THAN 70% LOAD ON A SINGLE 277V LIGHTING CIRCUIT.
- EXISTING EMERGENCY LIGHTING COULD NOT BE DETERMINED AT TIME OF FIELD SURVEY. E.C. TO VERIFY EXISTING EM LIGHTING MEETS OR EXCEEDS CODE REQUIREMENTS. PROVIDE ADDITIONAL EM LIGHTING IF NEEDED.
- NEW 18-CELL PARABOLIC 2x4 FLOURESCENT GRID TROFFER TO MATCH EXISTING IN SUITE. E.C. TO COORDINATE WITH P.M. PRIOR TO ORDERING.
- NEW 2x2 8-CELL PARABOLIC FLOURESCENT GRID TROFFER TO MATCH EXISTING IN SUITE. E.C. TO COORDINATE WITH P.M. PRIOR TO ORDERING.
- E.C. TO CLEAN/REPAIR/REBALLAST/RELAMPS EXISTING/RELOCATED FIXTURES AS NECESSARY TO PROVIDE A LIKE-NEW APPEARANCE.

SUPPLIED FROM:															
PANEL "L4A" (EXISTING)															
FLUSH SURFACE		M.C.B. BUS 225A CU		FEED THRU L4B		M.L.O. I.G. BAR A.I.C. 10,000		MANF. C.B. BOLT ON							
TYPE	DESCRIPTION	BKR	CIR	LOAD (VOLT AMPS)/PHASE			CIR	BKR DESCRIPTION	TYPE						
				A	B	C									
R	ROOF RECEP	20	1	540	500		2	20 DWN LTS STE 400	L						
R	SPARE	20	3		1000	500	4	20 DWN LTS STE 400	L						
R	CORE RECEP	20	5			720	6	20 DWN LTS STE 400	L						
G	WTR FNTN	20	7	500	500		8	20 DWN LTS STE 400	L						
R	TELE RECEP	20	9		360	500	10	20 DWN LTS STE 400	L						
R	EXAM RM STE 400	20	11			900	12	20 DIRECTORY	R						
R	EXAM RM STE 400	20	13	900	900		14	20 RECS STE 400	R						
R	EXAM RM STE 400	20	15		900	1080	16	20 RECS STE 400	R						
R	CAST RM STE 400	20	17			900	18	20 RECS STE 400	R						
R	CAST RM STE 400	20	19	540	250		20	20 BTHRM EF	M						
R	EXAM RM STE 400	20	21		720	540	22	20 DRK RM STE 400	R						
R	EXAM RM STE 400	20	23			1080	24	20 RECS STE 400	R						
R	EXAM RM STE 400	20	25	900	1080		26	20 RECS STE 400	R						
R	RECS STE 400	20	27		900	1080	28	20 RECS STE 400	R						
R	RECS STE 400	20	29			900	30	20 DED REC STE 420	R						
G	XRAYCCT STE 400	20	31	500	1080		32	20 RECS STE 400	R						
G	XRAYCCT STE 400	20	33		500	360	34	20 SWITCH STE 400	R						
G	FLM PROC STE 400	20	35			1500	36	20 VINDNG STE 400	K						
R	FLM RM STE 400	20	37	1500	180		38	20 DED REC STE 420	R						
R	FLM RM STE 400	20	39		360	1080	40	20 FURN STE 400	R						
M	EF-1	20	41			250	1080	42	20 FURN STE 400	R					
SEC 1		9870		9880		11550									
SEC 2		21166		22234		23912									
TOTAL		31036		32114		35462									
LOAD TYPE				CONNECTED KVA		ALL PHASES		DEMAND KVA		TOTAL					
				A	B	C	ALL PHASES	A	B	C	ALL PHASES				
LIGHTING				1.4	1.0	0.5	2.9	125%	1.8	1.3	0.6	3.6			
RECEPTACLE (10KVA OR LESS)				3.3	3.3	3.3	10.0	100%	3.3	3.3	3.3	10.0			
RECEPTACLE (OVER 10KVA)				16.4	19.2	22.3	57.9	56%	8.2	9.6	11.2	29.0			
HVAC/MOTOR				0.0	0.0	2.2	2.4	13	2.0	2.2	5.5	9.7			
MOTOR(LARGEST)				0.0	0.0	0.0	0.0	125%	0.0	0.0	0.0	0.0			
KITCHEN EQUIPMENT				4.6	5.4	5.6	15.6	100%	4.6	5.4	5.6	15.6			
MISCELLANEOUS				4.0	1.3	1.5	6.8	100%	4.0	1.3	1.5	6.8			
TOTAL KVA				31.0	32.1	35.5	98.6		TOTAL KVA	23	23	24	70.4		
WITH GROUND BUS				TOTAL AMPS		193		240		240		195.3			
LEGEND				L = LIGHTING		R = RECEPTACLE		M = HVAC/ MOTOR		K = KITCHEN		G = MISCELLANEOUS			
				MAX PERCENT DIFFERENCE BETWEEN PHASES (A,B,C) 12%											

COPPER FEEDER SCHEDULE							NOTE: BASED ON THHN CONDUCTORS	
FEEDER TYPE	RATING	# OF SETS	PHASE COND.	NEUTRAL	GROUND	CONDUIT	SCHED 80 CONDUIT	
2500.4	2500	7	(3) 500 KCMIL	500 KCMIL	350 KCMIL	3-1/2"	4"	
1600.4	1600	5	(3) 400 KCMIL	400 KCMIL	#4/0	3"	3-1/2"	
400.4	400	2	(3) #3/0	#3/0	#2	2"	2-1/2"	
400.3	400	2	(3) #3/0	#3/0	#2	2"	2"	
300.3	300	1	(3) 350 KCMIL	-	#4	2-1/2"	3"	
250.4	250	1	(3) 250 KCMIL	250 KCMIL	#4	2-1/2"	2-1/2"	
200.4	200	1	(3) #3/0	#3/0	#6	2"	2-1/2"	
200.3	200	1	(3) #3/0	-	#6	2"	2"	
150.4	150	1	(3) #1/0	#1/0	#6	2"	2"	
120.3	120	2	(3) #6	-	#10	2"	2"	
100.4	100	1	(3) #2	#2	#8	1-1/4"	1-1/2"	
100.3	100	1	(3) #2	-	#8	1-1/4"	1-1/4"	
60.3	60	1	(3) #6	-	#10	3/4"	1"	

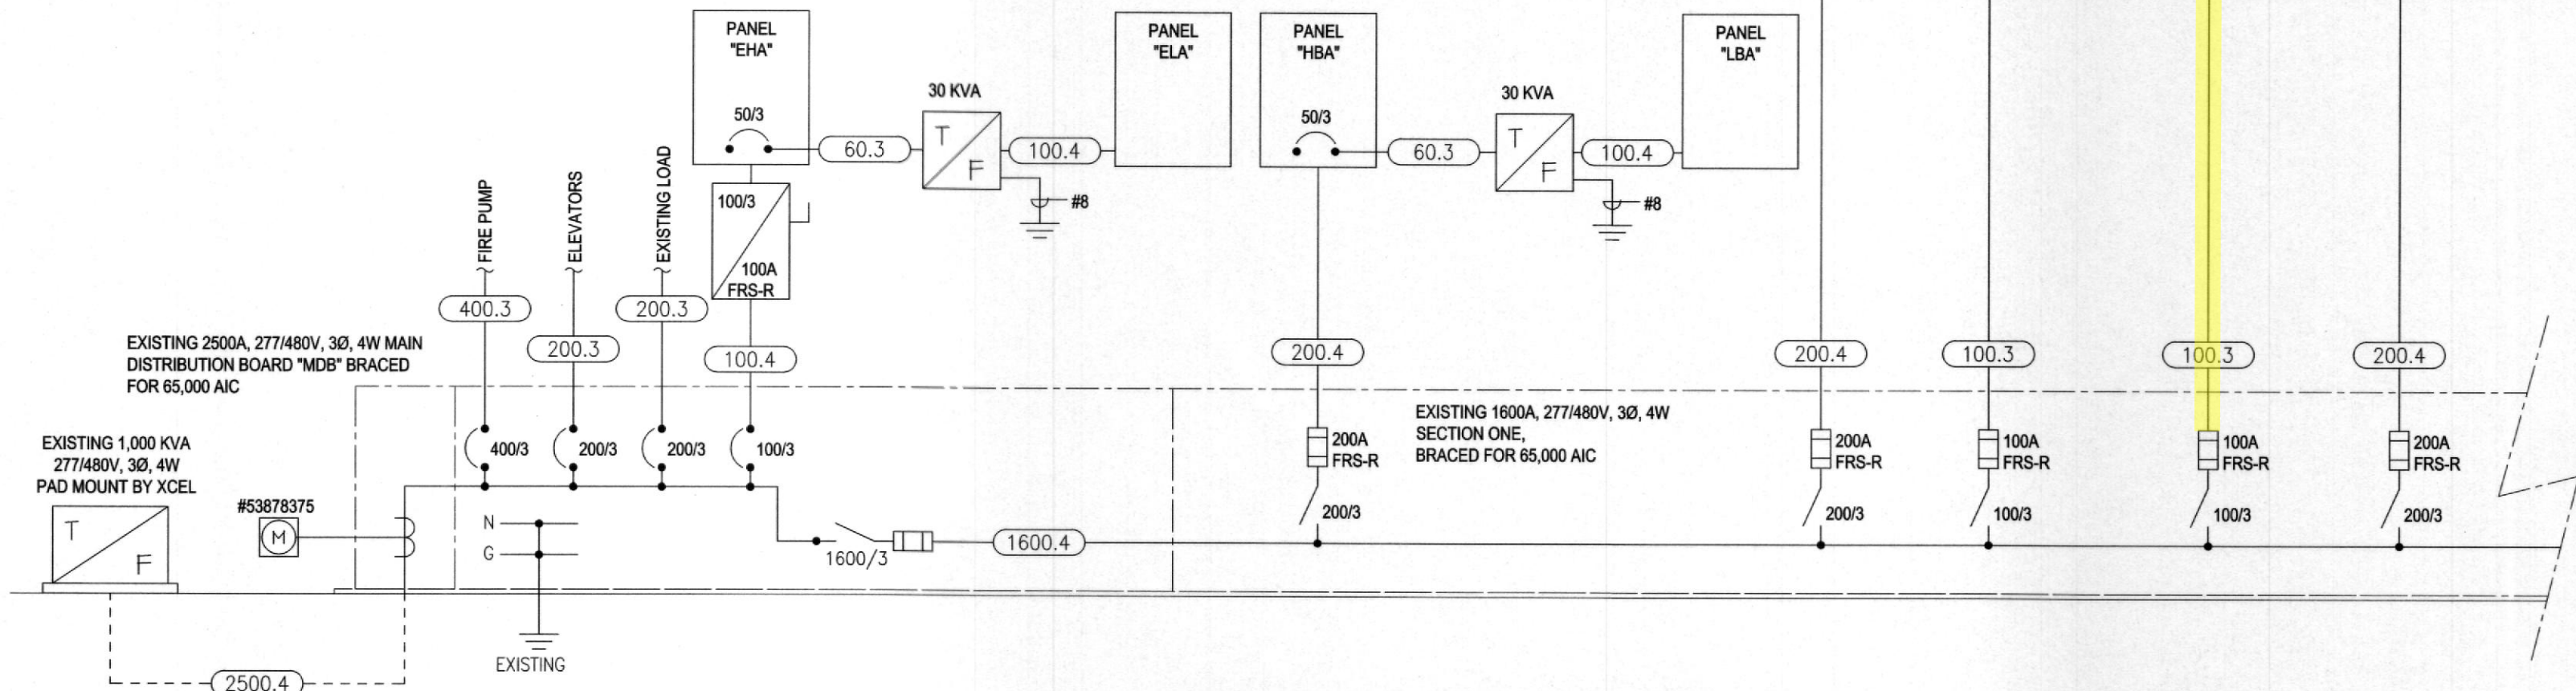


EXISTING ONE-LINE DIAGRAM
SCALE: NONE

GENERAL NOTES:
A. ALL EQUIPMENT IS EXISTING TO REMAIN

2015 IECC MINIMUM CONTROLS BY AREA CHART	
AREA TYPE:	CONTROL TYPE:
PRIVATE OFFICE	OCC, MANUAL ON, AUTO OFF (VACANCY MODE)
OPEN OFFICE AREA	OCC, 50% FULL AUTO ON, 50% MANUAL ON AUTO OFF, 100% MANUAL OFF CAPABLE
DAYLIGHT ZONES	OCC, AUTO, MANUAL ON OFF, DAYLIGHT CONTROLLED DIMMERS
EGRESS LIGHTS, OPEN OFF, FACTORY, ETC.	OCC, FULL AUTO ON, BATT OR GEN BACKED
EGRESS LIGHTS, WITH ALT EM LIGHTING	OCC, FULL AUTO ON, NO BACK UP POWER
WALK-IN COOLER, FREEZER	OCC, AUTO, MANUAL ON
TRAINING, CONFERENCE, COPY, BREAK	OCC, AUTO, MANUAL ON, MANUAL OFF CAPABLE
STORAGE, CLOSETS & LOCKER ROOMS	OCC, AUTO, MANUAL ON, MANUAL OFF CAPABLE
HALLWAY WITH EGRESS LGTS CONNECTED TO OPEN AREA	OCC, AUTO, MANUAL OFF CAPABLE. EGRESS FIXTURES, OCC, FULL AUTO
HALLWAYS, STAIRS, RESTROOMS, LOBBIES, CORRIDOR	OCC, FULL AUTO
FACTORY	OCC, MANUAL ON, AUTO OFF (VACANCY MODE)
WAREHOUSE	OCC BY ROW, MANUAL ON AUTO OFF. EGRESS LIGHTS OCC AUTO

2015 IECC LIGHTING CONTROLS GENERAL NOTES:

- WIRING DIAGRAM REPRESENTS DIAGRAMIC DESIGN TO OPERATE OPEN OFFICE PACKS USING SAME SET OF OCC. SENSORS, SOME WIRING MAY NOT BE NEEDED.
- LEVITON OSP20-RDH POWER PACK IS THE BASIS OF DESIGN FOR THIS WIRING DIAGRAM. PROVIDE WIRING ADJUSTMENTS TO ACCOMMODATE ACTUAL POWER PACK/RELAYS PROVIDED. EXPAND WIRING AS NEEDED FOR MULTIPLE ZONES.
- GENERIC +24VDC OCC. SENSORS CAN BE USED SUCH AS COOPER OAC-DT-1000
- POWER PACK CONTROL POWER CAN BE THE SAME CIRCUIT SERVING FIXTURES.
- PROVIDE EXTRA POWER PACKS AS REQUIRED TO ACCOMMODATE QUANTITIES OF OCCUPANCY SENSORS BEYOND THE SUPPLY CAPACITY OF A SINGLE POWER PACK.
- CONTRACTOR TO CONFIRM ALL PARTS, PIECES, AND WIRING WILL WORK TOGETHER AND MEET 2015 IECC CODE REQUIREMENTS PRIOR TO INSTALLATION.
- CONTROLLED ZONES SHALL NOT EXCEED 9000 SQ-FT PER SET OF SWITCHES.
- PROVIDE AS-BUILTS, MANUALS, CALIBRATION, AND TESTING PER 2015 IECC. PREFER REMOTE TYPE CALIBRATION. PROVIDE ADHESIVE LABELS FOR SWITCHES.

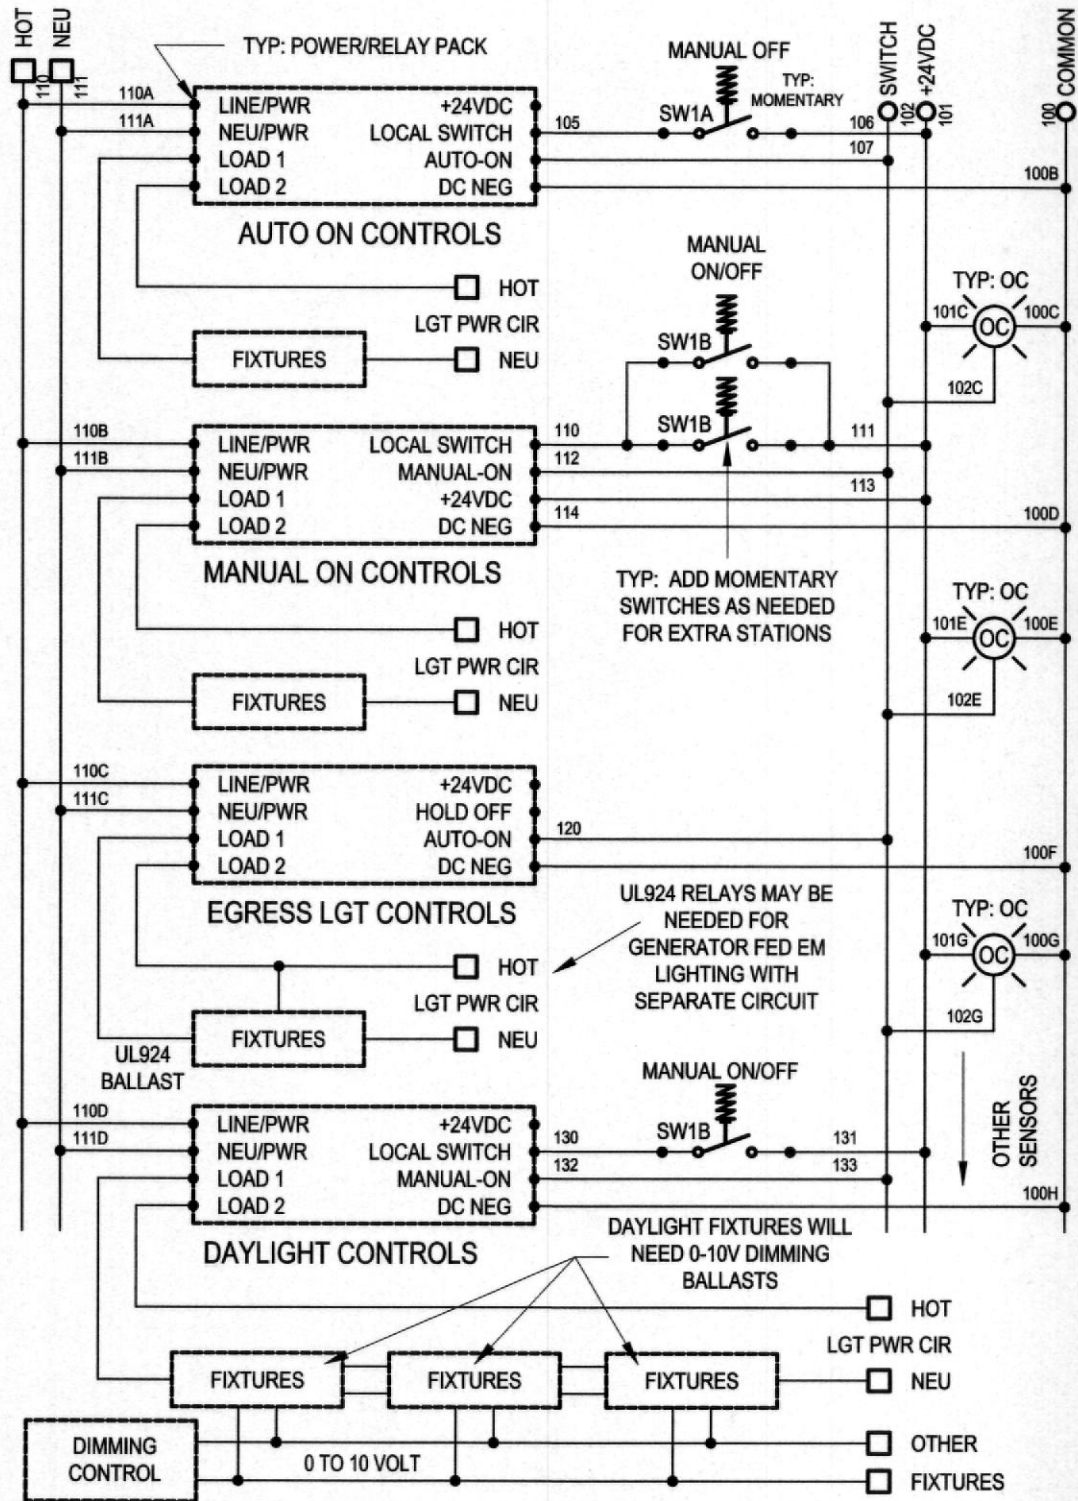

COMcheck Software Version 4.0.7.0
Interior Lighting Compliance Certificate


Project Information
Energy Code: 2015 IECC
Project Title: Lynn Institute
Project Type: Alteration
Owner/Agent: Eric McCloskey
Designer/Contractor: Corey Electrical Engineering
Construction Site: 1411 South Potomac Street, Suite 420, Aurora, CO 80012
Interior Lighting Compliance Certificate
Compliance Statement: The proposed interior lighting alteration project represented in this document is consistent with the building plans, specifications, and other calculations submitted with this permit application. The proposed interior lighting systems have been designed to meet the 2015 IECC requirements in COMcheck Version 4.0.7.0 and to comply with any applicable mandatory requirements listed in the Inspection Checklist.
Eric McCloskey - Project Manager
Date: 11/9/2017

Project Title: Lynn Institute
Data filename: F:\DATA\ACAD\17 Archives\17400 - 17499\17448 Lynn Institute\Design\IECC-Corcheck\17448.cck
Report date: 11/09/17
Page 1 of 3

COMcheck Software Version 4.0.7.0
Inspection Checklist

Requirements: 0.0% were addressed directly in the COMcheck software
Text in the "Comments/Assumptions" column is provided by the user in the COMcheck Requirements screen. For each requirement, the user certifies that a code requirement will be met and how that is documented, or that an exception is being claimed. Where compliance is itemized in a separate table, a reference to that table is provided.
Section # / Req ID: C103.2 (P44)
Plan Review: Plans, specifications, and/or calculations provide all information with which compliance can be determined for the interior lighting and electrical systems and equipment and document where exceptions to the standard are claimed. Information provided should include interior lighting power calculations, wattage of bulbs and ballasts, transformers and control devices.
Complies?: ☐ Complies, ☐ Does Not, ☐ Not Observable, ☐ Not Applicable
Additional Comments/Assumptions:

1 High Impact (Tier 1) 2 Medium Impact (Tier 2) 3 Low Impact (Tier 3)
Project Title: Lynn Institute
Data filename: F:\DATA\ACAD\17 Archives\17400 - 17499\17448 Lynn Institute\Design\IECC-Corcheck\17448.cck
Report date: 11/09/17
Page 2 of 5

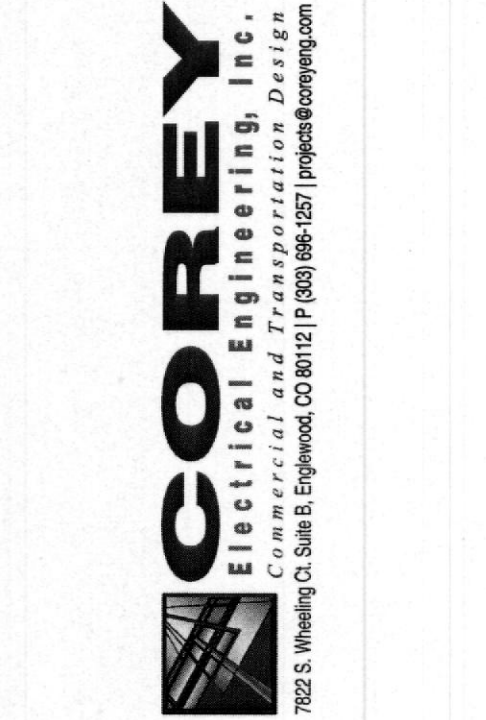

1411 South Potomac Street
Aurora, CO 80012
Suite 420



Lynn Institute

Dates of Record
Project Start Date: 13 June 2017

Issued On: Issued For:
10 November 2017 Tenant's Review & Approval;
and Construction

Sheet Contents
Project Team
Project Number
Sheet
Mark

EM,SLS
17448

E.2