


ISSUES	
1	02.13.2026 C&S BULLETIN 1
2	05.19.2026 C&S BULLETIN 2
3	07.29.2026 C&S BULLETIN 3
4	
5	
6	
7	
8	
9	
10	
REVISIONS	
12	07.29.2026 C&S BULLETIN 3

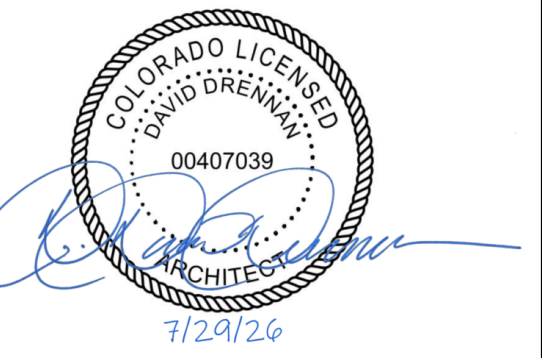

Date of issue:
07.29.2026

QTS DEN1 DC2
1140 N. GUN CLUB ROAD
QTS


KEYPLAN

S	Q	N	L	J	G	E	C	A
T	R	P	M	K	H	F	D	B

PENTHOUSE
DETAILS

JOB 24464.0000
DATE 07.29.2026
SHEET

A06-30

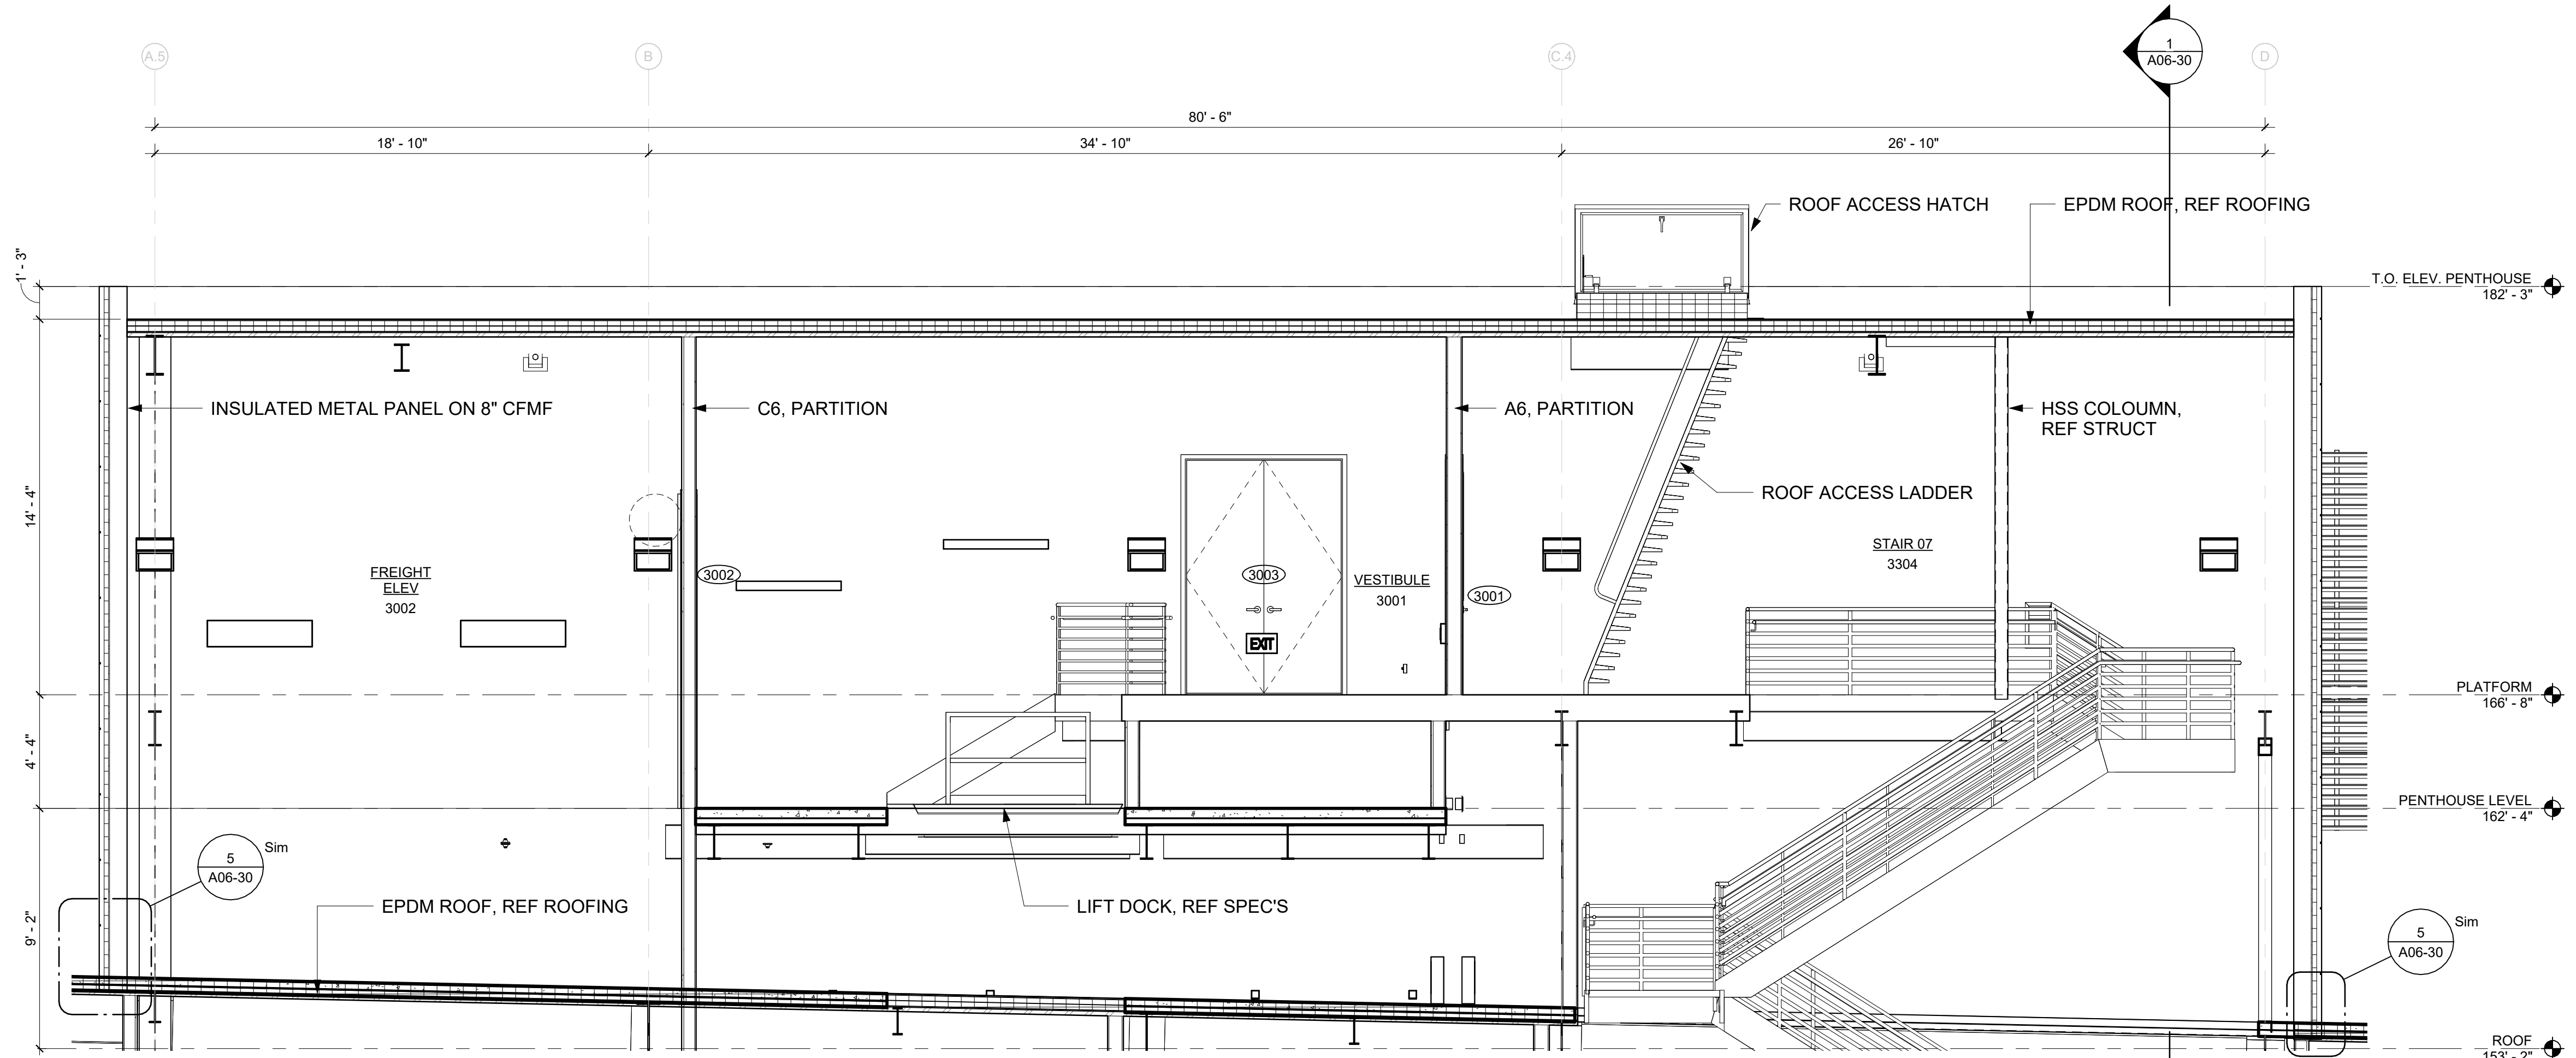


3 N/S SECTION - PENTHOUSE
1/4" = 1'-0"

REVISION FOR:
PERMIT: 25-2513934-CM
RSN: 1881854


Code violations that are found during inspection are required to be corrected. Permit issuance does not grant approval of a code violation.

ONLY HIGHLIGHTED OR CLOUDED REVISIONS ARE APPROVED ON THIS REVIEW. ALL PREVIOUS COMMENTS APPLY.

City of Aurora Building Division
Reviewed for Code Compliance
Approved as Noted: **malemu**
Date: **Sep 15, 2026**
2021 INTERNATIONAL CODES & 2023 NEC

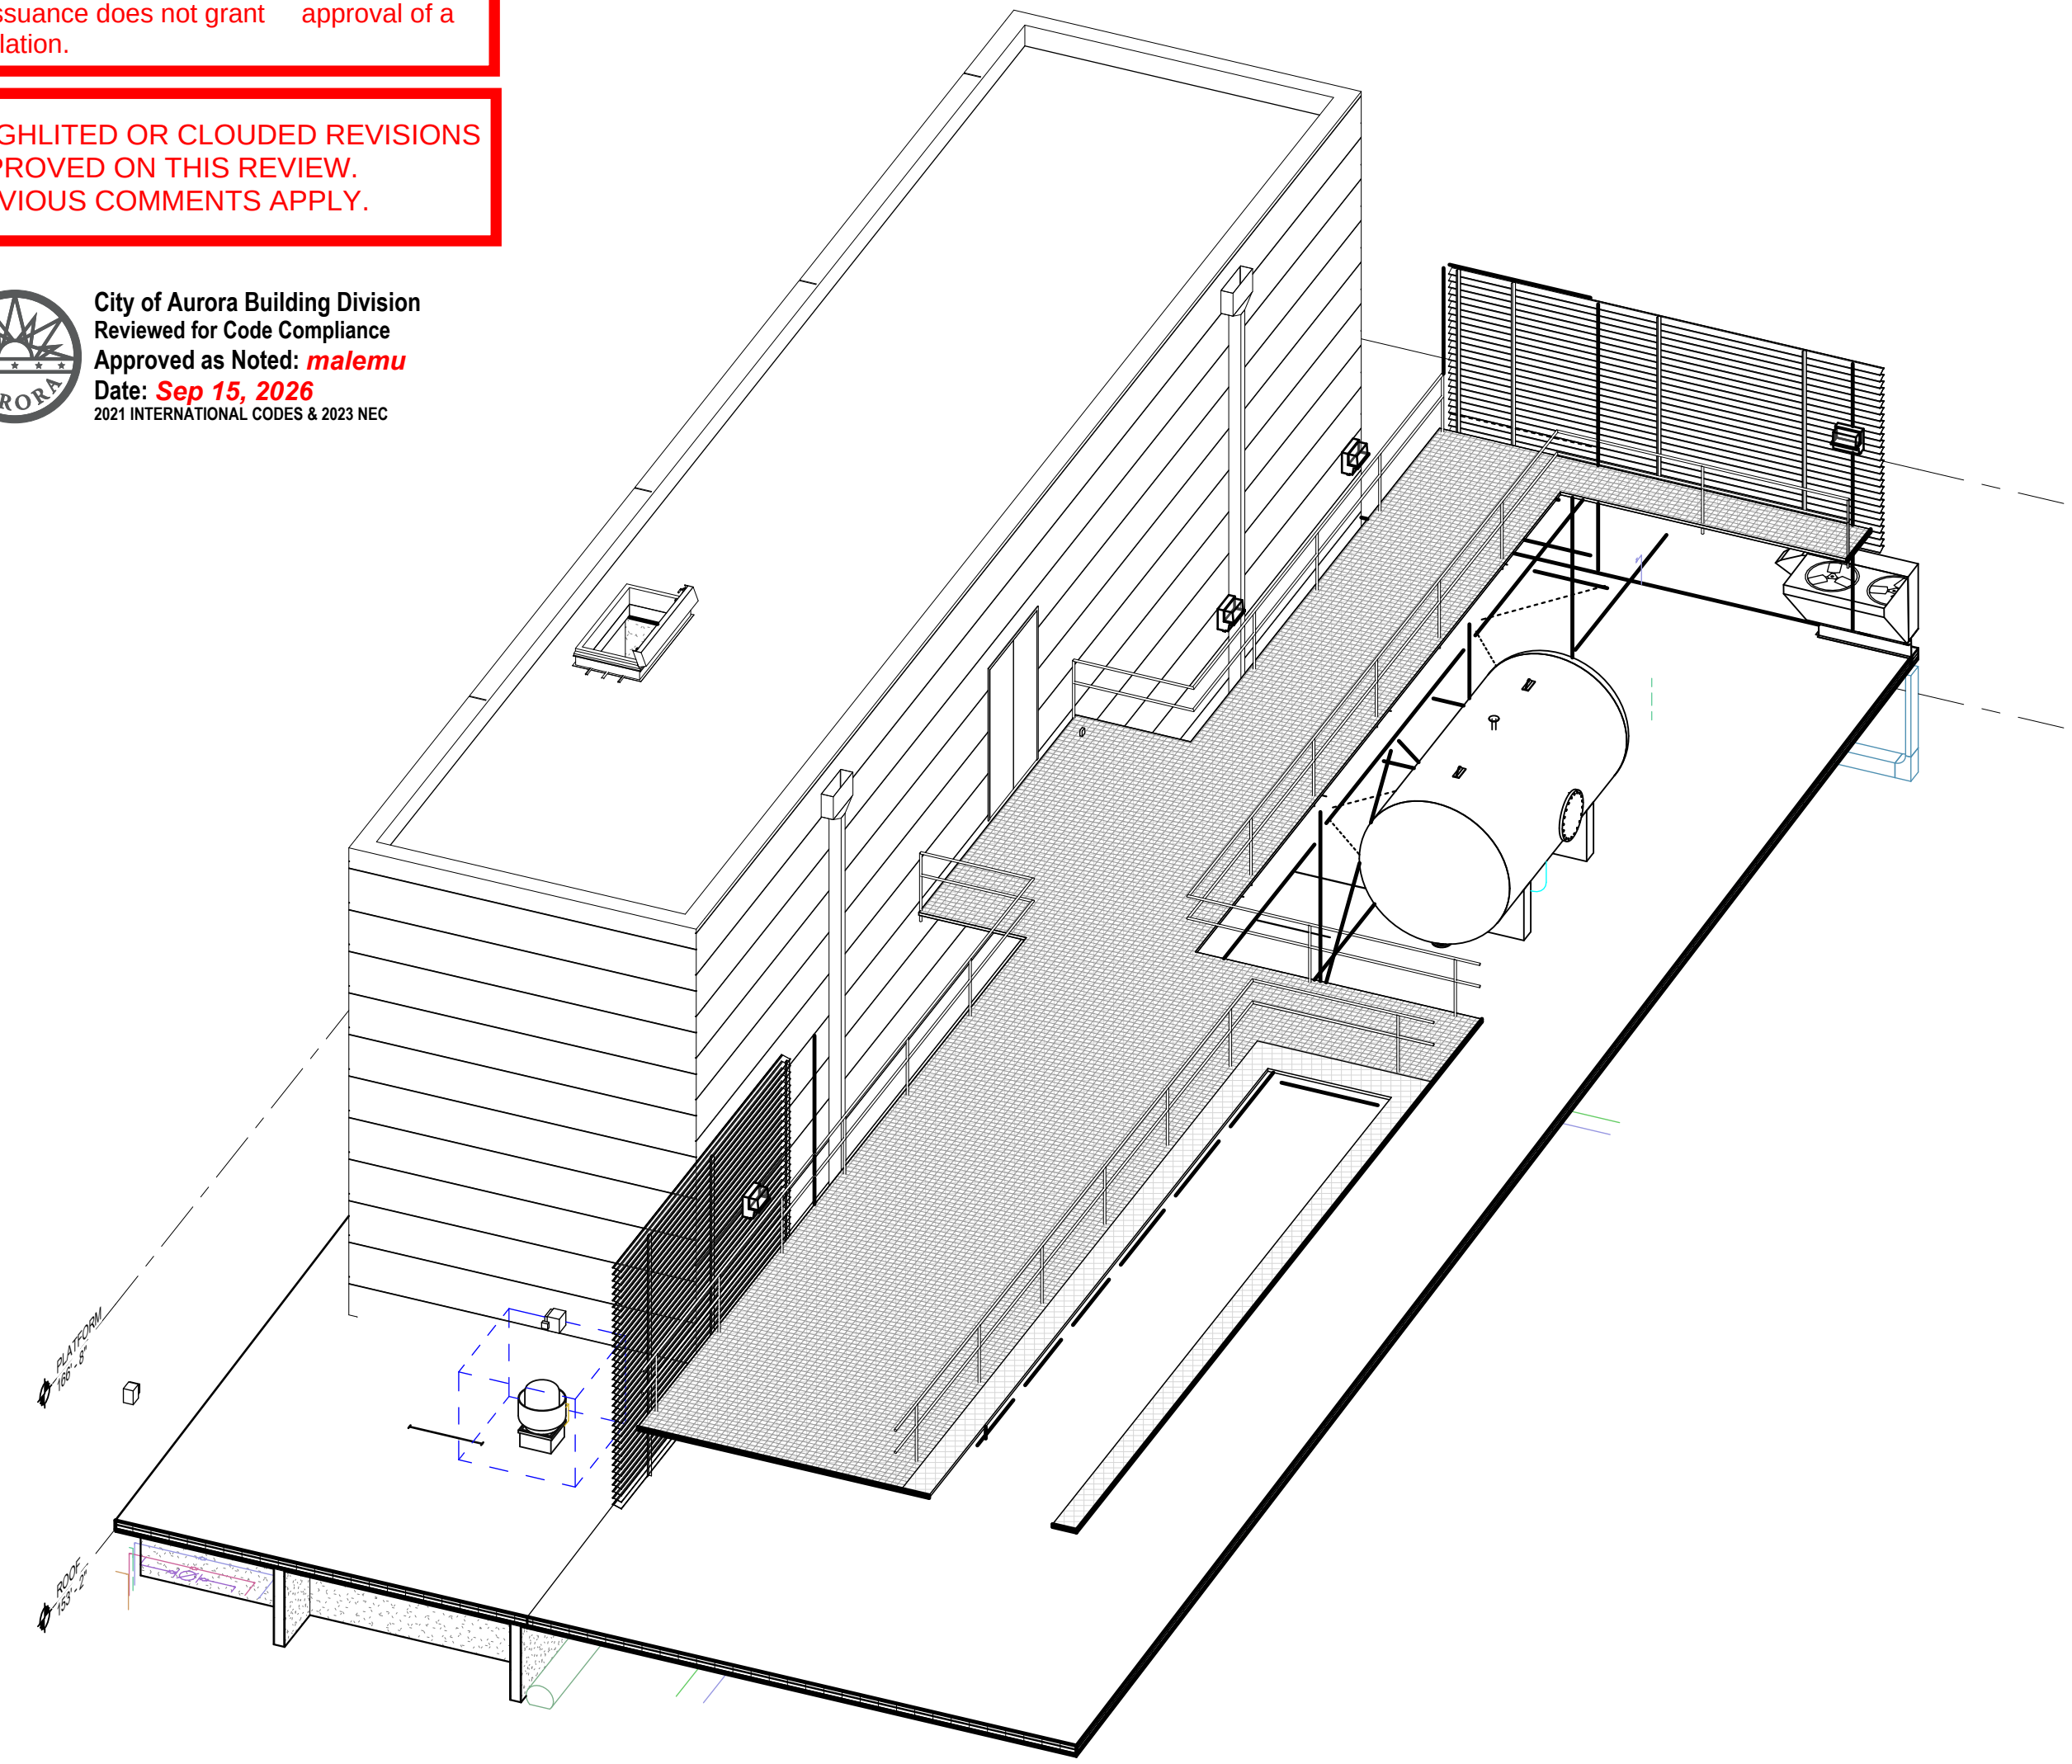


2 PENTHOUSE AXON

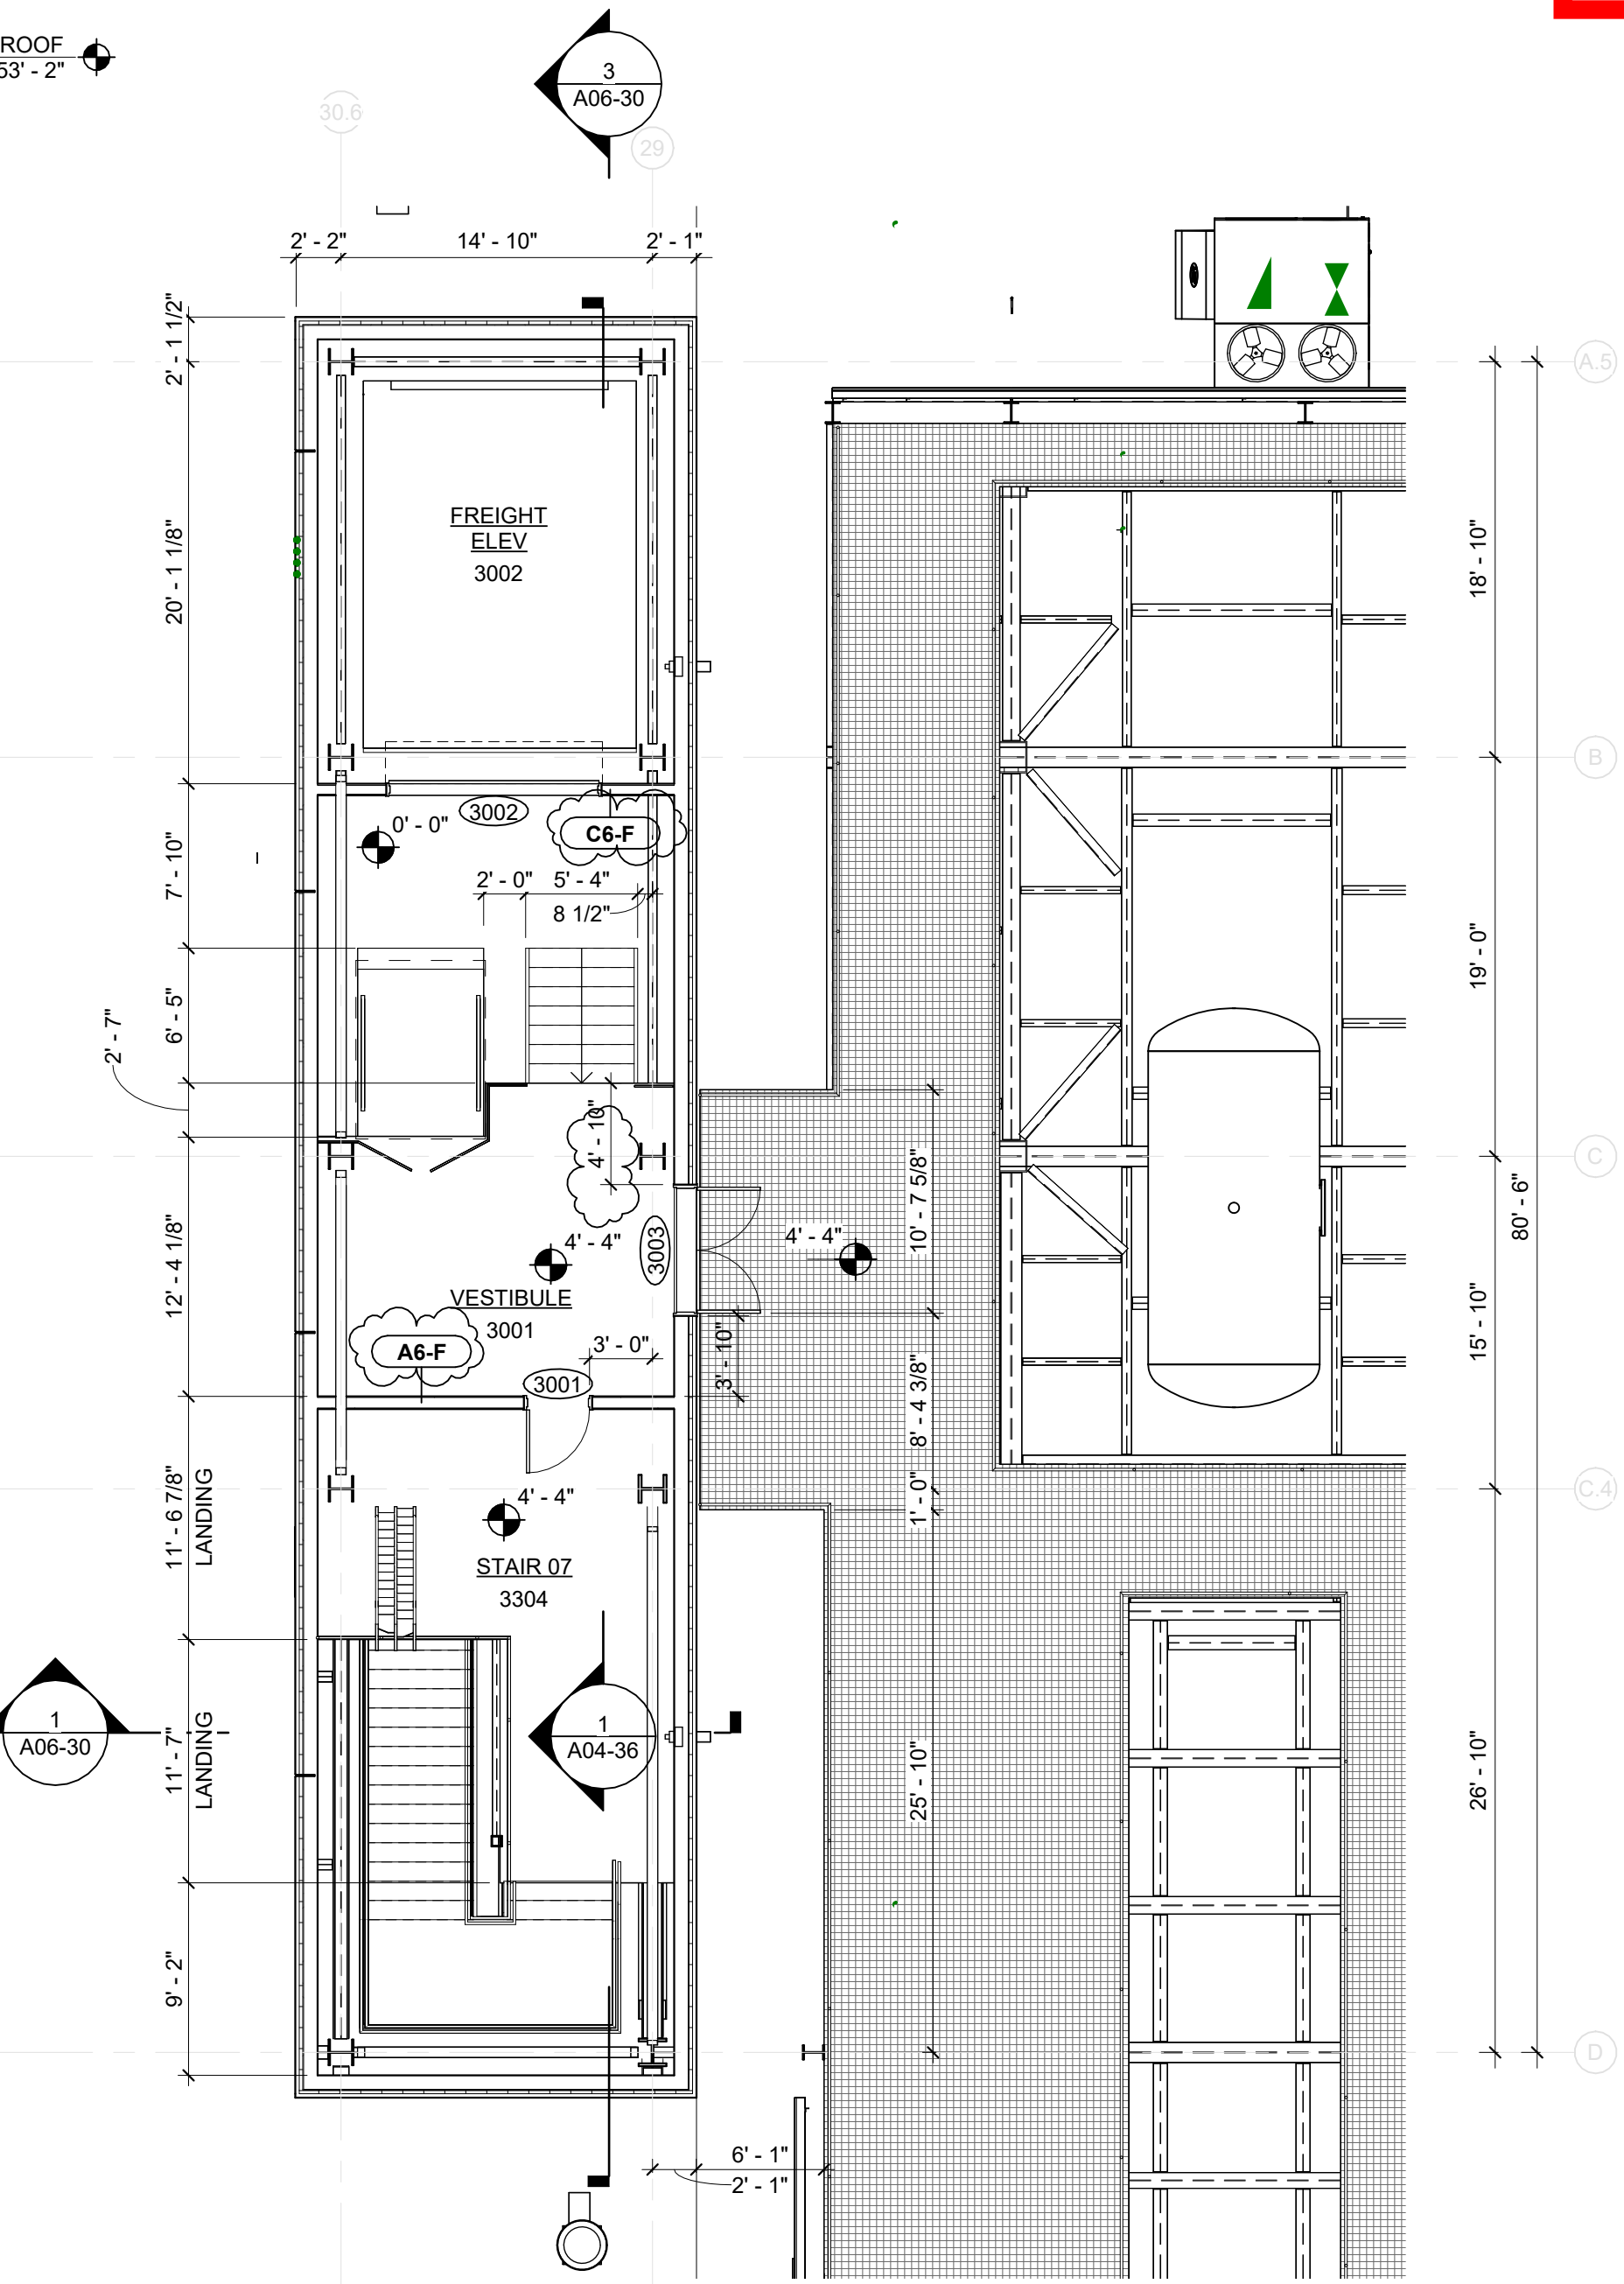


4 ENLARGED ROOF PLAN - PENTHOUSE
1/8" = 1'-0"

5 SECTION DETAIL - PENTHOUSE METAL PANEL TERMINATION, ROOFING TERMINATION
1 1/2" = 1'-0"

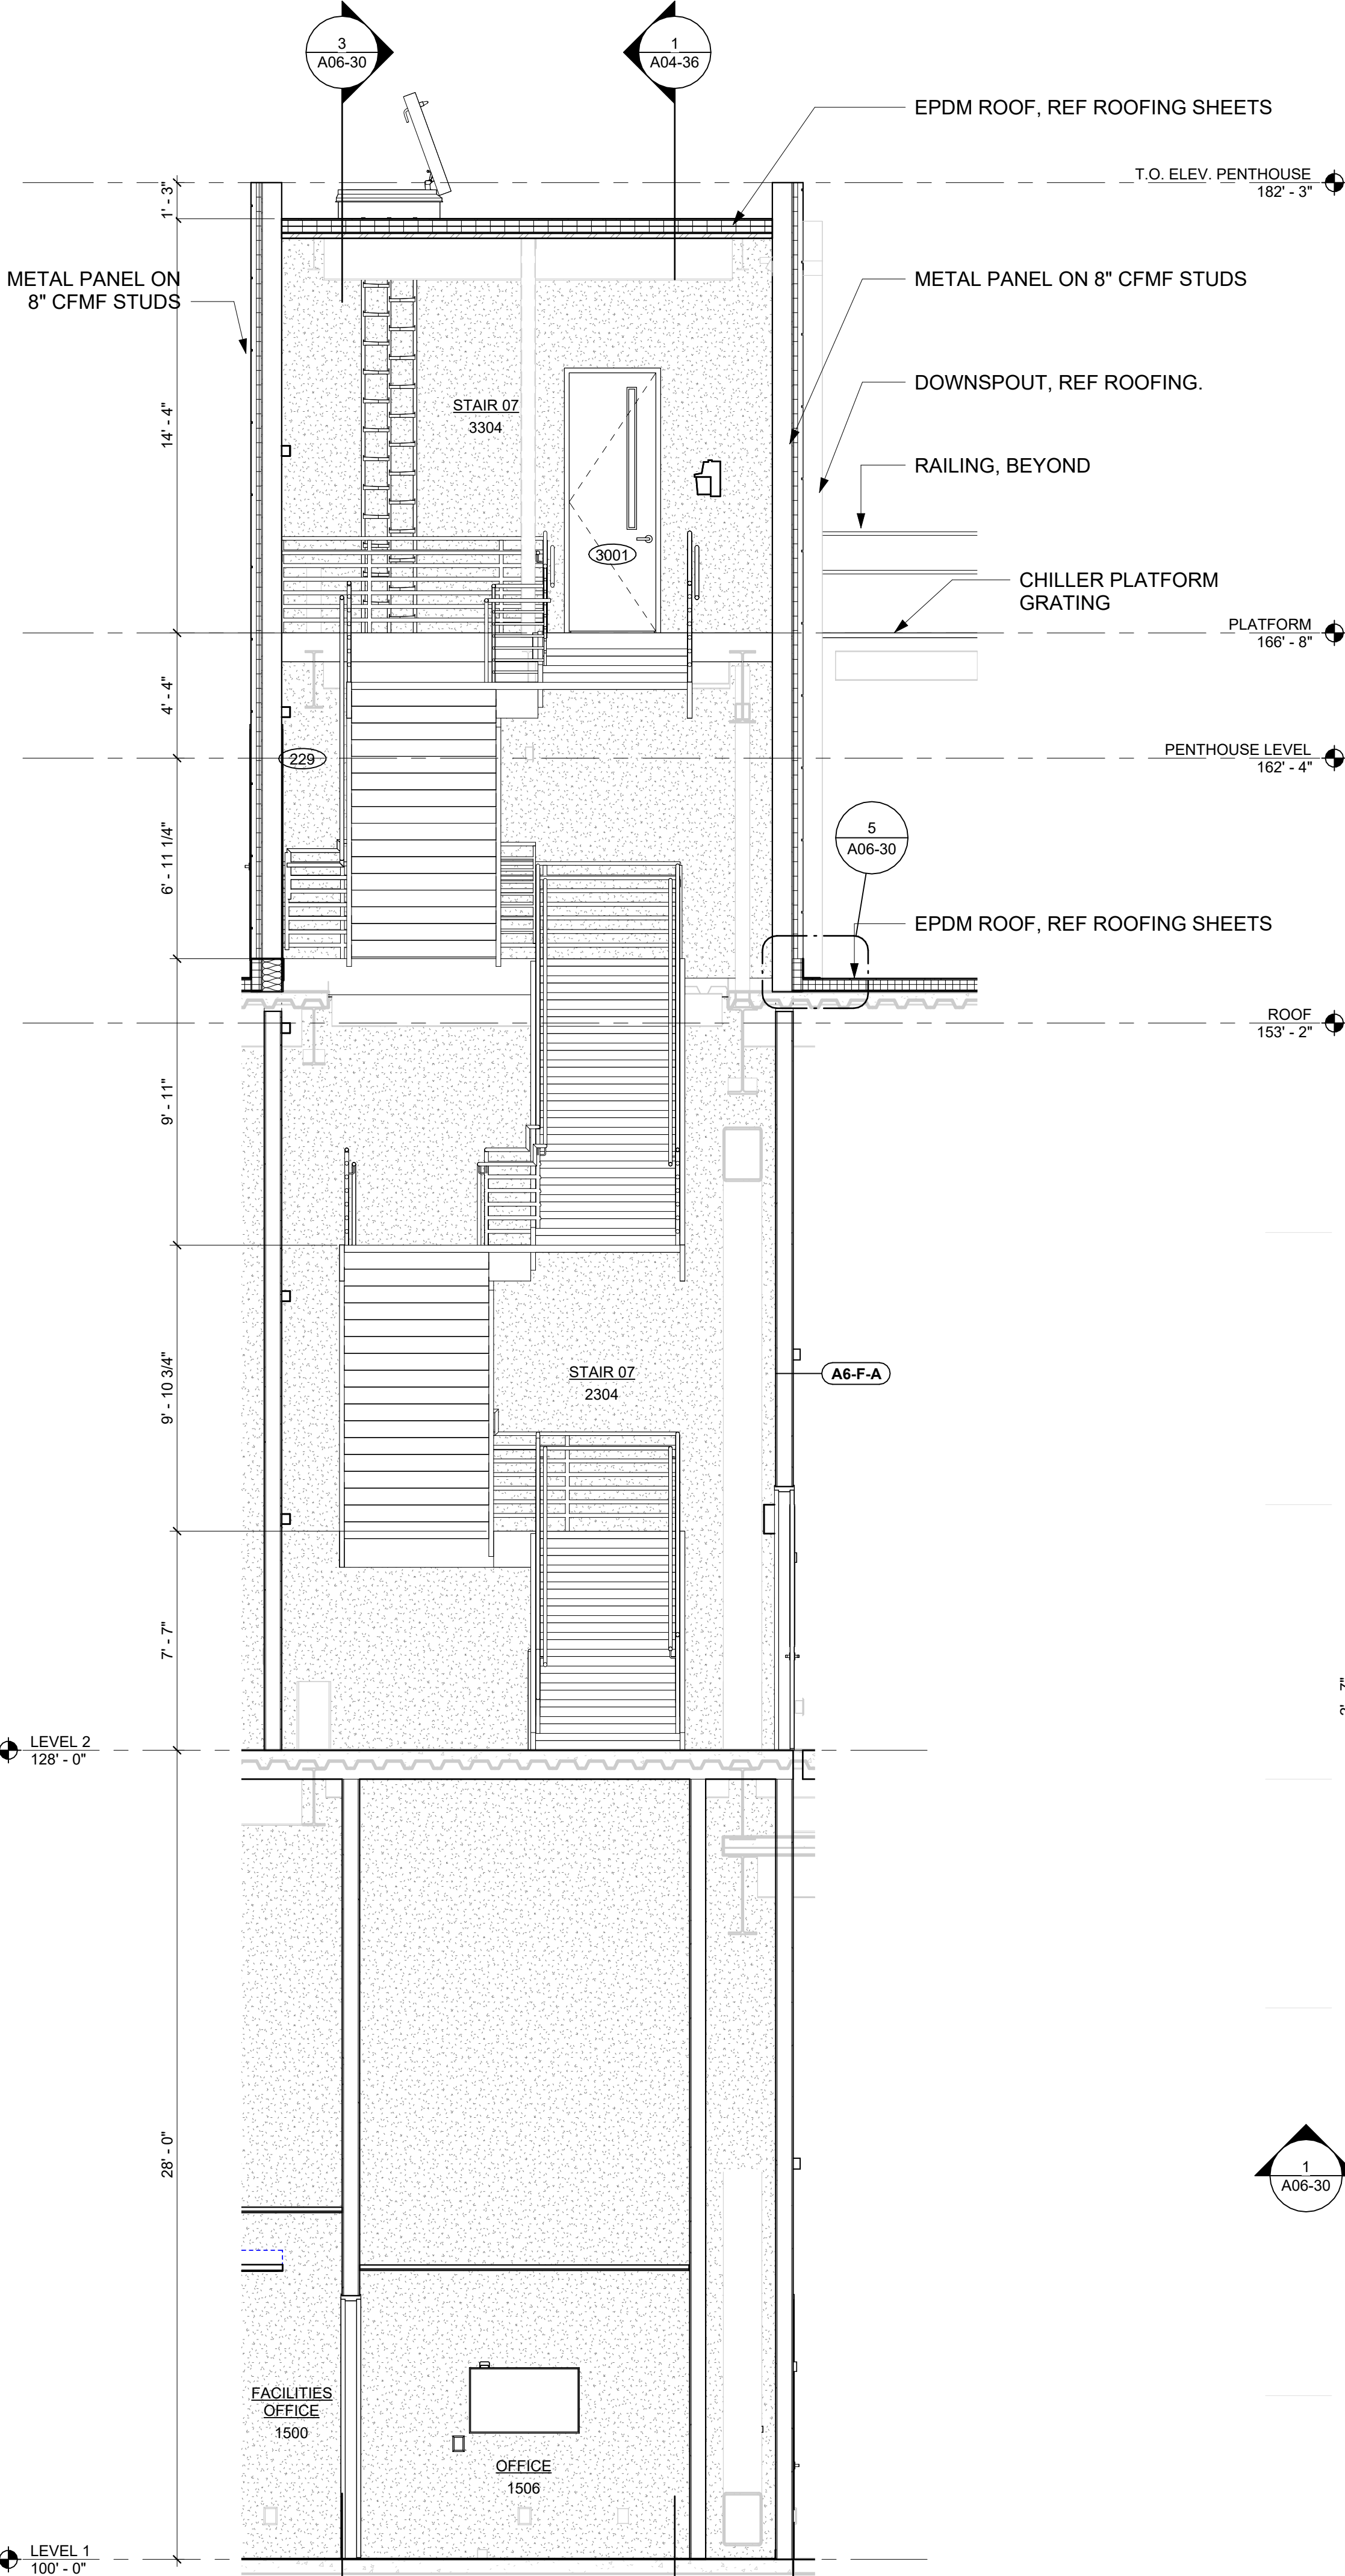

1 E/W SECTION - PENTHOUSE
1/4" = 1'-0"

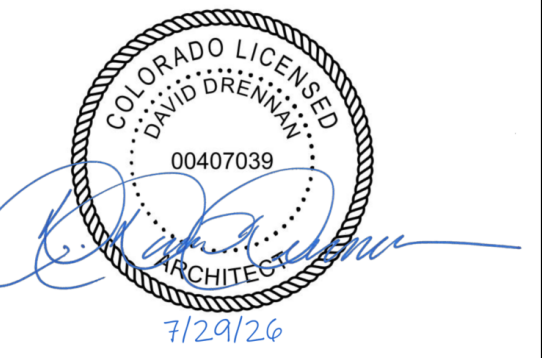[illegible]

Date of issue:
07.29.2026

QTS DEN1 DC2
1140 N. GUN CLUB ROAD

EYPLAN

S	Q	N	L	J	G	E	C	A
T	R	P	M	K	H	F	D	B

PENTHOUSE DETAILS


JOB 24464.0000
DATE 07.29.2026
SHEET

A06-31



City of Aurora Building Division
Reviewed for Code Compliance
Approved as Noted: **malemu**
Date: **Sep 15, 2026**
2021 INTERNATIONAL CODES & 2023 NEC

ONLY HIGHLIGHTED OR CLOUDED REVISIONS
ARE APPROVED ON THIS REVIEW.
ALL PREVIOUS COMMENTS APPLY.

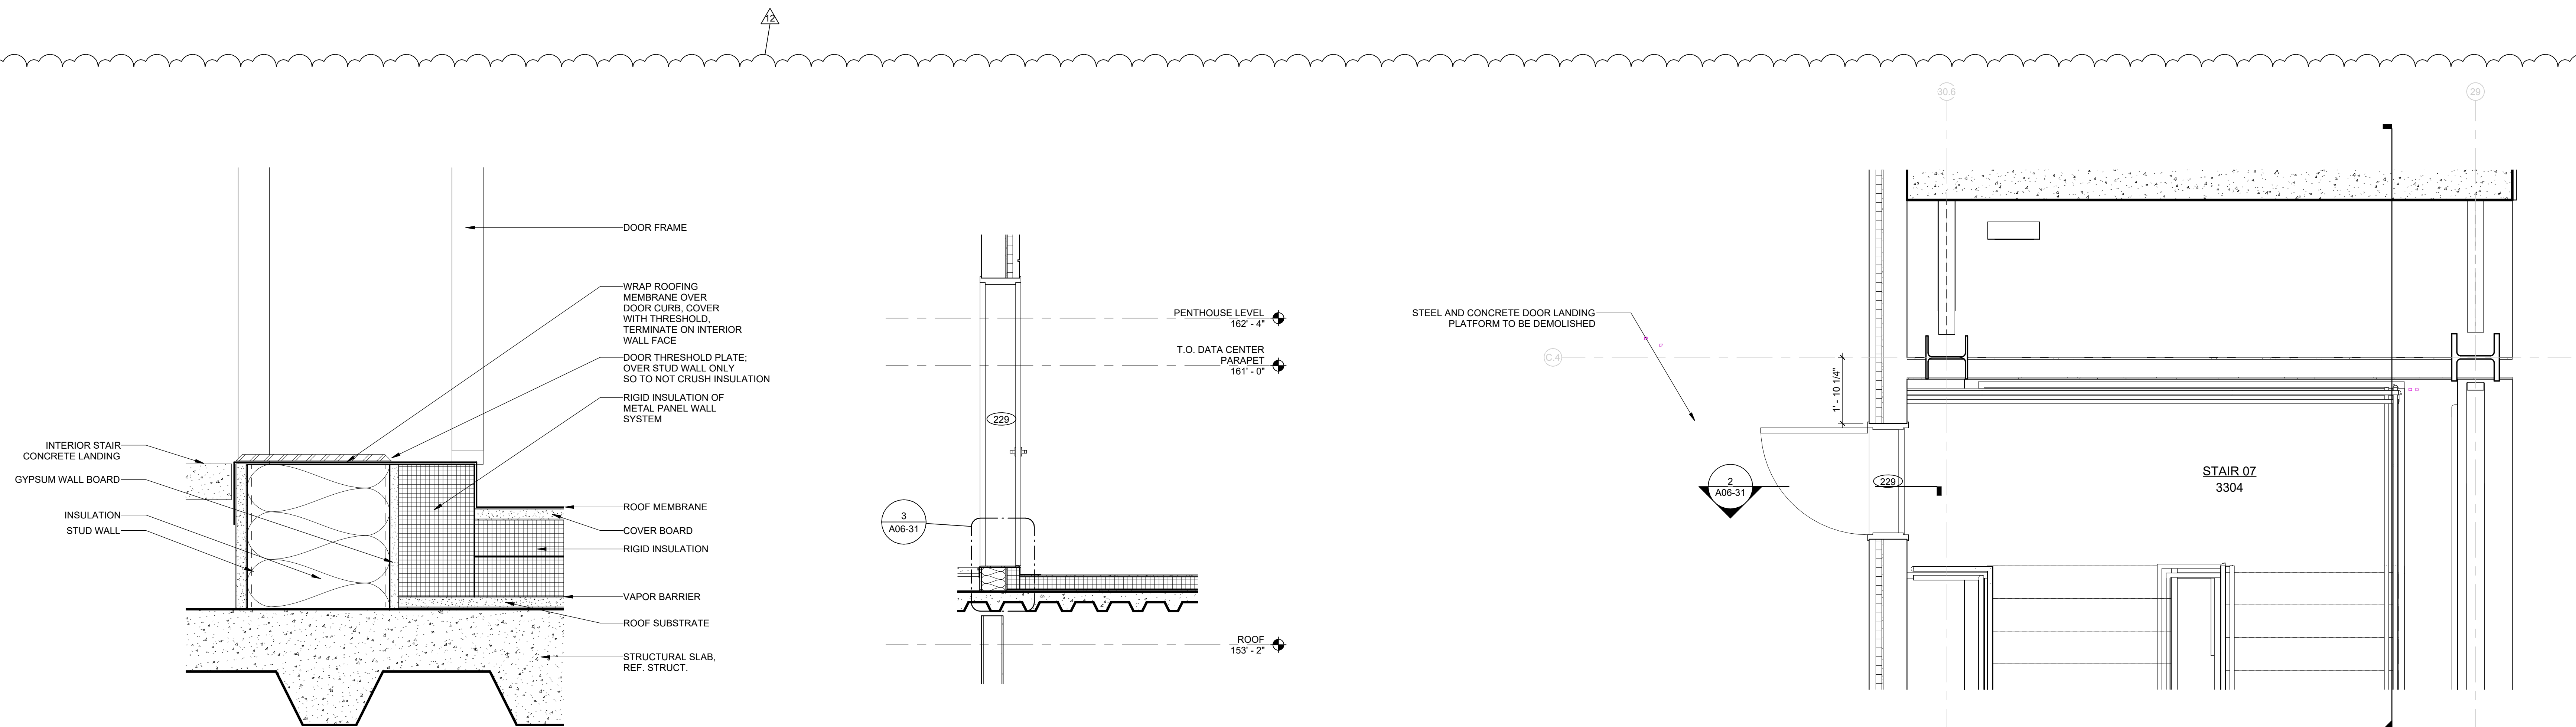


7/29/2026 10:02:36 PM A06-31 PENTHOUSE DETAILS

3 SECTION DETAIL - ROOFING TERMINATION AT DOOR OPENING
3" = 1'-0"


2 SECTION @ DOOR 229 - STAIR 07 - ROOF ACCESS
1/2" = 1'-0"

1 ENLARGED PLAN - STAIR 07 - INTERMEDIATE LEVEL - DEMOLITION PLAN
1/2" = 1'-0"

6/6/2025 6:48:28 PM A06-22 WALL SECTIONS

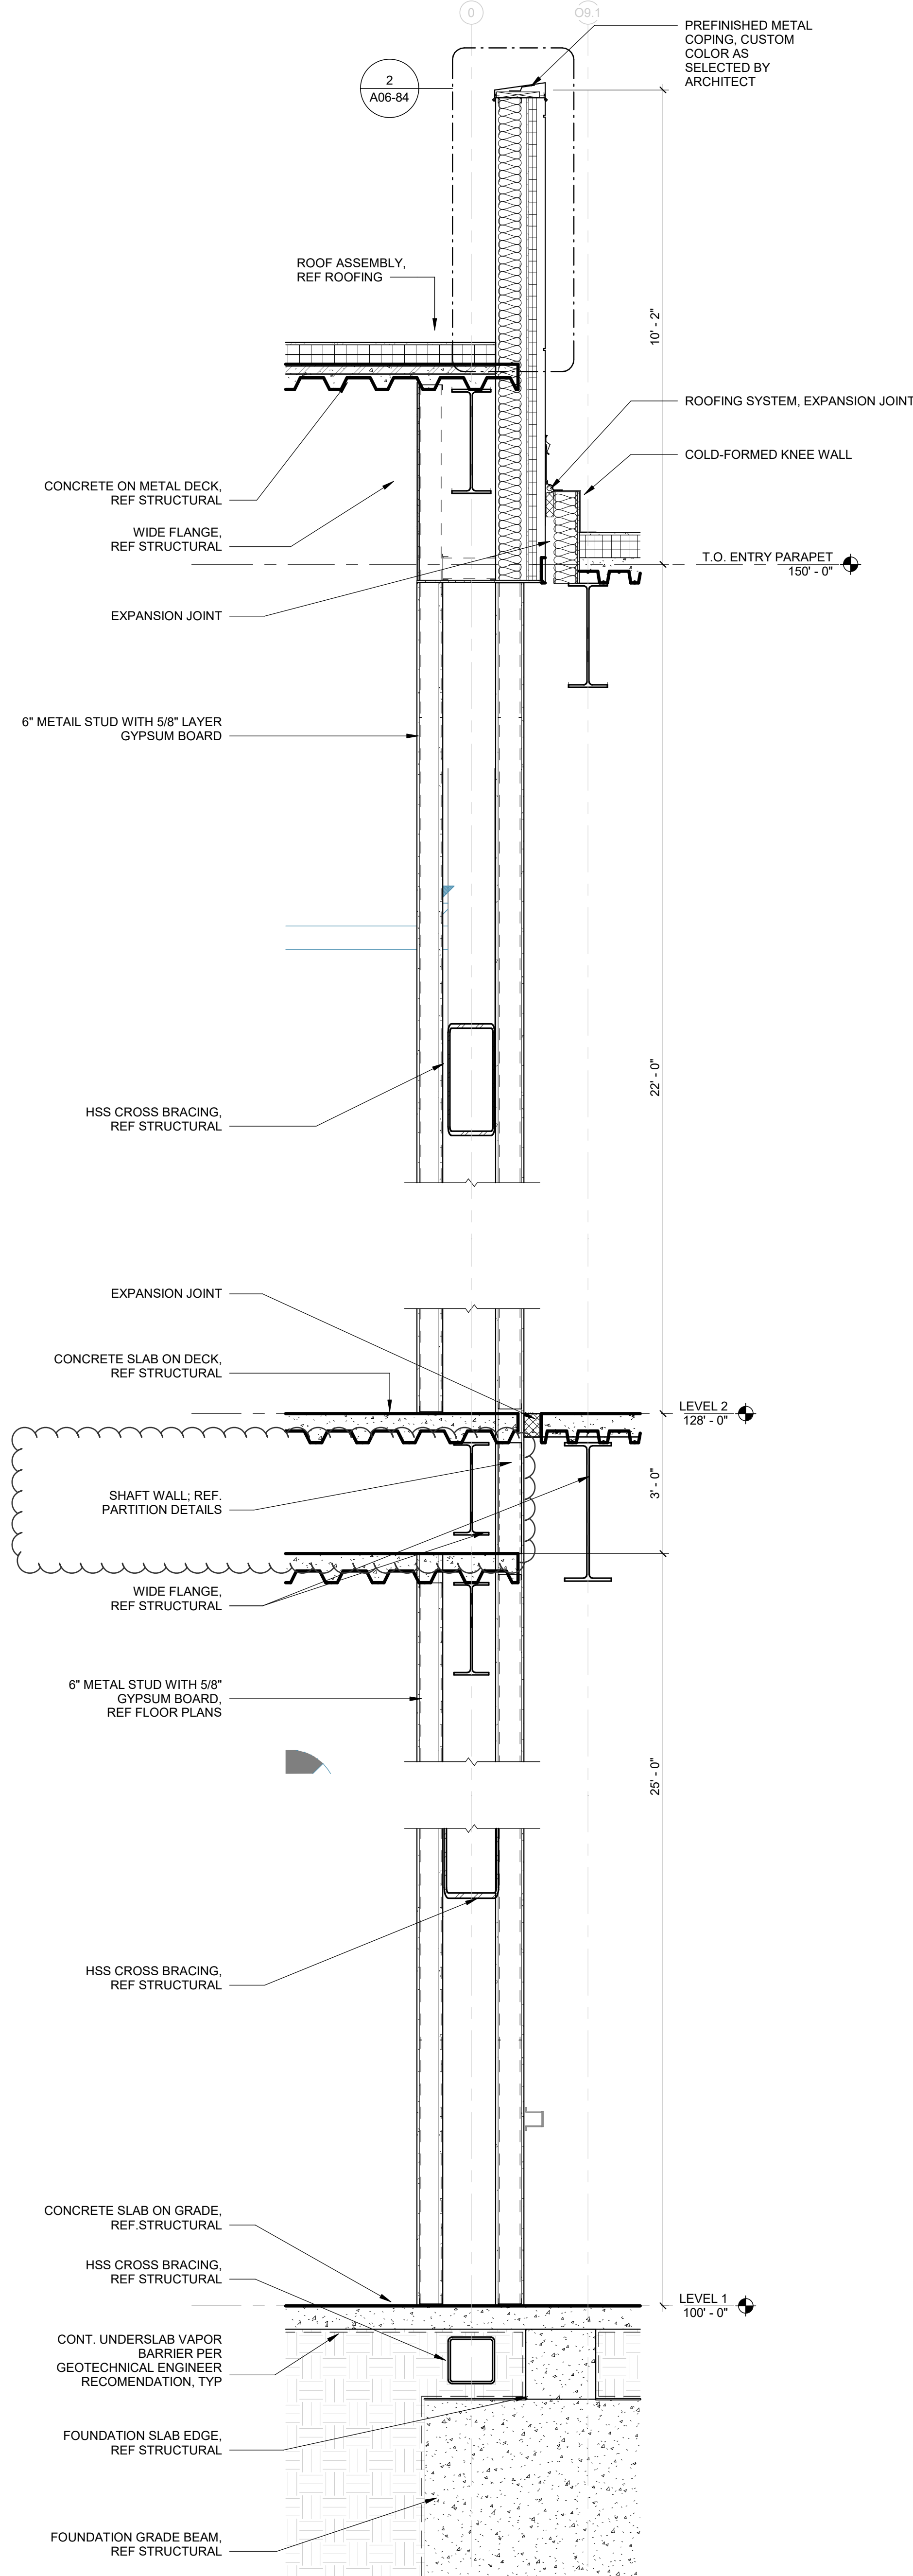

2 WALL SECTION @ ADMIN TO DH
1/2" = 1'-0"

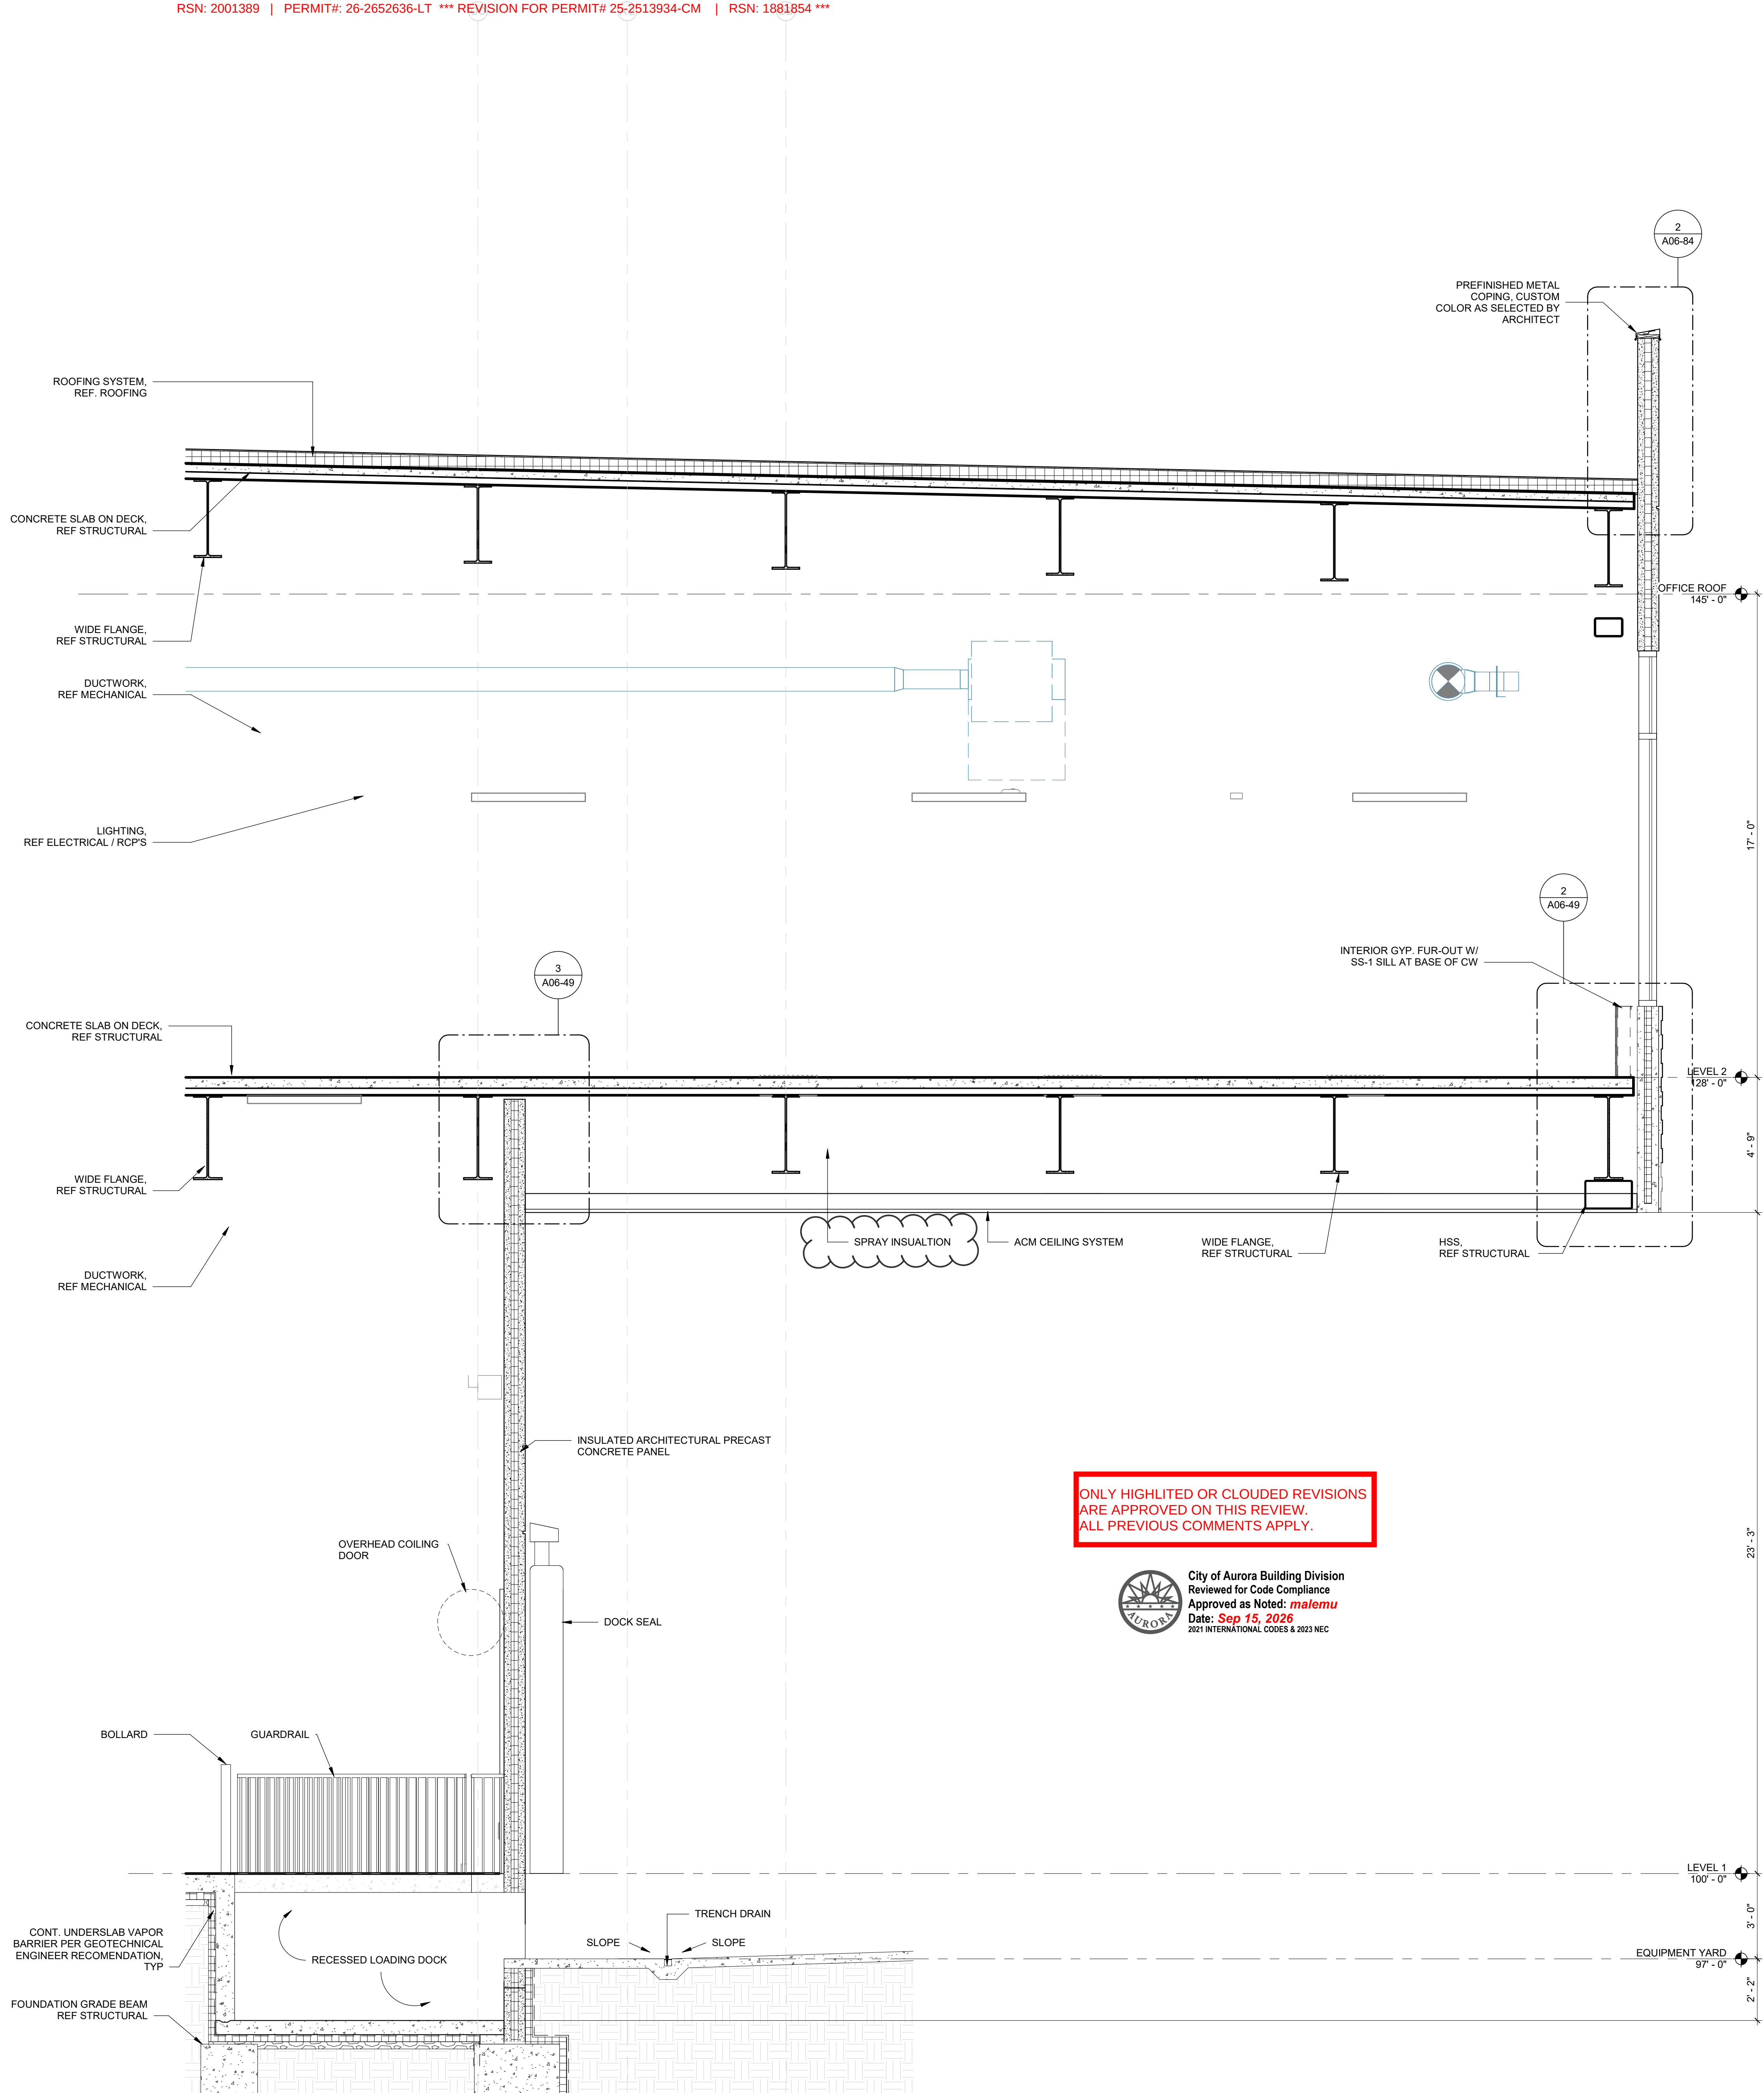

1 WALL SECTION @ DATA CENTER LOADING DOCK
3/8" = 1'-0"


ONLY HIGHLIGHTED OR CLOUDED REVISIONS
ARE APPROVED ON THIS REVIEW.
ALL PREVIOUS COMMENTS APPLY.



CORGAN

401 N. Houston Street Dallas, TX 75202
T: 214.748.2000

AG/E

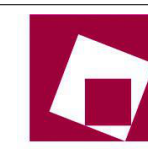

SYSKA HENNESSY
GROUP


TD
DESIGN CONSULTING LLC

ISSUES

1	12.20.24	DESIGN DEVELOPMENT
2	01.31.25	ISSUE FOR PERMIT
3	04.18.25	DH FIT OUT - DD
4	05.16.25	DH FIT OUT - IFP
5	05.30.25	ISSUE FOR CONSTRUCTION

REVISIONS

1		
2		
3		
4		
5		
6		
7		
8		
9		
10		

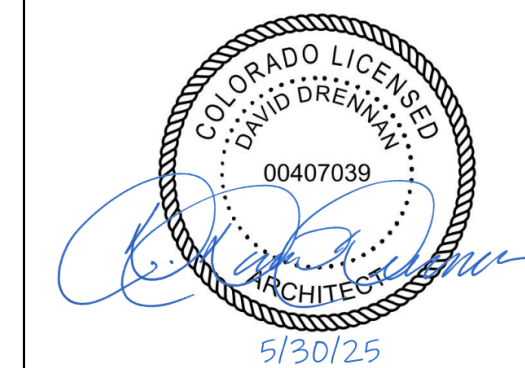

Date of issue:
05.30.25




QTS DEN1 DC2
1140 N. GUN CLUB ROAD
QTS

WALL SECTIONS

JOB 24464.0000
DATE 05.30.25
SHEET

A06-22

7/29/2026 10:02:10 PM A06-23 WALL SECTIONS

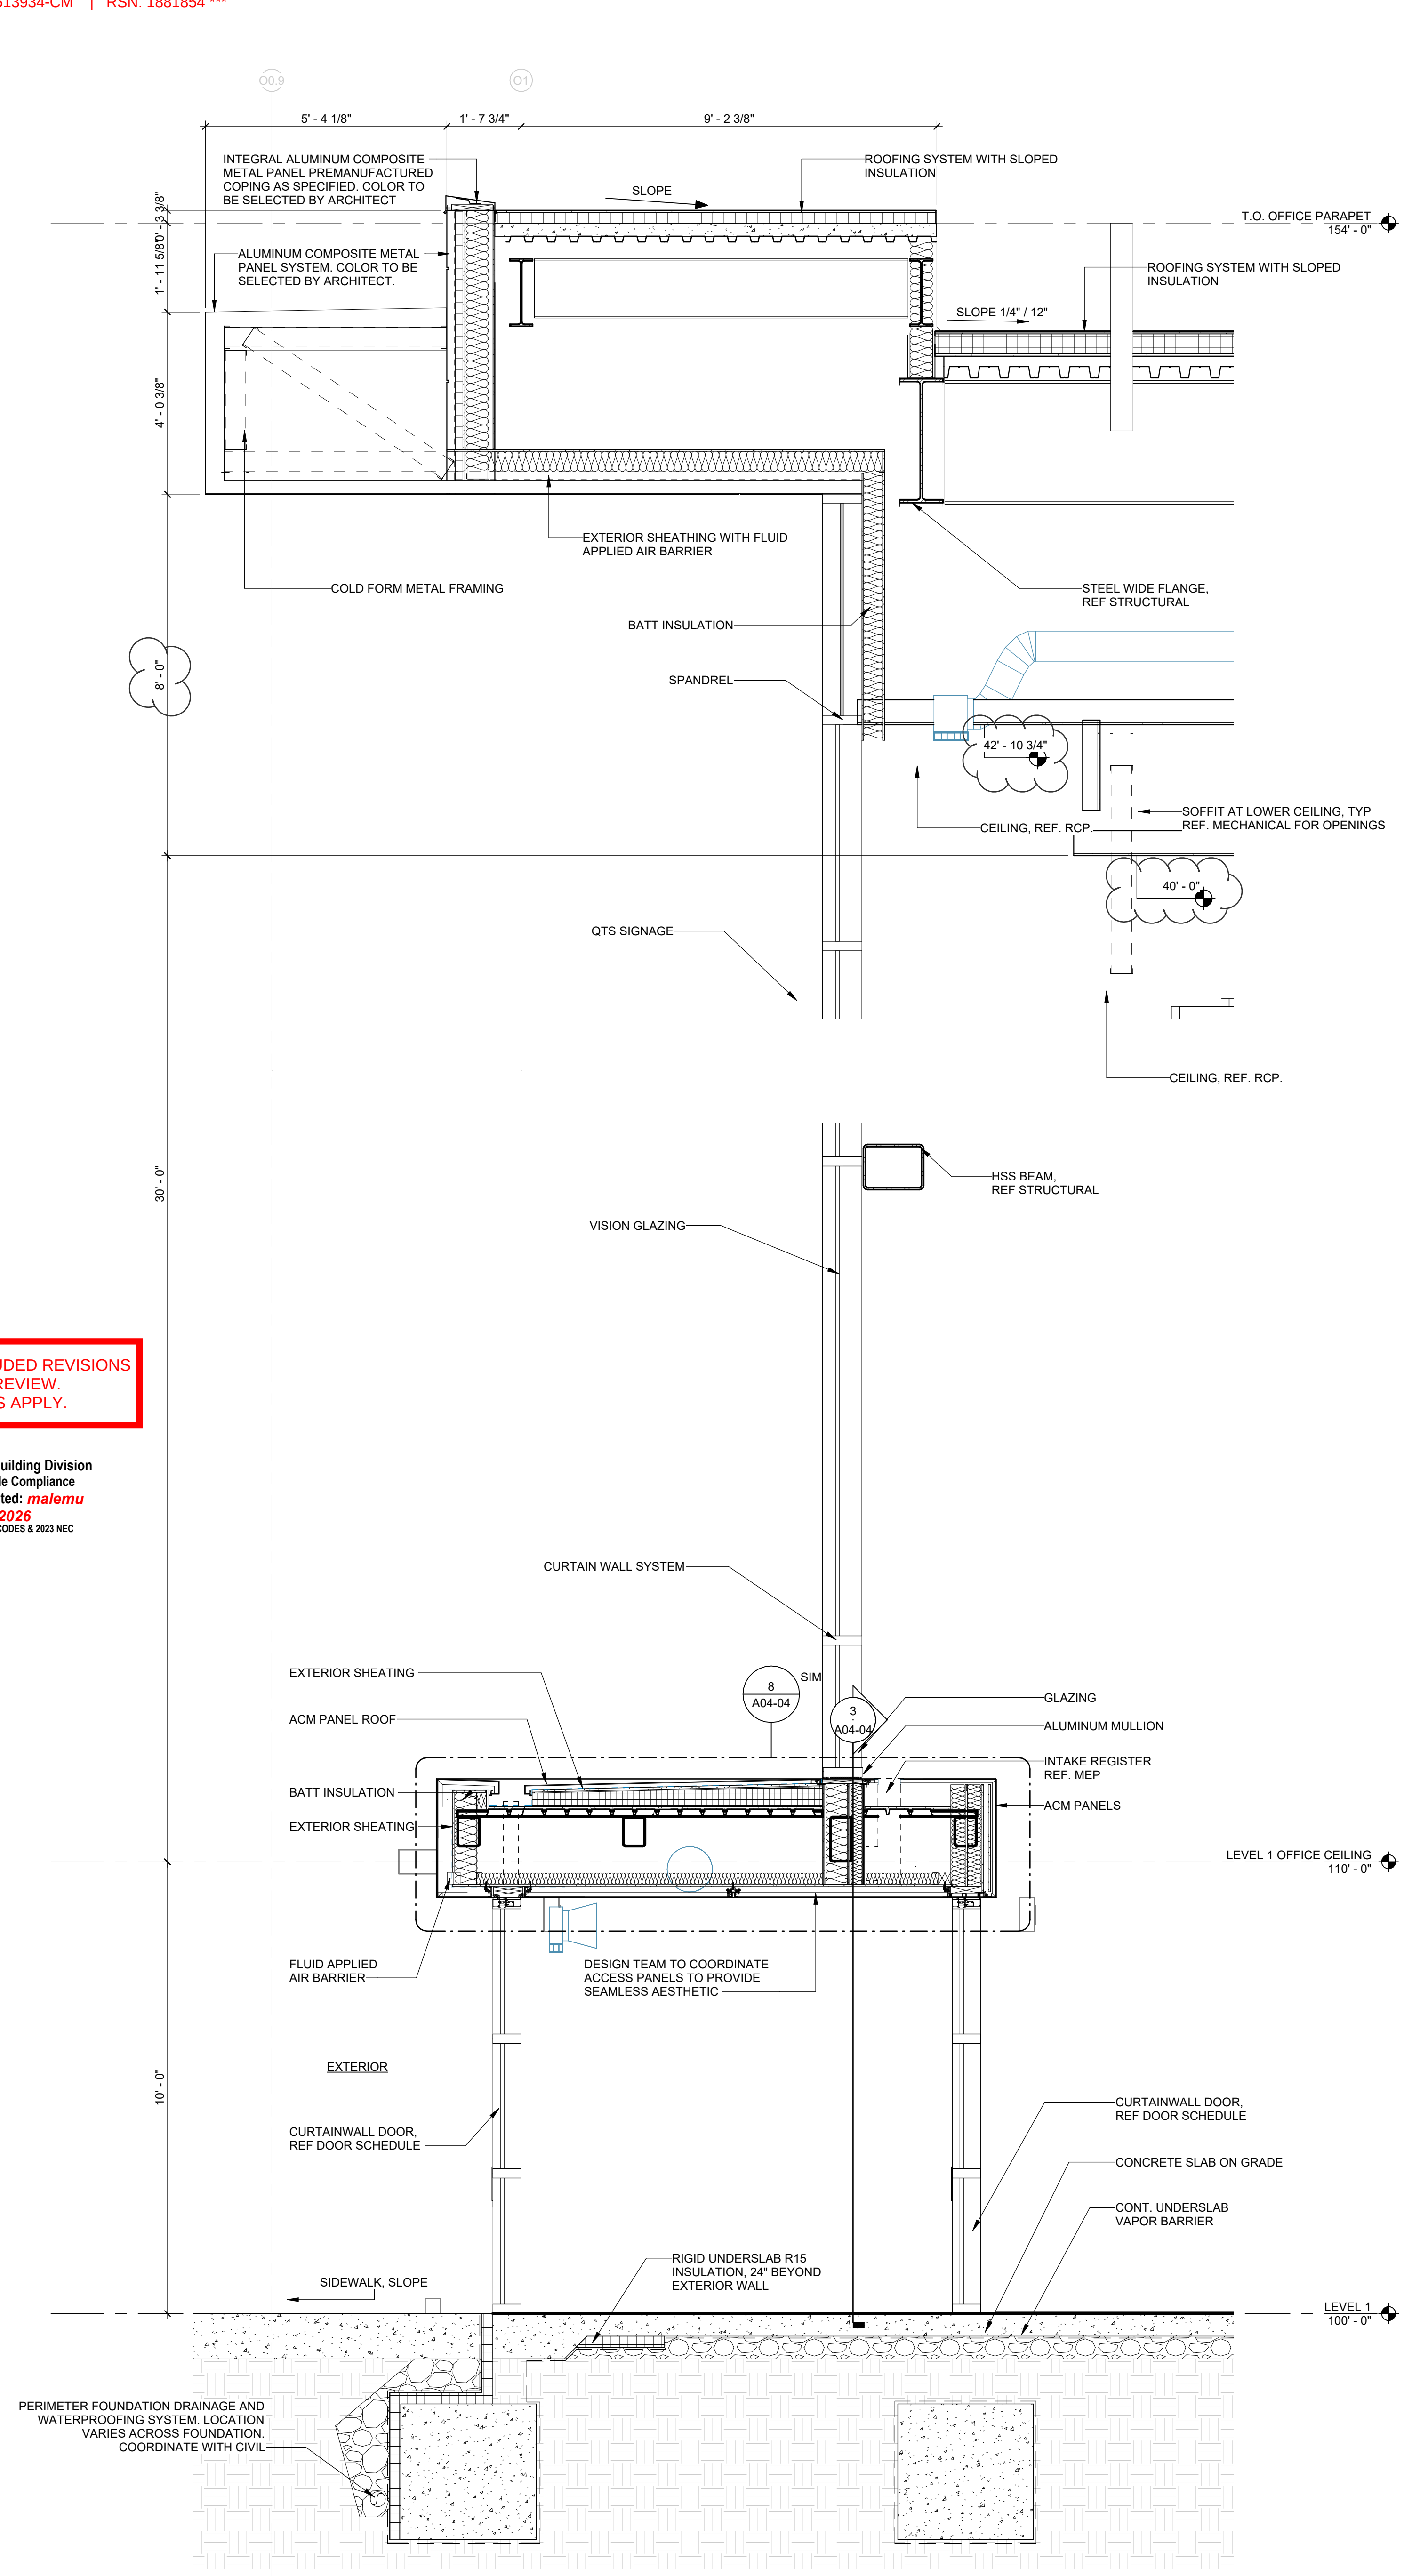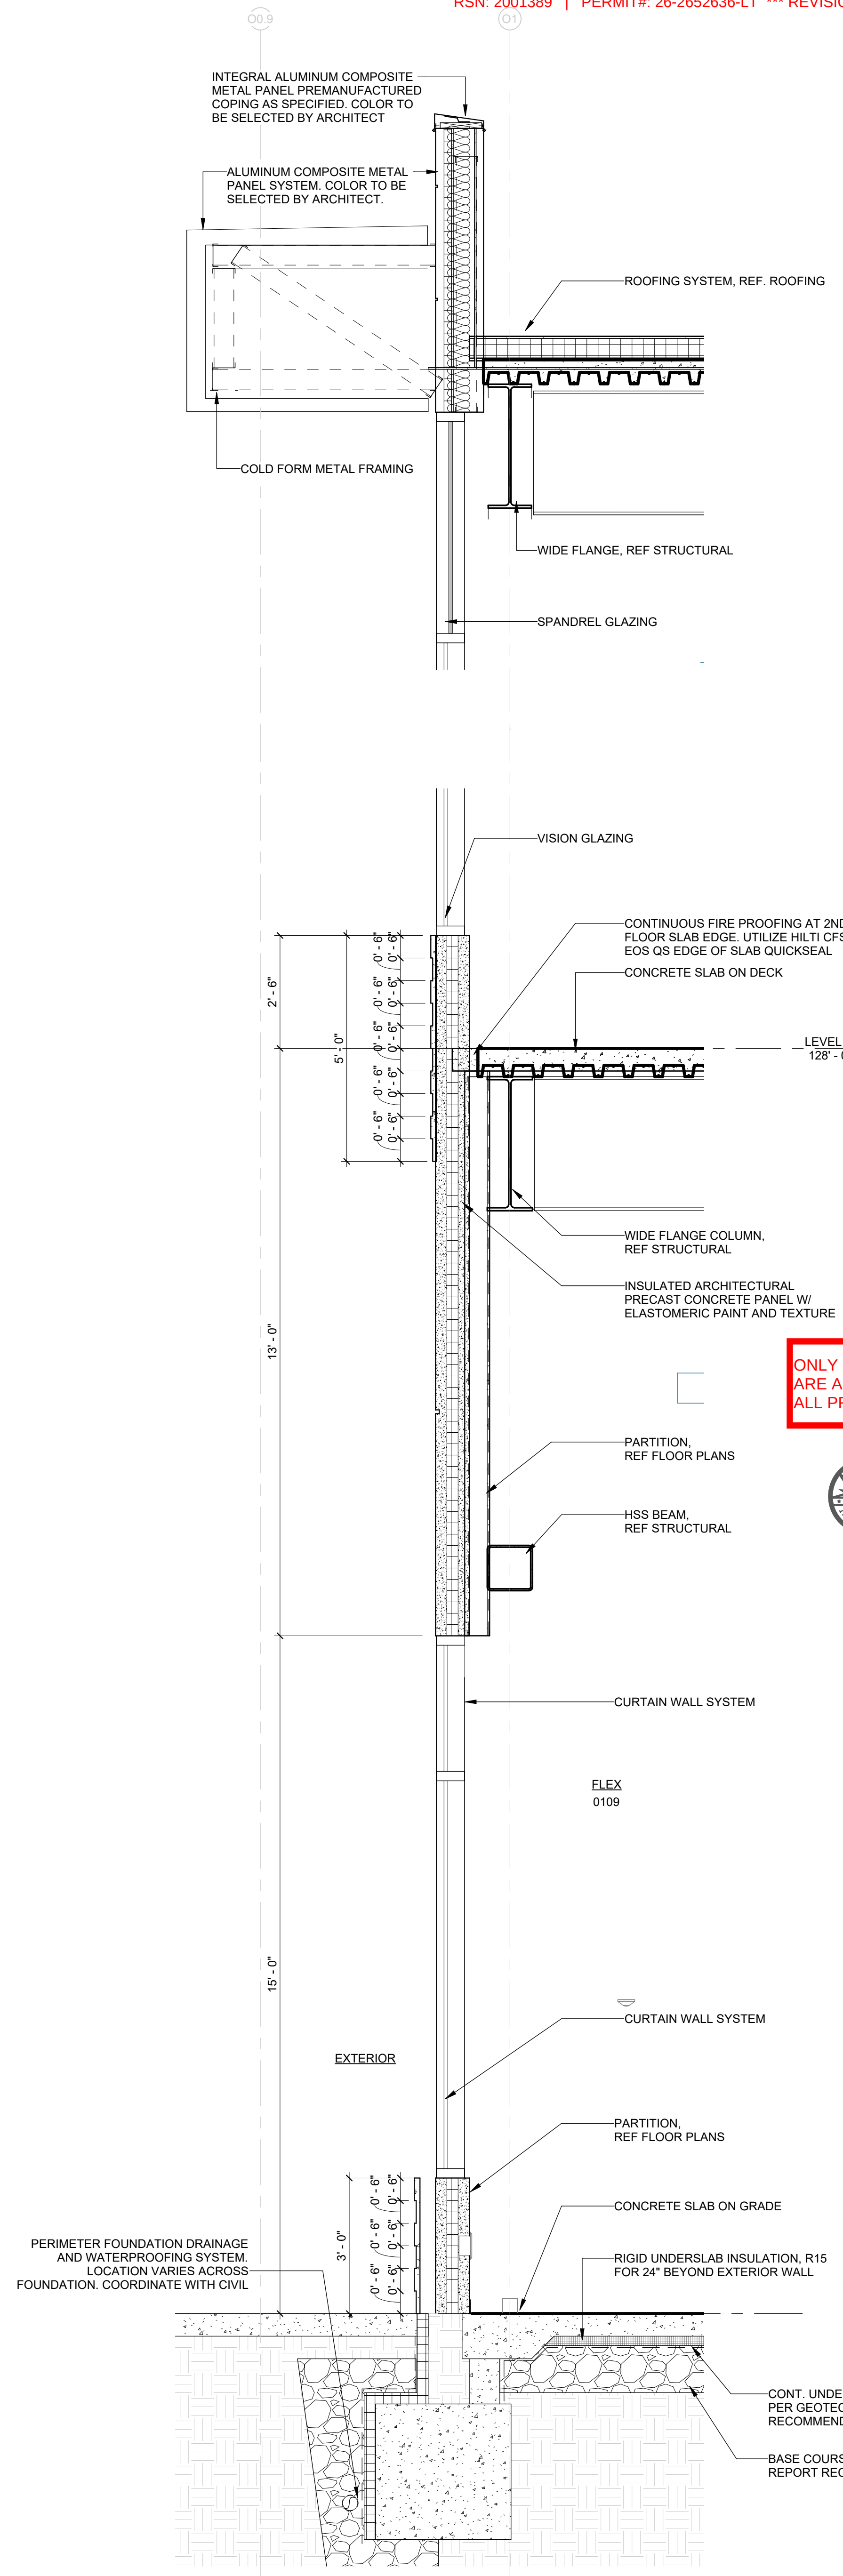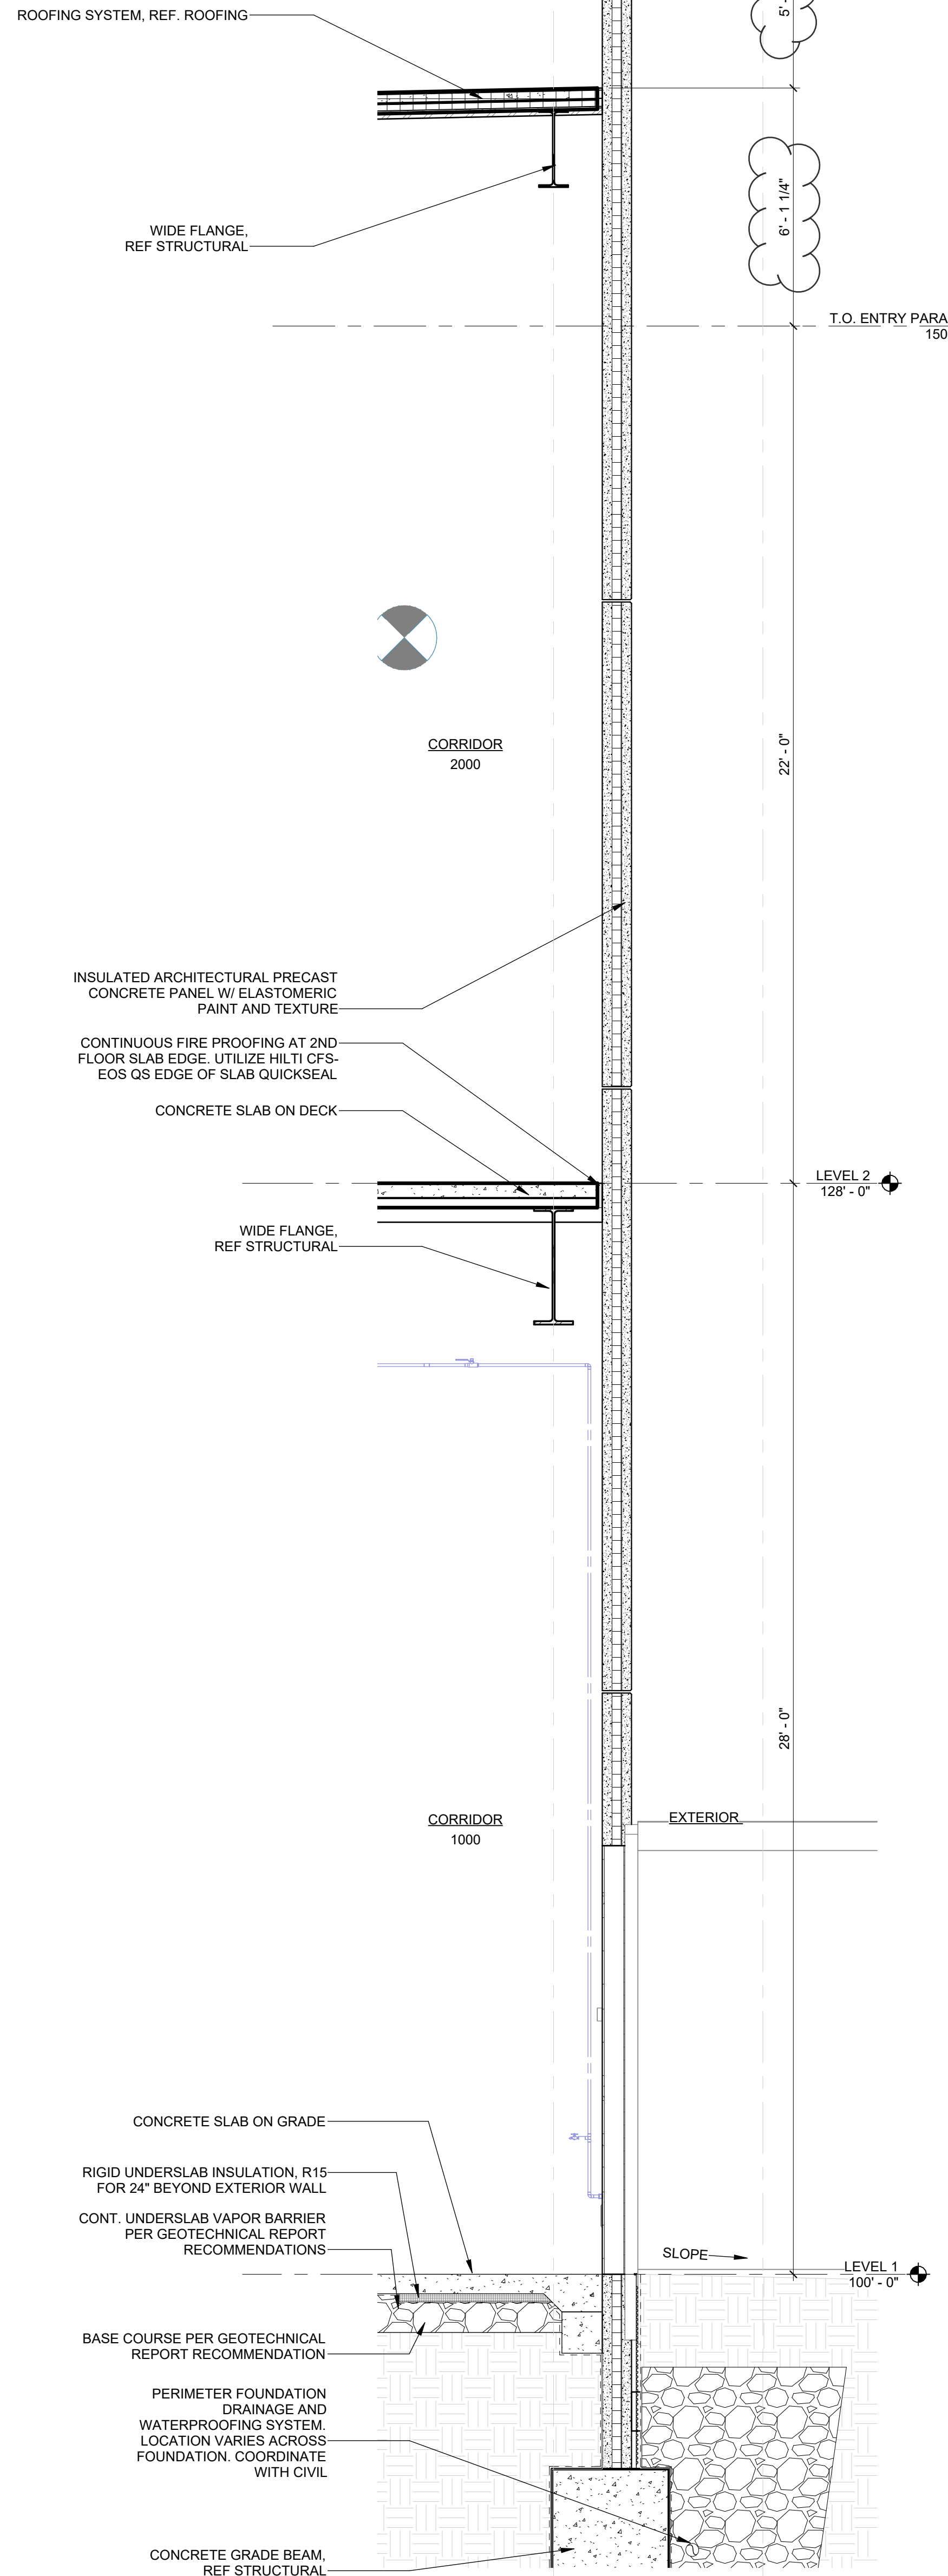

ONLY HIGHLIGHTED OR CLOUDED REVISIONS ARE APPROVED ON THIS REVIEW. ALL PREVIOUS COMMENTS APPLY.

City of Aurora Building Division
Reviewed for Code Compliance
Approved as Noted: **malemu**
Date: **Sep 15, 2026**
2021 INTERNATIONAL CODES & 2023 NEC

CORGAN

401 N. Houston Street Dallas, TX 75202
T: 214.748.2000

AG-E

SYSKA
HENNESSY
GROUP
ENGINEERING THE AMAZING

TD
DESIGN CONSULTING LLC

ISSUES

1	02.13.2026	C&S BULLETIN 1
2	05.19.2026	C&S BULLETIN 2
3	07.29.2026	C&S BULLETIN 3

4		
5		
6		
7		
8		
9		
10		

REVISIONS

12	07.29.2026	C&S BULLETIN 3
----	------------	----------------

00407039
7/29/26

Date of issue:
07.29.2026

QTS DEN1 DC2
1140 N. GUN CLUB ROAD
QTS

WALL SECTIONS

JOB 24464.0000
DATE 07.29.2026
SHEET

A06-23

ISSUES

1	02.13.2026	C&S BULLETIN 1
2	05.19.2026	C&S BULLETIN 2
3	07.29.2026	C&S BULLETIN 3

4		
5		
6		
7		
8		
9		
10		

REVISIONS

11	01.29.2020	
12	07.29.2026	C&S BULLETIN 3



Date of issue:
07.29.2026

QTS DEN1 DC2
1140 N. GUN CLUB ROAD
QTS


KEYPLAN

S	Q	N	L	J	G	E	C	A
T	R	P	M	K	H	F	D	B

ROOF DETAILS



JOB 24464.0000
DATE 07.29.2026
SHEET

A06-85

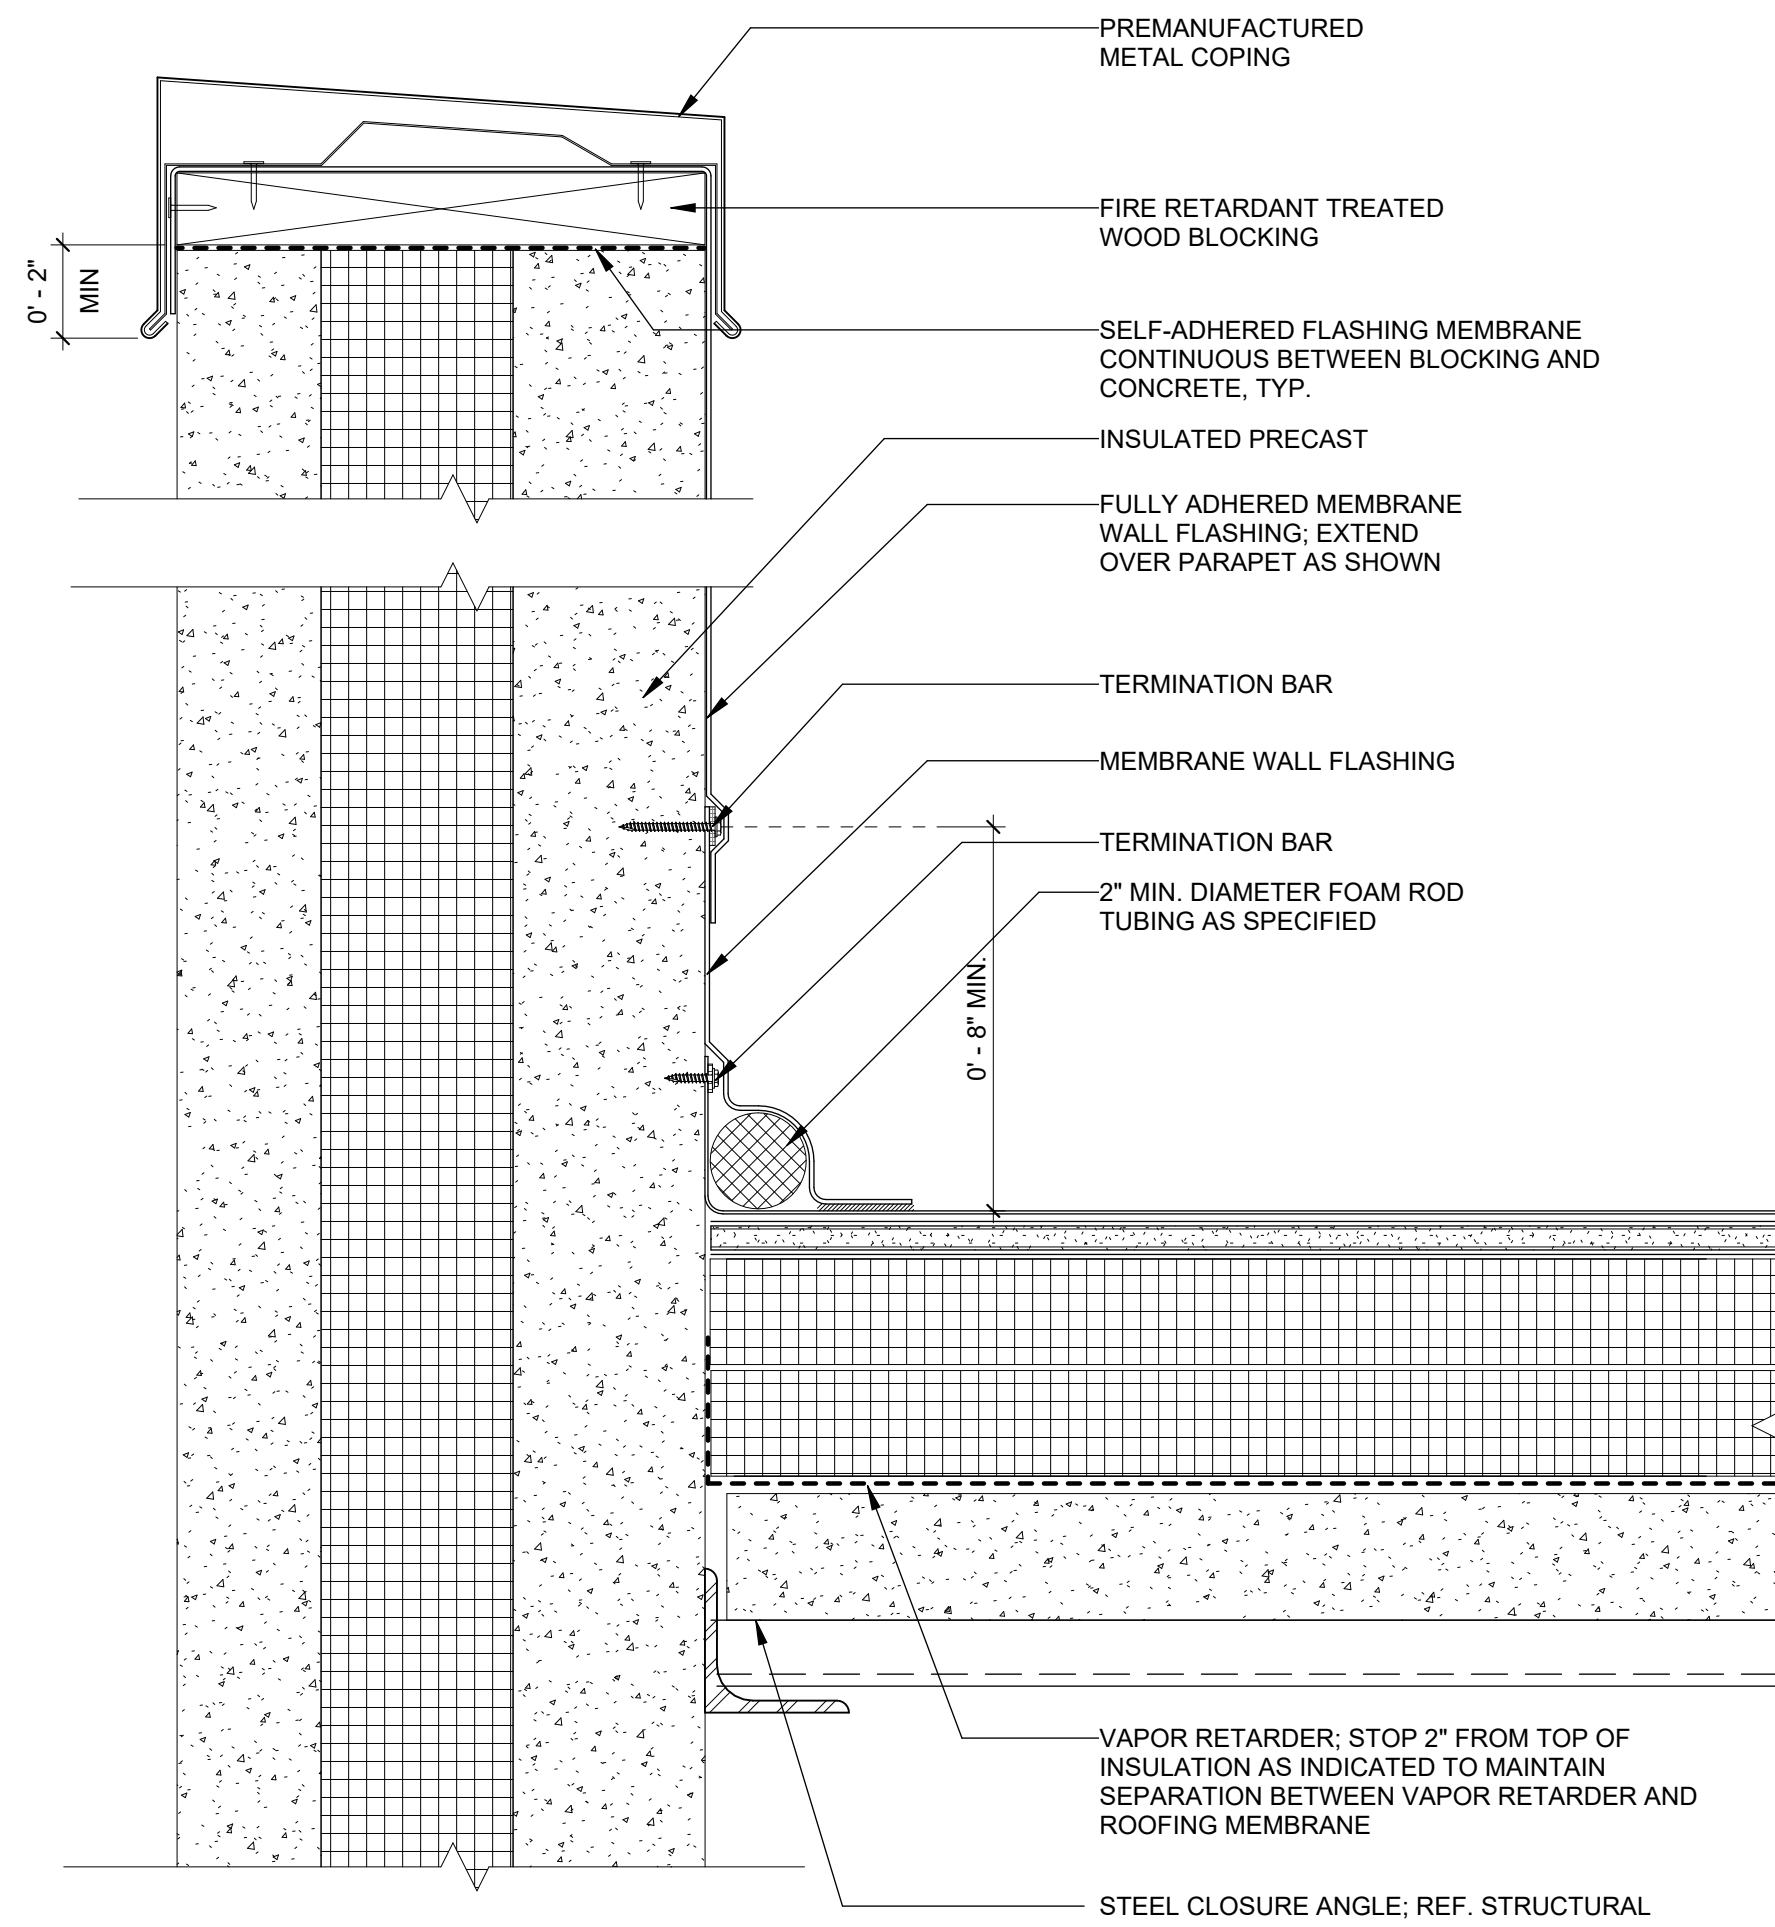


2 SECTION DETAIL @ PARAPET - METAL DECK
3" = 1'-0"

NOTE:
FLEXIBLE PROTECTION/ABRASION PADS: INSTALL SECONDARY PROTECTION PADS OF ROOFING MEMBRANE AS NEEDED AT EQUIPMENT TO PROTECT THE MAIN MEMBRANE. ALL PADS TO BE FULLY HEAT WELDED TO ROOFING SUBSTRATE ACCORDING TO ROOFING SYSTEM MANUFACTURER'S WRITTEN INSTRUCTIONS. THICKER VIBRATION PADS TO BE INSTALLED ABOVE PROTECTION PADS WITH COMPATIBLE ADHESIVE ACCORDING TO ROOFING SYSTEM MANUFACTURER'S WRITTEN INSTRUCTIONS

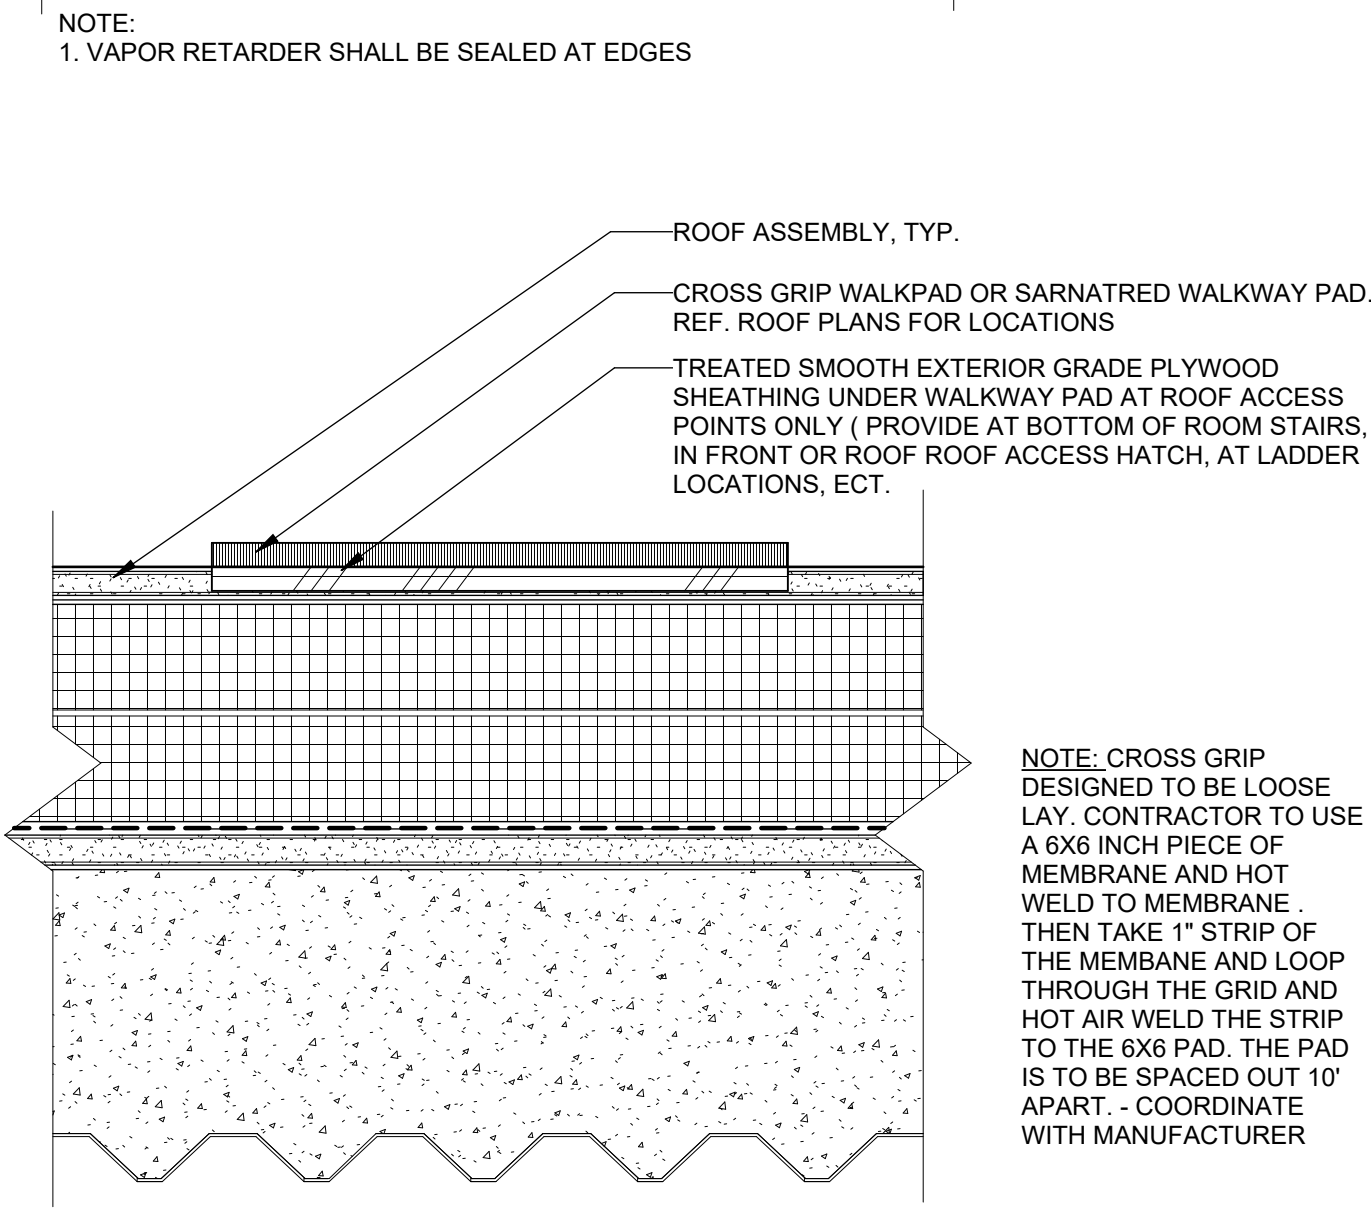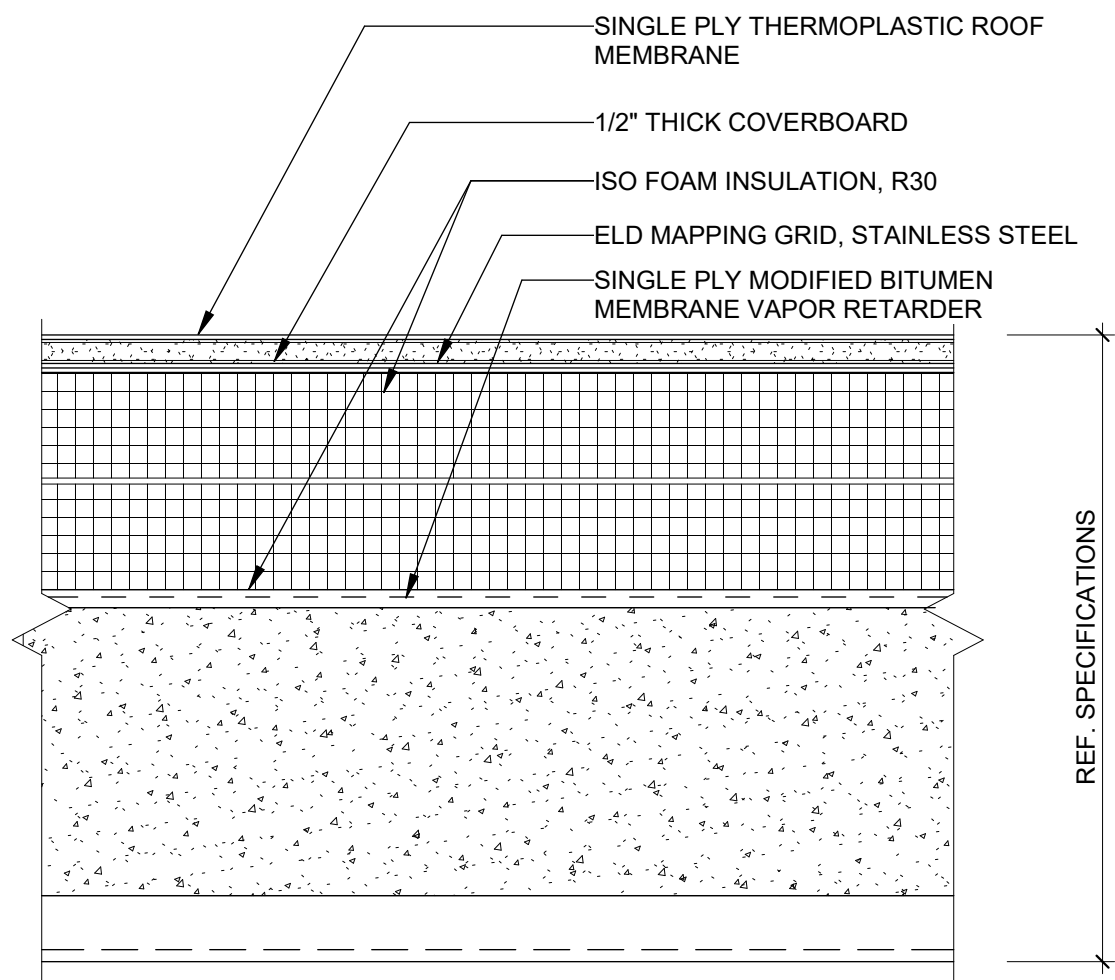

3 ROOF ASSEMBLY
3" = 1'-0"

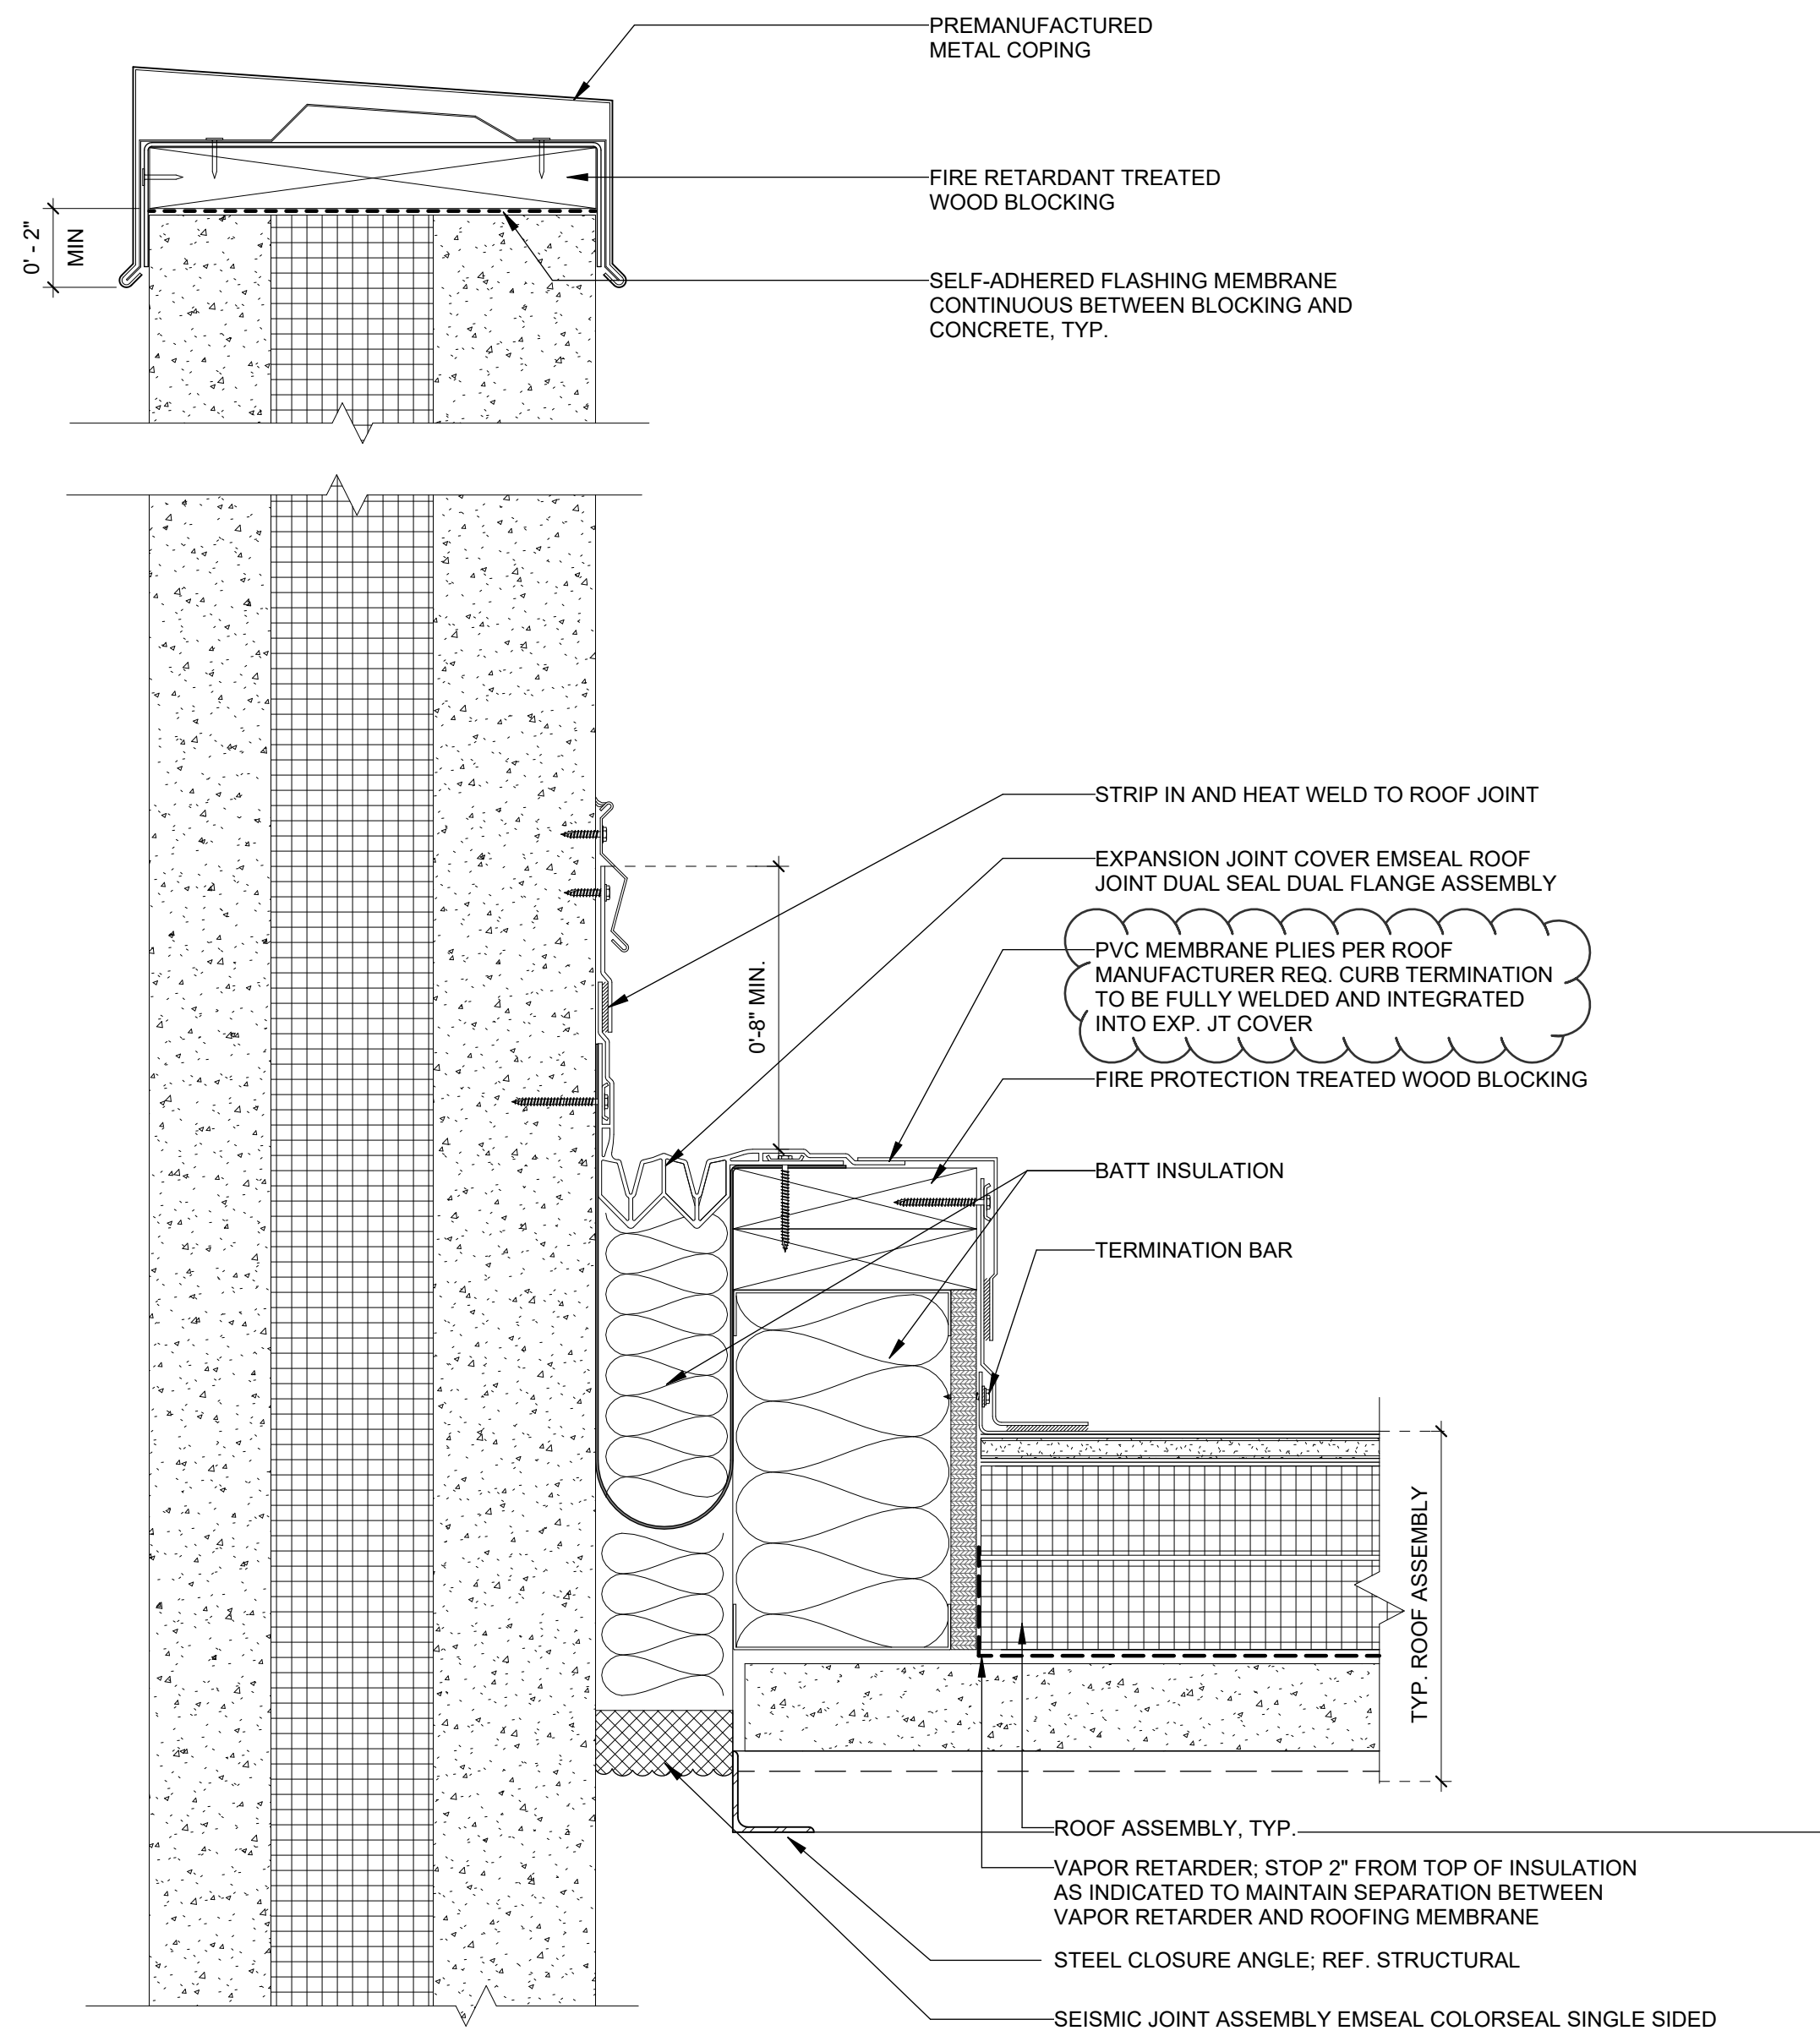

1 EXPANSION JOINT @ WALL - METAL DECK
3" = 1'-0"

ONLY HIGHLIGHTED OR CLOUDED REVISIONS
ARE APPROVED ON THIS REVIEW.
ALL PREVIOUS COMMENTS APPLY.

City of Aurora Building Division
Reviewed for Code Compliance
Approved as Noted: **malemu**
Date: Sep 15, 2026
2021 INTERNATIONAL CODES & 2023 NEC