
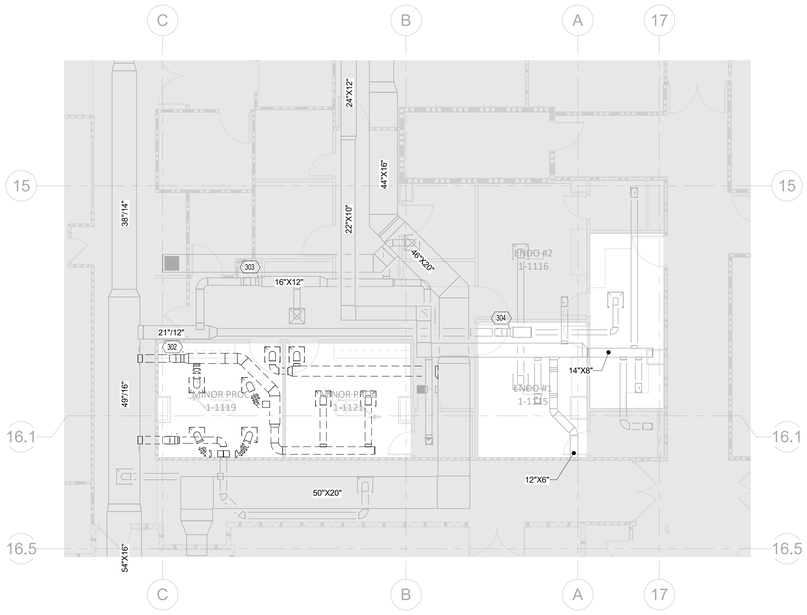


1 FIRST FLOOR PARTIAL PLAN - DEMOLITION - VENTILATION

1/8" = 1'-0"

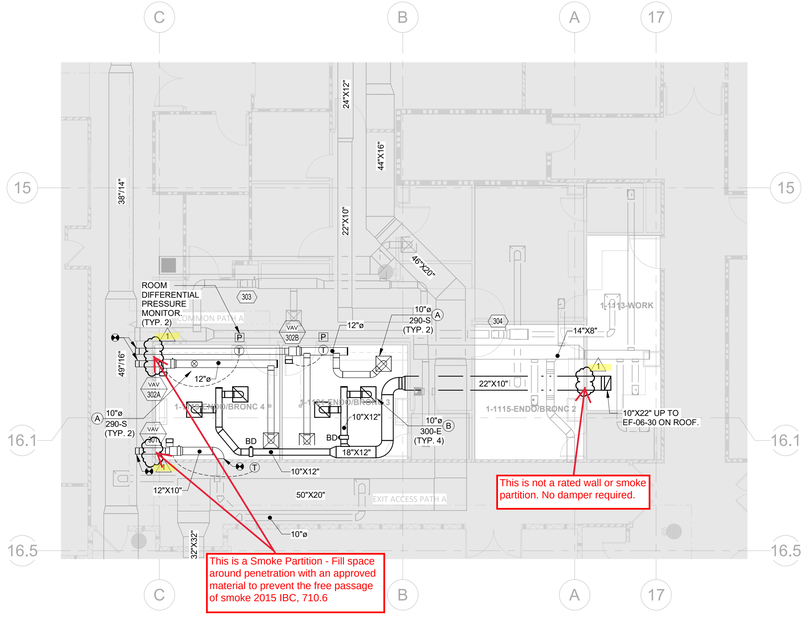


2 FIRST FLOOR PARTIAL PLAN - NEW WORK - VENTILATION

1/8" = 1'-0"


KEY NOTES:

1. PATCH ALL DUCT MAINS WHERE BRANCH LINES ARE DEMOLISHED AS SHOWN.
2. ADJUST VAV MAXIMUM DAMPER POSITION TO MEET REQUIRED 0.02" W.G. NEGATIVE PRESSURE WITHIN ENOSCOPY/BRONCHOSCOPY ROOMS.
3. ADD A NOTE "CONTRACTOR SHALL COORDINATE WITH FACILITY ENGINEER TO INCREASE THE AIR HANDLER MINIMUM OUTSIDE AIR SETPOINT BY 1,000 CFM UPON COMPLETION OF THE PROJECT.

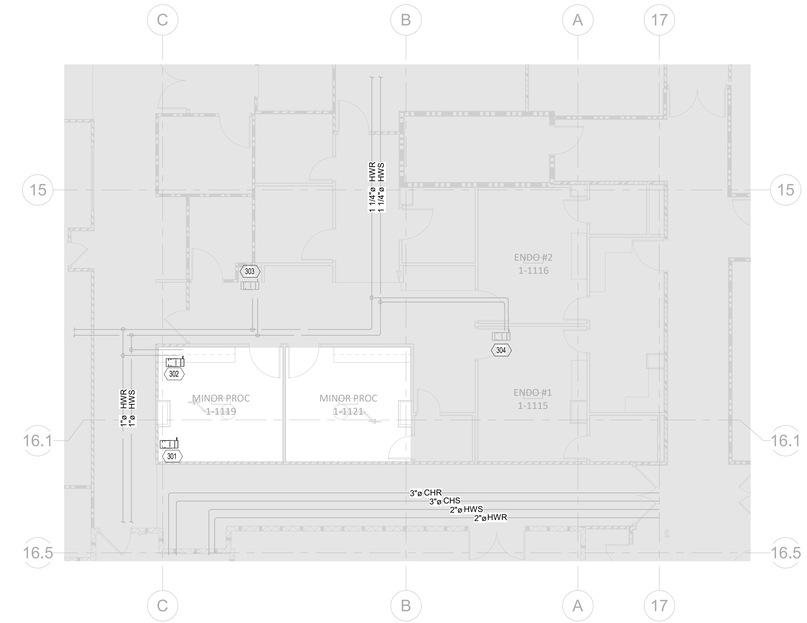

3 FIRST FLOOR PARTIAL PLAN - DEMOLITION - PIPING

1/8" = 1'-0"

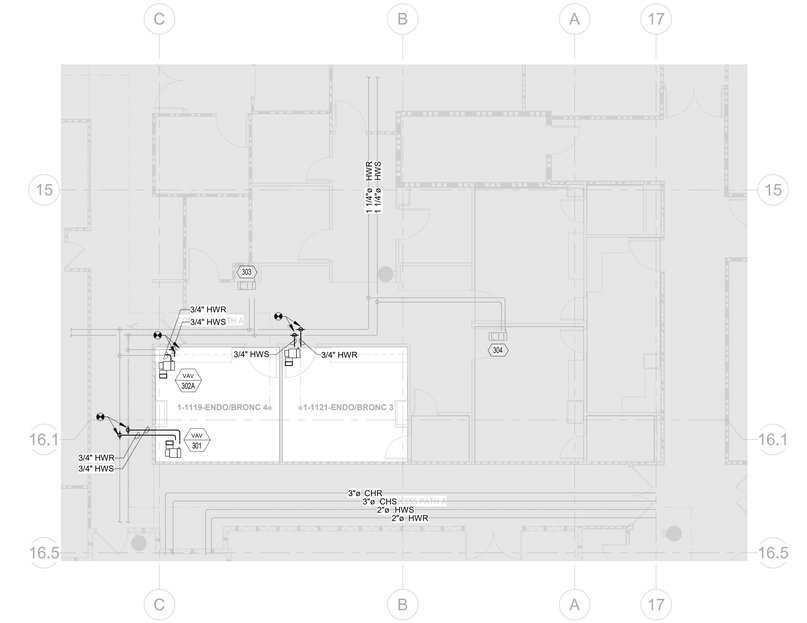

4 FIRST FLOOR PARTIAL PLAN - NEW WORK - PIPING

1/8" = 1'-0"

PRINT A FULL SIZE, COLOR COPY OF THE CITY APPROVED REVISIONS, AND KEEP WITH THE ORIGINAL CITY APPROVED PLANS FOR INSPECTIONS.

Only highlighted or clouded revisions are approved on this review. All previous comments apply.

REVISES PERMIT # 2019-1609662-TF

RSN: *1387770*
Permit #: *19-1662571-LT REV*

City of Aurora Building Division
Reviewed for Code Compliance
Approved as Noted: Rhonda Ritter
Date: Jul 24, 2019
2015 INTERNATIONAL CODES & 2017 NEC



PROJECT NUMBER
194003.00

DRAWN BY
Author

DATE
4/12/2019

REVISIONS

REV	DESCRIPTION	DATE
1	ADDENDUM 1	04/17/2019

WMA Consulting Engineers, Ltd.
WMA Job# 18193-00

BOULDER ASSOCIATES
ARCHITECTS

Boulder Associates, Inc.
Architecture + Interior Design
1426 Pearl Street, Suite 300
Boulder , Colorado 80302
303.499.7795
www.boulderassociates.com

COLORADO LICENSED
MICHAEL P THOMPSON
53150
PROFESSIONAL ENGINEER
4/12/19

PROJECT
THE MEDICAL CENTER OF AURORA ENDO/ BRONCH RENOVATION
ADDRESS
1501 S. POTOMAC ST.
AURORA, CO 80012

CONSTRUCTION DOCUMENTS

SHEET TITLE
MECHANICAL FLOOR PLANS

SHEET NUMBER
M2.10

C:\TEMP\WMA_18193-00_MFP_TMCA_19_X25.rvt
4/17/2019 2:59:42 PM
THIS LINE IS 2 INCH LONG WHEN PRINTED TO FULL SCALE

RSN: ***1387770***
Permit #: ***19-1662571-LT REV***

July 16, 2019

City of Aurora, Building Division
15151 E Alameda Parkway
2nd Floor
Aurora, CO 80012

RE: Endo-Bronch Room Addendum 1 HVAC Changes

The original scope of work identified for this project included three (3) fire/smoke dampers. Upon further investigation, it was found that these walls are not fire/smoke rated. This addendum includes the removal of the three (3) fire/smoke dampers to meet the actual wall conditions in the endoscopy suite.

9250 East Costilla Avenue Suite 220, Greenwood Village, CO 80112
P: 303.225.6320
www.wmaengineers.com