
City of Aurora
Building Codes Division
15151 E Alameda Pkwy
Aurora, CO 80012
(303) 739-7420

Notice

This material is subject to copyright protection pursuant to Federal Law: 17 United States Code Section 106.

A-2000 Additional Notes

4. ADD (1) 5/8" TYPE X GYPSUM BOARD TO THE SHAFT LINER FACE OF WALL TYPE P10. TERMINATE ABOVE CEILING.
5. MAINTAIN 2 HOUR ASSEMBLY AT RECESSED OPENINGS. REFER TO A-2400 AND A-4003 FOR FURTHER DETAILS.
6. MAINTAIN 2-HOUR BULKHEAD.
7. 2 HOUR FIRE ASSEMBLY TO BE CONSTRUCTED FROM CEILING HEIGHT TO ROOF DECK.
8. CONSTRUCT NEW 2-HOUR RATED BULKHEAD ABOVE. CONTINUE TO ROOF DECK.
9. VERIFY 2 HOUR CONSTRUCTION AT VESTIBULE. CONFIRM 90 MINUTE DOOR. IF NEITHER/NOR PROVIDE CORRIDOR WALL TYPE K10 AND 90 MINUTE DOOR/FRAME (HARDWARE TO MATCH EXISTING DOOR).
10. CONSTRUCT NEW 4 7/8" X 2" DEEP GYPSUM COLUMNETTE.
11. TERMINATE WALL TYPE K10 BACK INTO EXISTING 2-HOUR ASSEMBLY.

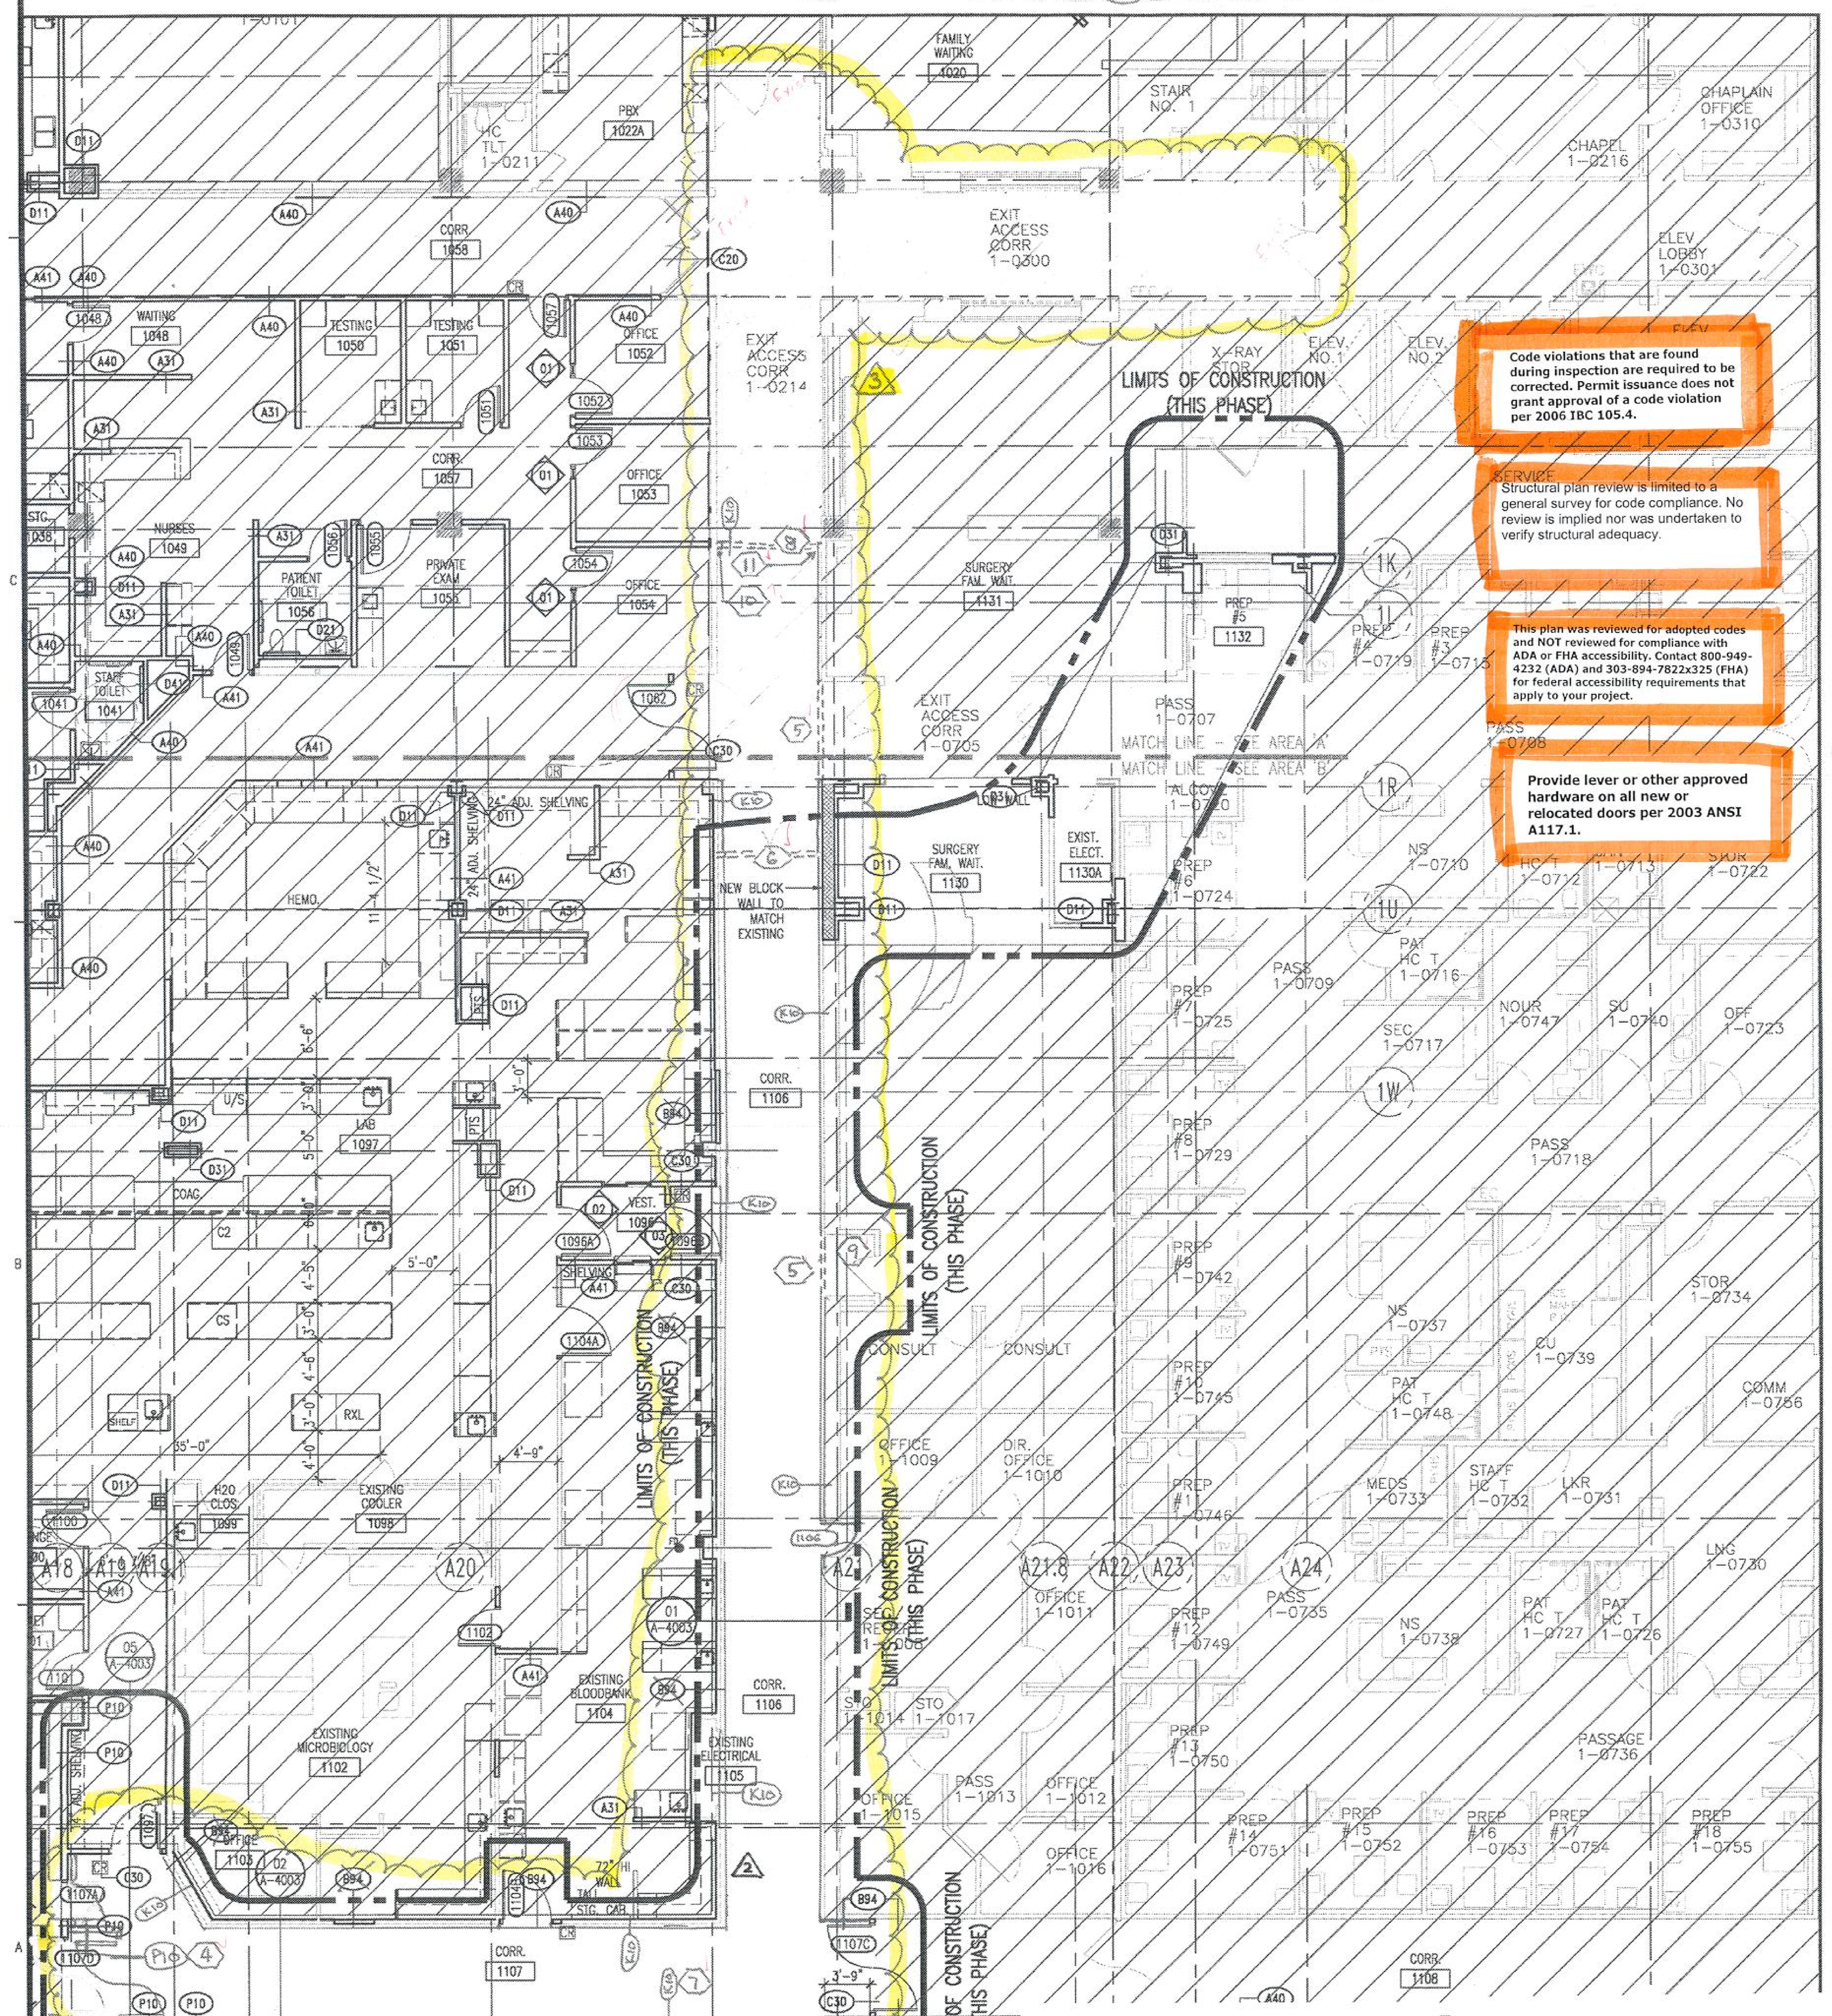

Code violations that are found during inspection are required to be corrected. Permit issuance does not grant approval of a code violation per 2006 IBC 105.4.

Structural plan review is limited to a general survey for code compliance. No review is implied nor was undertaken to verify structural adequacy.


This plan was reviewed for adopted codes and NOT reviewed for compliance with ADA or FHA accessibility. Contact 800-949-4232 (ADA) and 303-894-7822x325 (FHA) for federal accessibility requirements that apply to your project.

Provide lever or other approved hardware on all new or relocated doors per 2003 ANSI A117.1.


City of Aurora Plan Review
Occ./Const. Type I-2 / I-FR. SPK
Code 2006 IBC S.F. ∅
RSN 455617
Permit Number 09-384477-TF

City of Aurora Plan Review
Project Exit Passageway
Address 1501 S Potomac
Contractor JE Dunn
RSN 455617
Permit Number 09-384477-TF
Plan Location


01 ARCHITECTURAL NEW CONSTRUCTION PLAN – 1ST FLR – EXIT CORRIDOR AT FINAL PHASE
1/8" = 1'-0"

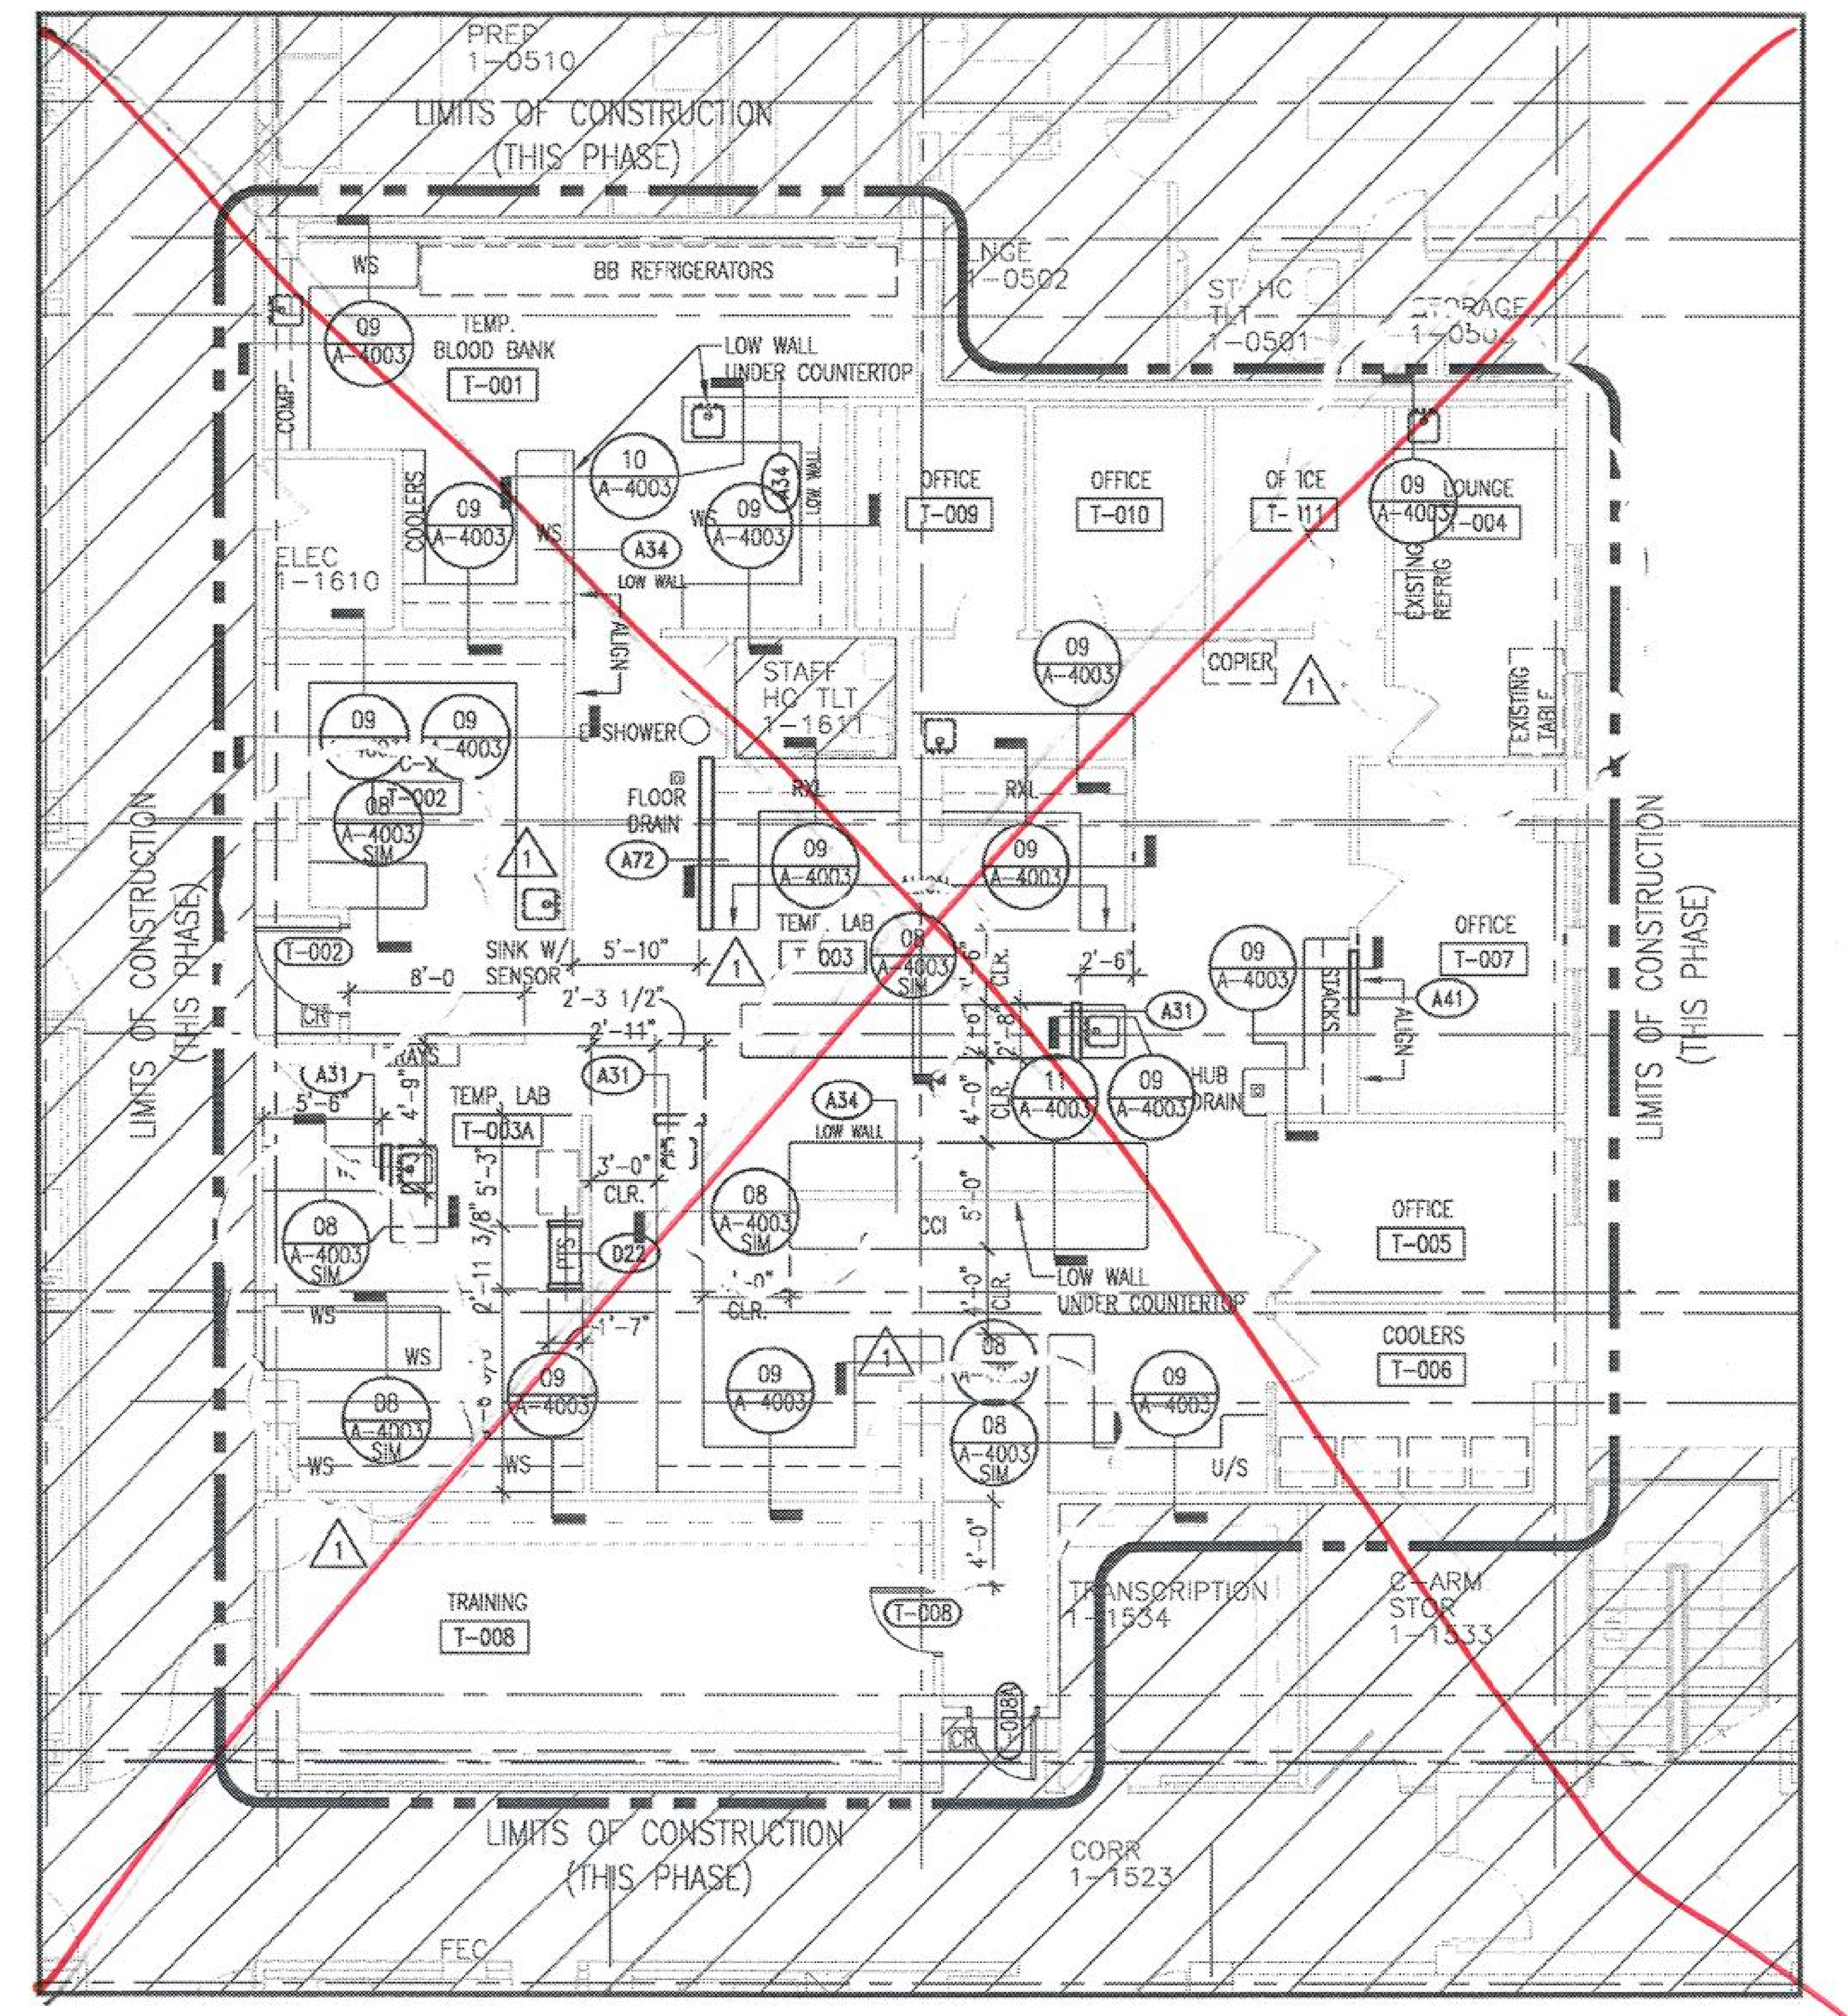

04 ARCHITECTURAL NEW CONSTRUCTION PLAN – 1ST FLR – TEMP LAB
1/8" = 1'-0"

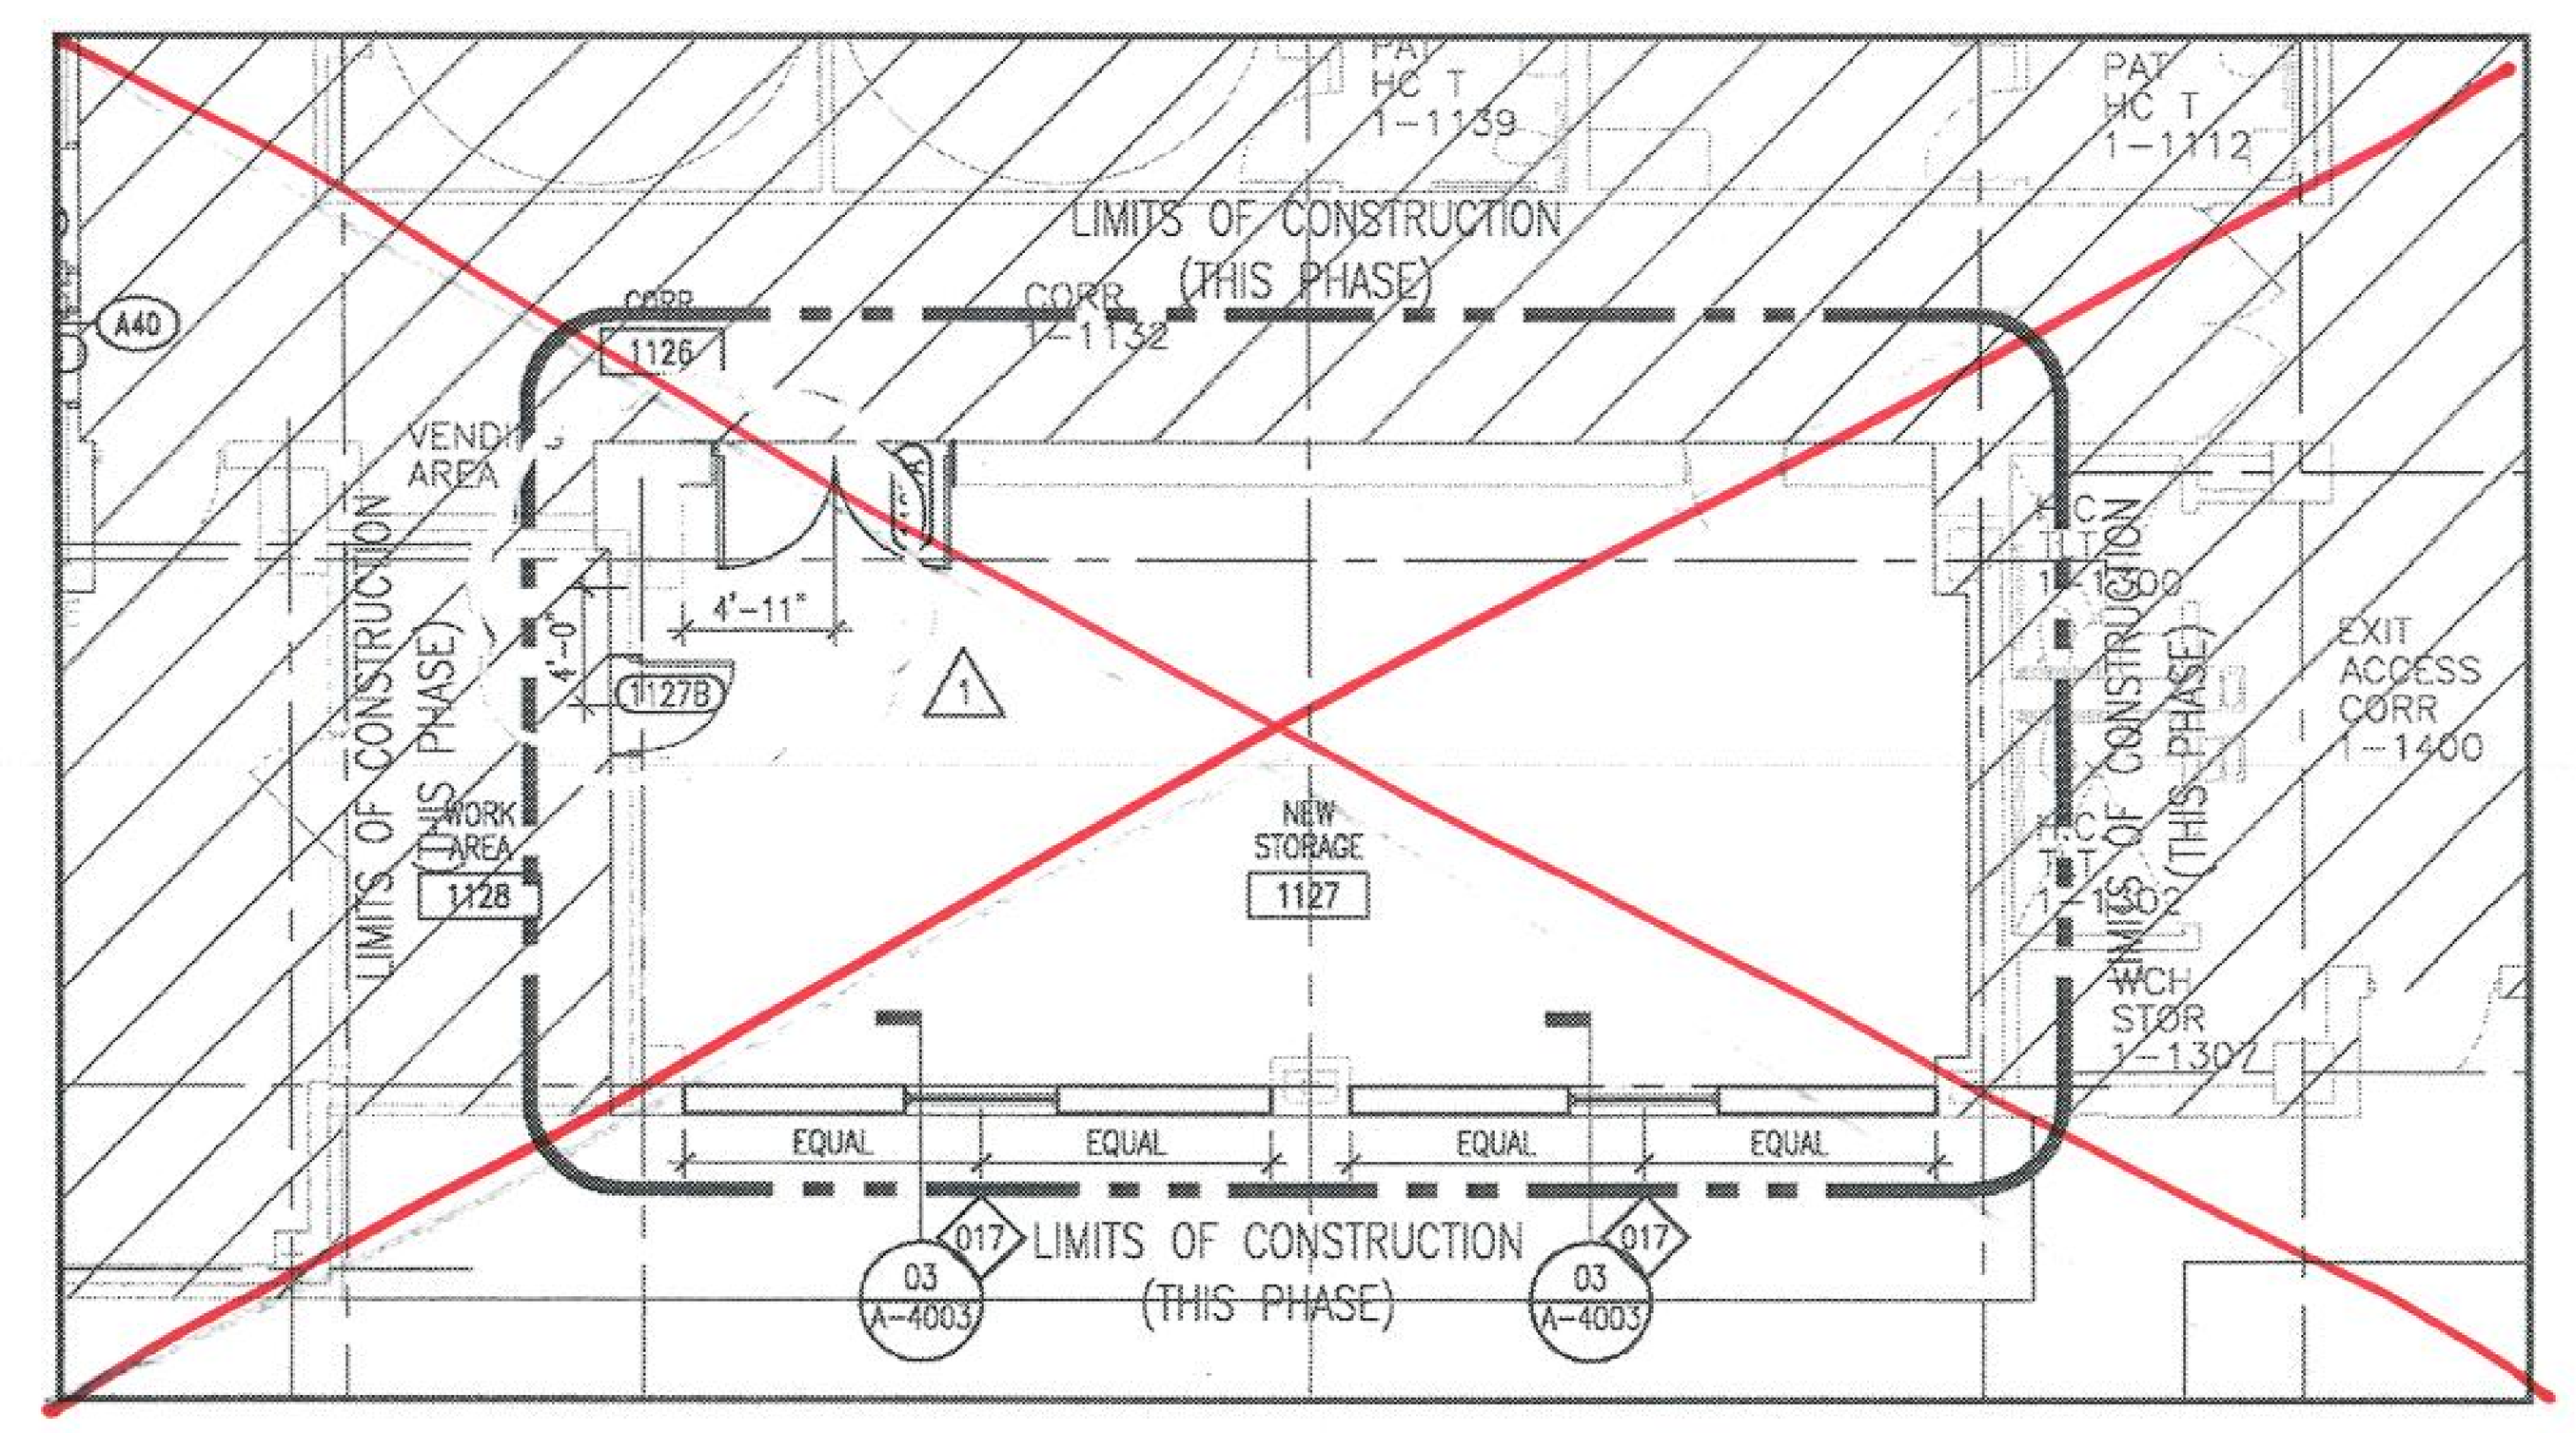

03 ARCHITECTURAL NEW CONSTRUCTION PLAN – 1ST FLR – BED STORAGE
1/8" = 1'-0"

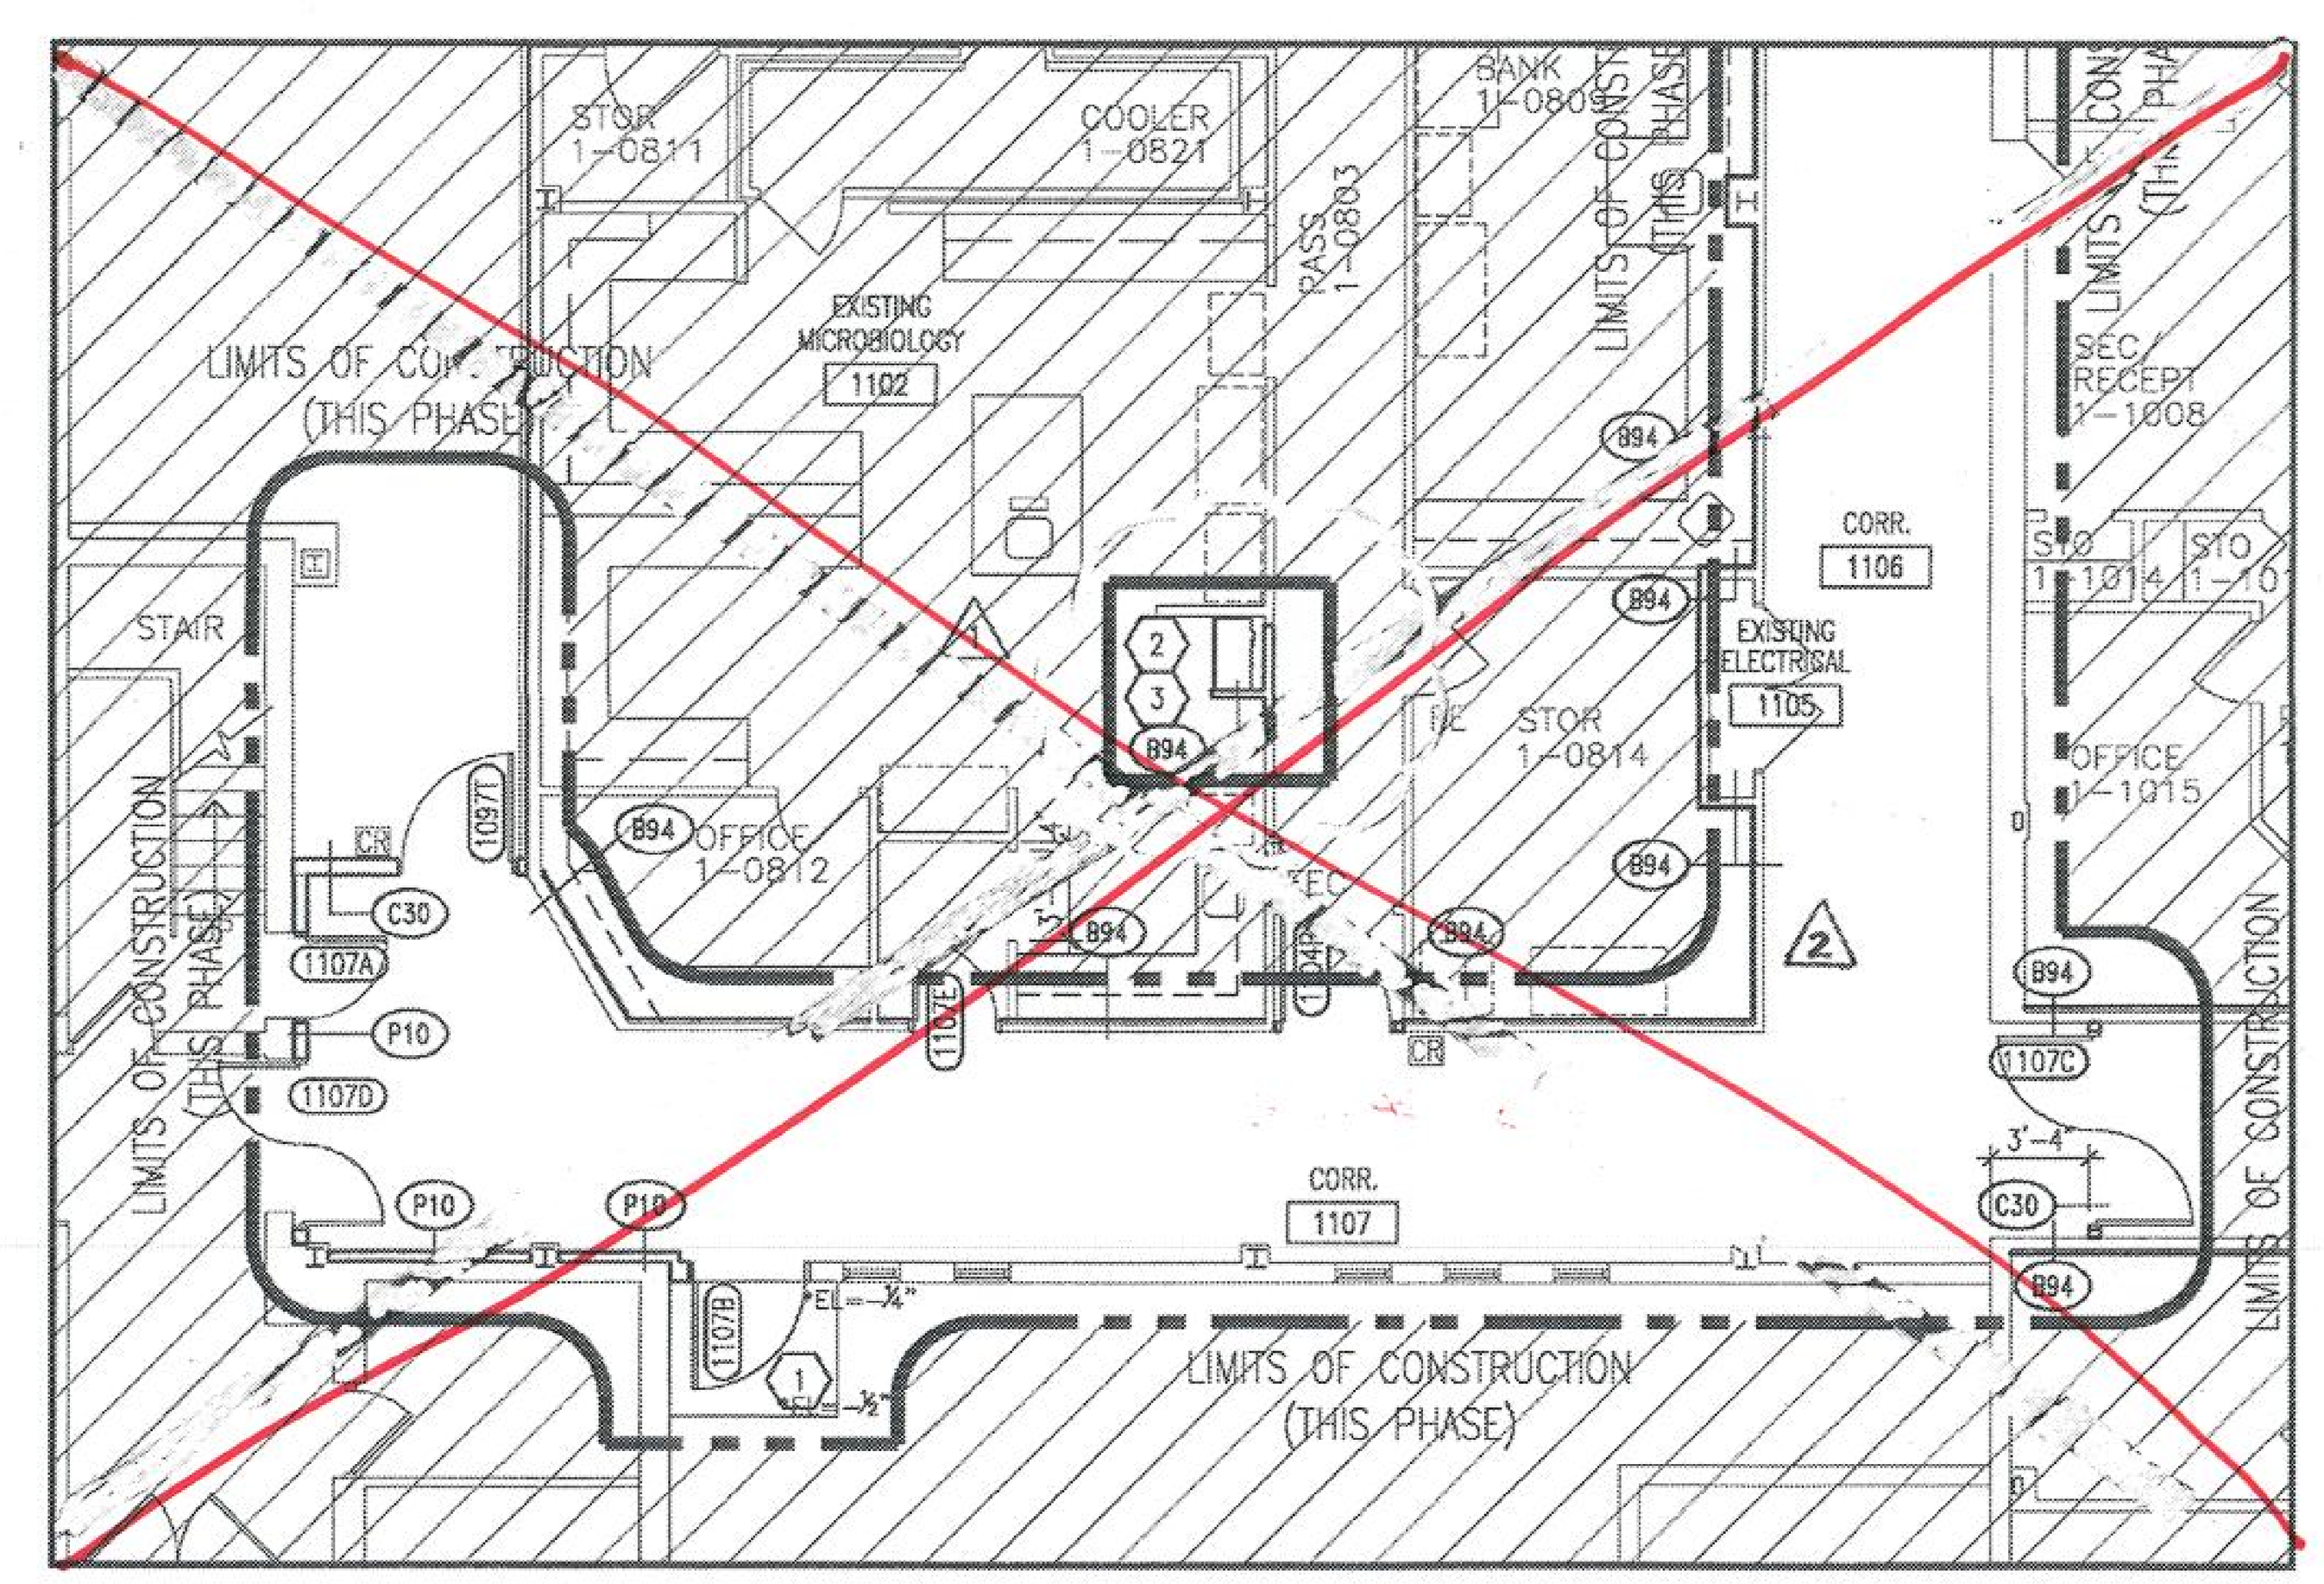

02 ARCHITECTURAL NEW CONSTRUCTION PLAN – 1ST FLR – MICROBIOLOGY – PHASE 2.2 AND EXIT CORRIDOR
1/8" = 1'-0"

09 -384477

FLOOR PLAN GENERAL NOTES

1. PARTITION TYPES ARE SCHEDULED IN THE A-8100 SERIES. RE: A-011 SERIES FOR GRAPHIC EXTENT OF FIRE RATED PARTITIONS. REFER TO PARTITION TYPE LEGENDS FOR LOCATION OF SOUND ATTENUATION BLANKETS.
2. DELETED.
3. ALL PARTITIONS ARE TYPE A41 UNLESS OTHERWISE NOTED.
4. DIMENSIONS SHOWN ON THE FLOOR PLANS FOR NEW CONSTRUCTION ARE TO THE FACE OF FINISH OF INTERIOR WALLS, TO CENTER LINE OF COLUMNS AND TO FACE OF CONCRETE OR MASONRY WALLS, UNLESS OTHERWISE INDICATED. DIMENSIONS IN RENOVATED AREAS ARE FROM FINISH FACE OF EXISTING WALLS AND TO FINISH FACE OF NEW STUD WALLS, UNLESS OTHERWISE INDICATED.
5. WHERE NEW GYPSUM BOARD PARTITIONS ARE A CONTINUATION OF AN EXISTING PARTITION OR COLUMN ENCASEMENT, THE FACE OF THE NEW GYPSUM BOARD SHALL BE ALIGNED WITH THE FACE OF THE EXISTING SURFACE. WHERE A ONE HOUR PARTITION IS SHOWN AS A CONTINUATION OF A TWO-HOUR PARTITION OR COLUMN ENCASEMENT, THE FACE OF THE GYPSUM BOARD SHALL BE ALIGNED. STUDS SHALL BE OFFSET AND ADDITIONAL LAYERS OF GYPSUM BOARD SHALL BE PROVIDED AS REQUIRED TO PROVIDE FACE ALIGNMENT OF GYPSUM BOARD.
6. CLINICAL SINKS SHALL BE MOUNTED SO THAT THE CENTERLINE OF THE SINK IS 1'-6" MINIMUM TO THE FACE OF THE ADJACENT FIXED EQUIPMENT, SIDE WALL, CASEWORK, ETC.
7. ALL PATIENT CORRIDORS AND PASSAGEWAYS SHALL BE 8'-0" MINIMUM CLEAR WIDTH.
8. SEE A-5000 (NOT INCLUDED IN THIS PACKAGE) FOR TYPICAL MOUNTING HEIGHTS OF PLUMBING FIXTURES AND TOILET ACCESSORIES.
9. LAVATORIES AND SINKS SHALL BE ACCOMPANIED BY A PAPER TOWEL DISPENSER "TA2" AND SOAP DISPENSER "TA8" UNLESS OTHERWISE NOTED ON ENLARGED FLOOR PLANS.
10. SEE A-5000 (NOT INCLUDED IN THIS PACKAGE) FOR ENLARGED PLAN AT A TYPICAL DRINKING FOUNTAIN ALCOVE.
11. REFER TO A-5500 SERIES (NOT INCLUDED IN THIS PACKAGE) FOR MISCELLANEOUS DETAILS.
12. PROVIDE 1'-0" CLEAR FLOOR SPACE AT THE PUSH SIDE OF EVERY DOOR WITH A CLOSER. PROVIDE 1'-6" CLEAR AT THE PULL SIDE OF EVERY DOOR (EXCLUDING PATIENT BEDROOMS), UNLESS SPECIFICALLY DIMENSIONED OTHERWISE.
13. PROVIDE 1'-4" CHASE BEHIND SINGLE SIDED TOILETS, AND 1'-8" CHASE BETWEEN BACK TO BACK TOILETS, FOR WALL HUNG FIXTURES.
14. ALL LAVATORIES AND SINKS SHALL BE MOUNTED A MINIMUM OF 1'-3" FROM THE CENTERLINE OF THE FIXTURE TO THE FINISHED FACE OF THE ADJACENT PARTITION.
15. SEE OWNER FURNISHED ***RADIOLOGY, ETC.*** VENDOR DRAWINGS FOR CRITICAL DIMENSIONS IN THESE AREAS.
16. REFER TO THE A-2100 SERIES, "EQUIPMENT AND MILLWORK PLANS" FOR WALL PROTECTION LOCATIONS.
17. PATCH AND PAINT WALLS AT LOCATION OF NEW PLUMBING CHASES AND ELECTRICAL AND DATA CHASES. RE: MEP.
18. REMOVE AND REPLACE GYP. BD. AND WALL, CEILING AND NEW COMUMN LOCATIONS.
19. AT LOCATIONS WHERE AN EXISTING EXTERIOR STUD PARTITION WILL BE REVISED TO AN INTERIOR STUD PARTITION, REMOVE THE EXISTING SHEATHING AND DAMPPROOFING AND REPLACE WITH ⅝" GYP. BD.

FLOOR PLAN LEGEND

- EXPANSION JOINT
- EXISTING PARTITION TO REMAIN
- NEW PARTITION
- EXISTING COLUMN
- (1 / A-3000) EXTERIOR ELEVATION TAG
- (1 / A-4100) SECTION TAG
- (001) EXTERIOR ALUMINUM FRAMED OPENING RE: A-8400
- F.V. FIELD VERIFY
- (1) INTERIOR WINDOW IDENTIFICATION RE: A-8500
- (200B) DOOR IDENTIFICATION RE: A-83 SERIES FOR HEAD, JAMB & SILL DETAILS
- (A1) WALL PARTITION TAG RE: A-81 SERIES
- F.D. FLOOR DRAIN
- (C.T.) (I.V.) CURTAIN OR I.V. TRACK RE: X/A55XX
- LEAD LINED WALL
- (1 / A-2000) ENLARGED FLOOR PLAN BUBBLE
- NOT IN SCOPE OF WORK
- CONTRACTOR FURNISHED EQUIPMENT/ ITEM
- OWNER FURNISHED EQUIPMENT/ ITEM
- SECURITY CAMERA, FIXTURE AND FINAL CONNECTION BY SECURITY VENDOR. CONTRACTOR TO PROVIDE/INSTALL CONDUIT AND CABLE.
- CR CARD READER, FIXTURE AND FINAL CONNECTION BY SECURITY VENDOR. CONTRACTOR TO PROVIDE/INSTALL CONDUIT AND CABLE.

FLOOR PLAN KEYNOTES

1. ADD NEW 5' x 6' CONCRETE SLAB EXIT LANDING, REWORK GRADE AS REQUIRED. RE: CIVIL FOR TYP. SIDEWALK DETAILS.
2. ~~G.C. TO COORDINATE PHASING OF THIS CONSTRUCTION.~~
3. PNEUMATIC TUBE IS TO BE REMOVED AND RELOCATED UPON COMPLETION OF LAB

SEE ADDITIONAL NOTES ABOVE

CITY OF AURORA
BUILDING DIVISION
APPROVED AS NOTED
DATE APPROVED MAR 26 2009

PERKINS & WILL
10100 North Central Expressway, Suite 300
Dallas, Texas 75231, USA
214.283.8700 Fax: 214.283.8701
www.perkinswill.com

Medical Center of Aurora
South Campus Private Room Expansion
Aurora, Colorado

HCA
Project # 306660001

In association with:

Civil
Martin Martin, Inc.
4251 Kipling Street
Wheat Ridge, CO 80033
T: 303.431.6100
F: 303.431.4028


Structural
TRC International, Ltd.
5050 QUARUM DRIVE, SUITE 700
Dallas, TX 75254
T: 214.722.6452
F: 214.722.6552

MEP
CCRD Partners
3625 N. HALL STREET
SUITE 1300, LB 139
DALLAS, TX-75219
T: 214.521.1661
F: 214.521.1664

LANDSCAPE
Davis Partnership
2310 BLAKE STREET, SUITE 100
DENVER, CO 80205
T: 303.861.8555
F: 303.861.3027

AUGUST 08
EARLY RELEASE PKG. #2
ADDENDUM #1
ISSUED FOR CONSTRUCTION

KEY PLAN
FIRST FLOOR

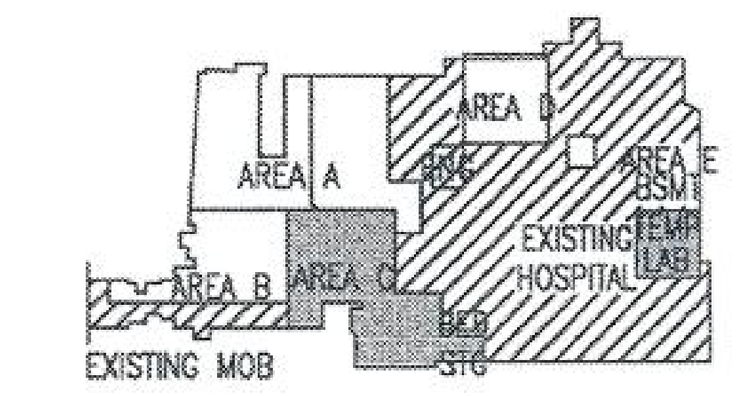

STATE OF COLORADO — TRUBY L. McDOUGAL — 203601 — LICENSED ARCHITECT — 8·8·06 — 2·24·09

Revisions

NO.	ISSUE	DATE
3	FIELD MEMO – 02-10-09	
2	ASI-001	01/10/07
1	ADDENDUM #1	08/08/06

Sheet Information

Date	07-13-2006
Job Number	142228.000
Drawn	LTS
Checked	DcE
Approved	CG

Title


ARCHITECTURAL NEW CONSTRUCTION PLAN FIRST FLOOR MISC. AREAS

Sheet


A-2000

Issued for Construction


Copyright © 2005 PERKINS & WILL

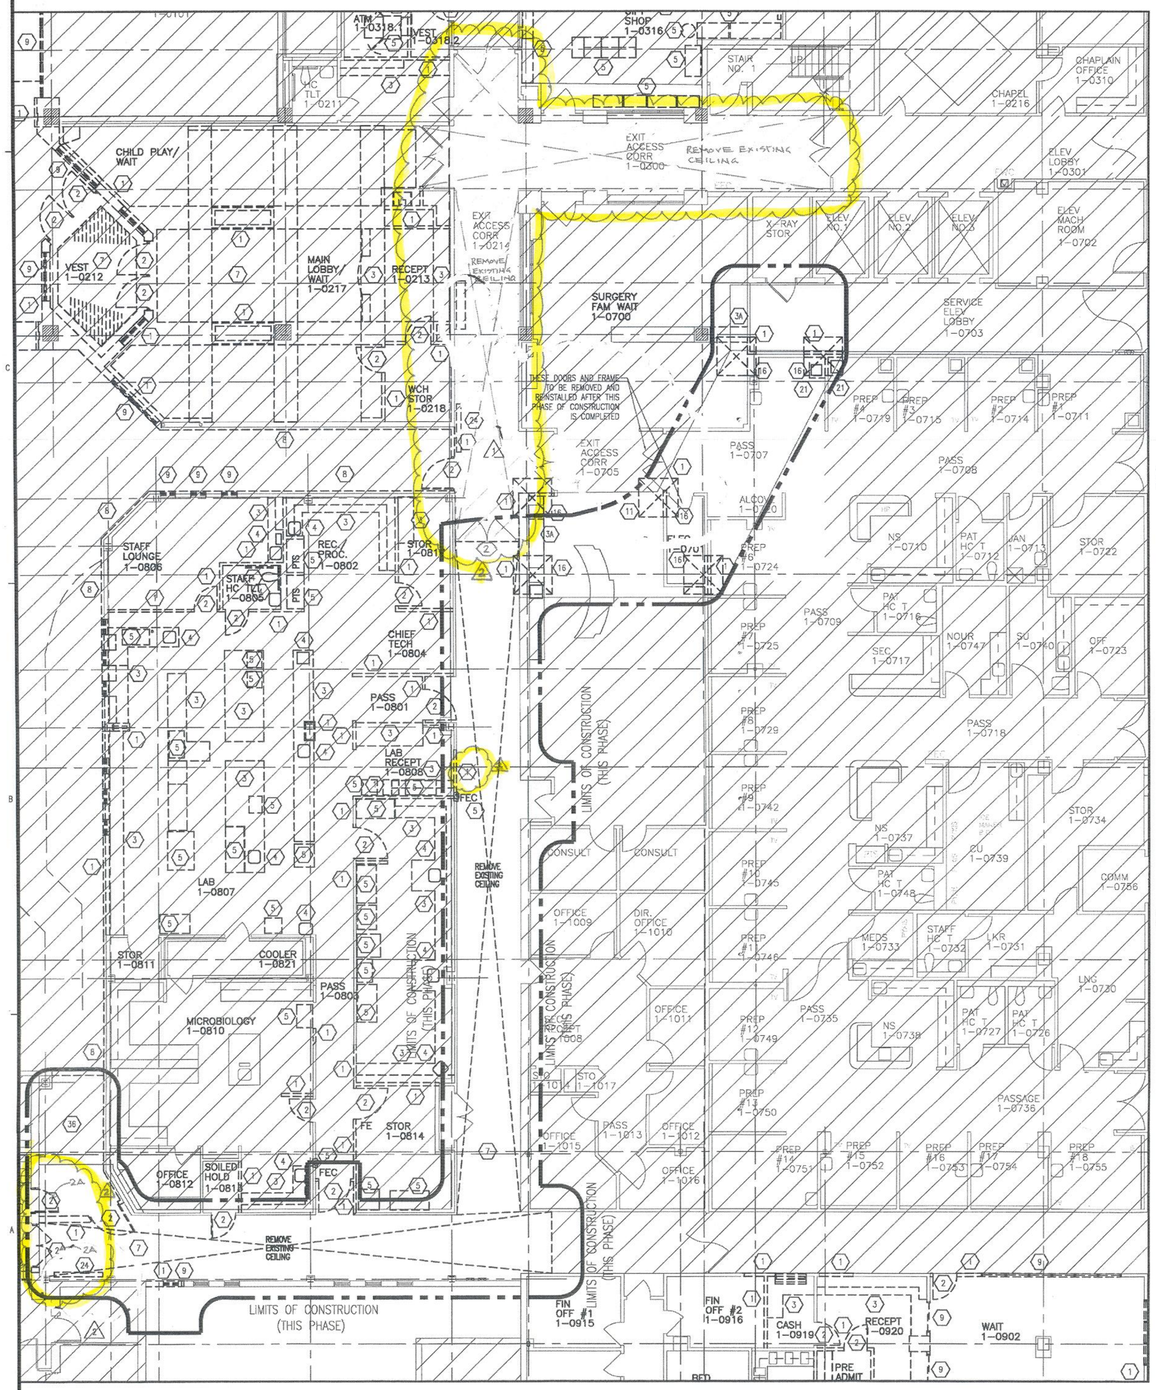


01 DEMOLITION PLAN – 1ST FLR – EXIT CORRIDOR
1/8" = 1'-0"

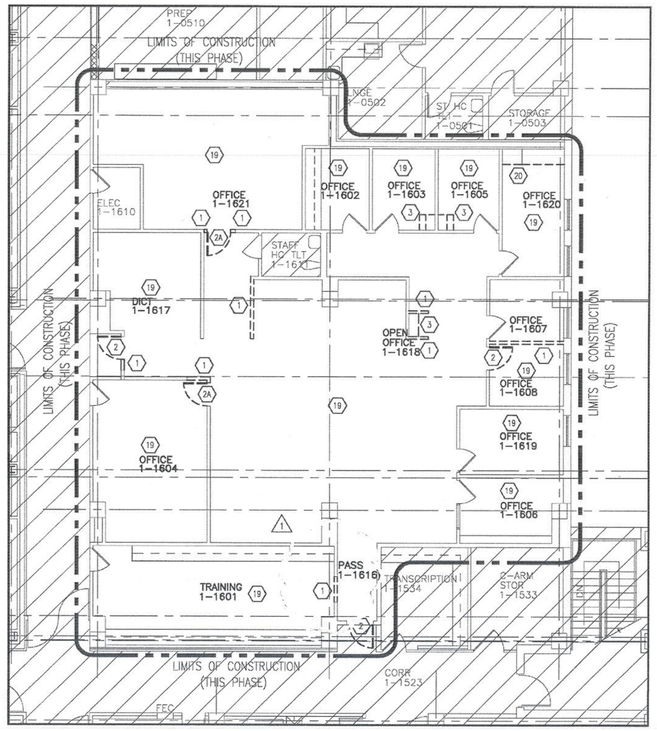

04 DEMOLITION PLAN – 1ST FLR – TEMP LAB
1/8" = 1'-0"

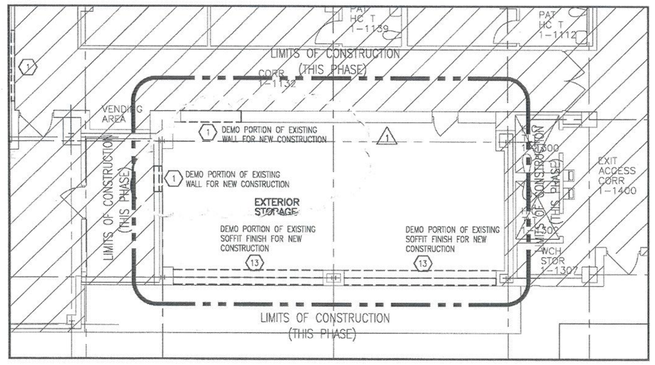

03 DEMOLITION PLAN – 1ST FLR – BED STORAGE
1/8" = 1'-0"

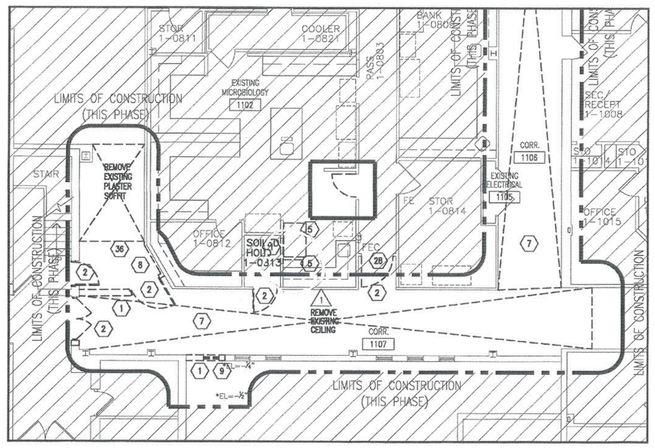

02 DEMOLITION PLAN – 1ST FLR – MICROBIOLOGY – PHASE 2.2
1/8" = 1'-0"

DEMOLITION GENERAL NOTES

1. REFER TO SPECIFICATIONS FOR INTERIM LIFE SAFETY MEASURES.
2. CONSTRUCT TEMPORARY PARTITIONS AS REQUIRED BY PHASING TO MINIMIZE THE SPREAD OF DUST AND NOISE.
3. THESE DRAWINGS HAVE BEEN DEVELOPED FROM EXISTING DRAWINGS WHICH MAY NOT REFLECT ACTUAL FIELD CONDITIONS. VERIFY THESE DRAWINGS WITH EXISTING FIELD CONDITIONS AND NOTIFY THE ARCHITECT IMMEDIATELY OF INCONSISTENCIES BETWEEN THEM AND ACTUAL CONDITIONS BEFORE PROCEEDING WITH CONSTRUCTION.
4. REPAIR ANY DAMAGED FIRE-RATED ASSEMBLIES TO THEIR ORIGINAL SPECIFICATION.
5. REMOVE EXISTING CONSTRUCTION AS INDICATED. TYPICAL WALL REMOVAL INCLUDES FINISHES AND MECHANICAL PLUMBING AND ELECTRICAL SYSTEMS CONTAINED THEREIN. REMOVE DOORS, CASEWORK, WINDOWS, FRAMES, AND OTHER FIXTURES AS REQUIRED. AFTER REMOVAL OF PIPE CHASES, PATCH HOLES IN EXISTING FLOORS OR WALLS TO REMAIN, TO MEET ORIGINAL FIRE PROTECTION AND STRUCTURAL REQUIREMENTS. PATCH ADJOINING WALLS, FLOORS AND DECK, AND PREPARE SURFACES TO RECEIVE NEW FINISHES PER FINISH SCHEDULE OR PER INTERIOR FINISH PLANS. U.N.O PATCHED AREAS TO MATCH THE ADJACENT FINISHES, INCLUDING TRIMWORK, HANDRAILS AND WALL PROTECTION.
6. WHERE NEW FINISHES ARE TO BE INSTALLED ON EXISTING SURFACES, REMOVE THE EXISTING FINISH AND PREPARE SURFACE TO RECEIVE THE NEW FINISH.
7. COORDINATE WITH THE OWNER ANY ITEMS TO BE STORED AND/OR RELOCATED.
8. SEE CIVIL, MECHANICAL, PLUMBING, AND ELECTRICAL DRAWING FOR DEMOLITION OF UTILITIES.
9. FOR EXTENT AND LOCATION OF CHANNELING OF EXISTING FLOOR SLABS REFER TO MECHANICAL, PLUMBING, AND ELECTRICAL DRAWINGS. IF EXISTING PIPING OR CONDUIT WORK (OTHER THAN THE DESIRED CONNECTION) IS ENCOUNTERED WHILE CHANNELING, NOTIFY THE ARCHITECT BEFORE CONTINUING.
10. VERIFY THAT CONSTRUCTION OF EXISTING WALLS WITHIN THE AREA OF RENOVATION (SMOKE COMPARTMENT) MEETS THE FIRE PROTECTION RATINGS DESIGNATED ON THE LIFE SAFETY PLANS. MAKE ANY REPAIRS OR MODIFICATIONS NECESSARY TO BRING EXISTING WALLS, DOORS, DUCTS, ETC. UP TO THE PROPER FIRE PROTECTION RATING. DOORS AND/OR FRAMES SHALL HAVE THE PROPER LABELING.
11. VERIFY THAT EXIT EGRESS IS MAINTAINED FOR ALL OCCUPIED AREAS OF THE BUILDING THROUGHOUT CONSTRUCTION.
12. DEMOLITION WORK SHALL BE EXECUTED IN CONFORMANCE WITH ALL CODES AND AS SET FORTH BY ALL GOVERNING AUTHORITIES.
13. BRACE ALL EXISTING STRUCTURES OR STRUCTURAL ELEMENTS AS NECESSARY DURING DEMOLITION.
14. DO NOT CUT ANY STRUCTURAL WORK WITHOUT PRIOR APPROVAL FROM THE STRUCTURAL ENGINEER.
15. THE EXISTING BUILDING ENVELOPE SHALL BE MAINTAINED IN A WEATHER TIGHT CONDITION AT ALL TIMES.
16. REPLACE OR REPAIR ANY EXISTING TO REMAIN FINISHES WHICH ARE DAMAGED DURING DEMOLITION (I.E. – CEILING GRID, CEILING TILE, WALL COVERING, FLOOR COVERINGS, ETC.)
17. WHEREVER POSSIBLE, RETAIN REMOVED BRICK, TO BE USED TO FILL EXTERIOR WALL OPENINGS.
18. NOTIFY THE ARCHITECT IMMEDIATELY IF THE REMOVAL OF MECHANICAL, ELECTRICAL, PLUMBING SYSTEMS OR COMPONENTS WILL ADVERSELY AFFECT THE OPERATION OF MEP SYSTEMS OUTSIDE THE LIMIT OF DEMOLITION.
19. SCHEDULE ALL DEMOLITION WITH THE OWNER.

DEMOLITION LEGEND

- EXISTING TO REMAIN
- EXISTING TO BE REMOVED RE: NOTE 5 OF DEMOLITION GENERAL NOTES
- EXISTING FLOOR SLAB TO BE REMOVED WITHIN AREA INDICATED
- EXISTING FLOOR, WALL AND CEILING FINISHES ONLY, TO BE REMOVED WITHIN AREA INDICATED
- EXISTING FLOOR AND WALL FINISHES ONLY, TO BE REMOVED WITHIN AREA INDICATED
- AREA OUT OF SCOPE

DEMOLITION NOTES BY NUMBER

1. REMOVE EXISTING WALL AS SHOWN.
2. REMOVE EXISTING DOOR, AND FRAME.
2A. REMOVE EXISTING DOOR ONLY, FRAME TO REMAIN.
3. REMOVE EXISTING CASEWORK AS SHOWN.
3A. REMOVE EXISTING CASEWORK AS SHOWN, SALVAGE FOR REINSTALLATION.
4. REMOVE EXISTING PLUMBING FIXTURES AS SHOWN.
5. STORE ITEM FOR FUTURE REUSE BY HOSPITAL STAFF.
6. REMOVE EXISTING MOVABLE WALL SYSTEM AS SHOWN.
7. REMOVE EXISTING FLOOR FINISH.
8. REMOVE EXISTING BRICK VENEER AND METAL FACIA PANELS AS SHOWN.
9. REMOVE EXISTING WINDOW FROM EXISTING WALL.
10. REMOVE AREA OF EXISTING BRICK VENEER PER DETAIL XXXXX.
11. REMOVE EXISTING LOW WALL.
12. REMOVE EXISTING EXTERIOR CANOPY FRAMING AND SUPPORTS.
13. SAWCUT EXISTING SLAB FOR INSTALLATION OF NEW GRADE BEAM.
14. RELOCATE EXISTING WATER METER. RE: PLUMBING PLANS.
15. REMOVE EXISTING WON-DOOR SYSTEM AS SHOWN.
16. REMOVE WALL AND FINISHES FOR CONSTRUCTION OF NEW COLUMN FOOTING. RE: STRUCTURAL.
17. CUT BACK EXISTING ROOF PER DETAILS. RE: STRUCTURAL.
18. REMOVE PORTION OF EXISTING RAIL FOR NEW REMOVEABLE RAIL. RE: EXTERIOR ELEVATION.
19. REMOVE EXISTING CEILING.
20. REMOVE PORTION OF EXISTING MILLWORK AS SHOWN. PREP FOR NEW SINK.
21. TEMPORARILY MOVE EXISTING EQUIPMENT AS SHOWN. REPLACE AFTER CONSTRUCTION.
22. REMOVE EXISTING PARAPET AS SHOWN.
23. REMOVE EXISTING CONCRETE APPLIED PANEL AS SHOWN. RE: DETAIL.
24. REMOVE EXISTING ASPHALT PAVING.
25. REMOVE EXISTING SIGNAGE. COORDINATE RELOCATION W/OWNER.
26. REMOVE EXISTING ASPHALT PAVING AND SUB-BASE FOR NEW PARKING STRUCTURE.
27. REMOVE EXISTING SLATWALL.
28. REMOVE EXISTING CEILING.
29. RELOCATE EXISTING FIRE EXTINGUISHER CABINET.
30. REMOVE EXISTING 6" HIGH CONCRETE CURB AROUND ROOM.
31. RELOCATE EXISTING COOKERS AS DIRECTED.
32. EXISTING FURROWN TO REMAIN.
33. EXISTING DUCT TO REMAIN. VERIFY THAT NEW BLOCK WILL NOT INTERFER WITH OPERATION.
34. REMOVE EXISTING TRAY DROP PASS-THRU.
35. REMOVE EXISTING CANOPY.
36. REMOVE EXISTING SIDEWALK.

This sheet of drawings has not been reviewed for code compliance.

09 -384477

PERKINS & WILL
10100 North Central Expressway, Suite 300
Dallas, Texas 75231, USA
214.283.8700 Fax: 214.283.8701
www.perkinswill.com

Medical Center of Aurora
South Campus
Private Room Expansion
Aurora, Colorado

HCA
Project # 306660001

In association with:

Civil
Martin Martin, Inc.
4251 Kipling Street
Wheat Ridge, CO 80033
T: 303.431.6100
F: 303.431.4028


Structural
TRC International, Ltd.
5050 QUARUM DRIVE, SUITE 700
Dallas, TX 75254
T: 214.722.6452
F: 214.722.6552

MEP
CCRD Partners
3625 N. HALL STREET
SUITE 1300, LB 139
DALLAS, TX-75219
T: 214.521.1661
F: 214.521.1664

LANDSCAPE
Davis Partnership
2310 BLAKE STREET, SUITE 100
DENVER, CO 80205
T: 303.861.8555
F: 303.861.3027

AUGUST 08
EARLY RELEASE PKG. #2
ADDENDUM #1
ISSUED FOR CONSTRUCTION

KEY PLAN
FIRST FLOOR

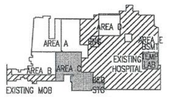

2.24.09
STATE OF COLORADO
TRUBY J. SCHMIDT
203601
LICENSED ARCHITECT
8.8.06

Revisions

NO.	ISSUE	DATE
2	FIELD MEMO – 02-10-09	
1	ADDENDUM #1	08/08/06

Sheet Information

Date	07-13-2006
Job Number	142228.000
Drawn	LTS
Checked	DcE
Approved	CG

Title

DEMOLITION PLAN
FIRST FLOOR
MISC. AREAS

Sheet


D-2000

Issued for Construction


Copyright © 2005 PERKINS & WILL

Aug 08, 2006 - 8:37pm
P:\142228 Med Ctr of Aurora - Bed Tower Expan\CAD\ERP#2\D-2000.dwg
schmidt


P:\142228 Med Ctr of Aurora - Bed Tower Expan\CAD\ERP#2\D-2000.dwg, 8/8/2006 8:37:39 AM, schmidt

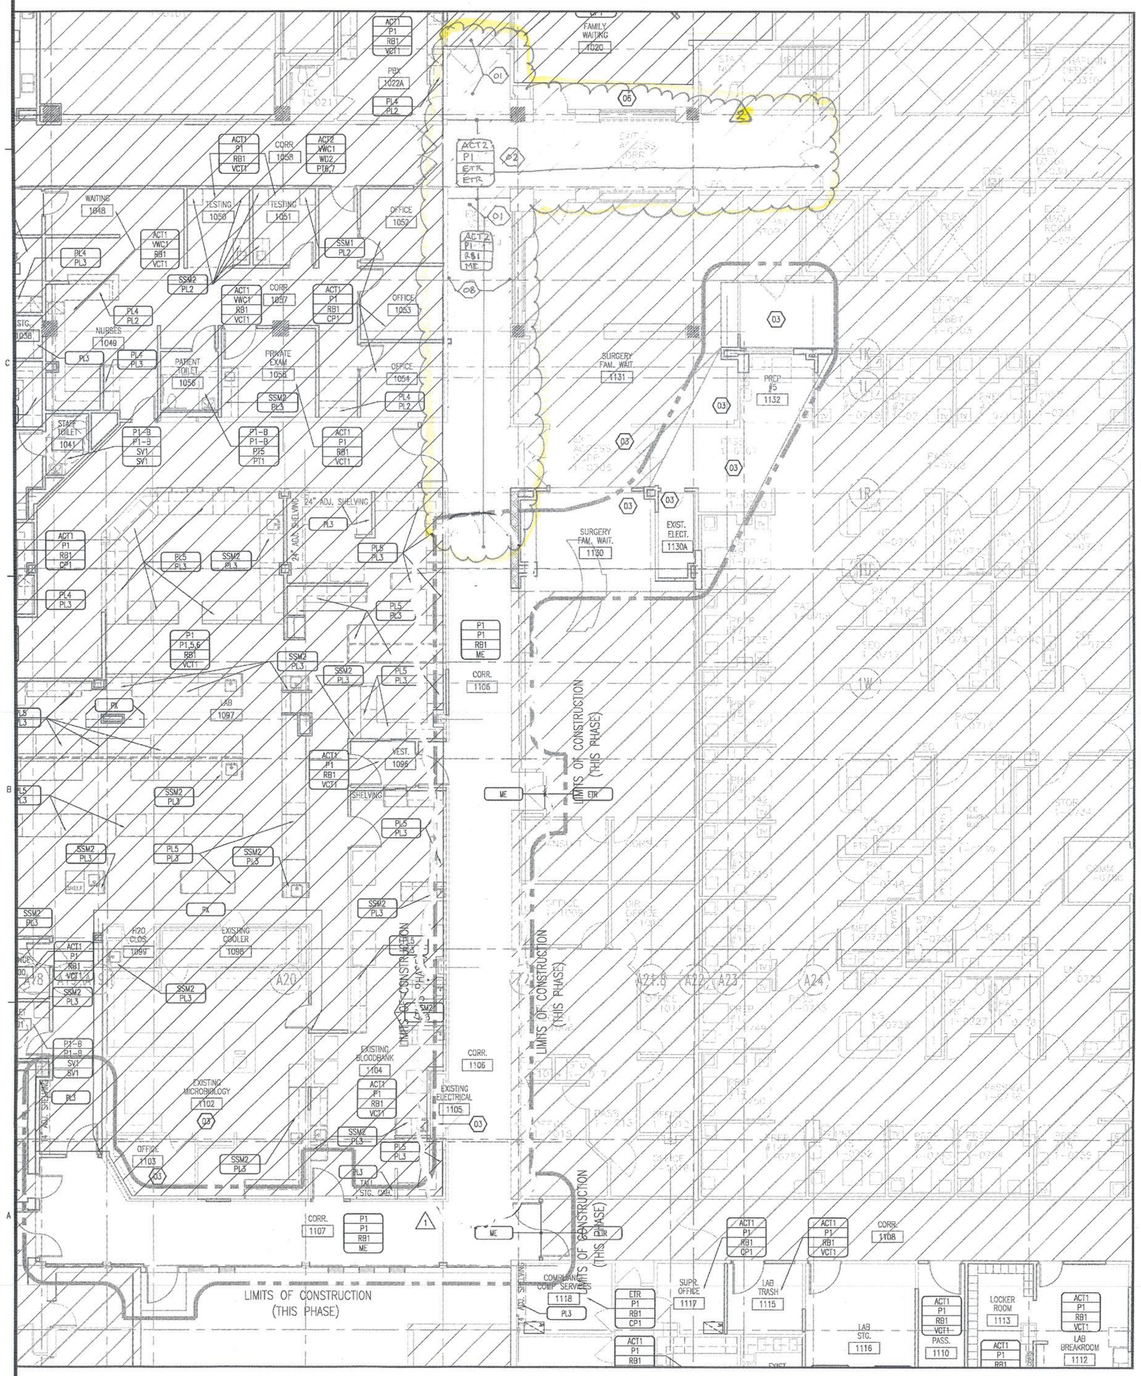


01 INTERIOR FINISH PLAN – 1ST FLR – EXIT CORRIDOR AT FINAL PHASE
1/8" = 1'-0"

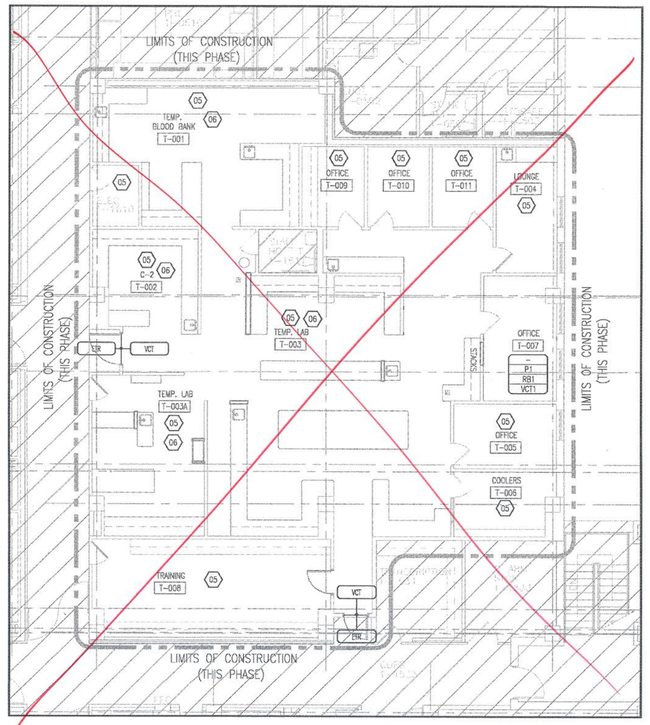

04 INTERIOR FINISH PLAN – 1ST FLR – TEMP LAB
1/8" = 1'-0"

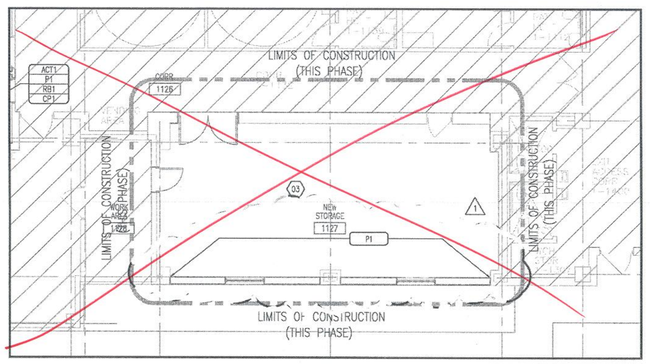

03 INTERIOR FINISH PLAN – 1ST FLR – BED STORAGE
1/8" = 1'-0"

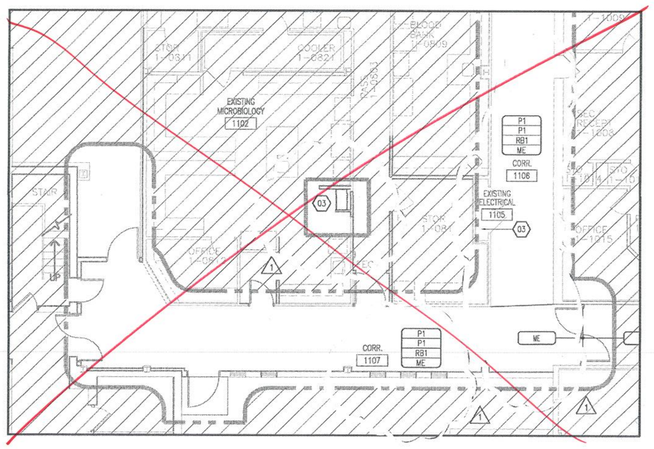

02 INTERIOR FINISH PLAN – 1ST FLR – MICROBIOLOGY – PHASE 2.2 AND EXIT CORRIDOR
1/8" = 1'-0"

GENERAL NOTES

1. REFER TO INTERIOR FINISH LEGEND A-8000 FOR FINISH MANUFACTURER AND COLOR INFORMATION.
2. REFER TO A-5600 FOR FLOOR TRANSITION DETAILS.
3. ALL CUBICLE CURTAINS TO BE CC1.

KEYNOTES

01 REMOVE TILE AND REPLACE WITH VCT TO MATCH ADJACENT CORRIDORS. RUBBER BASE TO MATCH ADJACENT CORRIDORS.
02 EXISTING TILE FLOOR TO REMAIN. REMOVE VWC AND SKIM WALLS TO PREP AND RECEIVE PAINT AS INDICATED.
03 PATCH TO MATCH EXISTING FLOOR, BASE, WALL AND CEILING FINISHES
04 PRICE AS ALTERNATE: REPLACE EXISTING TILE WITH PT1 FLOORING AND PT5 BASE
05 REPLACE EXISTING FLOORING WITH VCT1. ALL OTHER FINISHES PATCH TO MATCH.
06 ALL TEMPORARY LAB CASEWORK SHALL BE PL3 CABINET FRONTS AND EXPOSED SIDEES AND PL5 FOR COUNTERTOPS.
07 NEW WALL CONSTRUCTION TO RECEIVE P...
08 WALL TO BE PAINTED P1.

ROOM FINISH TAG
ACT CEILING FINISH
VWC WALL FINISH
RB WALL BASE FINISH
VCT FLOOR FINISH

MILLWORK FINISH TAG
SS1 COUNTERTOP
PL2 CABINET FRONT/ VERTICAL SURFACE

* DENOTES MULTIPLE FINISHES. PLEASE REFER TO ENLARGED PLANS, FLOOR PATTERN PLANS AND/OR ELEVATIONS FOR INFORMATION.

CC CUBICLE CURTAIN
ETR EXISTING TO REMAIN
XXX FINISH TAG
WT WINDOW TREATMENT
ME MATCH EXISTING
XXX FLOOR TRANSITION TAG
ETR
X KEYNOTE
NOT IN SCOPE OF WORK
LIMITS OF CONSTRUCTION (THIS PHASE)

PERKINS & WILL
10100 North Central Expressway, Suite 300
Dallas, Texas 75231, USA
214.283.8700 Fax: 214.283.8701
www.perkinswill.com


Medical Center of Aurora
South Campus
...te Room Expansion
Aurora, Colorado

HCA
Project # 306660001

In association with:
Civil
Martin Martin, Inc.
4251 Kipling Street
Wheat Ridge, CO 80033
T: 303.431.6100
F: 303.431.4028
Structural
TRC International, Ltd.
5050 QUARUM DRIVE, SUITE 700
Dallas, TX 75254
T: 214.722.6452
F: 214.722.6552
MEP
CCRD Partners
3625 N. HALL STREET
SUITE 1300, LB 139
DALLAS, TX-75219
T: 214.521.1661
F: 214.521.1664
LANDSCAPE
Davis Partnership
2310 BLAKE STREET, SUITE 100
DENVER, CO 80205
T: 303.861.8555
F: 303.861.3027

AUGUST 08
EARLY RELEASE PKG. #2
ADDENDUM #1
ISSUED FOR CONSTRUCTION

KEY PLAN
FIRST FLOOR

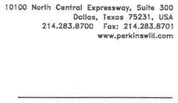

2.24.09
JAMES L. SCHMIDT
203601
REGISTERED ARCHITECT
8.8.06

Revisions

NO.	ISSUE	DATE
2	FIELD MEMO – 02-10-09	
1	ADDENDUM #1	08/08/06

Sheet Information

Date	07-13-2006
Job Number	142228.000
Drawn	CR,JB
Checked	CN
Approved	CC

Title

INTERIOR FINISH PLAN FIRST FLOOR MISC. AREAS

Sheet

A-2200

Issued for Construction


Copyright © 2005 PERKINS & WILL

CITY OF AURORA
BUILDING DIVISION
APPROVED AS NOTED
DATE APPROVED MAR 26 2009

09 -384477


Aug 08, 2006 - 9:05am
P:\142228 Med Ctr of Aurora - Bed Tower Expan\CAD\ERP#2\A-2200.dwg
schmidt

P:\142228 Med Ctr of Aurora - Bed Tower Expan\CAD\ERP#2\A-2200.dwg, 8/8/2006 9:05:37 AM, schmidt

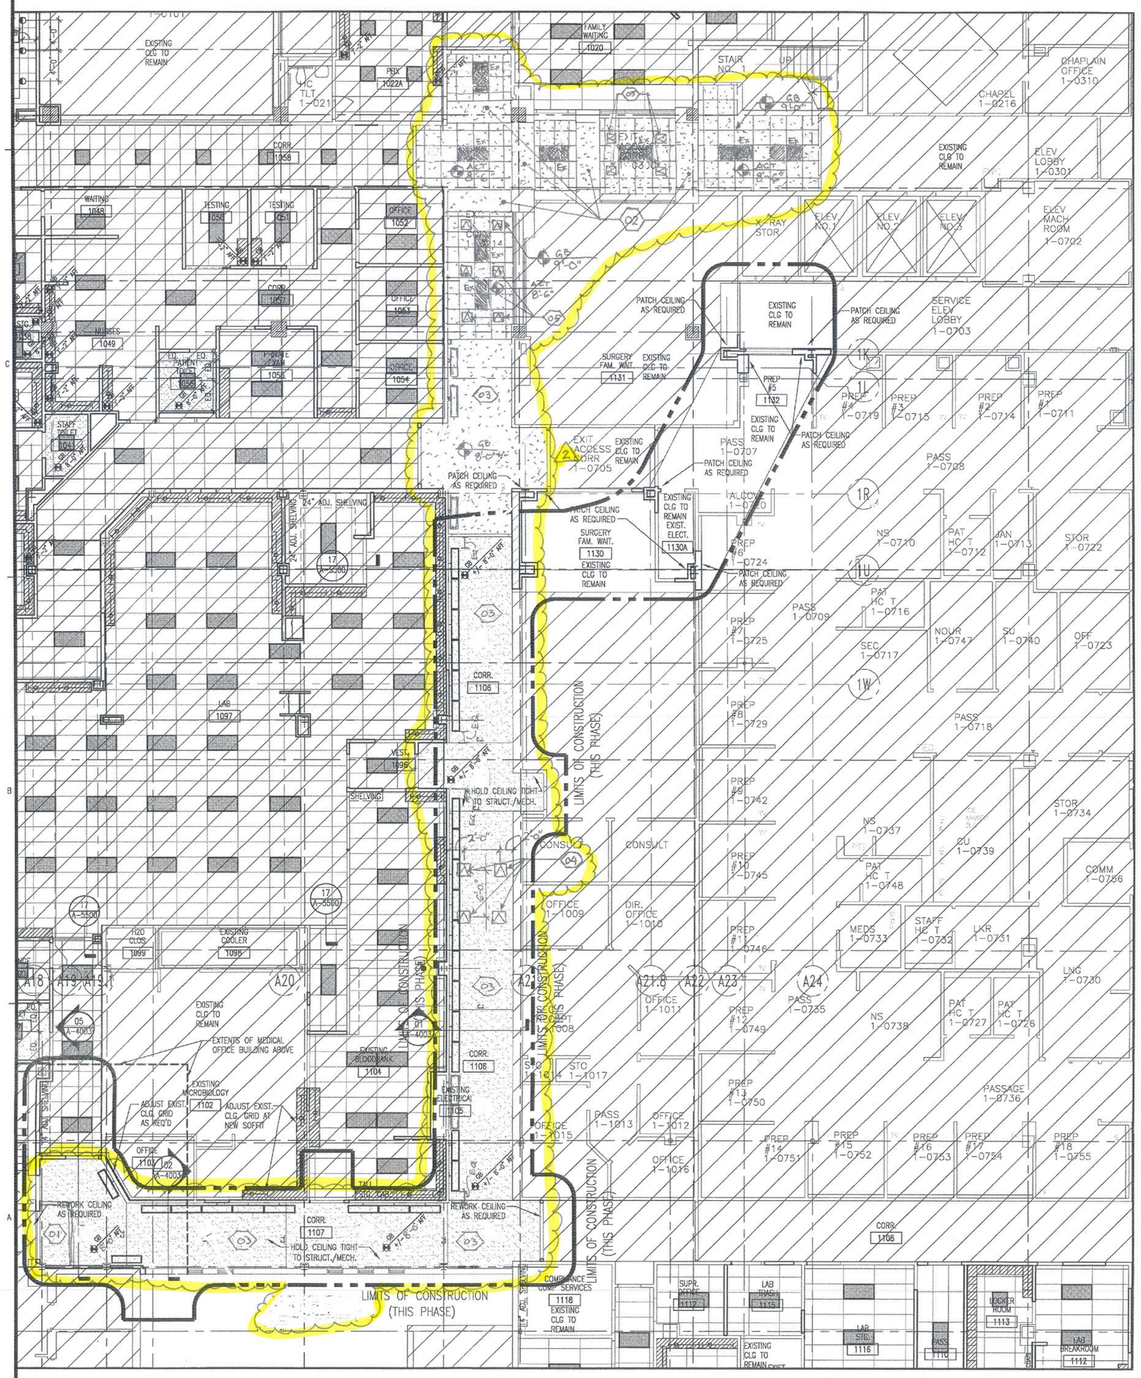


01 REFLECTED CEILING PLAN – 1ST FLR – EXIT CORRIDOR AT FINAL PHASE

1/8" = 1'-0"

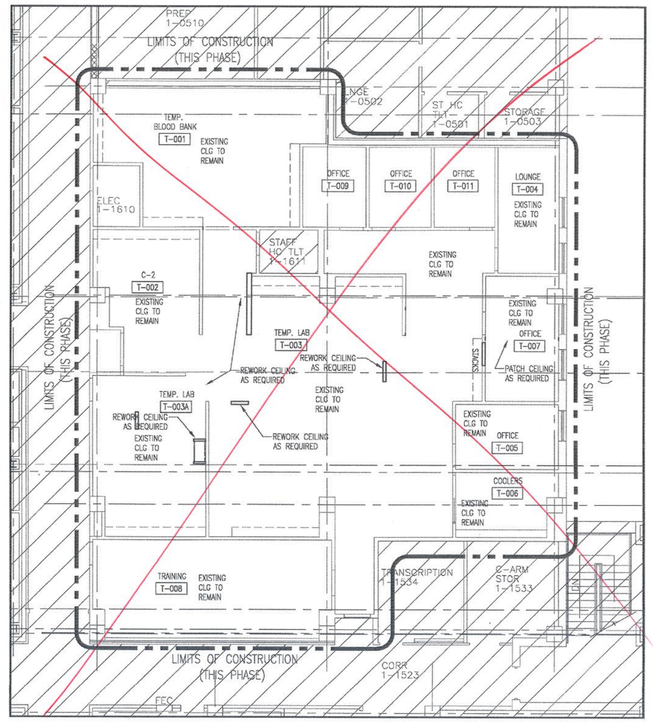


04 REFLECTED CEILING PLAN – 1ST FLR – TEMP LAB

1/8" = 1'-0"

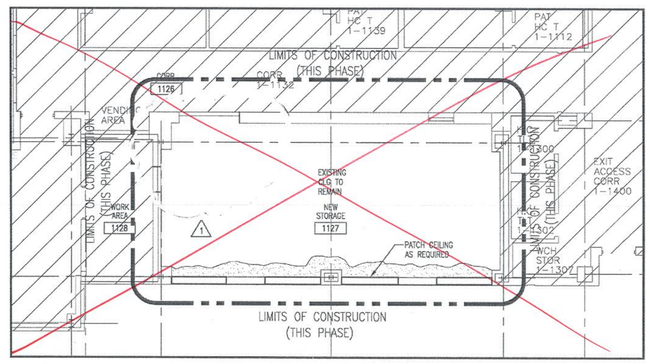

03 REFLECTED CEILING PLAN – 1ST FLR – BED STORAGE

1/8" = 1'-0"

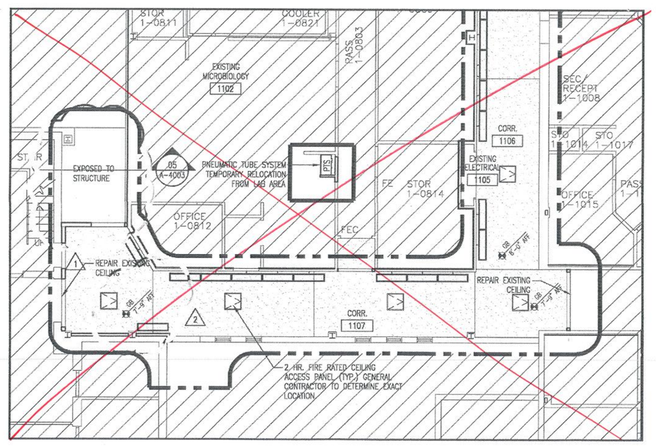

02 REFLECTED CEILING PLAN – 1ST FLR – MICROBIOLOGY – PHASE 2.2 AND EXIT CORRIDOR

1/8" = 1'-0"

RCP PLAN GENERAL NOTES

1. THE CONTRACTOR SHALL COMPARE THIS REFLECTED CEILING PLAN WITH ELECTRICAL LIGHTING PLANS, MECHANICAL SUPPLY, RETURN, AND EXHAUST PLANS. THE CONTRACTOR SHALL REPORT ANY OMISSIONS OR INCONSISTENCIES TO THE ARCHITECT.
2. SEE ELECTRICAL DRAWINGS FOR THE LOCATIONS OF CEILING MOUNTED SMOKE DETECTORS, SPEAKERS, NURSE CALL DOME LIGHTS, EXIT SIGNAGE, FIRE ALARM DEVICES, ETC. ALSO SEE ELECTRICAL FOR LOCATIONS OF WALL MOUNTED EXIT LIGHTS.
3. FOR FURTHER DIMENSIONS SEE LARGE SCALE PLANS, SECTIONS, ELEVATIONS, AND DETAILS.
4. SPRINKLER HEAD LOCATIONS ARE NOT SHOWN ON ARCHITECTURAL REFLECTED CEILING PLANS. CONTRACTOR TO INSTALL SUFFICIENT HEADS IN ALL SPACES TO PROVIDE 100% COVERAGE AS REQUIRED UNDER NFPA 13 AND OWNERS INSURANCE COMPANIES' REQUIREMENTS. HEADS SHALL BE LOCATED IN THE CENTER OF CEILING TILES, U.N.O.
5. THE CONTRACTOR SHALL VERIFY THAT ACCESS PANELS OF TYPE SPECIFIED ARE INSTALLED IN NON-ACCESSIBLE TYPE CEILINGS WHERE SERVICE OR ADJUSTMENT TO MECHANICAL, PLUMBING, OR ELECTRICAL ITEMS MAY BE REQUIRED. ACCESS PANELS SHALL BE THE FIRE RATED TYPE EQUAL TO THE RATING OF THE WALL OR CEILING IN WHICH THEY OCCUR.
6. 18" MINIMUM VERTICAL CLEARANCE SHALL BE MAINTAINED BETWEEN THE BOTTOM OF RECESSED SPRINKLER HEADS AND THE TOP OF ANY FILES, SHELVING, LOCKERS, ETC.
7. DELETED.
8. ROUGH SUPPLY DRAIN AND VENT PIPES TO MAINTAIN SCHEDULED CEILING HEIGHTS. COORDINATE RELOCATIONS WITH MEP ENGINEERS.
9. WHERE EXISTING LAY-IN CEILINGS ARE TO REMAIN, THE CONTRACTOR SHALL REPLACE ANY TILE THAT HAS BEEN DAMAGED WITH MATERIALS THAT MATCH THE EXISTING FOR COLOR, TEXTURE, PATTERN, ETC. IF UNIFORMITY CANNOT BE ACHIEVED, THE CONTRACTOR SHALL REPLACE THE ENTIRE CEILING WITHIN THE SPACE WITH NEW MATERIAL.

RCP LEGEND

- SUSPENDED 2' X 2' ACOUSTICAL CEILING SYSTEM
- SUSPENDED 2' X 4' ACOUSTICAL CEILING SYSTEM
- NEW RECESSED FLUORESCENT LIGHT FIXTURE
- R — RELOCATED RECESSED FLOURESCENT LIGHT FIXTURE
- EXISTING RECESSED FLOURESCENT LIGHT FIXTURE TO REMAIN
- FLOURESCENT STRIP COVE LIGHTING RE: X/A-5500
- SUPPLY AIR GRILLE — REFER TO MECHANICAL DRAWINGS FOR ADDITIONAL INFORMATION
- RETURN AIR GRILLE — REFER TO MECHANICAL DRAWINGS FOR ADDITIONAL INFORMATION
- EXHAUST AIR GRILLE — REFER TO MECHANICAL DRAWINGS FOR ADDITIONAL INFORMATION
- C.J — SUPPLY STRIP DIFFUSER RE: MECHANICAL SOFFIT/GYP. BD./PLASTER CONTROL JOINT
- 1 / A-5000 — DETAIL TAG
- EXPANSION JOINT (RE: SPECS FOR JOINT COVER)
- 8'-0" AFF BATT. — CEILING HEIGHT DESIGNATION PER AREA. WHERE NO HEIGHT IS DESIGNATED, 9'-0".
- C.T. — CUBICLE CURTAIN TRACK
- I.V. — I.V. TRACK
- GYP. BD. FURRDOWN @ CASEWORK (RE: X/A-5500 TYP.)
- WALL MOUNTED LIGHT FIXTURE
- TRACK LIGHT
- F — FLOURESCENT PENDANT
- SURFACE MOUNTED FLUORESCENT LIGHT FIXTURE
- P — CEILING MOUNT PENDANT LIGHT
- RECESSED CAN LIGHT FIXTURE
- SHOWER DOME LIGHT (BY SHOWER MANUFACTURER).
- UNDER CABINET TASK LIGHTING
- GYP. BD. CEILING OR SUSPENDED CEMENT PLASTER SOFFIT
- ES — EXPOSED STRUCTURE
- MS — MEDICAL SUPPORT SYSTEM. COORDINATE WITH VENDOR. RE. SPECS.
- WALL WASHER
- S — SOFFIT VENTS – RE: X/A-4000
- WALL MOUNTED SECURITY CAMERA
- CEILING MOUNTED SECURITY CAMERA

RCP NOTES BY NUMBER

01 NON-RATED GYPSUM BOARD CEILING.
02 NON-RATED GYPSUM HEADER. CONSTRUCT BELOW RATED CEILING ASSEMBLY TO 8'-3" A.F.F.
03 2-HOUR RATED CEILING ASSEMBLY CONSTRUCTED PER NER-258.
04 18 x 18 2 HOUR RATED ACCESS PANEL. LOCATE AS DIMENSIONED IN ALL RATED CORRIDOR CEILINGS WITH EXPOSED GYPSUM CEILINGS.
05 18 X 18 2 HOUR RATED ACCESS PANELS. LOCATE @ 6'-0" O.C. AND COORDINATE WITH CEILING GRID AS SHOWN TO PROVIDE EASE OF ACCESS. TYPICAL FOR ALL DOUBLE CEILINGS.

CITY OF AURORA
BUILDING DIVISION
APPROVED AS NOTED
DATE APPROVED MAR 2 6 2009

09 -384477

PERKINS & WILL
10100 North Central Expressway, Suite 300
Dallas, Texas 75231, USA
214.283.8700 Fax: 214.283.8701
www.perkinswill.com

Medical Center of Aurora
South Campus
Private Room Expansion
Aurora, Colorado

HCA

Project # 306660001

in association with:

Civil
Martin Martin, Inc.
4251 Kipling Street
Wheat Ridge, CO 80033
T: 303.431.6100
F: 303.431.4028


Structrual
TRC International, Ltd.
5050 QUARUM DRIVE, SUITE 700
Dallas, TX 75254
T: 214.722.6452
F: 214.722.6552

MEP
CCRD Partners
3625 N. HALL STREET
SUITE 1300, LB 139
DALLAS, TX-75219
T: 214.521.1661
F: 214.521.1664

LANDSCAPE
Davis Partnership
2310 BLAKE STREET, SUITE 100
DENVER, CO 80205
T: 303.861.8555
F: 303.861.5027

AUGUST 08
EARLY RELEASE PKG. #2
ADDENDUM #1
ISSUED FOR CONSTRUCTION

KEY PLAN
FIRST FLOOR

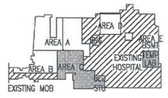

8.2.2009
TIMOTHY L. SCHMIDT
REGISTERED
203601
LICENSED ARCHITECT
8.8.06

Revisions	
FIELD MEMO – 02-10-09	
ADDENDUM #1	08/08/05
NO. ISSUE	DATE

Sheet Information

Date	07-13-2006
Job Number	142228.000
Drawn	LTS
Checked	DcE
Approved	CC

Title

REFLECTED CEILING PLAN FIRST FLOOR MISC. AREAS

Sheet

A-2400

Issued for Construction

Copyright © 2005 PERKINS & WILL

Aug 08, 2009 - 8:35am
P:\142228 Med Ctr of Aurora - Bed Tower Expan\CAD\ERP#2\A-2400.dwg
schmidt

P:\142228 Med Ctr of Aurora - Bed Tower Expan\CAD\ERP#2\A-2400.dwg, 8/8/2006 8:35:14 AM, schmidt

#677
1 - WD Door
Aluminum Frame

1017A	TEMP. ADMIN	4'-0"	7'-0"	WD	NV	WD2	A	HM	02/A-8300	01/A-8300	---	45/ST	---	---
1017B	TEMP. ADMIN	4'-0"	7'-0"	WD	NV	WD2	A	HM	02/A-8300	01/A-8300	---	45/ST	---	---
1019	STORAGE	3'-0"	7'-0"	WD	F	WD2	A	HM	02/A-8300	01/A-8300	---	45/ST	---	---
1023	OFFICE	3'-0"	7'-0"	WD	F	WD2	A	WD	02/A-8300	01/A-8300	---	ST	---	---
1024A	WHEELCHAIR	3'-0"	7'-0"	WD	F	WD2	A	WD	02/A-8300	01/A-8300	---	45/ST	---	---
1024B	WHEELCHAIR	3'-0"	7'-0"	WD	F	WD2	A	WD	02/A-8300	01/A-8300	---	45	---	---
1025	RECEPT.	3'-0"	7'-0"	WD	F	WD2	C	WD	02/A-8300	01/A-8300	---		---	---
1026	WAITING	6'-0"	7'-0"	WD	DV	WD2	H	WD	13/A-8301	12/A-8301	---	ST	---	6
1028	PUB. TOILET	3'-0"	7'-0"	WD	F	WD2	A	WD	02/A-8300	01/A-8300	---	---	---	---
1030	REGIST.	4'-0"	7'-0"	WD	NV	WD2	A	WD	02/A-8300	01/A-8300	---	---	---	---
1031	REGIST.	4'-0"	7'-0"	WD	NV	WD2	A	WD	02/A-8300	01/A-8300	---	---	---	---
1032	REGIST.	3'-0"	7'-0"	WD	NV	WD2	A	WD	02/A-8300	01/A-8300	---	---	---	---
1033	REGIST.	3'-0"	7'-0"	WD	NV	WD2	A	WD	02/A-8300	01/A-8300	---	---	---	---
1034	REGIST.	3'-0"	7'-0"	WD	NV	WD2	A	WD	02/A-8300	01/A-8300	---	---	---	---
1035A	WORK AREA	3'-0"	7'-0"	WD	NV	WD2	A	WD	02/A-8300	01/A-8300	---	---	---	4
1035B	WORK AREA	3'-0"	7'-0"	WD	F	WD2	A	HM	02/A-8300	01/A-8300	---	45/ST	---	4
1036	OFFICE	3'-0"	7'-0"	WD	F	WD2	A	HM	02/A-8300	01/A-8300	---	---	---	---
1037A	CONSULT.	3'-0"	7'-0"	WD	F	WD2	A	WD	02/A-8300	01/A-8300	---	---	---	---
1037B	CONSULT.	3'-0"	7'-0"	WD	F	WD2	A	HM	02/A-8300	01/A-8300	---	---	---	---
1038	STG.	3'-0"	7'-0"	WD	F	WD2	A	HM	02/A-8300	01/A-8300	---	---	---	---
1039	PBC	3'-0"	7'-0"	WD	F	WD2	A	HM	02/A-8300	01/A-8300	---	---	---	---
1040	BREAK ROOM	3'-0"	7'-0"	WD	F	WD2	A	HM	02/A-8300	01/A-8300	---	---	---	---
1041	STAFF TOILET	3'-0"	7'-0"	WD	F	WD2	A	HM	02/A-8300	01/A-8300	---	---	---	---
1042	FINAL CONSULT.	3'-0"	7'-0"	WD	F	WD2	A	HM	02/A-8300	01/A-8300	---	---	---	---
1043	DIRECTOR	3'-0"	7'-0"	WD	F	WD2	A	HM	02/A-8300	01/A-8300	---	---	---	---
1044	SUPR.	3'-0"	7'-0"	WD	F	WD2	A	HM	02/A-8300	01/A-8300	---	---	---	---
1045	MGR.	3'-0"	7'-0"	WD	F	WD2	A	HM	02/A-8300	01/A-8300	---	---	---	---
1046A	CONSULT.	3'-0"	7'-0"	WD	F	WD2	A	HM	02/A-8300	01/A-8300	---	---	---	---
1046B	CONSULT.	3'-0"	7'-0"	WD	F	WD2	A	HM	02/A-8300	01/A-8300	---	45/ST	---	---
1047A	CASHIER	3'-0"	7'-0"	WD	F	WD2	A	WD	02/A-8300	01/A-8300	---	ST	---	---
1047B	CASHIER	3'-0"	7'-0"	WD	F	WD2	A	HM	02/A-8300	01/A-8300	---	---	---	---
1048	WAITING	3'-0"	7'-0"	WD	NV	WD2	A	WD	02/A-8300	01/A-8300	---	45/ST	---	---
1049	NURSES	3'-0"	7'-0"	WD	F	WD2	A	HM	02/A-8300	01/A-8300	---	ST	---	---
1051	TESTING	3'-0"	7'-0"	WD	F	WD2	A	HM	02/A-8300	01/A-8300	---	---	---	---
1052	OFFICE	3'-0"	7'-0"	WD	F	WD2	A	HM	02/A-8300	01/A-8300	---	---	---	---
1053	OFFICE	3'-0"	7'-0"	WD	F	WD2	A	HM	02/A-8300	01/A-8300	---	---	---	---
1054	OFFICE	3'-0"	7'-0"	WD	F	WD2	A	HM	02/A-8300	01/A-8300	---	---	---	---
1055	PRIVATE EXAM	4'-0"	7'-0"	WD	F	WD2	A	HM	02/A-8300	01/A-8300	---	---	---	---
1056	PATIENT TOILET	3'-0"	7'-0"	WD	F	WD2	A	HM	02/A-8300	01/A-8300	---	---	---	---
1057	CORRIDOR	3'-0"	7'-0"	WD	F	WD2	A	HM	02/A-8300	01/A-8300	---	45/ST	---	4
1061A	ELEVATOR #3	4'-0"	7'-0"	---	---	---	E	HM	–	–	–	90	---	18
1061B	ELEVATOR #4	4'-0"	7'-0"	---	---	---	E	HM	–	–	–	90	---	18
1061C	ELEVATOR LOBBY	7'-0"	7'-0"	WD	NV	WD2	C	HM	04/A-8300	03/A-8300	---	---	---	4,12
1061D	ELEVATOR LOBBY	7'-4"	7'-0"	WD	NV	WD2	B	HM	06/A-8300	05/A-8300	---	45/ST	---	1
1062	CORRIDOR	7'-4"	7'-0"	WD	NV	WD1	B	HM	06/A-8300	05/A-8300	---	90/ST	---	4,12
1063A	CORRIDOR	5'-6"	7'-0"	WD	NV	WD2	C	HM	04/A-8300	03/A-8300	---	ST	---	---
1063B	CORRIDOR	5'-6"	7'-0"	HM	F	WD1/WD2	D	HM	15/A-8302	14/A-8302	---	180/ST	---	17,12,4
1064	WAITING	3'-0"	7'-0"	WD	F	WD2	A	HM	02/A-8300	01/A-8300	---	ST		---
1065	ECHO #2	3'-8"	7'-0"	WD	F	WD2	A	HM	02/A-8300	01/A-8300	---	ST		---
1066	ECHO #1	3'-8"	7'-0"	WD	F	WD2	A	HM	02/A-8300	01/A-8300	---	ST		---
1067	PULM. STRESS	3'-8"	7'-0"	WD	F	WD2	A	HM	02/A-8300	01/A-8300	---	ST		---
1068A	STAIR #2	3'-8"	8'-0"	HM	F	PT	A	HM	15/A-4202	16/A-4202	05/A-4202	---		4
1072	MENS TOILET	3'-0"	7'-0"	WD	F	WD2	A	HM	02/A-8300	01/A-8300	---	ST		---
1073	WOMENS TOILET	3'-0"	7'-0"	WD	F	WD2	A	HM	02/A-8300	01/A-8300	---	ST		---
1074	RECEPTION	3'-0"	7'-0"	WD	F	WD2	A	HM	02/A-8300	01/A-8300	---	ST		---
1075	CORRIDOR	4'-0"	7'-0"	WD	F	WD2	A	HM	02/A-8300	01/A-8300	---	ST		4
1076	OFFICE	3'-0"	7'-0"	WD	F	WD2	A	HM	02/A-8300	01/A-8300	---	ST		---
1077	ECHO READING	3'-0"	7'-0"	WD	F	WD2	A	HM	02/A-8300	01/A-8300	---	ST		---

5.01
5.02


4

4


1102	EXISTING MICRO.
1104A	EXISTING BLOODBANK
1104B	EXISTING BLOODBANK
1107A	CORRIDOR
1107B	CORRIDOR
1107C	CORRIDOR
1107D	CORRIDOR
1110	PASSAGE
1111	TOILET
1112	LAB BREAKROOM
1115	LAB TRASH
1116	LAB STG.
1121	POC TRAINING
1122	STG.
1123	POC OFFICE
1124	FAC. STG.
1125	SECURITY OFFICE
1127A	NEW STORAGE
1127B	NEW STORAGE
1129A	MECH ROOM
1129B	CENTRAL PLANT
1129CA	MECH ROOM
1129CB	MECH ROOM
1129D	CENTAL PLANT
1130A	STAIR #1
1133	ELECTRICAL
1133A	MECH ROOM
1133B	PUMP ROOM
1134A	ELECTRICAL
1134B	ELECTRICAL
1135A	RECEPT.
1135B	RECEPT.
1136	FILE
1137	BREAKROOM
1138	CONFERENCE
1138B	CONFERENCE
1139	TLT.
1140	CORRIDOR
~~1141~~	~~OFFICE~~
1142	OFFICE
1143	OFFICE
1144	OFFICE
1145	OFFICE
1145B	OFFICE
1145C	OFFICE
1146A	SHELL
1146B	CORRIDOR
~~1148~~	~~BREAK ROOM~~
~~1149~~	~~SHOP~~
~~1149A~~	~~PAINT ROOM~~
~~1151~~	~~STORAGE~~
?	?
T-002	TEMP. LAB
T-008	TRAINING
T-008A	TEMP LAB

RFI #10010


09 -384477

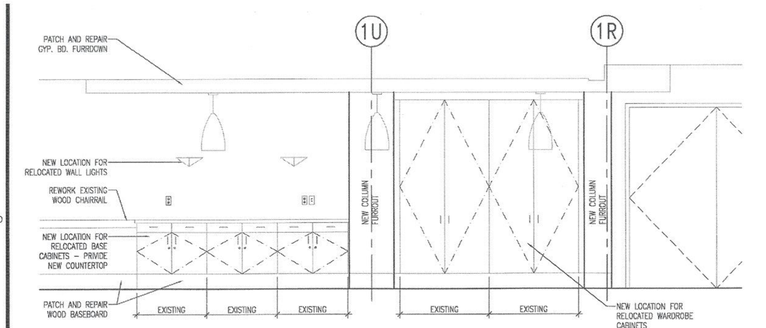


13 SURGERY FAMILY WAITING #1130
3/8" = 1'-0"

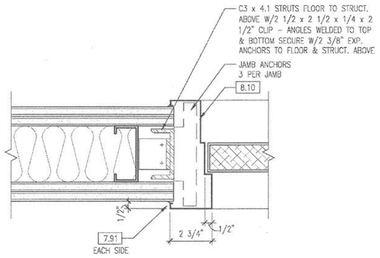


12 JAMB – DOUBLE EGRESS–HM
3"=1'-0"

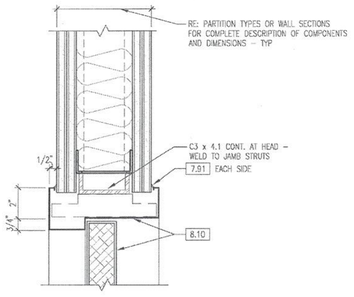



11 HEAD @ DOUBLE EGRESS–HM
3"=1'-0"

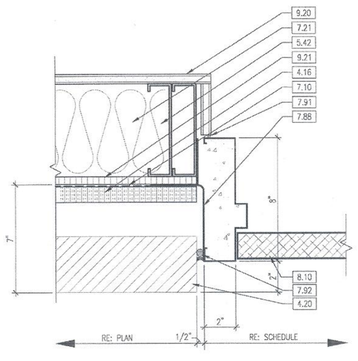


10 JAMB @ EXT. DOOR – HM/BRICK
3"=1'-0"

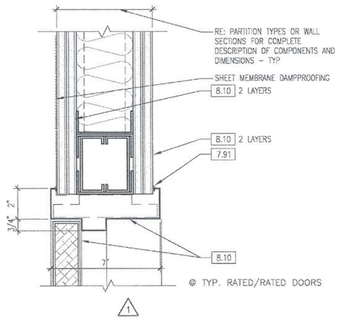

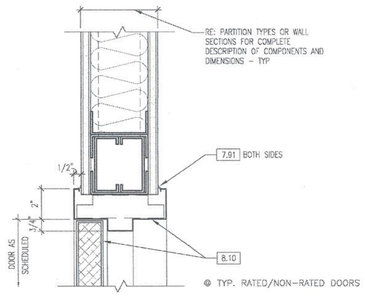


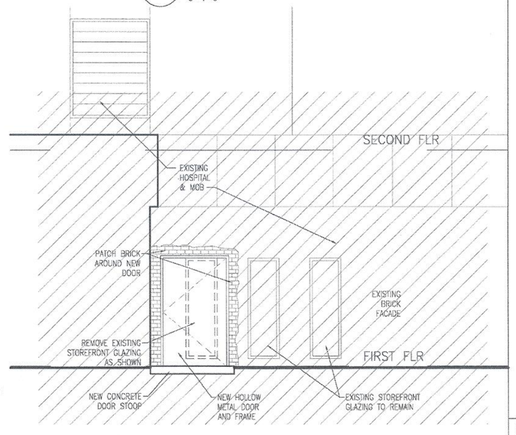


03 WEST PARTIAL ELEVATION @ EXTERIOR DR
1/4"=1'-0"

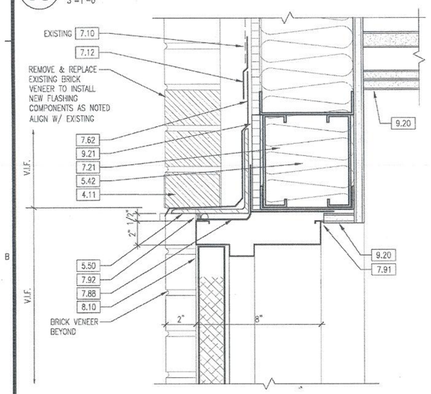


09 HEAD @ EXT. DOOR – HM/BRICK
3"=1'-0"

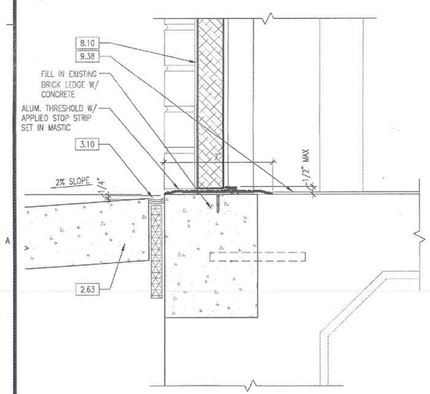

08 SILL @ EXT. DOOR – HM
3"=1'-0"

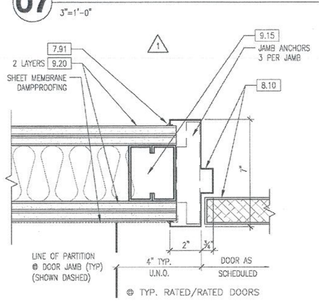

07 HEAD @ EXT. DOOR – HM
3"=1'-0"

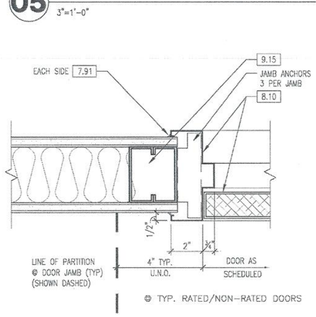

05 HEAD @ INT. DOOR – HM
3"=1'-0"

06 JAMB @ EXT. DOOR – HM
3"=1'-0"

04 JAMB @ INT. DOOR – HM
3"=1'-0"

02 NOT USED
1/4"=1'-0"

DOOR SCHEDULE

DOOR NUMBER	ROOM NAME	SIZE WIDTH	SIZE HEIGHT	TYPE	MATL	FINISH	GLAZING	FRAME MAT.	DETAIL HEAD	DETAIL JAMB	DETAIL SILL	RATING	REMARKS	Frame Type	Fire Rating
1097T	LAB	4'-0"	7'-0"	F	HM	PT	--	HM	07/A-4001	06/A-4001	08/A-4001 SIM	90/ST	--	A	--
1104B	EXISTING BLOODBANK	4'-0"	7'-0"	NV	HM	ST	WIRE	HM	07/A-4001	06/A-4001	--	90/ST	4	A	--
1107A	CORRIDOR	3'-0"*	7'-0"	F	HM	PT	--	HM	11/A-4001 SIM	12/A-4001 SIM	--	180/ST	--21	A	--
1107B	CORRIDOR	4'-0"	7'-0"	F	HM	PT	--	HM	09/A-4001	10/A-4001	08/A-4001	ST	19	A	--
1107C	CORRIDOR	7'-4"	7'-0"	NV	WD	ST	WIRE	HM	11/A-4001	12/A-4001	--	90/ST	1	B	--
1107D	CORRIDOR	7'-0"	7'-0"	NF	HM	PT	--	HM	11/A-4001	12/A-4001	--	180/ST	12,22	C	--
1107E	EXISTING BLOODBANK	3'-0"	7'-0"	F	WD	ST	--	HM	05/A-4001	04/A-4001	--	90/ST	20	A	--
1127A	NEW STORAGE	7'-6"	7'-0"	F	HM	PT	--	HM	09/A-4001	10/A-4001	--	45/ST	--	C	--
1127B	NEW STORAGE	3'-0"	7'-0"	F	HM	PT	--	HM	09/A-4001	10/A-4001	--	45/ST	--	A	--
T-002	TEMP. LAB	4'-0"	7'-0"	NV	WD	ST	WIRE	HM	05/A-4001	04/A-4001	--	45/ST	4	A	--
T-008	TRAINING	3'-0"	7'-0"	F	WD	ST	--	HM	05/A-4001	04/A-4001	--	--	--	A	--
T-008A	TEMP LAB	3'-0"	7'-0"	NV	WD	ST	WIRE	HM	05/A-4001	04/A-4001	--	90/ST	4	A	--

01 FIRST FLOOR DOOR SCHEDULE
NTS


* MATCH EXISTING DOOR WIDTH
** SEE REVISED LOCATION IN PR-49.
1106 EXISTING RECEPT. 3'-0" 7'-0" NV WD ST WIRE HM 05/A-4001 04/A 9001 90/ST 23 A

DOOR SCHEDULE GENERAL NOTES


1. REFER TO A-8400 SERIES FOR THE GLAZING SCHEDULE.
2. REFER TO A-8300 SERIES FOR DOOR HEAD, JAMB AND SILL DETAILS.
3. REFER TO SPECIFICATIONS FOR DESCRIPTIONS OF THE HARDWARE SETS.
4. FILL FRAMES (HEAD AND JAMB) OF DOORS OVER 5'-0" WIDE WITH GROUT.
5. PROVIDE A PAIR OF 14 GAGE STUDS AT THE SIDE OF AND HEAD OF ALL DOORS (U.N.O.).
6. ALL DOORS IN SMOKE RESISTANT PARTITIONS TO HAVE POSITIVE LATCHING (U.N.O.).
7. CLOSERS ARE NOT REQUIRED ON PATIENT BEDROOM, LDR ROOM, POST PARTUM ROOM, ANTE PARTUM ROOM, AND CORRIDOR DOORS (U.N.O.).
8. FIRE-RATING GLAZING IN DOORS SHALL MATCH THE FIRE-RATING OF THE DOORS TO WHICH THEY ARE INSTALLED.
9. "SWING CLEAR" HINGES SHALL BE PROVIDED AT ALL PATIENT ROOM, EXAM ROOM, TREATMENT ROOM, OPERATING ROOM, AND PROCEDURE ROOM DOORS.
10. PROVIDE A" CLEAR TEMPERED GLAZING UNLESS REQUIRED OTHERWISE BY WALL TYPE.

DOOR TYPES
Scale: NTS

NOTE:
9" @ EACH SIDE OF DOOR W/A HOSPITAL LATCH OR PANIC HARDWARE.
9" @ EACH SIDE OF 4'-0" DOORS OR WIDER.
6" @ EACH SIDE OF ALL OTHER DOORS.

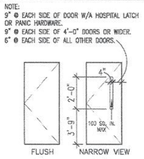

FRAME TYPES
Scale: NTS

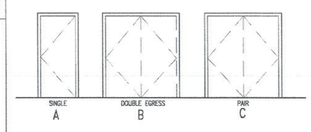

NOTES:
1. FILL FRAMES (HEAD AND JAMB) OF DOORS OVER 5'-0" WIDE WITH GROUT.

DOOR SCHEDULE REMARKS

1. PROVIDE WITH MAGNETIC HOLD OPEN
2. VIEW WINDOWS IN LARGER LEAF ONLY
3. REFER TO A-8500 SERIES FOR ELEVATION OF DOOR WITH A SIDELIGHT
4. AUTOMATIC CARD SWIPE DOOR
5. INTEGRAL BLINDS (CONTROLS ON INTERIOR ROOM SIDE ONLY)
6. DOOR SWINGS 180°
7. DOOR SWINGS BOTH WAYS
8. ISOLATION PATIENT ROOM REQUIRES A CLOSER
9. LEAD LINED DOOR
10. STOREFRONT SYSTEM
11. CURTAINWALL SYSTEM
12. POWER ASSISTED DOOR
13. BLINDS
14. 5-BUTTON COMBINATION LOCK
15. BUZZED ENTRY RE: ELECTRICAL
16. CALL BOX ENTRY RE: ELECTRICAL
17. UNEQUAL DOOR PAIR
18. ELEVATOR DOOR RE: VENDOR
19. COORDINATE HGT. W/EXIST. BRICK COURSING
20. TEMP. DOOR - TO BE REMOVED AFTER LAB CONSTRUCTION COMPLETION
21. RELOCATE EXISTING HARDWARE TO NEW DOOR
22. MATCH HARDWARE OF NOTE 2 (NO MAG)
23. MATCH EXISTING HARDWARE (RATED FORMAT)
- REFER TO MANUFACTURER

DOOR SCHEDULE LEGEND

WD – SOLID CORE WOOD WITH STAINED FINISH
PL – SOLID CORE WOOD WITH PLASTIC LAMINATE FINISH
HM – STEEL
ST – SMOKE TIGHT
ALUM – ANODIZED ALUMINUM
ALUM1 – CUSTOM ALUMINUM COLOR
FL – FIRELITE GLAZING

Approval not valid without 8½"x11" attached. (Door schedule #1062)

CITY OF AURORA
BUILDING DIVISION
APPROVED AS NOTED
DATE APPROVED MAR 26 2009

09 -384477

SPECIFICATION KEY NOTES

DIVISION 1 – GENERAL REQUIREMENTS
1.01 EXISTING STRUCTURE
1.02 DEMOLISH EXISTING
DIVISION 2 – SITE CONSTRUCTION
2.30 SELECT FILL ON PREPARED SUBGRADE
2.40 DRILLED CONCRETE PIERS (RE: STRUCTURAL)
2.60 FOUNDATION DRAINAGE SYSTEM
2.62 MOLDED SHEET DRAINAGE PANEL
2.63 FINISHED GRADE
2.63 CONCRETE SIDEWALK REF: CIVIL
DIVISION 3 – CONCRETE
3.10 PREMOLDED JOINT FILLER AND SEALANT
3.11 STEEL EMBED PLATE (RE: STRUCTURAL)
3.12 ANCHOR BOLT (RE: STRUCTURAL)
3.20 CONCRETE REINFORCING (RE: STRUCTURAL)
3.30 UNDER-SLAB SHEET VAPOR BARRIER
3.31 REINFORCED CONCRETE SLAB-ON-GRADE
3.32 CONCRETE GRADE BEAM (RE: STRUCTURAL)
3.50 LIGHTWEIGHT CONCRETE ROOF INSULATION SYSTEM
DIVISION 4 – MASONRY
4.10 EMBEDDED FLASHING – EXTEND UP WALL 8" MINIMUM
4.11 WEEPS @ 24" O.C. HORIZONTALLY (TYP.)
4.12 CONTINUOUS CAVITY DRAINAGE MATERIAL
4.13 ADJUSTABLE MASONRY VENEER ANCHORS @ 16" O.C. EACH WAY
4.14 MASONRY EXPANSION JOINT WITH COMPRESSIBLE FILLER RE: X\XXXX
4.15 HORIZONTAL JOINT REINFORCING @ 16" O.C. VERTICALLY
4.16 MASONRY CAVITY WALL INSULATION 1" THICK
4.17 GROUT-FILL CAVITY SOLID BELOW FLASHING
4.18 MASONRY WALL REINFORCING (RE: STRUCTURAL)
4.20 MODULAR FACE BRICK, RUNNING BOND
4.31 8" CONCRETE MASONRY UNIT
4.32 8" CONCRETE MASONRY UNIT
4.33 CMU BOND BEAM WITH REINFORCING AND GROUT (RE: STRUCTURAL)
4.50 SANDSTONE MASONRY VENEER 16"X24" NOMINAL
4.51 SANDSTONE SMOOTH MASONRY VENEER 8"X24" NOMINAL
4.60 MODULAR FACE BRICK, SOLDIER COURSE
4.62 CAST STONE COPING
DIVISION 5 – METALS
5.11 STEEL BEAM (RE: STRUCTURAL)
5.12 STEEL COLUMN (RE: STRUCTURAL)
5.13 STEEL ANGLE FRAMING (RE: STRUCTURAL)
5.14 CONTINUOUS STEEL POUR STOP (RE: STRUCTURAL)
5.17 STEEL CHANNEL (RE: STRUCTURAL)
5.18 SUSPENDED STEEL SHELF ANGLE (RE: STRUCTURAL) FIELD-PAINTED TO MATCH VENEER
5.30 COMPOSITE METAL DECK (RE: STRUCTURAL)
5.32 STEEL ROOF DECK (RE: STRUCTURAL)
5.40 3 5/8" METAL STUD
5.41 4" COLD FORMED METAL FRAMING
5.42 6" COLD-FORMED METAL FRAMING
5.43 C.F.M.F DEFLECTION TRACK RE: X\XXXX
5.50 GALVANIZED LOOSE STEEL LINTEL, FIELD-PAINTED TO MATCH VENEER
5.53 METAL EXHAUST LOUVER
DIVISION 6 – WOOD AND PLASTICS
6.12 FIRE RETARDANT-TREATED WOOD BLOCKING / NAILER
6.13 WOOD WINDOW SURROUND
6.60 SOLID SURFACING MATERIAL
DIVISION 7 – THERMAL AND MOISTURE PROTECTION
7.10 BITUMINOUS DAMPPROOFING
7.12 SELF-ADHERING FLEXIBLE FLASHING
7.16 FLUID-APPLIED WATERPROOFING
7.21 6" FIBERGLASS BATT INSULATION
7.22 3" FIBERGLASS BATT INSULATION
7.32 CONTINUOUS METAL DRIP EDGE
7.42 LOUVERED EQUIPMENT SCREEN
7.43 ALUMINUM COMPOSITE PANEL SYSTEM
7.51 TAPERED RIGID ROOF INSULATION
7.54 TPO SINGLE-PLY MEMBRANE ROOFING SYSTEM
7.56 ROOFING SYSTEM BASE FLASHING
7.62 STAINLESS STEEL FLASHING
7.63 2-PIECE METAL COUNTERFLASHING
7.64 CONTINUOUS METAL REGLET
7.65 ROOF EXPANSION JOINT FLASHING
7.66 CONTINUOUS METAL THROUGH-WALL FLASHING
7.70 PREFABRICATED METAL GRAVEL STOP
7.71 PREFABRICATED METAL COPING
7.72 CONTINUOUS METAL CLEAT ANCHORED AT 24" O.C.
7.73 PREFABRICATED METAL FASCIA
7.75 PREFABRICATED METAL GUTTER
7.76 PREFABRICATED METAL DOWNSPOUT
7.80 SPRAYED FIRE-RESISTIVE MATERIAL
7.88 SEMI-RIGID JAMB AND HEAD FLASHING
7.91 CONTINUOUS SEALANT
7.92 CONTINUOUS BACKER ROD AND SEALANT
7.93 PREFORMED PRECOMPRESSED FOAM SEALANT
7.94 FIRE SAFING
DIVISION 8 – DOORS AND WINDOWS
8.10 DOOR AND FRAME, COORDINATE W/FINISH NOTES
8.41 ALUMINUM STOREFRONT SYSTEM
8.42 BREAK-METAL CLOSURE TO MATCH ALUMINUM
8.43 SLIDING AUTOMATIC ENTRANCE DOOR
8.51 FIXED ALUMINUM WINDOW WITH INTEGRAL BLINDS
8.53 WINDOW SUPPORT ANGLE (BY WINDOW MFR.)
8.54 ALUMINUM SILL PAN FLASHING W/ END DAMS
8.81 SKYLIGHT ASSEMBLY
8.81 SPANDREL GLASS
8.90 GLAZED ALUMINUM CURTAIN WALL
8.92 CURTAIN WALL ANCHOR (BY CURTAIN WALL MFR.)
DIVISION 9 – FINISHES
9.10 18 GA. GALV. STRAP
9.11 7/8" HAT CHANNELS AT 16" O.C.
9.13 RIGID METAL ROD HANGERS AT 48" O.C. MAX
9.14 2 1/2" METAL STUDS AT 16" O.C.
9.15 3 5/8" METAL STUDS AT 16" O.C.
9.18 2 1/2" C-H SHAFT WALL STUDS
9.19 6" C-H SHAFT WALL STUDS
9.20 5/8" CYPSUM BOARD
9.21 1/2" EXTERIOR SHEATHING
9.23 3-COAT (7/8") PORTLAND CEMENT PLASTER
9.24 CONTINUOUS METAL 'J' MOLDING WITH WEEPS
9.25 CONTINUOUS METAL SOFFIT VENT
9.26 "J" MOLD
9.39 FINISH FLOORING AS SCHEDULED
9.39 BASE AS SCHEDULED
9.50 CEILING AS SCHEDULED
9.51 SOLAR SHADE
9.91 ELASTOMERIC COATING

PERKINS & WILL
10100 North Central Expressway, Suite 300
Dallas, Texas 75231, USA
214.283.8700 Fax: 214.283.8701
www.perkinswill.com

Medical Center of Aurora
South Campus
Private Room Expansion
Aurora, Colorado

HCA
Project # 306660001

in association with:
Civil
Martin Martin, Inc.
4251 Kipling Street
Wheat Ridge, CO 80033
T: 303.431.6100
F: 303.431.4028
Structrue
TRC International, Ltd.
5050 QUARUM DRIVE, SUITE 700
Dallas, TX 75254
T: 214.722.6452
F: 214.722.6552
MEP
CCRD Partners
3625 N. HALL STREET
SUITE 1300, LB 139
DALLAS, TX-75219
T: 214.521.1661
F: 214.521.1664
LANDSCAPE
Davis Partnership
2310 BLAKE STREET, SUITE 100
DENVER, CO 80205
T: 303.861.8555
F: 303.861.3027

AUGUST 24 2006
EARLY RELEASE PKG. #2
ADDENDUM #2
ISSUED FOR CONSTRUCTION

2.24.07
TRUDY L. [illegible]
203601
LICENSED ARCHITECT
9.15.06

Revisions

NO.	ISSUE	DATE
4	FIELD MEMO – 02-10-09	
3	ADDENDUM #3	09/15/06
2	ADDENDUM #1	08/08/06

Sheet Information


Date	07-13-2006
Job Number	142228.000
Drawn	LTS
Checked	DcE
Approved	CG

Title
DOOR SCHEDULE ELEVATIONS & DETAILS

Sheet
A-4001
Issued for Construction

Copyright © 2005 PERKINS & WILL

Sep 15, 2006 – 10:42am
P:\142228 Med Ctr of Aurora – Bed Tower Expan\CAD\EPSP\A-4001.dwg
kmobit

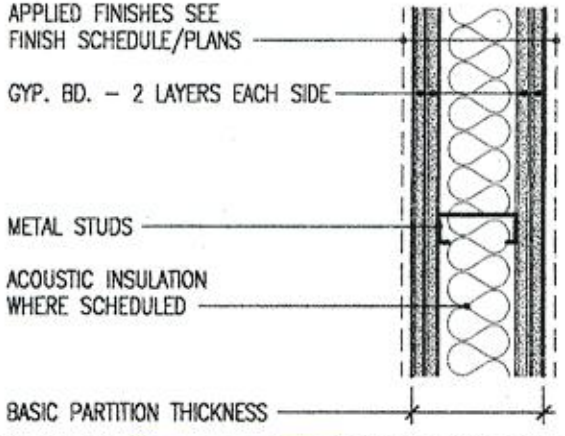


NOTES:
* SEE DETAILS FOR BRACING OF PARTITIONS TYPES C_3 & C_4

STUDS TO STRUCTURE ABOVE (SEE DETAILS)	2 HR. RATED WITH GYP. BD. TO STRUCTURE ABOVE	C10	C20	C30	C40	C50	C60	C70	C80
	NON RATED WITH GYP. BD. TO STRUCTURE ABOVE	C11	C21	C31	C41	C51	C61	C71	C81
	NON RATED WITH GYP. BD. TO 6" ABOVE CEILING	C12	C22	C32	C42	C52	C62	C72	C82
NON RATED WITH STUDS & GYP. BD. TO FINISHED CEILING (SEE DETAILS) *		C13	C23	C33	C43	C53	C63	C73	C83
NON RATED PARTIAL HEIGHT PARTITION WITH GYP.BD. TO X'-0" AFF (SEE DETAIL) *		C14	C24	C34	C44	C54	C64	C74	C84
STUD SIZE		2 1/2"	2 1/2"	3 5/8"	3 5/8"	4"	4"	6"	6"
GYP. BD. THICKNESS		5/8"	5/8"	5/8"	5/8"	5/8"	5/8"	5/8"	5/8"
BASIC PARTITION THICKNESS		5"	5"	6 1/8"	6 1/8"	6 1/2"	6 1/2"	8 1/2"	8 1/2"
ACOUSTICAL INSULATION		NO	YES	NO	YES	NO	YES	NO	YES
ACOUSTICAL RATING (STC)		48	56	48	56	48	56	48	56
ACOUSTICAL TEST NUMBER		SIM. BBN 770408	SIM. USG 840818	SIM. BBN 770408	SIM. USG 840818	SIM. BBN 770408	SIM. USG 840818	SIM. BBN 770408	SIM. USG 840818
FIRE TEST NUMBER (WHERE APPLICABLE)		UL DES U411	UL DES U411	UL DES U411	UL DES U411	UL DES U411	UL DES U411	UL DES U411	UL DES U411
REMARKS									

A

d Ctr of Aurora – Bed Tower Expan\CAD\SHEETS\A-B100.dwg


09 -384477

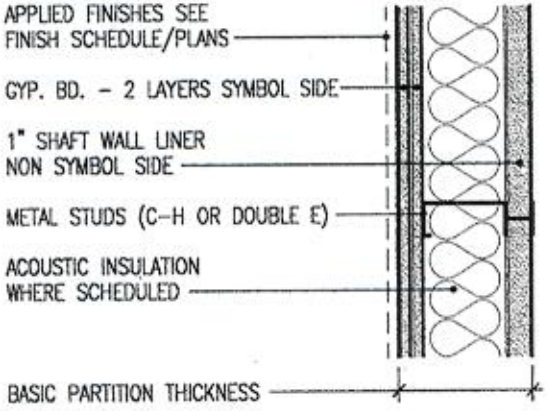

NOTES:
* THESE PARTITION TYPES ARE GENERALLY NOT USED

		K10	K20	K30	K40	K50	K60	K70	K80
STUDS TO STRUCTURE ABOVE (SEE DETAILS)	2 HR. RATED WITH GYP. BD. TO STRUCTURE ABOVE								
	NON RATED WITH GYP. BD. TO STRUCTURE ABOVE								
	NON RATED WITH GYP. BD. TO 6" ABOVE CEILING								
NON RATED WITH STUDS & GYP. BD. TO FINISHED CEILING (SEE DETAILS) *									
NON RATED PARTIAL HEIGHT PARTITION WITH GYP.BD. TO X'-0" AFF (SEE DETAIL) *									
STUD SIZE ("C-H" OR DOUBLE "E")		2 1/2"	2 1/2"	4"	4"	6" (C-H)	6" (C-H)	6 (2xE)	6" (2xE)
GYP. BD. THICKNESS		5/8"	5/8"	5/8"	5/8"	5/8"	5/8"	5/8"	5/8"
BASIC PARTITION THICKNESS		3 3/4"	3 3/4"	5 1/4"	5 1/4"	7 1/4"	7 1/4"	7 1/4"	7 1/4"
ACOUSTICAL INSULATION		NO	YES	NO	YES	NO	YES	NO	YES
ACOUSTICAL RATING (STC)		39	47	39	47	39	47	39	47
ACOUSTICAL TEST NUMBER		SIM. USG 750302	SIM. USG 750706	SIM. USG 750302	SIM. USG 750706	SIM. USG 750302	SIM. USG 750706	SIM. USG 750302	SIM. USG 750706
FIRE TEST NUMBER (WHERE APPLICABLE)		UL DES U438	UL DES U438	UL DES U438 SIM.	UL DES U438 SIM.	UL DES U438 SIM.	UL DES U438 SIM.	UL DES U438 SIM.	UL DES U438 SIM.
REMARKS									

09 -384477

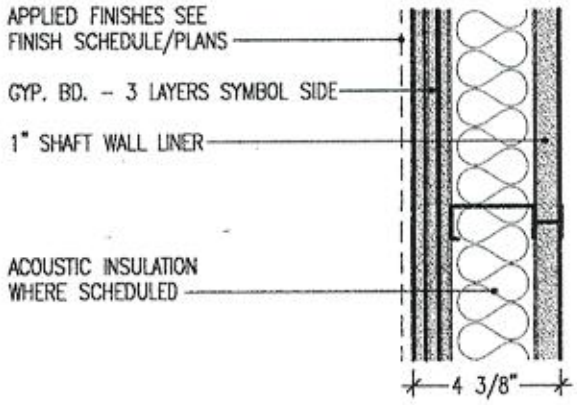

	J70	J80
	6 (2xE)	6" (2xE)
	5/8"	5/8"
	6 5/8"	6 5/8"
	NO	YES
	–	–
	–	–
	UL DES U469 SIM.	UL DES U469 SIM.

		P10	P20
STUDS TO STRUCTURE ABOVE (SEE DETAILS)	3 HR. RATED WITH GYP. BD. TO STRUCTURE ABOVE		
	NON RATED WITH GYP. BD. TO STRUCTURE ABOVE		
	NON RATED WITH GYP. BD. TO 6" ABOVE CEILING		
NON RATED WITH STUDS & GYP. BD. TO FINISHED CEILING (SEE DETAILS) *			
NON RATED PARTIAL HEIGHT PARTITION WITH GYP.BD. TO X'-0" AFF (SEE DETAIL) *			
STUD SIZE ('C-H')		2 1/2"	2 1/2"
GYP. BD. THICKNESS		5/8"	5/8"
BASIC PARTITION THICKNESS		4 3/8"	4 3/8"
ACOUSTICAL INSULATION		NO	YES
ACOUSTICAL RATING (STC)		45	51
ACOUSTICAL TEST NUMBER		–	–
FIRE TEST NUMBER (WHERE APPLICABLE)		UL DES U415 SYSTEM G	UL DES U415 SYSTEM G
REMARKS			

09 -384477

D

PERKINS & WILL

10100 North Central Expressway, Suite 300
Dallas, Texas 75231, USA
214.283.8700 Fax: 214.283.8701
www.perkinswill.com

Medical Center of Aurora

South Campus Private Room Expansion

Aurora, Colorado

HCA

Project # 306660001

In association with:

Civil


Martin Martin, Inc.
4251 Kipling Street
Wheat Ridge, CO 80033
T: 303.431.6100
F: 303.431.4028


Structrual


TRC International, Ltd.
5050 QUARUM DRIVE, SUITE 700
Dallas, TX 75254
T: 214.722.6452
F: 214.722.6552

MEP


CCRD Partners

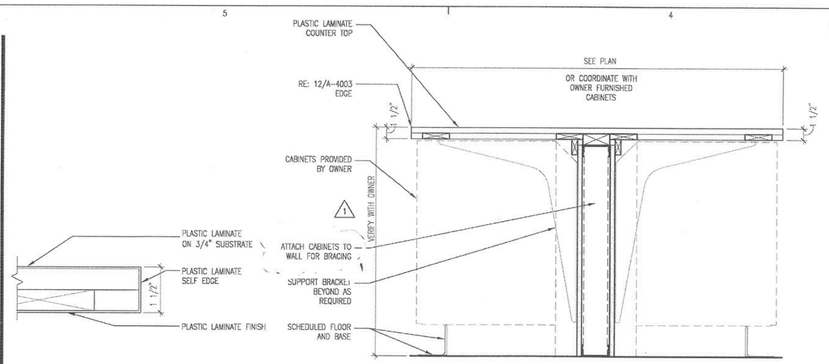

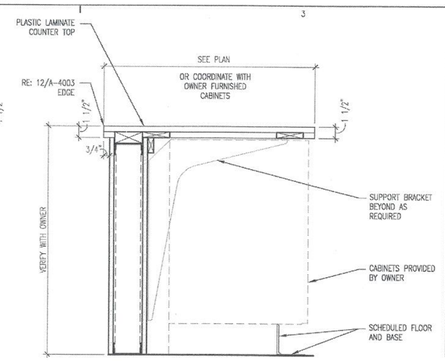


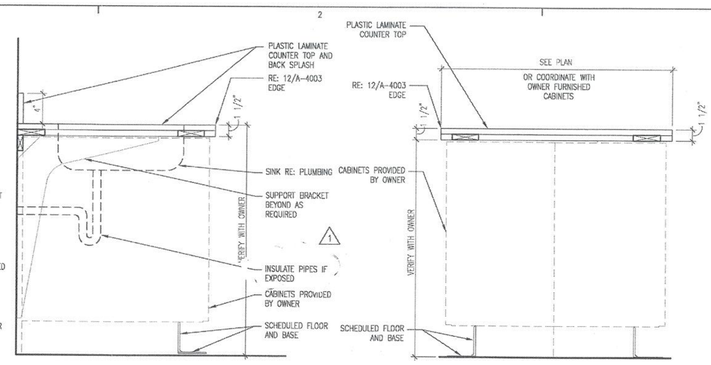


12 SECTION DETAIL
1 1/2" = 1'-0"

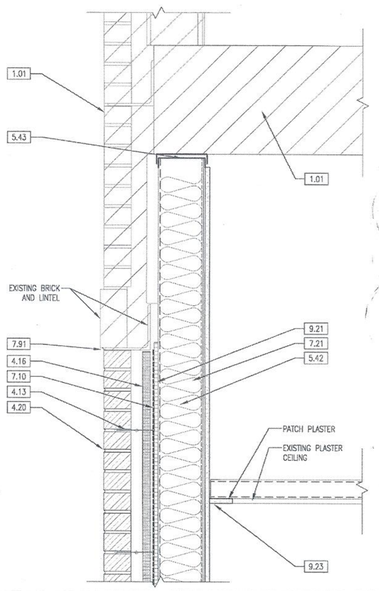

11 SECTION DETAIL
1 1/2" = 1'-0"

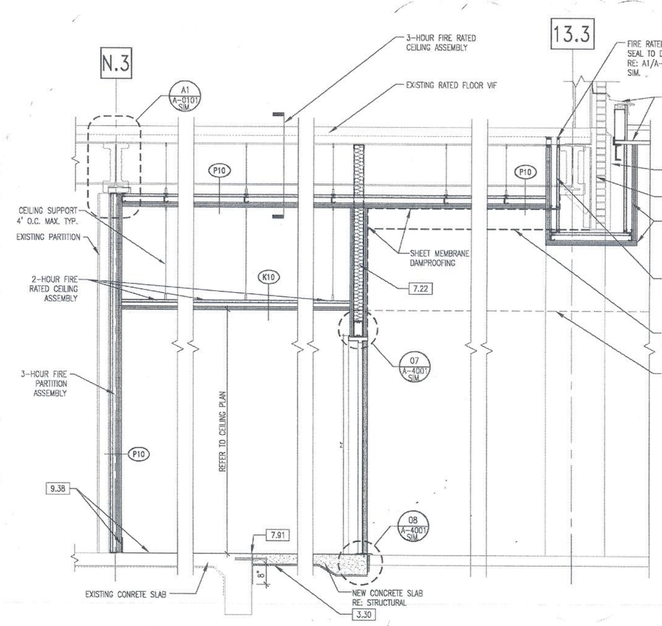


10 SECTION DETAIL
1 1/2" = 1'-0"

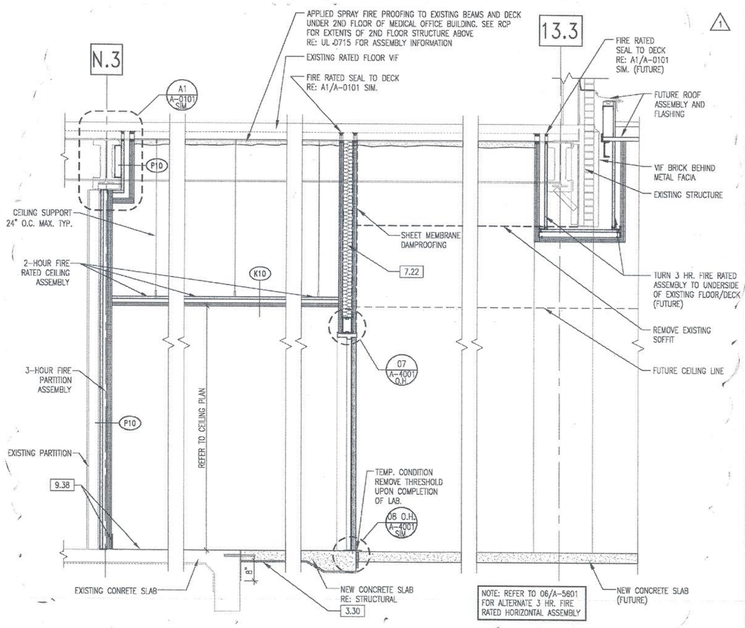


09 SECTION DETAIL
1 1/2" = 1'-0"

08 SECTION DETAIL
1 1/2" = 1'-0"

07 SECTION DETAIL
1 1/2" = 1'-0"

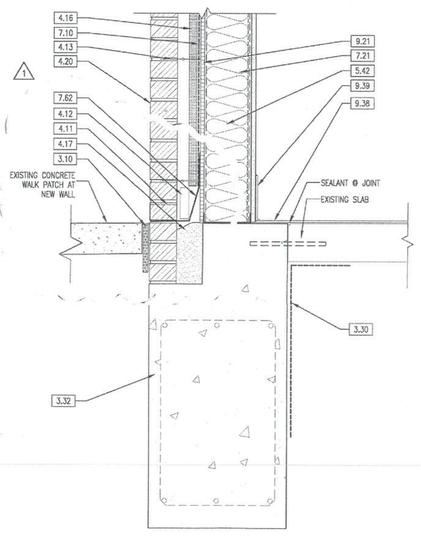


04 SECTION DETAIL
1 1/2" = 1'-0"

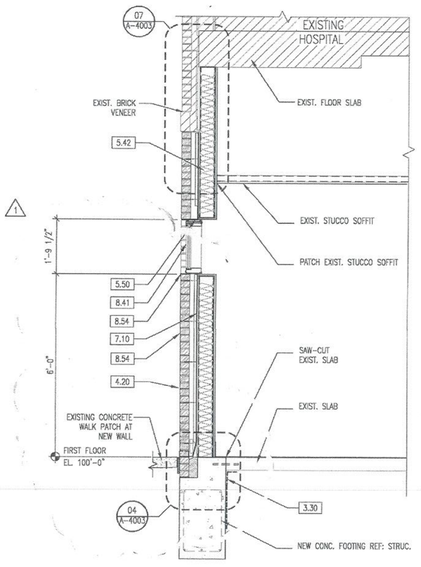

03 SECTION DETAIL
1/2" = 1'-0"

06 SECTION DETAIL – ALTERNATE
1/2" = 1'-0"

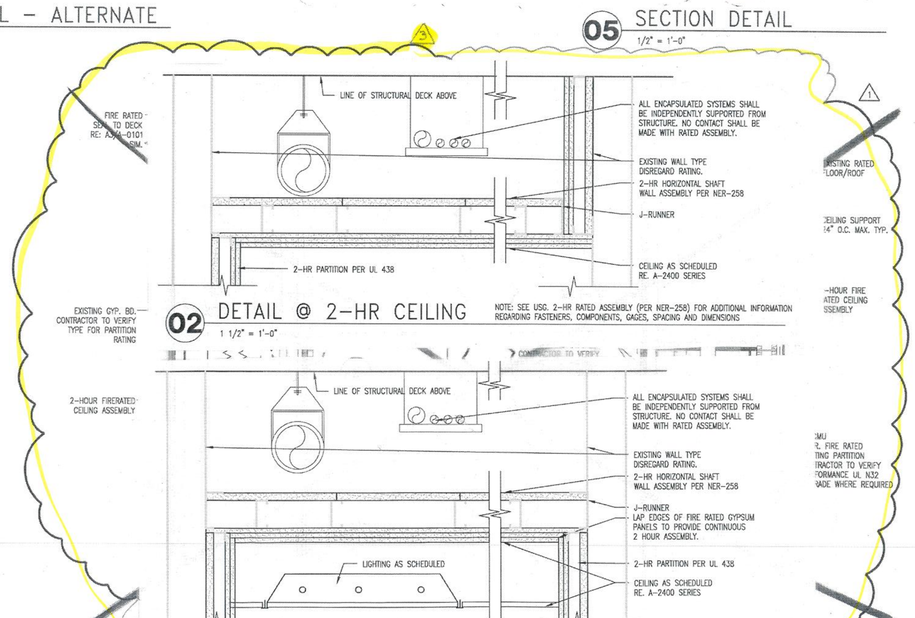

05 SECTION DETAIL
1/2" = 1'-0"

SPECIFICATION KEY NOTES

DIVISION 1 – GENERAL REQUIREMENTS
- 1.01 EXISTING STRUCTURE
- 1.02 DEMOLISH EXISTING

DIVISION 2 – SITE CONSTRUCTION
- 2.30 SELECT FILL ON PREPARED SUBGRADE
- 2.40 DRILLED CONCRETE PIERS (RE: STRUCTURAL)
- 2.60 FOUNDATION DRAINAGE SYSTEM
- 2.62 MOLDED SHEET DRAINAGE PANEL
- 2.63 FINISHED GRADE
- 2.63 CONCRETE SIDEWALK REF: CIVIL

DIVISION 3 – CONCRETE
- 3.10 PREMOLDED JOINT FILLER AND SEALANT
- 3.11 STEEL EMBED PLATE (RE: STRUCTURAL)
- 3.12 ANCHOR BOLT (RE: STRUCTURAL)
- 3.20 CONCRETE REINFORCING (RE: STRUCTURAL)
- 3.30 UNDER-SLAB SHEET VAPOR BARRIER
- 3.31 REINFORCED CONCRETE SLAB-ON-GRADE
- 3.32 CONCRETE GRADE BEAM (RE: STRUCTURAL)
- 3.50 LIGHTWEIGHT CONCRETE ROOF INSULATION SYSTEM

DIVISION 4 – MASONRY
- 4.10 EMBEDDED FLASHING – EXTEND UP WALL 8" MINIMUM
- 4.11 WEEPS @ 24" O.C. HORIZONTALLY (TYP.)
- 4.12 CONTINUOUS CAVITY DRAINAGE MATERIAL
- 4.13 ADJUSTABLE MASONRY VENEER ANCHORS @ 16" O.C. EACH WAY
- 4.14 MASONRY EXPANSION JOINT WITH COMPRESSIBLE FILLER RE: X'.XXXX
- 4.15 HORIZONTAL JOINT REINFORCING @ 16" O.C. VERTICALLY
- 4.16 MASONRY CAVITY WALL INSULATION 1" THICK
- 4.17 GROUT-FILL CAVITY SOLID BELOW FLASHING
- 4.18 MASONRY WALL REINFORCING (RE: STRUCTURAL)
- 4.20 MODULAR FACE BRICK, RUNNING BOND
- 4.31 6" CONCRETE MASONRY UNIT
- 4.32 8" CONCRETE MASONRY UNIT
- 4.33 CMU BOND BEAM WITH REINFORCING AND GROUT (RE: STRUCTURAL)
- 4.50 SANDSTONE MASONRY VENEER 16"X24" NOMINAL
- 4.51 SANDSTONE SMOOTH MASONRY VENEER 8"X24" NOMINAL
- 4.60 MODULAR FACE BRICK, SOLDIER COURSE
- 4.62 CAST STONE COPING

DIVISION 5 – METALS
- 5.11 STEEL BEAM (RE: STRUCTURAL)
- 5.12 STEEL COLUMN (RE: STRUCTURAL)
- 5.13 STEEL ANGLE FRAMING (RE: STRUCTURAL)
- 5.14 CONTINUOUS STEEL POUR STOP (RE: STRUCTURAL)
- 5.17 STEEL CHANNEL (RE: STRUCTURAL)
- 5.18 SUSPENDED STEEL SHELF ANGLE (RE: STRUCTURAL) FIELD-PAINTED TO MATCH VENEER
- 5.30 COMPOSITE METAL DECK (RE: STRUCTURAL)
- 5.32 STEEL ROOF DECK (RE: STRUCTURAL)
- 5.40 3 5/8" METAL STUD
- 5.41 4" COLD FORMED METAL FRAMING
- 5.42 6" COLD-FORMED METAL FRAMING
- 5.43 C.F.M.F DEFLECTION TRACK RE: X'.XXXX
- 5.50 GALVANIZED LOOSE STEEL LINTEL, FIELD-PAINTED TO MATCH VENEER
- 5.53 METAL EXHAUST LOUVER

DIVISION 6 – WOOD AND PLASTICS
- 6.12 FIRE RETARDANT-TREATED WOOD BLOCKING / NAILER
- 6.13 WOOD WINDOW SURROUND
- 6.60 SOLID SURFACING MATERIAL

DIVISION 7 – THERMAL AND MOISTURE PROTECTION
- 7.10 BITUMINOUS DAMPPROOFING
- 7.12 SELF-ADHERING FLEXIBLE FLASHING
- 7.16 FLUID-APPLIED WATERPROOFING
- 7.21 6" FIBERGLASS BATT INSULATION
- 7.22 3" FIBERGLASS BATT INSULATION
- 7.37 CONTINUOUS METAL DRIP EDGE
- 7.42 LOUVERED EQUIPMENT SCREEN
- 7.43 ALUMINUM COMPOSITE PANEL SYSTEM
- 7.51 TAPERED RIGID ROOF INSULATION
- 7.54 TPO SINGLE-PLY MEMBRANE ROOFING SYSTEM
- 7.55 ROOFING SYSTEM BASE FLASHING
- 7.62 STAINLESS STEEL FLASHING
- 7.63 2-PIECE METAL COUNTERFLASHING
- 7.64 CONTINUOUS METAL REGLET
- 7.65 ROOF EXPANSION JOINT FLASHING
- 7.66 CONTINUOUS METAL THROUGH-WALL FLASHING
- 7.70 PREFABRICATED METAL GRAVEL STOP
- 7.71 PREFABRICATED METAL COPING
- 7.72 CONTINUOUS METAL CLEAT ANCHORED AT 24" O.C.
- 7.73 PREFABRICATED METAL FASCIA
- 7.75 PREFABRICATED METAL GUTTER
- 7.76 PREFABRICATED METAL DOWNSPOUT
- 7.80 SPRAYED FIRE-RESISTIVE MATERIAL
- 7.88 SEMI-RIGID JAMB AND HEAD FLASHING
- 7.91 CONTINUOUS SEALANT
- 7.92 CONTINUOUS BACKER ROD AND SEALANT
- 7.93 PREFORMED PRECOMPRESSED FOAM SEALANT
- 7.94 FIRE SAFING

DIVISION 8 – DOORS AND WINDOWS
- 8.10 DOOR AND FRAME, COORDINATE W/FINISH NOTES
- 8.41 ALUMINUM STOREFRONT SYSTEM
- 8.42 BREAK-METAL CLOSURE TO MATCH ALUMINUM
- 8.43 SLIDING AUTOMATIC ENTRANCE DOOR
- 8.51 FIXED ALUMINUM WINDOW WITH INTEGRAL BLINDS
- 8.53 WINDOW SUPPORT ANGLE (BY WINDOW MFR.)
- 8.54 ALUMINUM SILL PAN FLASHING W/ END DAMS
- 8.61 SKYLIGHT ASSEMBLY
- 8.81 SPANDREL GLASS
- 8.90 GLAZED ALUMINUM CURTAIN WALL
- 8.92 CURTAIN WALL ANCHOR (BY CURTAIN WALL MFR.)

DIVISION 9 – FINISHES
- 9.10 16 GA. GALV. STRAP
- 9.11 7/8" HAT CHANNELS AT 16" O.C.
- 9.12 RIGID METAL ROD HANGERS AT 48" O.C. MAX
- 9.14 2 1/2" METAL STUDS AT 16" O.C.
- 9.15 3 5/8" METAL STUDS AT 16" O.C.
- 9.18 2 1/2" C-H SHAFT WALL STUDS
- 9.19 4" C-H SHAFT WALL STUDS
- 9.20 5/8" GYPSUM BOARD
- 9.21 1/2" EXTERIOR SHEATHING
- 9.23 3-COAT (7/8") PORTLAND CEMENT PLASTER
- 9.24 CONTINUOUS METAL "J" MOLDING WITH WEEPS
- 9.25 CONTINUOUS METAL SOFFIT VENT
- 9.26 "J" MOLD
- 9.35 FINISH FLOORING AS SCHEDULED
- 9.35 BASE AS SCHEDULED
- 9.50 CEILING AS SCHEDULED
- 9.51 SOLAR SHADE
- 9.91 ELASTOMERIC COATING

CITY OF AURORA
BUILDING DIVISION
APPROVED AS NOTED
DATE APPROVED MAR 2 0 2009

09 -384477

Approval Not valid without (3) 36"x11" sheets wall Details P10, C30, K10

PERKINS & WILL
10100 North Central Expressway, Suite 300
Dallas, Texas 75231, USA
214.283.8700 Fax: 214.283.8701
www.perkinswill.com

Medical Center of Aurora
South Campus
Private Room Expansion
Aurora, Colorado

HCA
Project # 306660001

In association with:

Civil
Martin Martin, Inc.
4251 Kipling Street
Wheat Ridge, CO 80033
T: 303.431.6100
F: 303.431.4028

Structrual
TRC International, Ltd.
5050 QUARUM DRIVE, SUITE 700
Dallas, TX 75254
T: 214.722.6452
F: 214.722.6552

MEP
CCRD Partners
3625 N. HALL STREET
SUITE 1300, LB 139
DALLAS, TX-75219
T: 214.521.1681
F: 214.521.1664

LANDSCAPE
Davis Partnership
2310 BLAKE STREET, SUITE 100
DENVER, CO 80205
T: 303.861.8555
F: 303.861.3027

AUGUST 08
EARLY RELEASE PKG. #2
ADDENDUM #1
ISSUED FOR CONSTRUCTION

8.24.09
JEFFREY L. TAUBY
203601
LICENSED ARCHITECT
8.8.08

Revisions

NO.	ISSUE	DATE
2	FIELD MEMO – 02-10-09	
1	ASI-001	01/30/07
1	ADDENDUM #1	08/08/06

Sheet Information

Date	07-13-2006
Job Number	142228.000
Drawn	XX
Checked	DcE
Approved	CG

Title

MISCELLANEOUS DETAILS


Sheet

A-4003

Issued for Construction


Copyright © 2005 PERKINS & WILL

Aug 08, 2006 - 9:12am
P:\142228 Med Ctr of Aurora – Bed Tower Expan\CAD\ARF#21\A-4003.dwg
kknoell

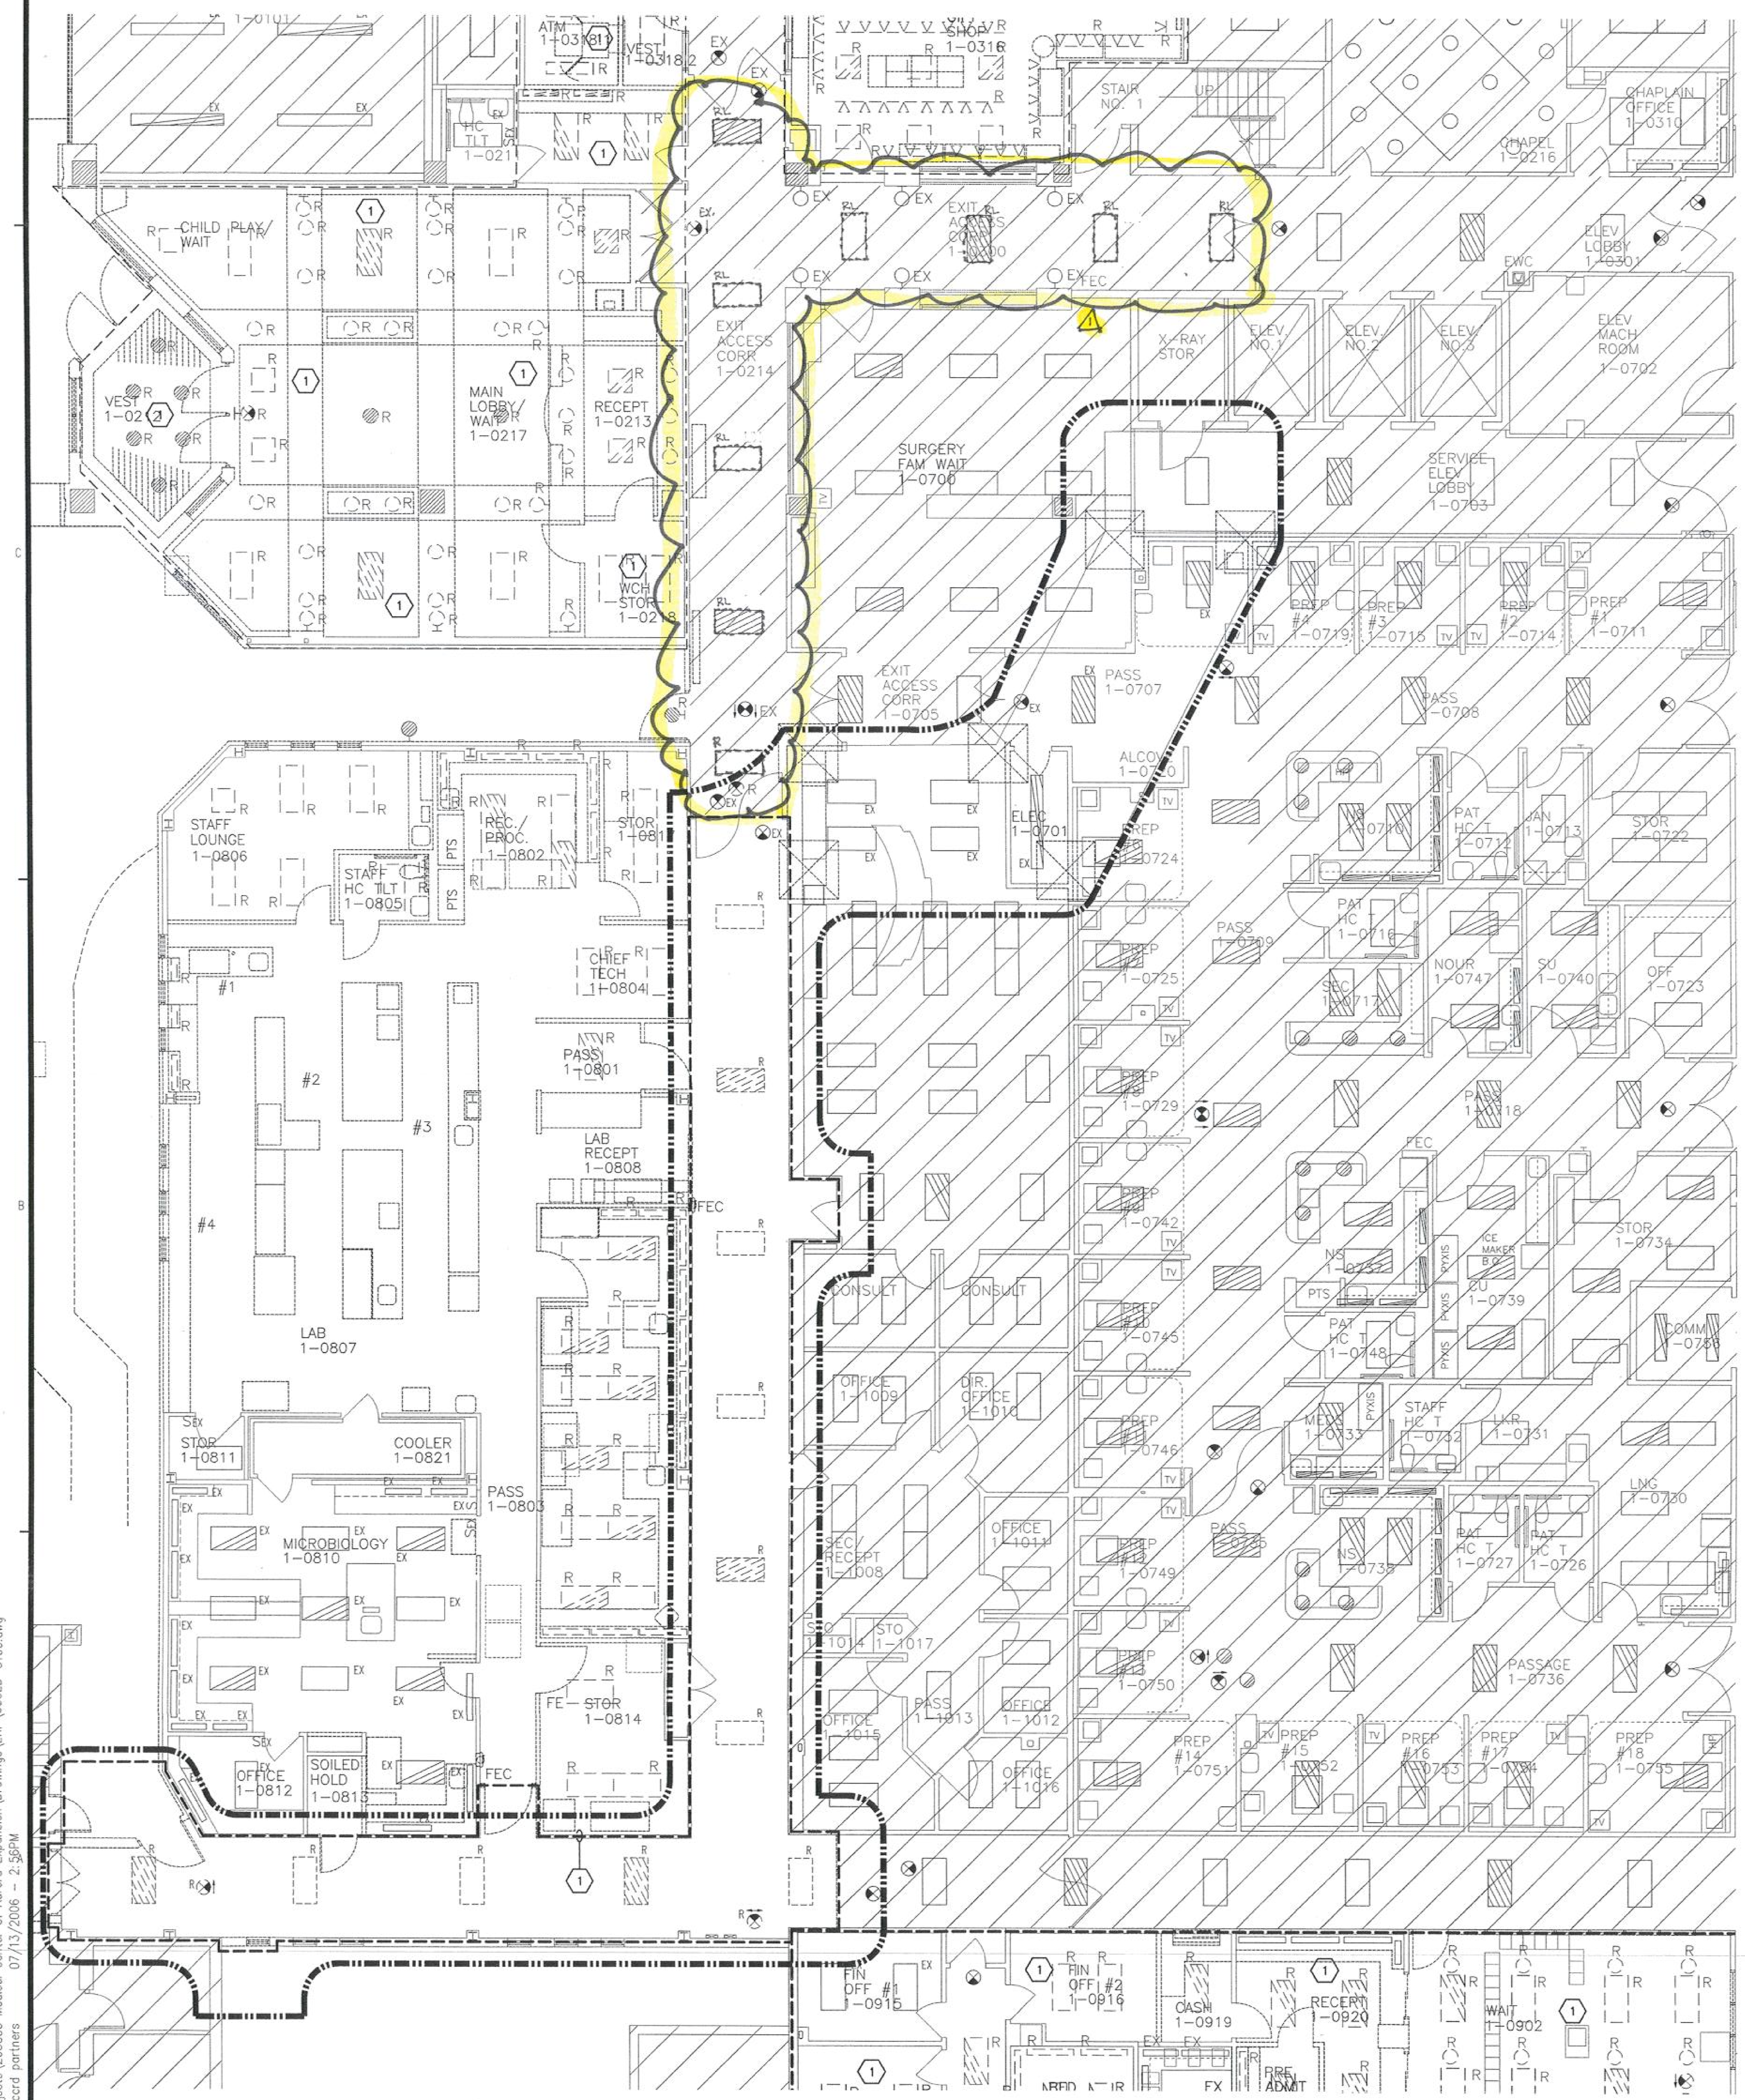


01 LIGHTING - FIRST FLOOR DEMO - EXIT CORRIDOR 'A'
SCALE: 1/8" = 1'-0"

02 NOT USED
SCALE: 1/8" = 1'-0"

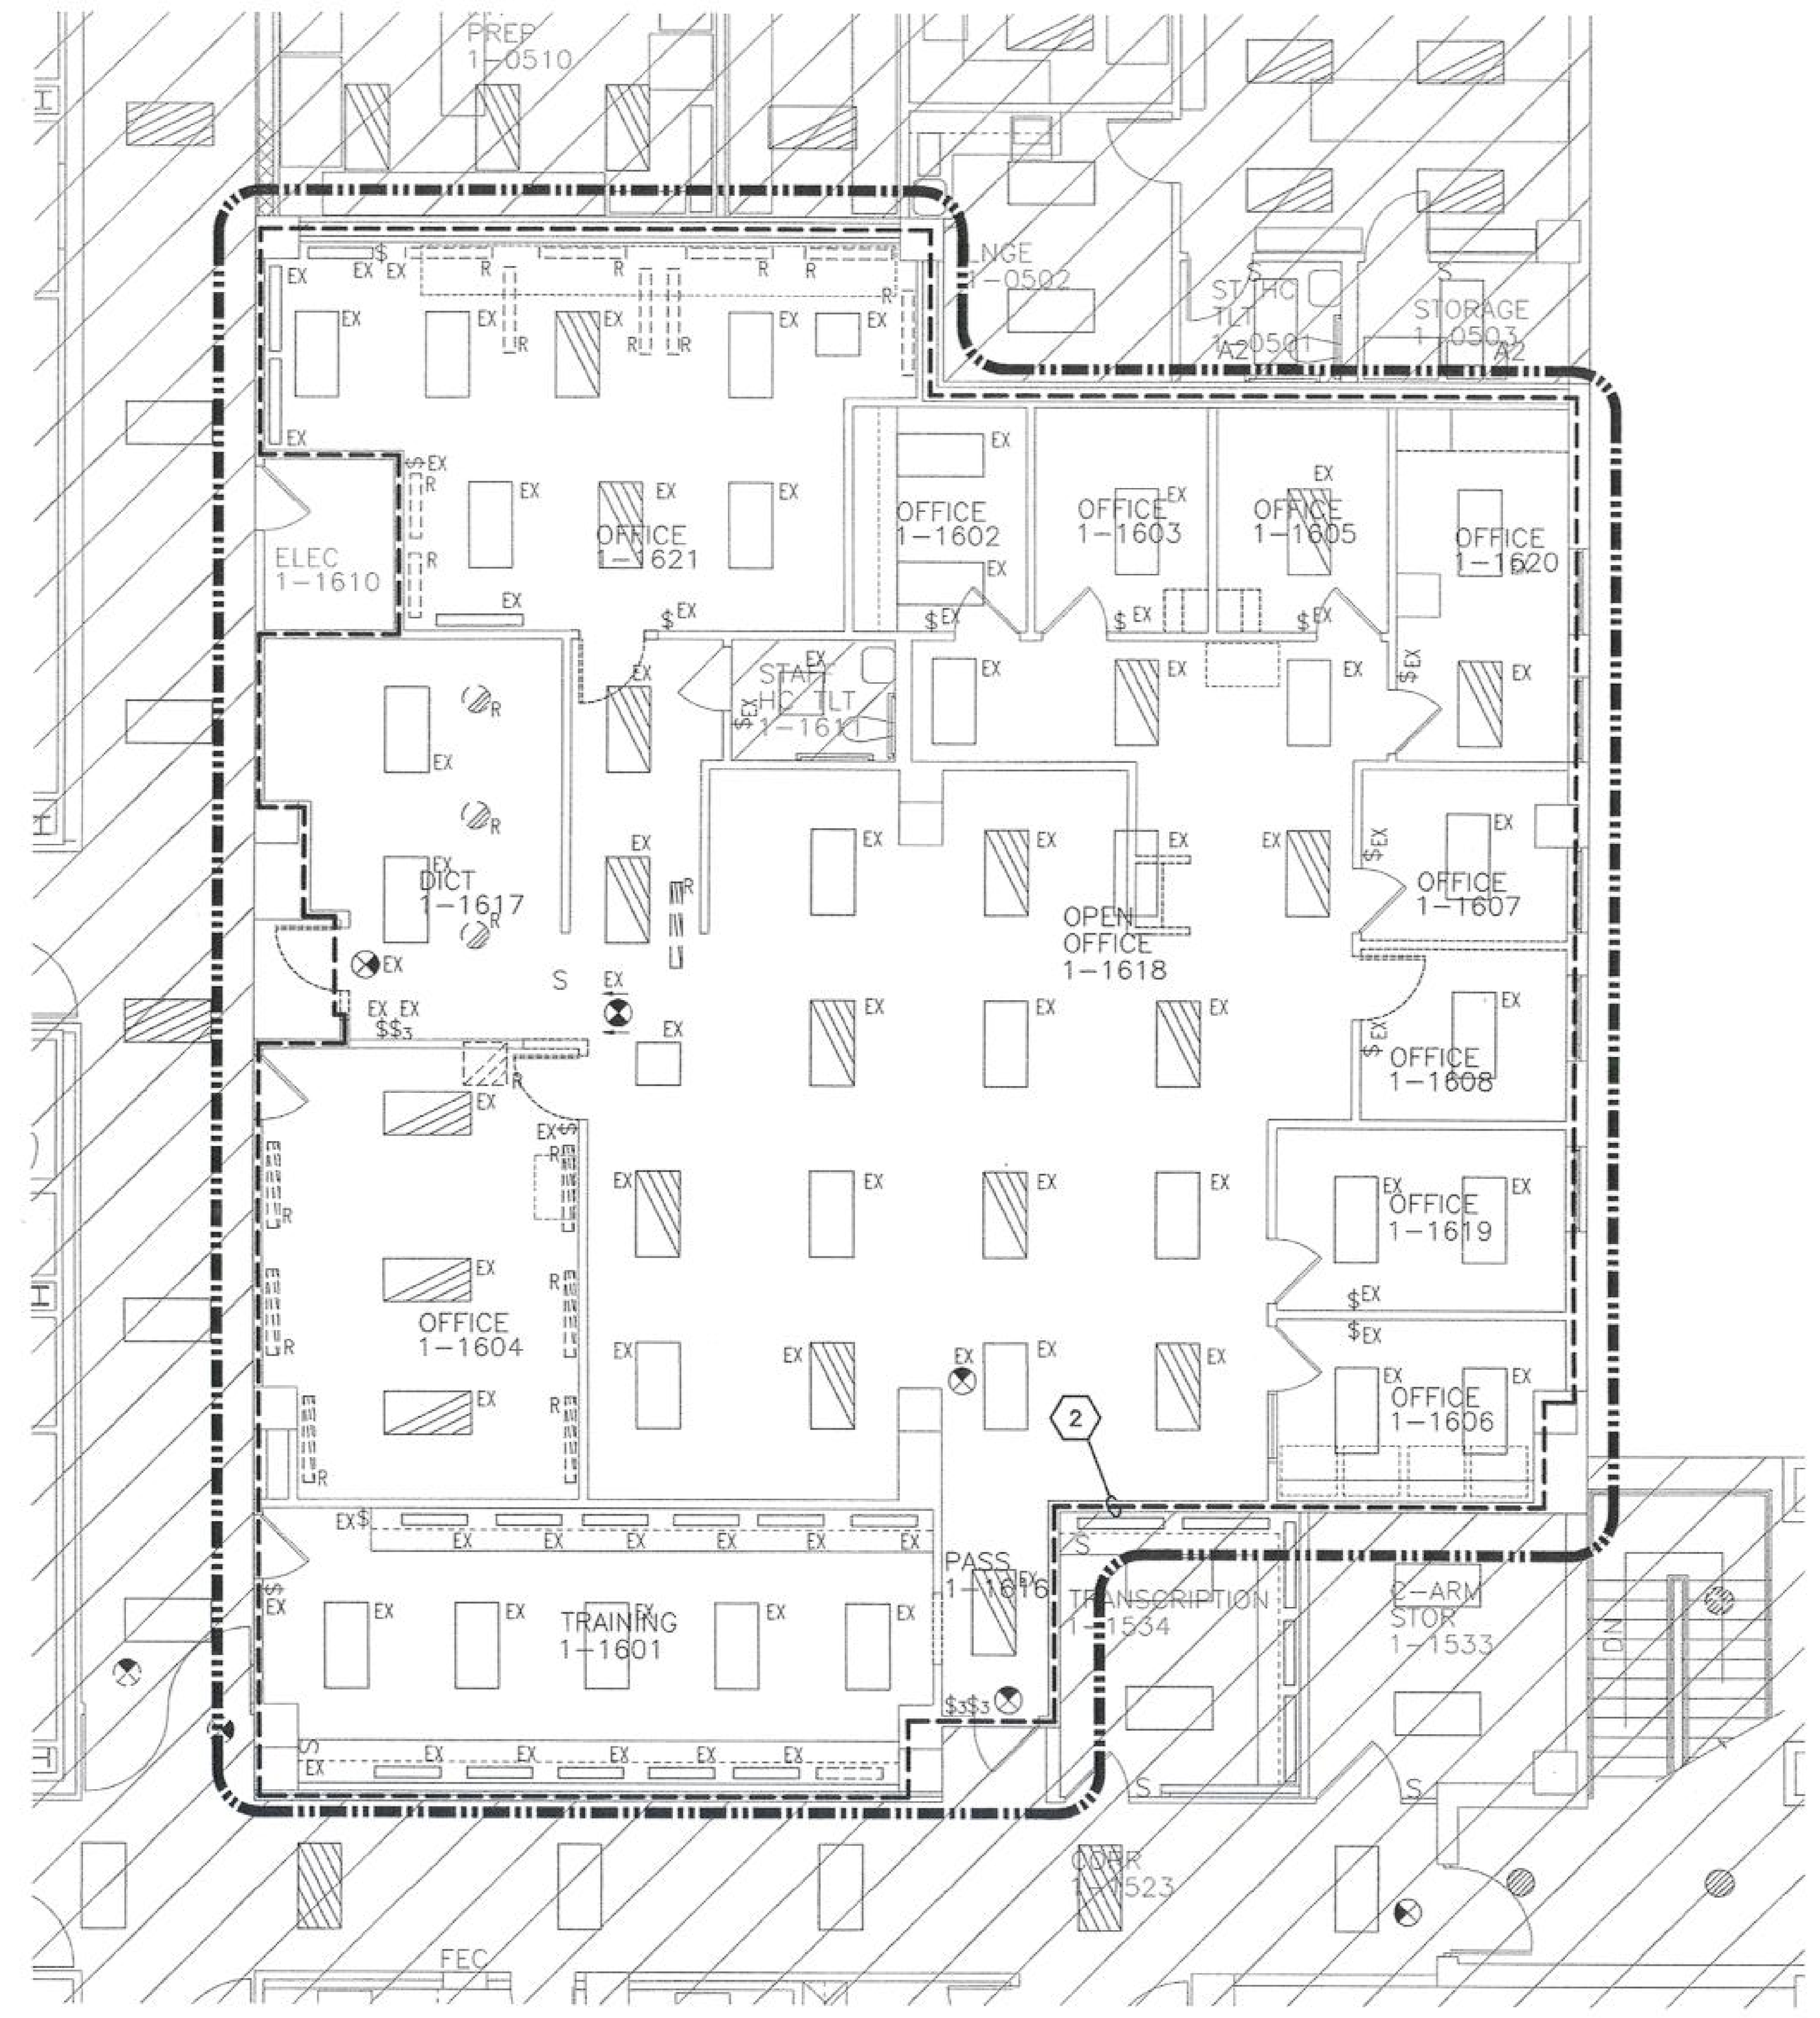

04 LIGHTING - FIRST FLOOR DEMO - TEMP LAB
SCALE: 1/8" = 1'-0"

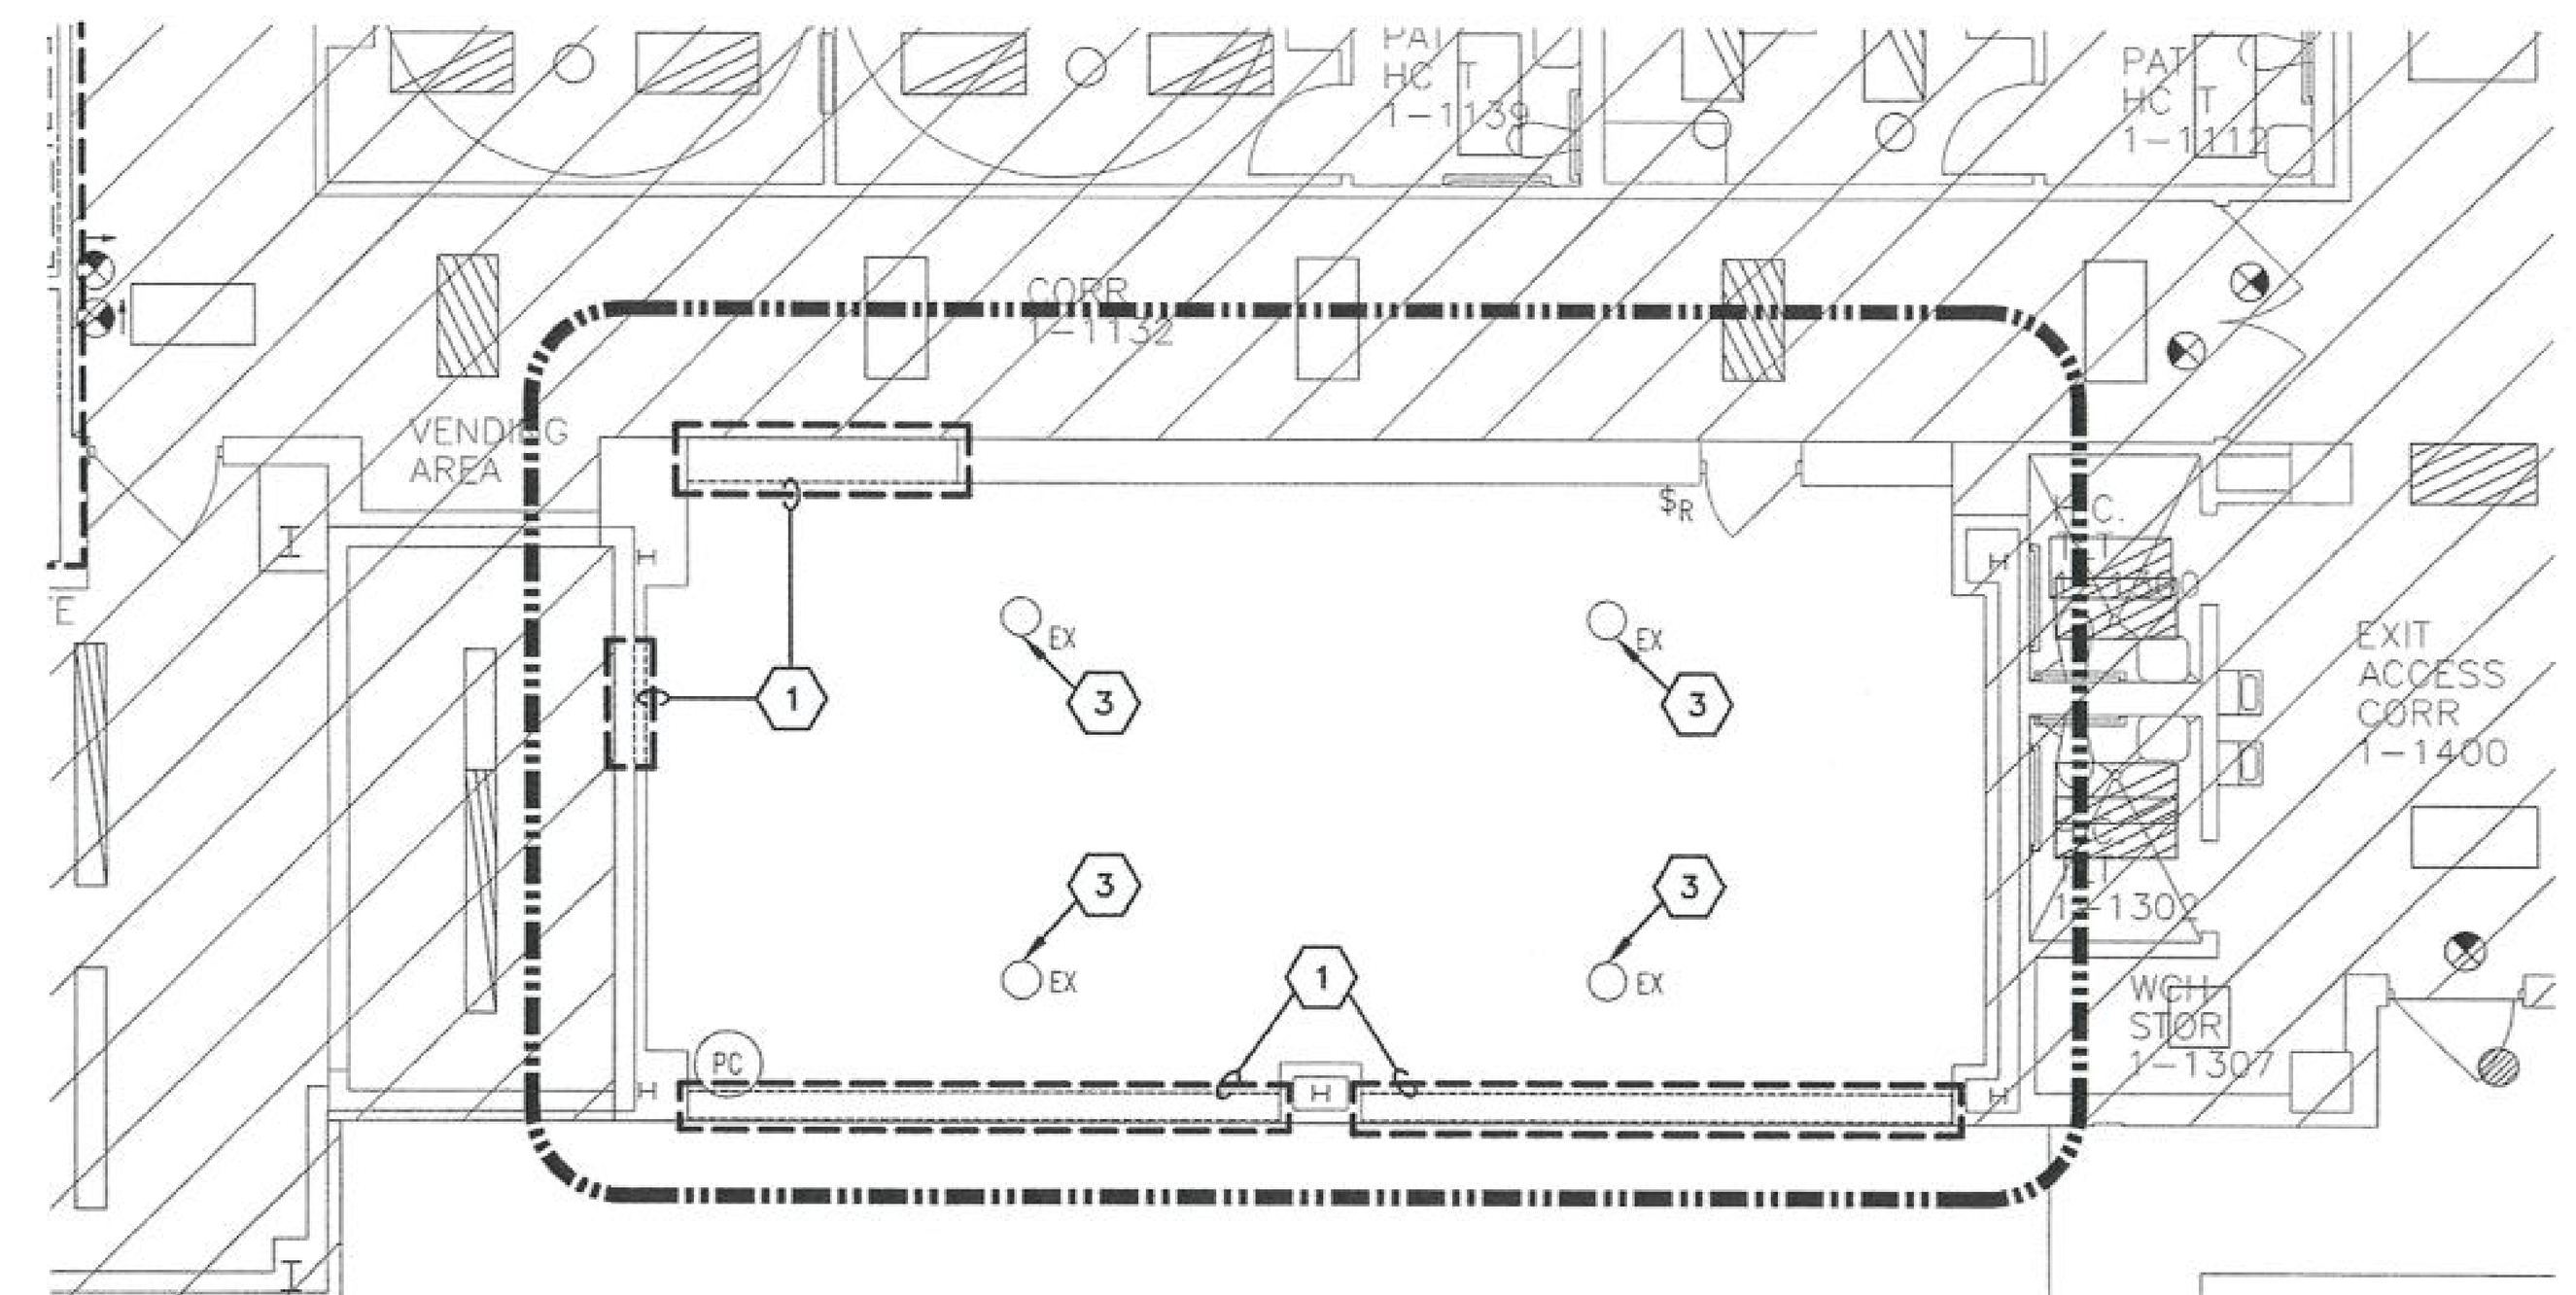

03 LIGHTING - FIRST FLOOR DEMO - BED STORAGE
SCALE: 1/8" = 1'-0"

GENERAL NOTES

A. REFER TO AND COORDINATE WITH THE ARCHITECTURAL PLANS, ELEVATIONS, AND DETAILS FOR DEMOLITION REQUIREMENTS.

B. DESIGNATION 'EX' REPRESENTS EXISTING DEVICE OR LIGHT FIXTURE TO REMAIN AS CIRCUITED AND SWITCHED UNLESS NOTED OTHERWISE. EXISTING LIGHT FIXTURES SHALL BE CLEANED AND REPAIRED AS REQUIRED.

C. A DEVICE WITH AN 'RL' INDICATES EXISTING DEVICE TO BE RELOCATED AND RE-USED.

D. A DEVICE WITH AN 'R' INDICATES EXISTING DEVICE TO BE REMOVED INCLUDING ALL ASSOCIATED CONDUIT AND WIRING.

LEGEND NOTES

1. REMOVE ALL ELECTRICAL WORK AND CIRCUITING IN THIS AREA UNLESS NOTED OTHERWISE. WHERE WALLS ARE BEING DEMOLISHED DOWN TO STUDS, REMOVE ALL ELECTRICAL DEVICES AND ASSOCIATED CONDUIT AND CONDUCTORS CONTAINED THERIN UNLESS NOTED OTHERWISE. CIRCUITS SHALL BE DEMOLISHED BACK TO POINT OF ORIGINATION. REFER TO ARCHITECTURAL DEMOLITION PLANS FOR ADDITIONAL INFORMATION.
2. EXISTING DEVICES AND LIGHT FIXTURES IN THIS AREA TO REMAIN AS CIRCUITED AND SWITCHED UNLESS NOTED OTHERWISE.
3. DISCONNECT EXISTING FIXTURE FROM PHOTOCELL.

PERKINS & WILL
6200 North Central Expressway
Dallas, Texas 75206 USA
214.775.6200 Fax: 214.775.6201
www.perkinswill.com

Medical Center of Aurora
South Campus
Private Room Expansion
Aurora, Colorado

HCA
Project # 306660001

In association with:

Civil
Martin Martin, Inc.
4251 Kipling Street
Wheat Ridge, CO 80033
T: 303.431.6100
F: 303.431.4028


Structural
TRC International, Ltd.
5050 QUARUM DRIVE, SUITE 700
Dallas, TX 75254
T: 214.722.6452
F: 214.722.6552


MEP
CCRD Partners
3625 N. HALL STREET
SUITE 1300, LB 139
DALLAS, TX-75219
T: 214.521.1661
F: 214.521.1664

LANDSCAPE
Davis Partnership
2310 BLAKE STREET, SUITE 100
DENVER, CO 80205
T: 303.861.8555
F: 303.861.3027

JULY 13
EARLY RELEASE PKG. #2
ISSUED FOR PERMIT & CONSTRUCTION

KEY PLAN
FIRST FLOOR

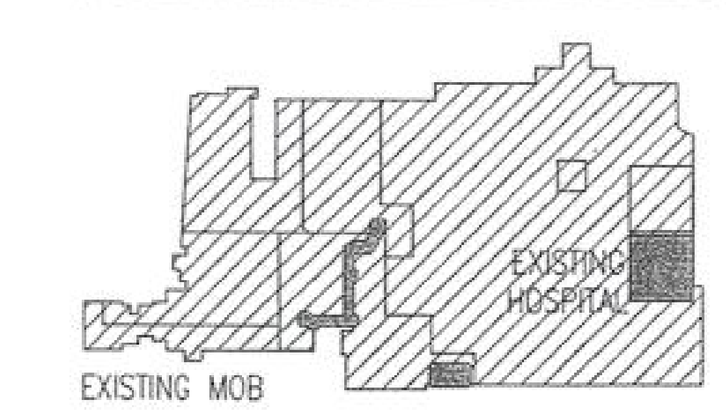

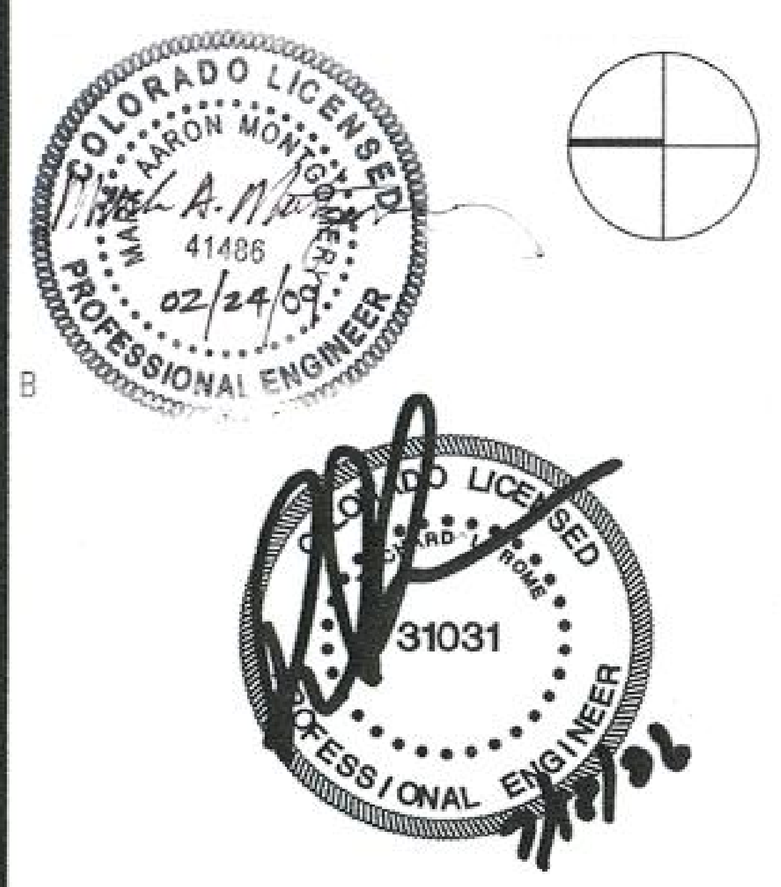

Revisions

NO.	ISSUE	DATE
1	FIELD MEMO	02.10.09

Sheet Information

Date	07-13-2006
Job Number	142228.000
Drawn	AL
Checked	SG
Approved	SG

Title

DEMOLITION PLAN FIRST FLOOR LIGHTING

Sheet


ED-3100

Issued for Construction


Copyright © 2005 PERKINS & WILL

THIS SHEET OF DRAWINGS HAS NOT BEEN REVIEWED FOR CODE COMPLIANCE
09-384477


F:\2005 Projects\205555 Medical Center of Aurora Expansion\Drawings\ERP\555ED-3100.dwg
Dan Seeley, ccrd partners 07/13/2006 - 2:56PM

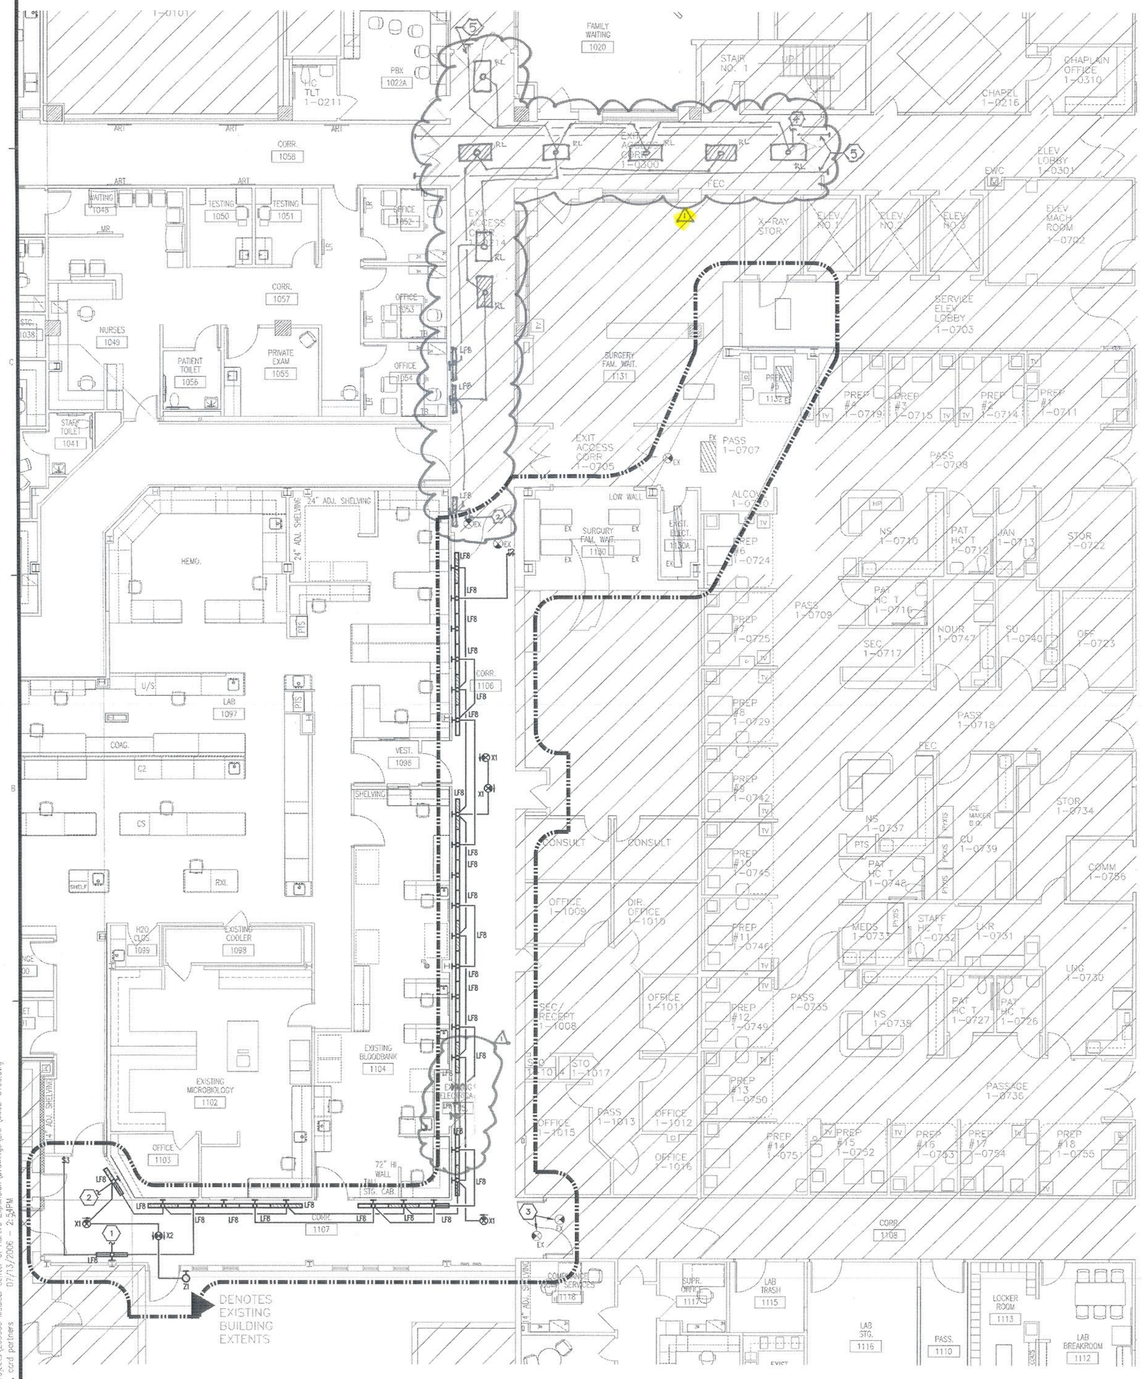

01 LIGHTING - FIRST FLOOR - EXIT CORRIDOR 'A'
SCALE: 1/8" = 1'-0"

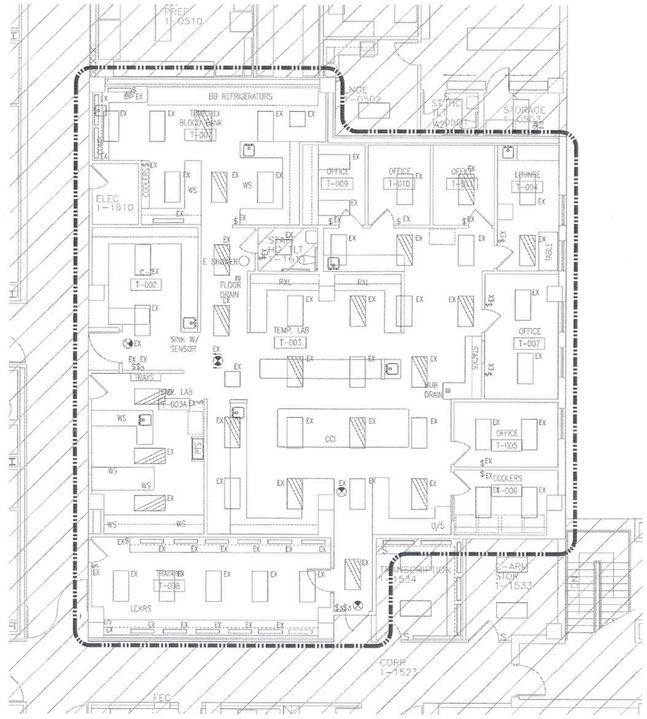

04 LIGHTING - FIRST FLOOR - TEMP LAB
SCALE: 1/8" = 1'-0"

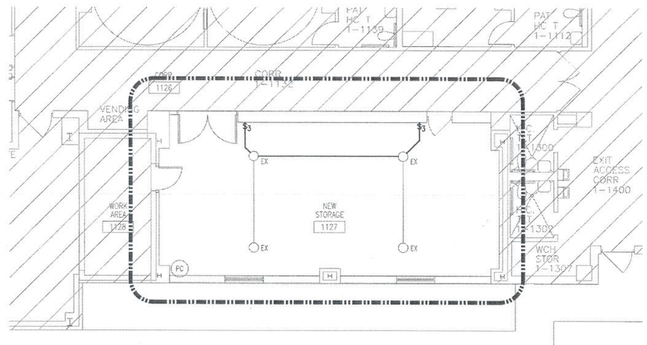

03 LIGHTING - FIRST FLOOR - BED STORAGE
SCALE: 1/8" = 1'-0"

02 NOT USED
SCALE: 1/8" = 1'-0"

GENERAL NOTES

A. REFER TO AND COORDINATE WITH THE ARCHITECTURAL PLANS, ELEVATIONS, AND DETAILS FOR EXACT LOCATIONS OF ALL LIGHT FIXTURES, SWITCHES AND WIRING DEVICES.

B. DESIGNATION 'EX' REPRESENTS EXISTING DEVICE OR LIGHT FIXTURE TO REMAIN AS CIRCUITED AND SWITCHED UNLESS NOTED OTHERWISE. EXISTING LIGHT FIXTURES SHALL BE CLEANED AND REPAIRED AS REQUIRED.

C. A DEVICE WITH AN 'RL' INDICATES EXISTING DEVICE TO BE RELOCATED AND RE-USED.

D. ALL NEW DEVICES AND CONDUIT IN TEMP LAB ARE TO BE SURFACE MOUNTED. PAINT CONDUIT AND BOXES TO MATCH SURROUNDINGS.

E. 2x4 LIGHTS MARKED WITH "RL" ARE EXISTING TO BE REUSED. CLEAN, RELAMP, AND REINSTALL ON EXISTING CIRCUITS FEEDING THEM.

LEGEND NOTES

1. CONNECT TO EXISTING 277V NORMAL POWER CORRIDOR LIGHTING CIRCUIT AVAILABLE FROM DEMOLITION.
2. CONNECT TO EXISTING 277V LIFE SAFETY POWER CORRIDOR LIGHTING CIRCUIT AVAILABLE FROM DEMOLITION.
3. RELOCATE EXISTING EXIT SIGNS TO NEW DOOR LOCATION. EXTEND EXISTING CIRCUITING TO NEW LOCATION AS INDICATED.
4. CONNECT TO EXISTING LIGHT SWITCH CURRENTLY SERVING THE EXIT ACCESS CORRIDOR.
5. PROVIDE 3" CONDUIT ABOVE RAISED CEILING FOR FUTURE LOW VOLTAGE PATHWAY.

Legibly identify each breaker or switch for it's use or purpose on the circuit directory in the panel/switchboard per 2008 NEC 408.4.

Wiring in air handling spaces must comply with 2008 NEC 300-22. Firestop penetrations per 2008 NEC 300-21. Secure and support eqipment per 2008 NEC 300-11.

09-384477

CITY OF AURORA
BUILDING DIVISION
APPROVED AS NOTED
DATE APPROVED MAR 11 2009

PERKINS & WILL

8200 North Central Expressway
Dallas, Texas 75206 USA
214.775.6200 Fax: 214.775.6201
www.perkinswill.com

Medical Center of Aurora
South Campus
Private Room Expansion
Aurora, Colorado

HCA

Project # 306660001

In association with:

CM
Martin Martin, Inc.
4251 Kipling Street
Wheat Ridge, CO 80033
T: 303.431.6100
F: 303.431.4028


Structural
TRC International, Ltd.
5050 QUARUM DRIVE, SUITE 700
Dallas, TX 75254
T: 214.722.6452
F: 214.722.6552

MEP
CCRD Partners
3625 N. HALL STREET
SUITE 1300, LB 139
DALLAS, TX-75219
T: 214.521.1661
F: 214.521.1664

LANDSCAPE
Davis Partnership
2310 BLAKE STREET, SUITE 100
DENVER, CO 80205
T: 303.861.8555
F: 303.861.3057

JULY 13
EARLY RELEASE PKG. #2
ISSUED FOR PERMIT &
CONSTRUCTION

KEY PLAN
FIRST FLOOR

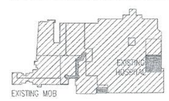

REGISTERED LICENSED 31031 PROFESSIONAL ENGINEER

Revisions

NO.	ISSUE	DATE
1	Field Memo	02.10.09

Sheet Information

Date	07-13-2006
Job Number	142228.000
Drawn	AL
Checked	SG
Approved	SG

Title

LIGHTING PLAN FIRST FLOOR

Sheet

E-3100

Issued for Construction

Copyright © 2005 PERKINS & WILL

F:\2005 Projects\205555 Medical Center of Aurora Expansion\Drawings\ESP\SCHE - 3100.dwg
07/13/2006 - 2:54PM
Don Seeling, ccrd partners