City of Aurora
Building Codes Division
15151 E Alameda Pkwy
Aurora, CO 80012
(303) 739-7420

Notice

This material is subject to copyright protection pursuant to Federal Law: 17 United States Code Section 106.

Medical Center of Aurora
South Campus - CATH LAB ADDITION

1501 SOUTH POTOMAC STREET
AURORA, CO 80012

April 22, 2009
PWCRA PROJECT # 142542.000
HCA #306660005

ADDENDUM #2
ISSUE FOR CONSTRUCTION

SYMBOLS KEY

DRAWING NUMBER KEY

DISCIPLINE
A – ARCHITECTURAL
C – CIVIL
L – LANDSCAPE
M – MECHANICAL
E – ELECTRICAL
P – PLUMBING
S – STRUCTURAL
K – KITCHEN
R – RADIOLOGY

15/A-2010
NUMBER OF PLAN, DETAIL, ETC. ON SHEET
DRAWING SERIES

ISSUE DATE
INITIAL ISSUE DATE
INITIAL ISSUE NAME
REVISION NAME
FOR CONSTRUCTION MAY 17, 2006
CITY COMMENTS #1 MAY 17, 2006

INDEX OF DRAWINGS

GENERAL

		ISSUE	DATE: CONSTRUCTION DOCUMENTS 03-06-09	ADDENDUM #1 04-21-09	ADDENDUM #2 04-22-09
G-0000	COVER SHEET	●			
G-0001	INDEX OF DRAWINGS	●	●		

STRUCTURAL

S-1	CATH LAB EQUIPMENT BRACING AND SECTIONS	●		●
S-2	NEW ROOF RTU BRACING	●		●

ARCHITECTURAL

D-2001	DEMOLITION PLAN – PARTIAL FIRST FLOOR	●		●

A-0000	GENERAL NOTES, ABBREVIATIONS, CODE SUMMERY AND SYMBOLS	●		
A-0101	CODE COMPLIANCE DETAILS	●		
A-0102	CODE COMPLIANCE DETAILS	●		
A-0111	CODE COMPLIANCE PLAN – PARTIAL FIRST FLOOR	●		
A-1000	ARCHITECTURAL ROOF PLAN	●		●
A-2001	ARCHITECTURAL NEW CONSTRUCTION PLAN – PARTIAL FIRST FLOOR	●		●
A-2101	EQUIPMENT AND WOODWORK PLAN – PARTIAL FIRST FLOOR	●		●
A-2201	INTERIOR FINISH PLAN – PARTIAL FIRST FLOOR	●		●
A-2401	ARCHITECTURAL REFLECTED CEILING PLAN – PARTIAL FIRST FLOOR	●		●
A-5200	ARCHITECTURAL INTERIOR ELEVATIONS	●		●
A-5201	ARCHITECTURAL INTERIOR ELEVATIONS	●		●
A-5400	ARCHITECTURAL CASEWORK SECTIONS	●		
A-5401	ARCHITECTURAL WOODWORK SECTIONS	●		●
A-5500	INTERIOR RCP DETAILS	●		
A-5600	TOILET ACCESSORIES & MISCELLANEOUS INTERIOR DETAILS	●		
A-8000	INTERIOR FINISH LEGEND	●		●
A-8100	PARTITION DETAILS	●		
A-8101	PARTITION TYPE SCHEDULE	●		
A-8200	DOOR/WINDOW SCHEDULE & DETAILS	●		●

MECHANICAL ELECTRICAL AND PLUMBING

		ISSUE	DATE: CONSTRUCTION DOCUMENTS 03-06-09	ADDENDUM #1 04-21-09	ADDENDUM #2 04-22-09
E-0001	ELECTRICAL LEGENDS & NOTES	●			
ED-2001	POWER DEMOLITION PLAN – FIRST FLOOR	●			●
ED-3001	LIGHTING DEMOLITION PLAN – FIRST FLOOR	●			●
ED-4001	FIRE ALARM DEMOLITION PLAN – FIRST FLOOR	●			●
E-2000	POWER OVERALL PLAN – FIRST FLOOR	●			●
E-2001	POWER PLAN – FIRST FLOOR	●		●	●
E-2002	POWER PLAN – FIRST FLOOR	●			●
E-200R	POWER PLAN – ROOF	●			●
E-3001	LIGHTING PLAN – FIRST FLOOR	●			●
E-4001	FIRE ALARM PLAN – FIRST FLOOR	●			
E-5001	ELECTRICAL ONE-LINE DIAGRAM	●			
E-5002	ELECTRICAL ONE-LINE DIAGRAM	●			
E-5003	ELECTRICAL ONE-LINE DIAGRAM	●	●		
E-6001	ELECTRICAL DETAILS	●			
E-7001	ELECTRICAL SCHEDULES	●			●
E-7002	ELECTRICAL SCHEDULES	●			●
E-7003	ELECTRICAL SCHEDULES	●			●

M-0001	GENERAL INFORMATION – MECHANICAL	●		
M-0002	CONTROL DIAGRAMS – MECHANICAL			●
MD-2001	DUCTWORK DEMOLITION PLAN – FIRST FLOOR	●		●
MD-2002	DUCTWORK DEMOLITION PLAN – ROOF	●		●
MD-3001	PIPING DEMOLITION PLAN – FIRST FLOOR	●		●
M-2001	DUCTWORK PLAN – FIRST FLOOR	●		●
M-2002	DUCTWORK PLAN – ROOF	●		●
M-3001	PIPING PLAN – FIRST FLOOR	●		●
M-3002	PIPING PLAN – ROOF	●		●
M-4001	MECHANICAL DETAILS – SHEET 1 OF 3	●		
M-4002	MECHANICAL DETAILS – SHEET 2 OF 3	●		
M-4003	MECHANICAL DETAILS – SHEET 3 OF 3	●		●
M-5001	MECHANICAL SCHEDULES – SHEET 1 OF 2	●		
M-5002	MECHANICAL SCHEDULES – SHEET 2 OF 2	●		●

P-0001	PLUMBING LEGENDS & NOTES	●		
P-1001	PLUMBING PLAN – UNDERFLOOR	●		●
P-2001	PLUMBING PLAN – FIRST FLOOR	●		●
P-2002	PLUMBING PLAN – ROOF	●		●
P-3001	MEDICAL GAS PLAN – FIRST FLOOR	●		●
P-4001	PLUMBING DETAILS	●		
P-5001	PLUMBING RISER DIAGRAMS	●		

CM-0001	NOTES AND LEGENDS	●		●
CM-2001	COMMUNICATIONS PLAN – FIRST FLOOR	●		●
CM-3001	LOW VOLTAGE PLAN – FIRST FLOOR	●		●
CM-6001	COMMUNICATIONS RISERS AND DETAILS	●		
CM-6002	COMMUNICATIONS RISERS AND DETAILS	●		●

*OWNER FURNISHED DRAWINGS
*ISSUED FOR INFORMATION AND COORDINATION ONLY

PHILIPS CATH LAB VENDOR DRAWINGS
N-WES090034 C

		ISSUE	DATE: CONSTRUCTION DOCUMENTS 03-06-09	ADDENDUM #1 04-21-09	ADDENDUM #2 04-22-09
C1	TABLE OF CONTENTS	●		●	●
AN	GENERAL NOTES	●		●	●
AL	EQUIPMENT LEGEND	●		●	●
A1	EQUIPMENT PLAN	●		●	●
AD1	EQUIPMENT DETAILS	●		●	●
AD2	EQUIPMENT DETAILS	●		●	●
AD3	EQUIPMENT DETAILS	●		●	●
AD4	EQUIPMENT DETAILS	●		●	●
AD5	EQUIPMENT DETAILS	●		●	●
AD6	EQUIPMENT DETAILS	●		●	●
AD7	EQUIPMENT DETAILS	●		●	●
AD8	TRANSPORT DETAILS	●		●	●
SN	SUPPORT NOTES	●		●	●
SL	SUPPORT LEGENDS	●		●	●
S1	SUPPORT PLAN – FLOOR & WALL	●		●	●
S2	SUPPORT PLAN – CEILING	●		●	●
SD1	SUPPORT DETAILS	●		●	●
SD2	SUPPORT DETAILS	●		●	●
SD3	SUPPORT DETAILS	●		●	●
EN	ELECTRICAL NOTES	●		●	●
EL	ELECTRICAL LEGEND	●		●	●
E1	ELECTRICAL PLAN	●		●	●
E2	RACEWAY & CONDUIT INFORMATION	●		●	●
E3	RACEWAY & CONDUIT INFORMATION	●		●	●
E4	RACEWAY & CONDUIT INFORMATION	●		●	●
ED1	ELECTRICAL DETAILS	●		●	●
ED2	ELECTRICAL DETAILS	●		●	●
ED3	ELECTRICAL DETAILS	●		●	●
ED4	ELECTRICAL DETAILS	●		●	●
N1	REMOTE SERVICE NETWORK	●		●	●
CHK	CHECK LIST	●		●	●

N-WES090035 C

C1	TABLE OF CONTENTS	●		●
AN	GENERAL NOTES	●		●
AL	EQUIPMENT LEGEND	●		●
A1	EQUIPMENT PLAN	●		●
AD1	EQUIPMENT DETAILS	●		●
AD2	EQUIPMENT DETAILS	●		●
AD3	EQUIPMENT DETAILS	●		●
AD4	EQUIPMENT DETAILS	●		●
AD5	EQUIPMENT DETAILS	●		●
AD6	EQUIPMENT DETAILS	●		●
AD7	EQUIPMENT DETAILS	●		●
AD8	TRANSPORT DETAILS	●		●
SN	SUPPORT NOTES	●		●
SL	SUPPORT LEGENDS	●		●
S1	SUPPORT PLAN – FLOOR & WALL	●		●
S2	SUPPORT PLAN – CEILING	●		●
SD1	SUPPORT DETAILS	●		●
SD2	SUPPORT DETAILS	●		●
SD3	SUPPORT DETAILS	●		●
EN	ELECTRICAL NOTES	●		●
EL	ELECTRICAL LEGEND	●		●
E1	ELECTRICAL PLAN	●		●
E2	RACEWAY & CONDUIT INFORMATION	●		●
E3	RACEWAY & CONDUIT INFORMATION	●		●
E4	RACEWAY & CONDUIT INFORMATION	●		●
ED1	ELECTRICAL DETAILS	●		●
ED2	ELECTRICAL DETAILS	●		●
ED3	ELECTRICAL DETAILS	●		●
ED4	ELECTRICAL DETAILS	●		●
N1	REMOTE SERVICE NETWORK	●		●
CHK	CHECK LIST	●		●

*OWNER FURNISHED DRAWINGS
*ISSUED FOR INFORMATION AND COORDINATION ONLY

PHILIPS PATIENT MONITORING VENDOR DRAWINGS

		ISSUE	DATE: CONSTRUCTION DOCUMENTS 03-06-09	ADDENDUM #1 04-21-09	ADDENDUM #2 04-22-09
1	INDEX	●			
2	1ST FLOOR MONITORING PLAN	●			
3	EQUIPMENT ELEVATIONS	●			

NURSE CALL VENDOR DRAWINGS

NC01	NURSE CALL LAYOUT	●		

TELEHEALTH SERVICES VENDOR DRAWINGS

1 of 2	LEGENDS, NOTES AND DETAILS	●		
2 of 2	EQUIPMENT FLOOR PLAN	●		

Code violations found during inspection are required to be corrected. Plan/Permit issuance does not grant approval of code violation. 2006 IBC 105.4

Only highlighted or clouded revisions are approved on this review. All Previous comments apply.

09 399209

CITY OF AURORA
BUILDING DIVISION
APPROVED AS NOTED
DATE APPROVED JUN 19 2009
2006 IBC

PERKINS & WILL
10100 North Central Expressway, Suite 300
Dallas, Texas 75231, USA
214.283.8700 Fax: 214.283.8701
www.perkinswill.com

Medical Center of Aurora
1501 S. Potomac
South Campus
Cath Lab
Aurora, Colorado 80012
HCA
Project # 306660005

In association with:

Structrual
TRC International, Ltd.
13800 MONTFORT DRIVE, SUITE 145
DALLAS, TX 75240
T: 972.991.1188
F: 972.991.1192

MEP
CCRD Partners
8301 E. PRENTICE AVENUE, SUITE 200
GREENWOOD VILLAGE, CO 80111
T: 303.694.4755
F: 303.694.5125

STATE OF COLORADO
TRUDY L. McDOUGAL
203601
LICENSED ARCHITECT
4-22-09

Revisions

NO.	ISSUE	DATE

Sheet Information

Date	03-06-2009
Job Number	142542.000
Drawn	LTS
Checked	JMN
Approved	CG

Title

INDEX OF DRAWINGS


Sheet

G-0001

Issued for Construction


Copyright © 2005 PERKINS & WILL

Apr 21, 2009 – 3:05pm
P:\Dallas\142542.000 HCA Aurora Cath\CAD\SHEETS\G-0001--addendum 2.dwg
acrenshaw

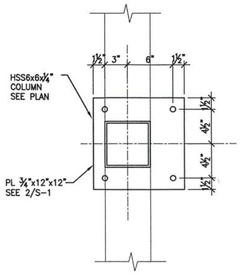


OFFSET BASE PLATE DETAIL


SCALE: 1½"=1'-0"

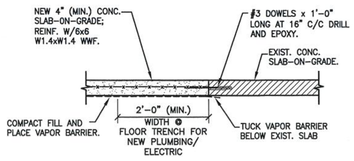


SLAB REPAIR DETAIL

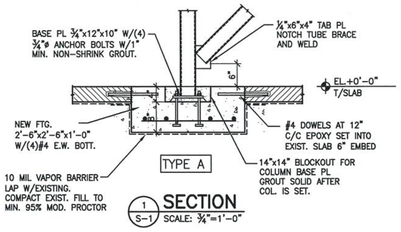


1 S-1 **SECTION** SCALE: ¾"=1'-0"

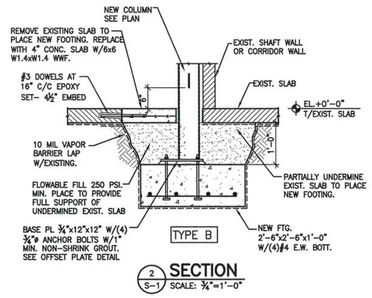


2 S-1 **SECTION** SCALE: ¾"=1'-0"

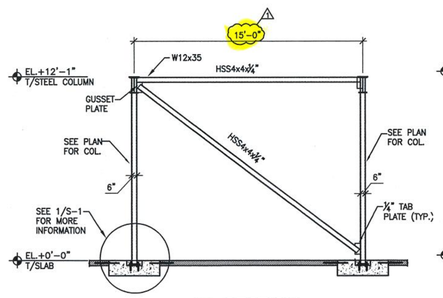


3 S-1 **SECTION** SCALE: ¾"=1'-0"

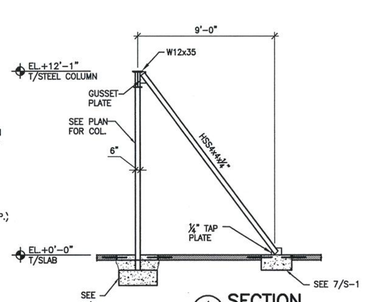


4 S-1 **SECTION** SCALE: ¾"=1'-0"

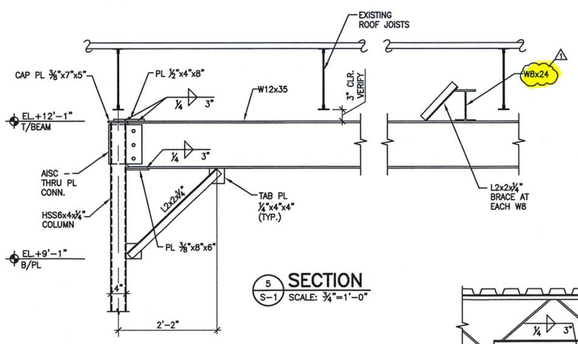


5 S-1 **SECTION** SCALE: ¾"=1'-0"

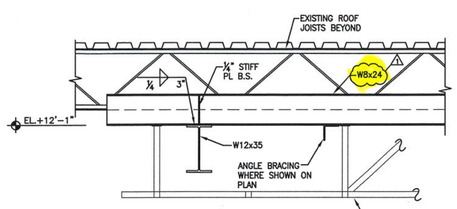

6 S-1 **SECTION** SCALE: ¾"=1'-0"

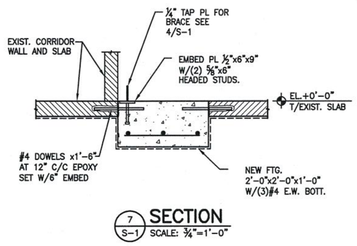


7 S-1 **SECTION** SCALE: ¾"=1'-0"

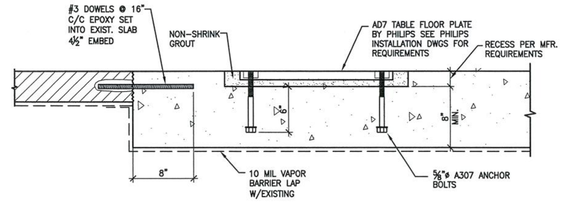


DETAIL AT FLOOR PLATE

SCALE: 1½"=1'-0"

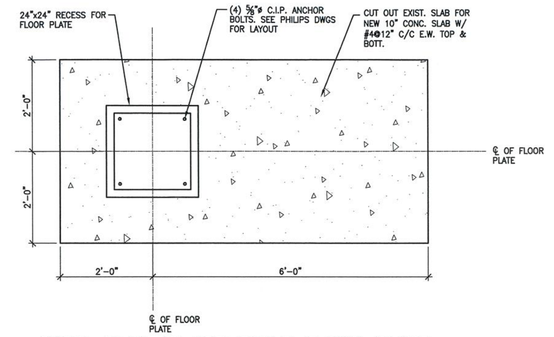

PART. PLAN AT AD7 TABLE FLOOR PLATE

SCALE: ¾"=1'-0"

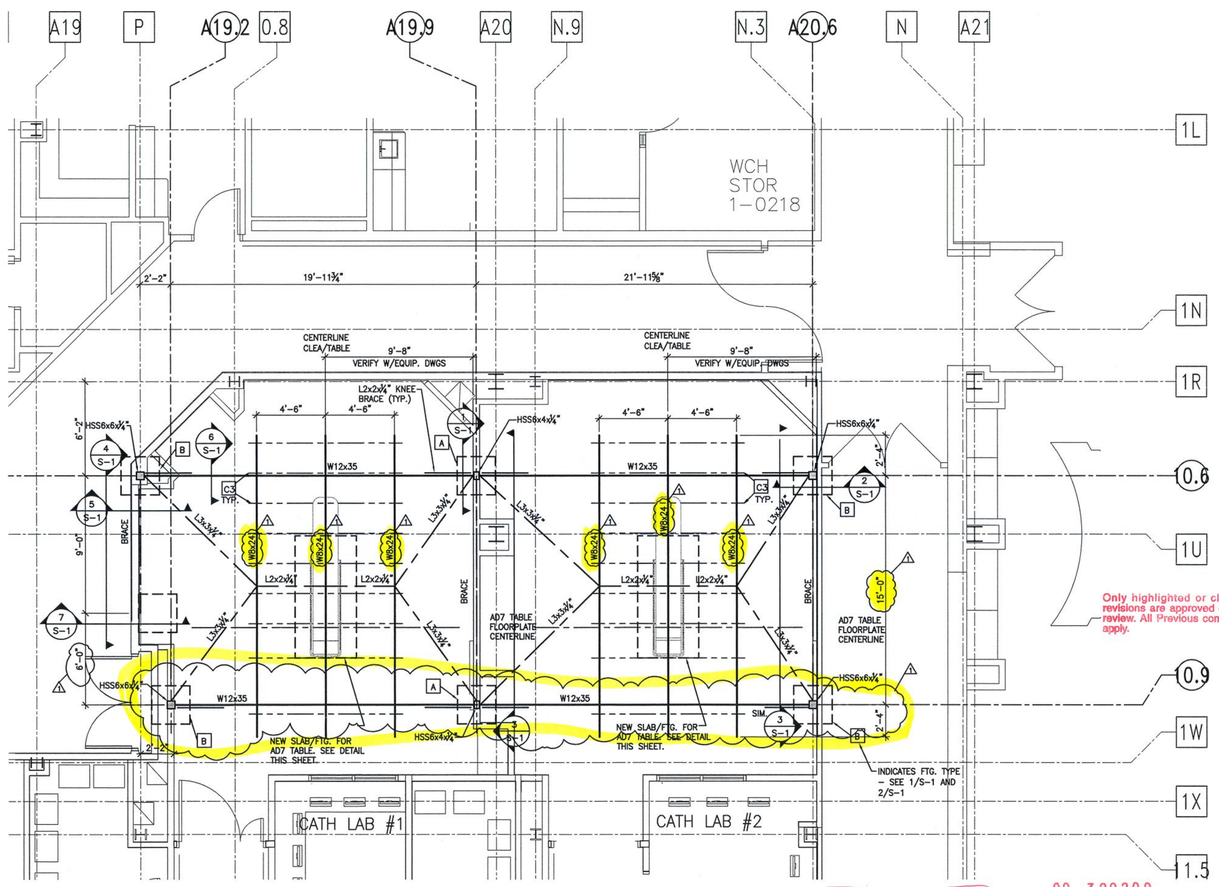

Only highlighted or clouded revisions are approved on this review. All Previous comments apply.

09 399209

Code violations found during inspection are required to be corrected. Plan/Permit Issuance does not grant approval of code violation. 2006 IBC 105.4

CATH LAB EQUIPMENT SUPPORT FRAMING

SCALE: ¼"=1'-0"

1. VERIFY EXISTING CONDITIONS AND DIMENSIONS PRIOR TO COMMENCING CONSTRUCTION.
2. VERIFY ALL DIMENSIONS WITH PHILIPS EQUIPMENT AND ARCH. DRAWINGS.
3. CONCRETE STRENGTH FOR NEW SLABS AND FOOTINGS SHALL BE 3000 PSI AT 28 DAYS.
4. C3 INDICATES UNISTRUT SUPPORT FRAMING; COORDINATE WITH MEDICAL EQUIPMENT VENDOR DRAWINGS. NEW UNISTRUT FRAMING AND CONNECTION TO SUPPORT STRUCTURE SHALL BE BY SPECIALTY ENGINEER. SUBMIT SIGNED & SEALED SHOP DRAWINGS FOR REVIEW. UNISTRUT FRAMING SHALL BE SUPPORTED FROM NEW STEEL FRAMING DETAIL ON THIS PLAN. DO NOT SUPPORT FROM EXISTING ROOF STRUCTURE.

CITY OF AURORA
BUILDING DIVISION
APPROVED AS NOTED
DATE APPROVED JUN 17 2009
2006 IBC

PERKINS & WILL

10100 North Central Expressway, Suite 300
Dallas, Texas 75231, USA
214.283.8700 Fax: 214.283.8701
www.perkinswill.com

Medical Center of Aurora

South Campus
Cath Labs
Aurora, Colorado

HCA

Project # 306660005

In association with:

Structural
TRC Worldwide Engineering,Inc
13800 MONTFORT DRIVE, SUITE 145
Dallas, TX 75240
T: 972.991.1188
F: 972.991.1192

MEP
CCRD Partners
8301 E. PRENTICE AVENUE, SUITE 200
GREENWOOD VILLAGE, CO 80111
T: 303.694.4755
F: 303.694.5125

TRC WORLDWIDE ENGINEERING INC.
CERTIFICATE OF AUTHORIZATION NO. 27322
13800 Montfort Drive, Suite 145
DALLAS, TX 75240
PHONE: (972) 991-1188
FAX: (972) 991-1192

© - TRC Worldwide Engineering, Inc. All rights reserved.

www.trcww.com

TO THE BEST OF MY KNOWLEDGE AND ABILITY, THE COMPLETED STRUCTURE DEPICTED ON THESE PLANS COMPLIES WITH THE APPLICABLE MINIMUM BUILDING CODES.

FILE No. 05BRW099

KEY PLAN

FIRST FLOOR



COLORADO REGISTERED SUDHONRA RAMANAN 30354 PROFESSIONAL ENGINEER 9.27.2009

Revisions

NO.	ISSUE	DATE
2	ADDENDUM #2	4/6/09

Sheet Information

Date	03-06-2009
Job Number	142542.000
Drawn	DAB
Checked	JDM
Approved	JDM

Title

CATH LAB EQUIPMENT SUPPORT FRAMING & SECTIONS & DETAILS

Sheet


S-1

Issued for Construction


Copyright © 2005 PERKINS & WILL

\projects\2009\05BRV099 MCOA Cath Lab\CAD\STRUCT\05BRV099-S1 .dwg, 3/26/2009 10:11:36 AM, Acrobat Distiller.pc3, 1:1


Mar 26, 2009 - 10:12pm
K:\projects\2009\05BRW099 MCOA Cath Lab\CAD\STRUCT\05BRW099-S1 .dwg
dbodley

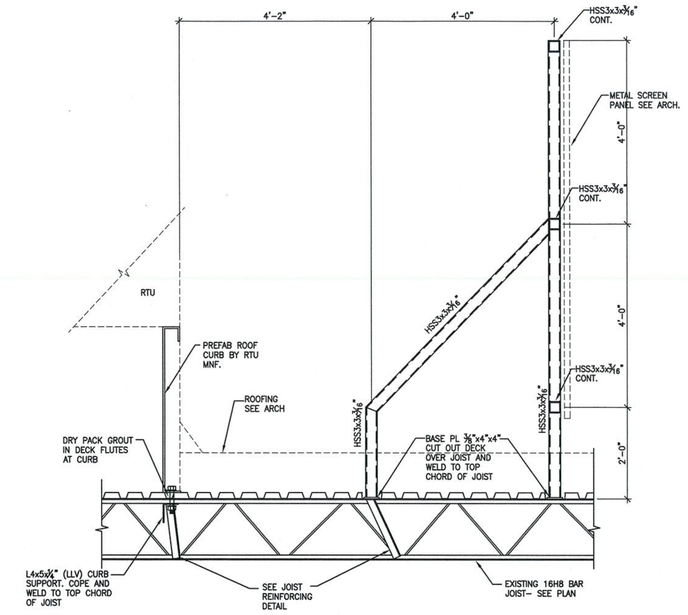


1 S-2 **SECTION**
SCALE: 3/4"=1'-0"

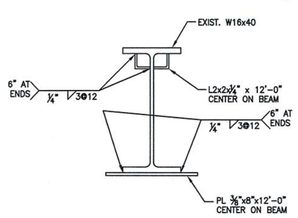

2 S-2 **SECTION**
SCALE: 1½"=1'-0"

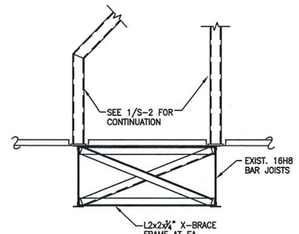

1A S-2 **SECTION**
SCALE: 3/4"=1'-0"

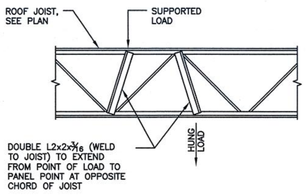


NOTES:

1. PROVIDE REINFORCEMENT AT SUPPORTED OR HUNG LOADS > 300#.
2. DETAIL NOT REQD. IF LOAD IS APPLIED DIRECTLY TO JOIST PANEL POINT.


JOIST REINFORCING DETAILS AT POINT LOADS

SCALE 3/4"=1'-0"

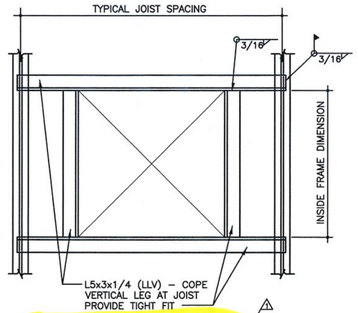

TYPICAL ROOF OPENING REINFORCING DETAIL


1. SEE PLANS FOR LOCATIONS REQUIRED.
2. COORDINATE SIZE OF OPENING WITH MECHANICAL REQUIREMENTS.

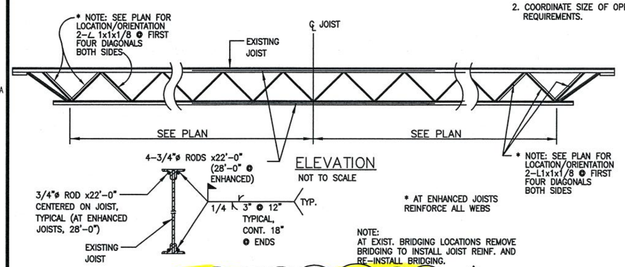

JOIST REPAIR DETAIL

SCALE: 3/4"= 1'-0"

A S-2

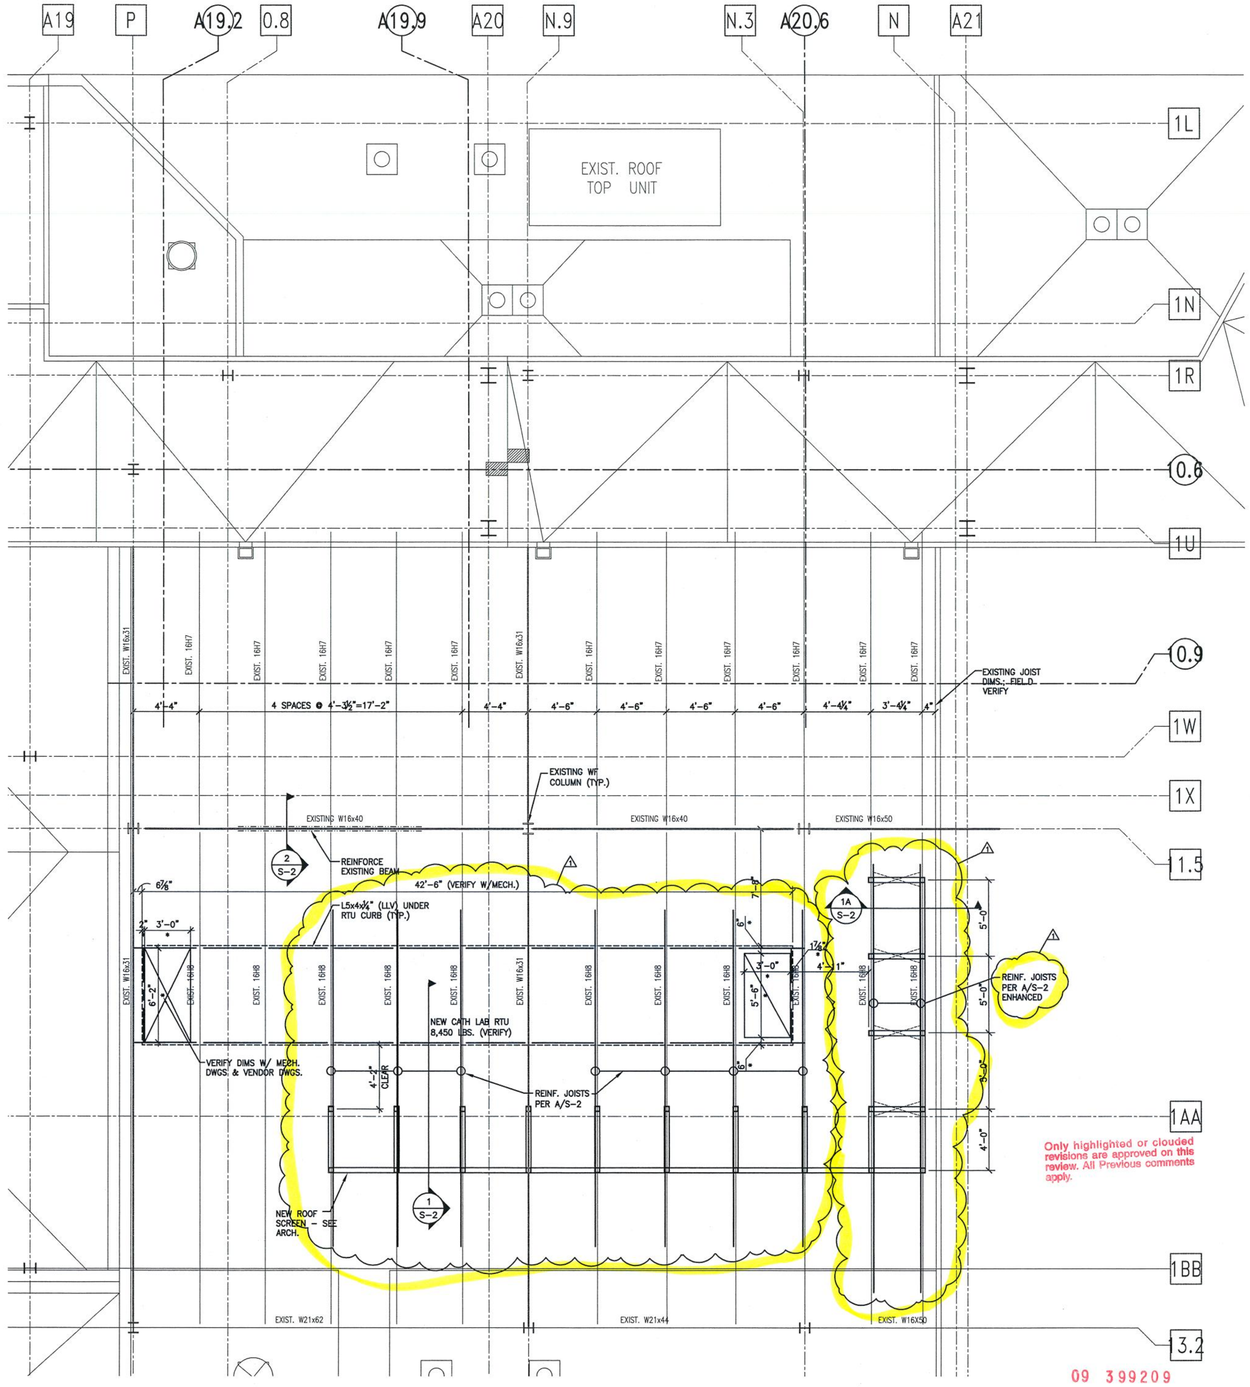

Only highlighted or clouded revisions are approved on this review. All Previous comments apply.

09 399209

Code violations found during inspection are required to be corrected. Plan/Permit issuance does not grant approval of code violation. 2006 IBC 105.4

CITY OF AURORA
BUILDING DIVISION
APPROVED AS NOTED
DATE APPROVED JUN 17 2009
2006 IBC

PARTIAL ROOF PLAN AT NEW RTU

SCALE: 1/4"=1'-0"

1. VERIFY ALL EXISTING CONDITIONS AND DIMENSIONS PRIOR TO COMMENCING CONSTRUCTION.
2. VERIFY EQUIPMENT AND SCREEN LOCATIONS WITH ARCHITECT AND MEP DRAWINGS.
3. ALL EXPOSED MISC. METAL TO BE HOT DIPPED GALVANIZED.

PERKINS & WILL
10100 North Central Expressway, Suite 300
Dallas, Texas 75231, USA
214.283.8700 Fax: 214.283.8701
www.perkinswill.com

Medical Center of Aurora

South Campus
Cath Labs
Aurora, Colorado

HCA

Project # 306660005

In association with:

Structural
TRC Worldwide Engineering,Inc
13800 MONTFORT DRIVE, SUITE 145
Dallas, TX 75240
T: 972.991.1188
F: 972.991.1192

MEP
CCRD Partners
8301 E. PRENTICE AVENUE, SUITE 200
GREENWOOD VILLAGE, CO 80111
T: 303.694.4755
F: 303.694.5125

TRC WORLDWIDE ENGINEERING INC.
CERTIFICATE OF AUTHORIZATION NO. 27322
13800 Montfort Drive, Suite 145
DALLAS, TX 75240
PHONE: (972) 991-1188
FAX: (972) 991-1192

© - TRC Worldwide Engineering, Inc. All rights reserved.


www.trcww.com

TO THE BEST OF MY KNOWLEDGE AND ABILITY, THE COMPLETED STRUCTURE DEPICTED ON THESE PLANS COMPLIES WITH THE APPLICABLE MINIMUM BUILDING CODES.

FILE No. 05BRW099

KEY PLAN

FIRST FLOOR

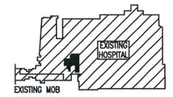

COLORADO REGISTERED SUSENDRA RAMAMURTI 30354 PROFESSIONAL ENGINEER 3/27/2009

Revisions

NO.	ISSUE	DATE
1	ADDENDUM #2	4/6/09

Sheet Information

Date	03-06-2009
Job Number	142542.000
Drawn	DAB
Checked	JDM
Approved	JDM

Title

PARTIAL ROOF PLAN AT NEW RTU & SECTIONS & DETAILS


Sheet

S-2

Issued for Construction

Copyright © 2005 PERKINS & WILL

\projects\2009\05BRW099 MCOA Cath Lab\CAD\STRUCT\05BRW099-S1 .dwg, 3/26/2009 10:13:09 AM, Acrobat Distiller.pc3, 1:1
Mar 26, 2009 - 10:13am
K:\projects\2009\05BRW099 MCOA Cath Lab\CAD\STRUCT\05BRW099-S1 .dwg
dooley

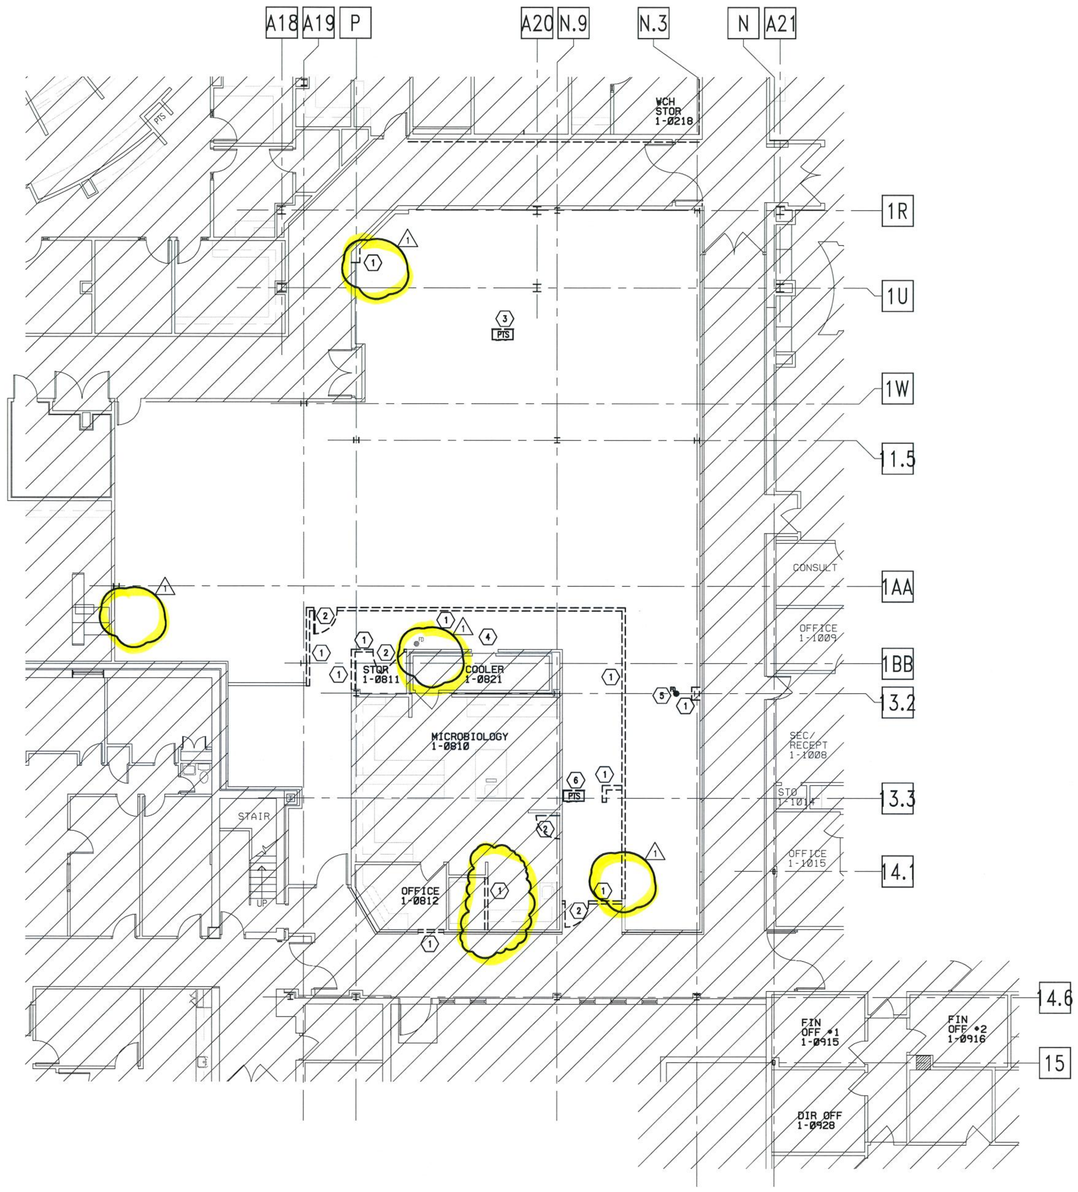

01 DEMOLITION PLAN – FIRST FLOOR
1/8" = 1'-0"

DEMOLITION GENERAL NOTES

1. REFER TO SPECIFICATIONS FOR INTERIM LIFE SAFETY MEASURES.
2. CONSTRUCT TEMPORARY PARTITIONS AS REQUIRED BY PHASING TO MINIMIZE THE SPREAD OF DUST AND NOISE.
3. THESE DRAWINGS HAVE BEEN DEVELOPED FROM EXISTING DRAWINGS WHICH MAY NOT REFLECT ACTUAL FIELD CONDITIONS. VERIFY THESE DRAWINGS WITH EXISTING FIELD CONDITIONS AND NOTIFY THE ARCHITECT IMMEDIATELY OF INCONSISTENCIES BETWEEN THEM AND ACTUAL CONDITIONS BEFORE PROCEEDING WITH CONSTRUCTION.
4. REPAIR ANY DAMAGED FIRE RATED ASSEMBLIES TO THEIR ORIGINAL SPECIFICATION.
5. REMOVE EXISTING CONSTRUCTION AS INDICATED. TYPICAL WALL REMOVAL INCLUDES FINISHES AND MECHANICAL PLUMBING AND ELECTRICAL SYSTEMS CONTAINED THEREIN. REMOVE DOORS, CASEWORK, WINDOWS, FRAMES, AND OTHER FIXTURES AS REQUIRED. AFTER REMOVAL OF PIPE CHASES, PATCH HOLES IN EXISTING FLOORS OR WALLS TO REMAIN, TO MEET ORIGINAL FIRE PROTECTION AND STRUCTURAL REQUIREMENTS. PATCH ADJOINING WALLS, FLOORS AND DECK, AND PREPARE SURFACES TO RECEIVE NEW FINISHES PER FINISH SCHEDULE OR PER INTERIOR FINISH PLANS.
6. WHERE NEW FINISHES ARE TO BE INSTALLED ON EXISTING SURFACES, REMOVE THE EXISTING FINISH AND PREPARE SURFACE TO RECEIVE THE NEW FINISH.
7. COORDINATE WITH THE OWNER ANY ITEMS TO BE STORED AND/OR RELOCATED.
8. SEE CIVIL, MECHANICAL, PLUMBING, AND ELECTRICAL DRAWING FOR DEMOLITION OF UTILITIES.
9. FOR EXTENT AND LOCATION OF CHANNELING OF EXISTING FLOOR SLABS REFER TO MECHANICAL, PLUMBING, AND ELECTRICAL DRAWINGS. IF EXISTING PIPING OR CONDUIT WORK (OTHER THAN THE DESIRED CONNECTION) IS ENCOUNTERED WHILE CHANNELING, NOTIFY THE ARCHITECT BEFORE CONTINUING.
10. VERIFY THAT CONSTRUCTION OF EXISTING WALLS WITHIN THE AREA OF RENOVATION (SMOKE COMPARTMENT) MEETS THE FIRE PROTECTION RATINGS DESIGNATED ON THE LIFE SAFETY PLANS. MAKE ANY REPAIRS OR MODIFICATIONS NECESSARY TO BRING EXISTING WALLS, DOORS, DUCTS, ETC. UP TO THE PROPER FIRE PROTECTION RATING. DOORS AND/OR FRAMES SHALL HAVE THE PROPER LABELING.
11. VERIFY THAT EXIT EGRESS IS MAINTAINED FOR ALL OCCUPIED AREAS OF THE BUILDING THROUGHOUT CONSTRUCTION.
12. DEMOLITION WORK SHALL BE EXECUTED IN CONFORMANCE WITH ALL CODES AND AS SET FORTH BY ALL GOVERNING AUTHORITIES.
13. BRACE ALL EXISTING STRUCTURES OR STRUCTURAL ELEMENTS AS NECESSARY DURING DEMOLITION.
14. DO NOT CUT ANY STRUCTURAL WORK WITHOUT PRIOR APPROVAL FROM THE STRUCTURAL ENGINEER.
15. THE EXISTING BUILDING ENVELOPE SHALL BE MAINTAINED IN A WATER TIGHT CONDITION AT ALL TIMES.
16. REPLACE OR REPAIR ANY EXISTING TO REMAIN FINISHES WHICH ARE DAMAGED DURING DEMOLITION (I.E. – CEILING GRID, CEILING TILE, WALL COVERING, FLOOR COVERINGS, ETC.)
17. WHEREVER POSSIBLE, RETAIN REMOVED BRICK, TO BE USED TO FILL EXTERIOR WALL OPENINGS.
18. NOTIFY THE ARCHITECT IMMEDIATELY IF THE REMOVAL OF MECHANICAL, ELECTRICAL, PLUMBING SYSTEMS OR COMPONENTS WILL ADVERSELY AFFECT THE OPERATION OF MEP SYSTEMS OUTSIDE THE LIMIT OF DEMOLITION.
19. SCHEDULE ALL DEMOLITION WITH THE OWNER.

DEMOLITION LEGEND

- EXISTING TO REMAIN
- EXISTING TO BE REMOVED RE: NOTE 5 OF DEMOLITION GENERAL NOTES
- AREA OUT OF SCOPE
- EXISTING COLUMN TO REMAIN

DEMOLITION NOTES BY NUMBER

1. REMOVE EXISTING WALL.
2. REMOVE EXISTING DOOR & FRAME.
3. REMOVE EXISTING PNEUMATIC TUBE STATION AND TUBE. UNIT TO BE GIVEN TO HOSPITAL ENGINEERING DEPARTMENT FOR POSSIBLE FUTURE REUSE. CAP TUBE LINES AS REQUIRED.
4. REMOVE EXISTING OPENING FRAME AT COOLER.
5. CAP EXISTING FLOOR DRAIN.
6. RELOCATE EXISTING PNEUMATIC TUBE.

Code violations found during inspection are required to be corrected. Plan/Permit issuance does not grant approval of code violation. 2006 IBC 105.4

Only highlighted or clouded revisions are approved on this review. All Previous comments apply.

CITY OF AURORA
BUILDING DIVISION
APPROVED AS NOTED
DATE APPROVED JUN 17 2009
2006 IBC

09 399209

PERKINS & WILL
10100 North Central Expressway, Suite 300
Dallas, Texas 75231, USA
214.283.8700 Fax: 214.283.8701
www.perkinswill.com

Medical Center of Aurora
1501 S. Potomac
South Campus
Cath Lab
Aurora, Colorado 80012
HCA


Project # 306660005

in association with:

Structural
TRC International, Ltd.
13800 MONTFORT DRIVE, SUITE 145
DALLAS, TX 75240
T: 972.991.1188
F: 972.991.1192

MEP
CCRD Partners
8301 E. PRENTICE AVENUE, SUITE 200
GREENWOOD VILLAGE, CO 80111
T: 303.694.4755
F: 303.694.5125

KEY PLAN
FIRST FLOOR

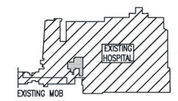

STATE OF COLORADO
JEFFREY J. MCDOUGAL
203601
LICENSED ARCHITECT
4-22-09

Revisions

NO.	ISSUE	DATE
1	ADDENDUM #2	04-22-09

Sheet Information

Date	03-06-2009
Job Number	142542.000
Drawn	LTS
Checked	JMN
Approved	CG

Title

DEMOLITION PLAN
FIRST FLOOR


Sheet

D-2001

Issued for Construction

Copyright © 2005 PERKINS & WILL

Apr 21, 2009 - 3:04pm
P:\Dallas\142542.000 HCA Aurora Cath\CAD\SHEETS\D-2001.dwg
schmidtt

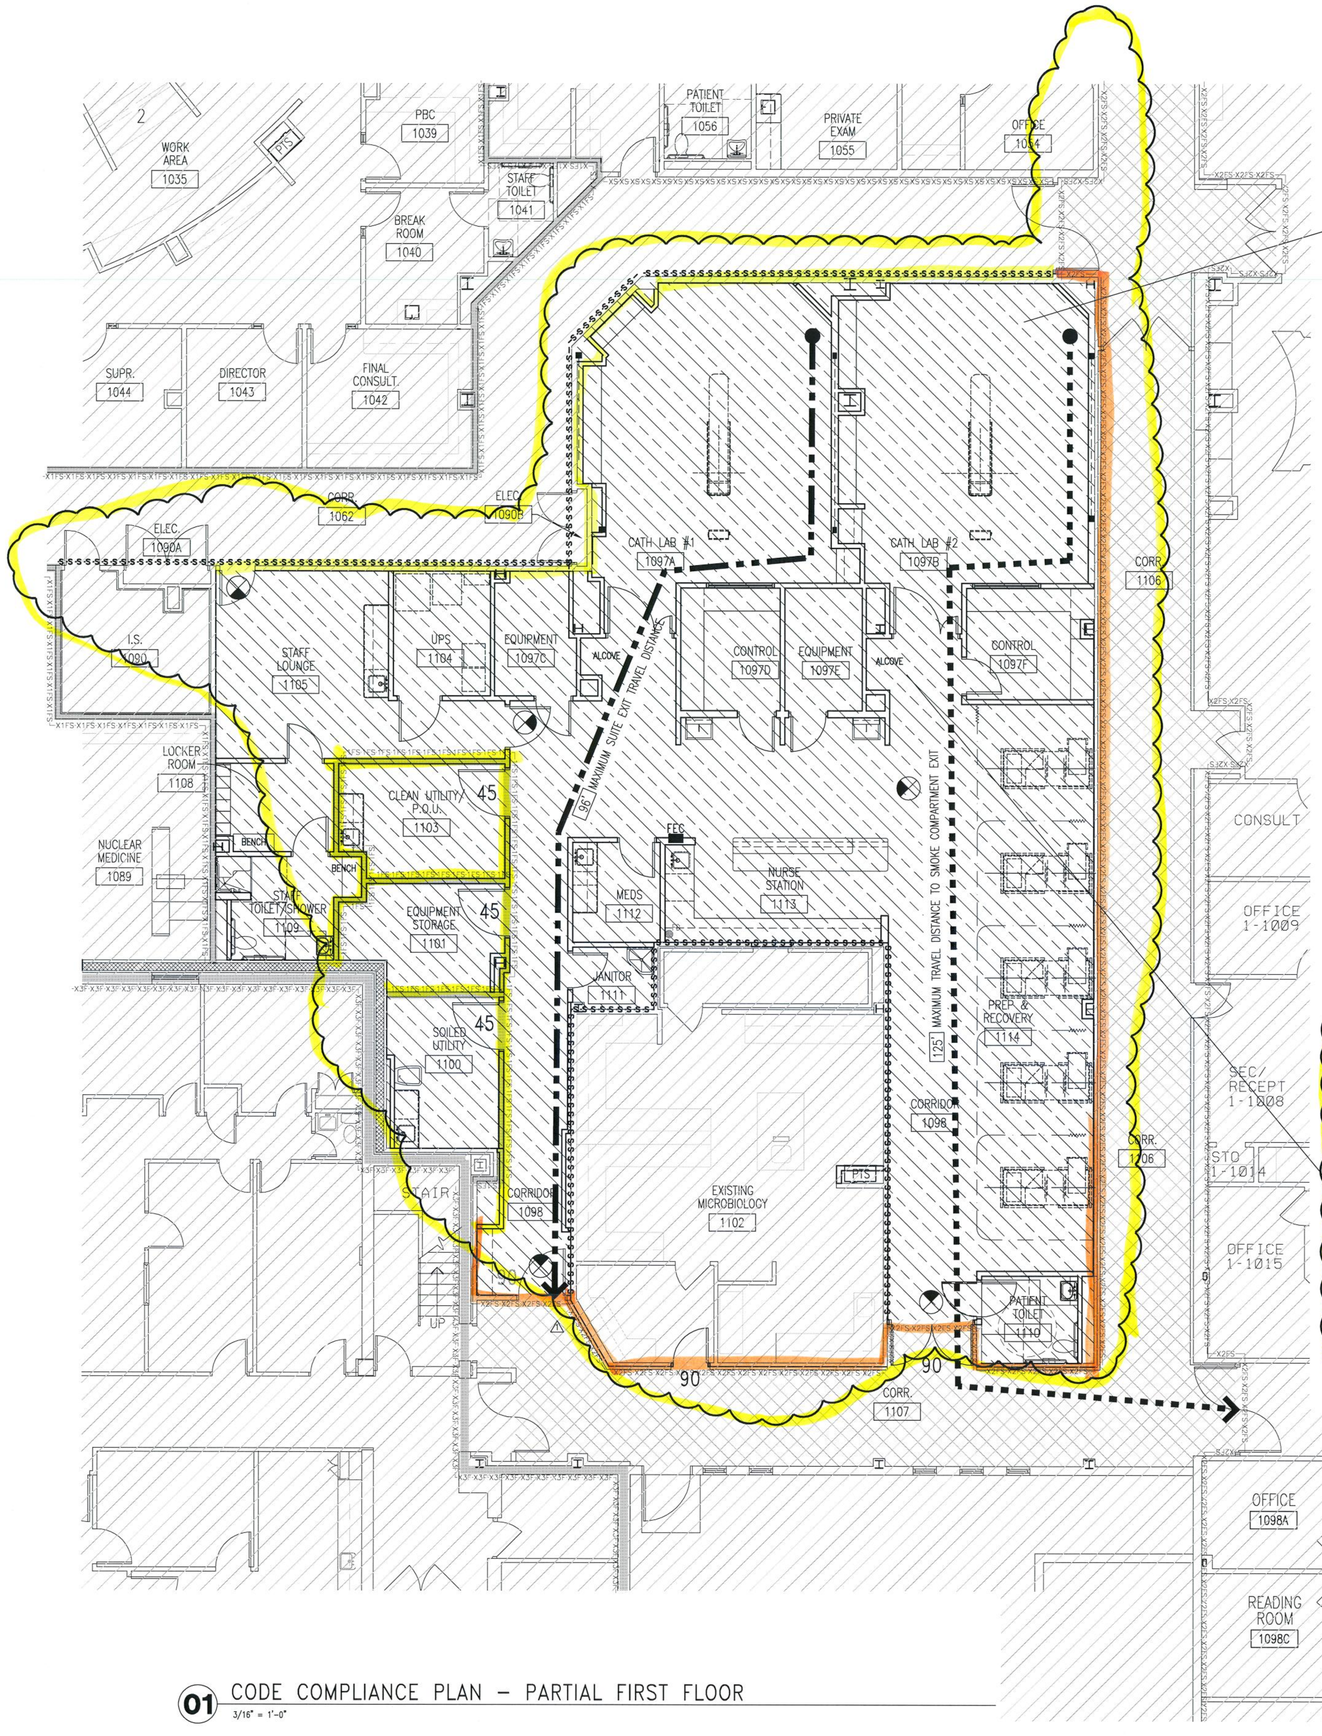

SUITE DATA:

- EXITING NOT ALLOWED THROUGH SUITE
- 4,535 SF SHOWN, 10,000 SF ALLOWED
- 3 EXITS SHOWN, 2 EXITS REQUIRED
- ± 96' MAXIMUM EXIT TRAVEL DISTANCE SHOWN
  100' MAXIMUM EXIT TRAVEL DISTANCE ALLOWED W/ ONE INTERVENING ROOM
- 19 OCCUPANTS (4,535 SF/ 1 OCCUPANT/ 240 SF), DOORS ARE NOT REQUIRED TO SWING OUTWARD

SMOKE COMPARTMENT DATA: AREA 1D

TOTAL SMOKE COMPARTMENT SQUARE FOOTAGE:
10,835 SQ FT (22,500 SQ FT MAXIMUM ALLOWED)

TRAVEL DISTANCE TO A SMOKE BARRIER DOOR:
LONGEST LENGTH = 138'-7" (200' MAXIMUM ALLOWED)

AREA OF REFUGE REQUIRED FOR THIS ZONE:
31 OCCUPANTS X 6 SQ FT/OCCUPANT = 186 SQ FT

ADJACENT SMOKE COMPARTMENT A
655 OCCUPANTS X 6 SQ FT/OCCUPANT = 3,930 SQ FT

ADJACENT SMOKE COMPARTMENT C
156 OCCUPANTS X 6 SQ FT/ OCCUPANT = 936 SQ FT
TOTAL AREA OF REFUGE REQUIRED: 5,112 SQ FT

SQUARE FOOTAGE OF LOW HAZARD AREA = 6400 SQ FT

Code violations found during inspection are required to be corrected. Plan/Permit issuance does not grant approval of code violation. 2006 IBC 105.4

Only highlighted or clouded revisions are approved on this review. All Previous comments apply.

09 399209

CITY OF AURORA
BUILDING DIVISION
APPROVED AS NOTED
DATE APPROVED JUN 17 2009
2006 IBC

01 CODE COMPLIANCE PLAN – PARTIAL FIRST FLOOR

3/16" = 1'-0"

LIFE SAFETY GENERAL NOTES

1. EXISTING WALLS SHOWN WITH NEW LIFE SAFETY RATINGS ARE TO BE UPGRADED TO THE NEW RATING. THE UPGRADING INCLUDES PROTECTING ALL OPENINGS IN THE PARTITION.
2. WALL RATINGS IN EXISTING HOSPITAL ARE BASED UPON OWNER FURNISHED DRAWINGS. THE CONTRACTOR SHALL BRING DISCREPANCIES BETWEEN THE OWNER FURNISHED INFORMATION & THE AS-BUILT CONDITION TO THE ARCHITECTS ATTENTION.
3. REFER TO ELECTRICAL DRAWINGS FOR LOCATION AND QUANTITY OF SMOKE DETECTORS.
4. DOORS IN CORRIDOR PARTITIONS SHALL BE INSTALLED TO RESIST THE PASSAGE OF SMOKE. U.N.O.
5. REFER TO B1/A-0102 FOR FIRE EXTINGUISHER CABINET DETAIL.
6. CONTRACTOR TO VERIFY THAT ALL EXISTING DOORS IN A RATED WALL ARE LABELED WITH THE APPROPRIATE RATING WITHIN THE SMOKE COMPARTMENTS THAT ARE WITHIN THE SCOPE OF THIS WORK. CONTRACTOR ALSO TO VERIFY THAT ALL EXISTING WALLS WITHIN MODIFIED SMOKE COMPARTMENTS THAT ARE LABELED AS FIRE RATED OR SMOKE TIGHT MEET THE REQUIREMENTS OF THE LABELING.
7. AREAS OUTSIDE OF PROJECT SCOPE'S SMOKE COMPARTMENTS ARE SHOWN FOR REFERENCE ONLY.

LIFE SAFETY LEGEND

- EXISTING SMOKE PARTITION
- NEW SMOKE PARTITION
- EXISTING 1 HOUR FIRE BARRIER
- NEW 1 HOUR FIRE BARRIER
- EXISTING 1 HOUR FIRE BARRIER TO RESIST THE PASSAGE OF SMOKE
- NEW 1 HOUR FIRE BARRIER TO RESIST THE PASSAGE OF SMOKE
- NEW 2 HOUR FIRE BARRIER
- NEW 2 HOUR FIRE BARRIER TO RESIST THE PASSAGE OF SMOKE
- EXISTING 2 HOUR FIRE BARRIER TO RESIST THE PASSAGE OF SMOKE
- SMOKE BARRIER WITH FIRE RATING AS SHOWN ON PLAN FOR COMPARTMENTATION.
- NEW 3 HOUR FIRE BARRIER
- NEW 3 HOUR FIRE BARRIER TO RESIST THE PASSAGE OF SMOKE
- NEW PARTITION
- EXISTING PARTITION
- FIRE EXTINGUISHER & CABINET (SCREENED IF EXISTING)
- EXIT LOCATION AND WIDTH (IN INCHES) (SCREENED IF EXISTING)
- FIRE RATING OF DOOR IN MINUTES (SCREENED IF EXISTING)
- EXIT LIGHT FIXTURE W/ DIRECTION (SCREENED IF EXISTING)
- SOLID FILL DENOTES FACE OF EXIT FIXTURE
- ARROW DENOTES FACE OF EXIT FIXTURE W/ DIRECTIONAL ARROW
- FIRE EXTINGUISHER SURFACE MOUNTED (SCREENED IF EXISTING)
- EXISTING EXIT PASSAGEWAY
- OUT OF SCOPE
- EXTENT OF SUITE
- LONGEST ROUTE TO AN ADJACENT SMOKE COMPARTMENT
- LONGEST ROUTE TO AN EXIT

PERKINS & WILL
10100 North Central Expressway, Suite 300
Dallas, Texas 75231, USA
214.283.8700 Fax: 214.283.8701
www.perkinswill.com

Medical Center of Aurora

1501 S. Potomac
South Campus
Cath Lab
Aurora, Colorado 80012
HCA


Project # 306660005

in association with:

Structrual
TRC International, Ltd.
13800 MONTFORT DRIVE, SUITE 145
DALLAS, TX 75240
T: 972.991.1188
F: 972.991.1192

MEP
CCRD Partners
8301 E. PRENTICE AVENUE, SUITE 200
GREENWOOD VILLAGE, CO 80111
T: 303.694.4755
F: 303.694.5125

KEY PLAN
FIRST FLOOR

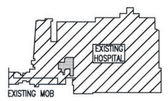

STATE OF COLORADO
TRUDY L. MCDUGAL
203601
LICENSED ARCHITECT
4-22-09

Revisions

NO.	ISSUE	DATE
1	ADDENDUM #2	04/22/09

Sheet Information

Date	03-06-2009
Job Number	142542.000
Drawn	HA
Checked	JMN
Approved	CG

Title

CODE COMPLIANCE PLAN – PARTIAL FIRST FLOOR


Sheet

A-0111

Issued for Construction


Copyright © 2005 PERKINS & WILL

Apr 21, 2009 - 2:53pm
P:\Dallas\142542.000 HCA Aurora Cath\CAD\SHEETS\A-0111.dwg
schmidtt

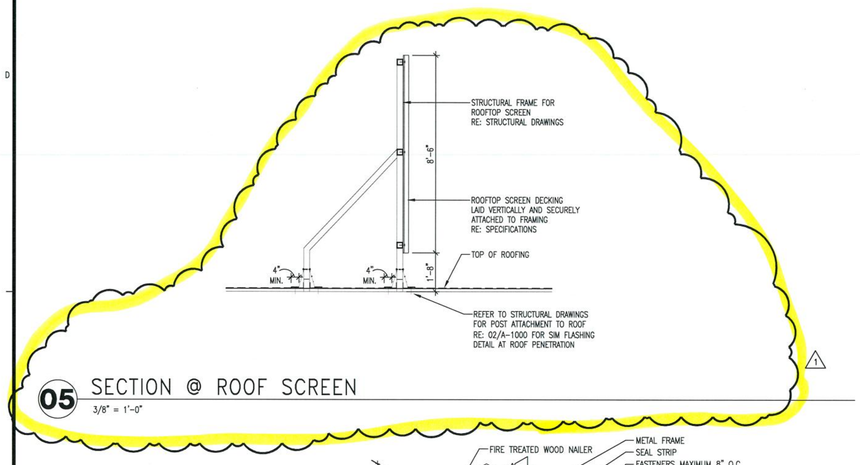


05 SECTION @ ROOF SCREEN

3/8" = 1'-0"

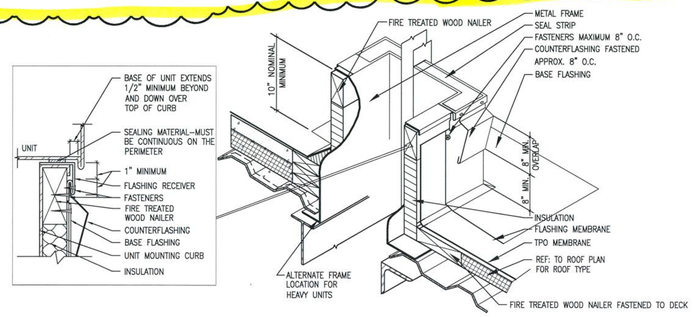


04 DETAIL @ ROOF CURB FLASHING

1 1/2" = 1'-0"

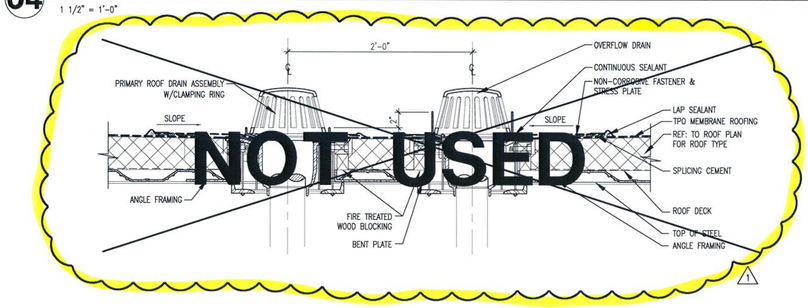


03 DETAIL @ ROOF AND OVERFLOW DRAINS

1 1/2" = 1'-0"

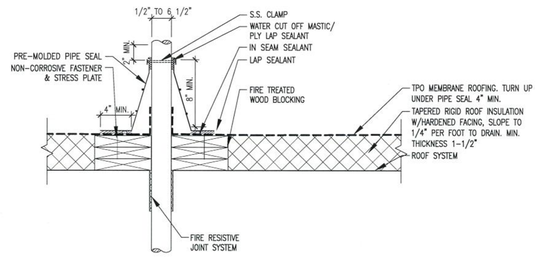

02 DETAIL @ ROOF PENTRATION

1 1/2" = 1'-0"

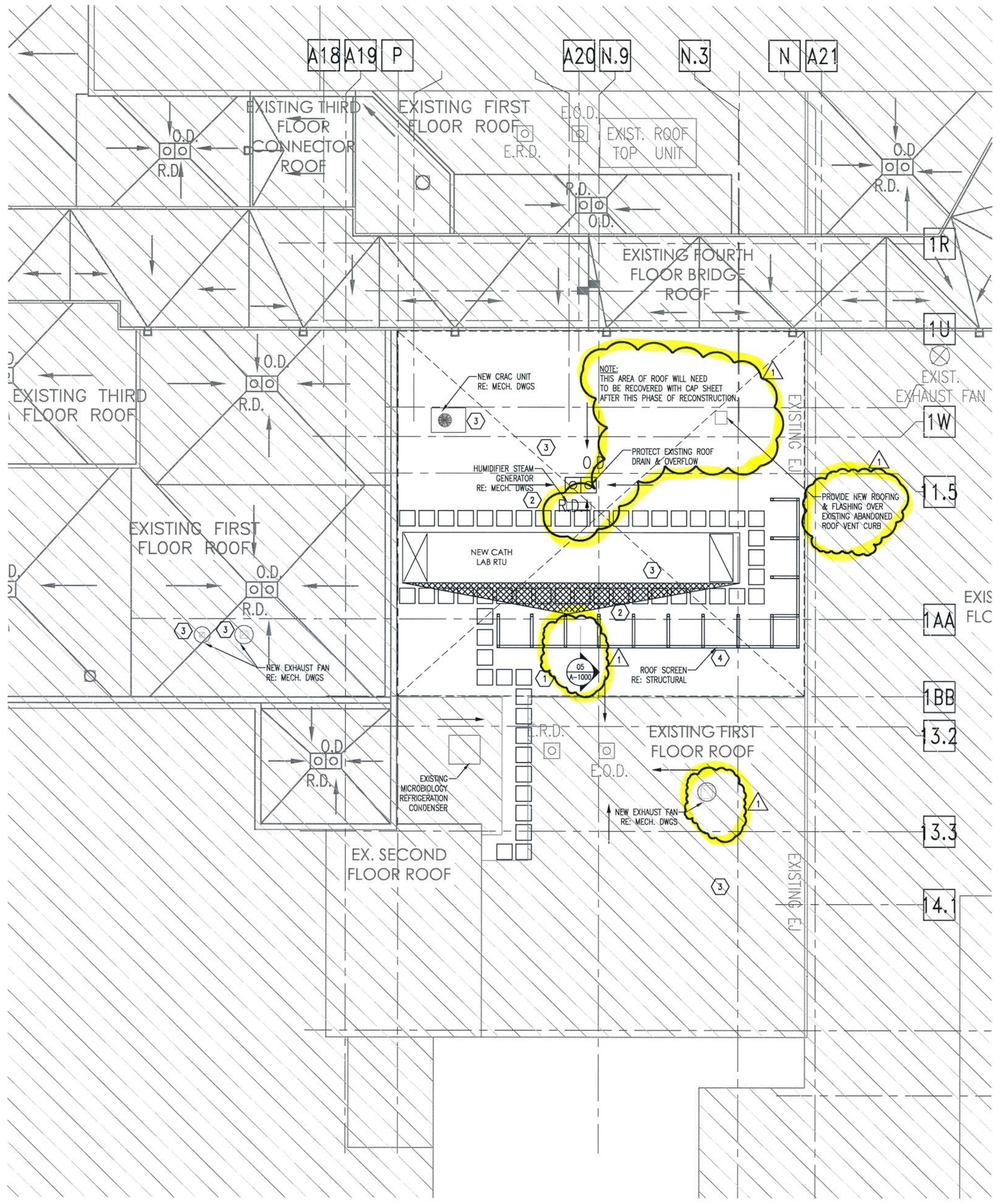

01 ARCHITECTURAL ROOF PLAN

1/8" = 1'-0"

ROOF PLAN GENERAL NOTES

1. REFER TO MECHANICAL, PLUMBING, AND ELECTRICAL FOR LOCATIONS OF PIPING, CURBS, VENTS, DUCTS, FANS, AND OTHER ITEMS ON THE ROOF SURFACE.
2. PAINT EXPOSED ROOF MOUNTED EQUIPMENT, PIPING, ETC., EXCEPT THOSE ITEMS WHICH ARE ALUMINUM OR STAINLESS STEEL. COLOR AS SELECTED BY ARCHITECT.
3. CUT EXISTING ROOF AS REQUIRED FOR EQUIPMENT INSTALLATION AND NEW ROOF. FLASH IN WITH NEW ROOFING MATERIAL TO MATCH EXISTING. COMPLY WITH ALL REQUIREMENTS OF MANUFACTURER OF EXISTING ROOF TO MAINTAIN CURRENT WARRANTY.
4. ALL ROOF FLASHING TO BE ACCORDING TO MANUFACTURER'S RECOMMENDATIONS.
5. PROVIDE CRICKETS AT NEW ROOF EQUIPMENT AND OTHER OBSTRUCTIONS TO
6. PROVIDE $\frac{1}{4}$"/FT MIN SLOPE TO DRAIN.
7. OVERFLOW ROOF DRAIN INLETS SHALL BE 2" ABOVE THE PRIMARY DRAIN INLETS.
8. RE: A-1000 FOR TYPICAL ROOF DETAILS.

ROOF PLAN LEGEND

E.O.D. / E.R.D.	EXISTING ROOF DRAIN AND OVERFLOW TO REMAIN
O.D. / R.D.	PRIMARY ROOF DRAIN (2'-0" FROM BEAM CENTERLINE TYP.) ROOF DRAIN SHALL BE AT THE LOW POINT OF THE ROOF. RE: A-1000 FOR OVERFLOW DRAIN (INLET TO BE SET AT 2" ABOVE THE PRIMARY ROOF DRAIN WITH A STANDARD 2" DAM). RE: A-1000
	ROOF WALK PADS
SLOPE	SLOPE FOR 1/4" PER FOOT MINIMUM FLOW TO DRAIN

ROOF PLAN NOTES BY NUMBER

1. PROVIDE NEW WALKWAY PADS TO CLOSEST EXISTING ACCESS ROUTE.
2. PROVIDE NEW INSULATION BOARD TO RE-SLOPE ROOF TO EXISTING DRAINS AROUND NEW HVAC UNIT.
3. MECHANICAL EQUIPMENT – RE: MEP MOUNTING FOR CURB AND TYPE OF ROOF CURB.
4. ROOF SCREEN – PROVIDE LOUVERED METAL PANEL SYSTEM PER SPEC. SECTION 07 42 14. ROOF SCREEN TO MATCH STYLE AND FINISH OF EXISTING SCREEN USED ON THE TOWER EXPANSION PROJECT.

Code violations found during inspection are required to be corrected. Plan/Permit issuance does not grant approval of code violation. 2006 IBC 105.4

Only highlighted or clouded revisions are approved on this review. All Previous comments apply.

09 399209

CITY OF AURORA
BUILDING DIVISION
APPROVED AS NOTED
DATE APPROVED JUN 17 2009
2006 IBC

PERKINS & WILL
10100 North Central Expressway, Suite 300
Dallas, Texas 75231, USA
214.283.8700 Fax: 214.283.8701
www.perkinswill.com

Medical Center of Aurora

1501 S. Potomac
South Campus
Cath Lab
Aurora, Colorado 80012
HCA

Project # 306660005


in association with:

Structrual
TRC International, Ltd.
13800 MONTFORT DRIVE, SUITE 145
DALLAS, TX 75240
T: 972.991.1198
F: 972.991.1192

MEP
CCRD Partners
8301 E. PRENTICE AVENUE, SUITE 200
GREENWOOD VILLAGE, CO 80111
T: 303.694.4755
F: 303.694.5125

KEY PLAN

FIRST FLOOR

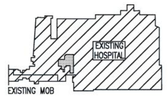

STATE OF COLORADO
TRUDY L. McCLOSKEY
203601
LICENSED ARCHITECT
4-22-09

Revisions

NO.	ISSUE	DATE
1	ADDENDUM #2	04-22-09

Sheet Information

Date	03-06-2009
Job Number	142542.000
Drawn	LTS
Checked	JMN
Approved	CG

Title

ARCHITECTURAL ROOF PLAN


Sheet

A-1000

Issued for Construction

Copyright © 2005 PERKINS & WILL

Apr 21, 2009 – 2:54pm
P:\Dallas\142542.000 HCA Aurora Cath\CAD\SHEETS\A-1000.dwg
schmidtt

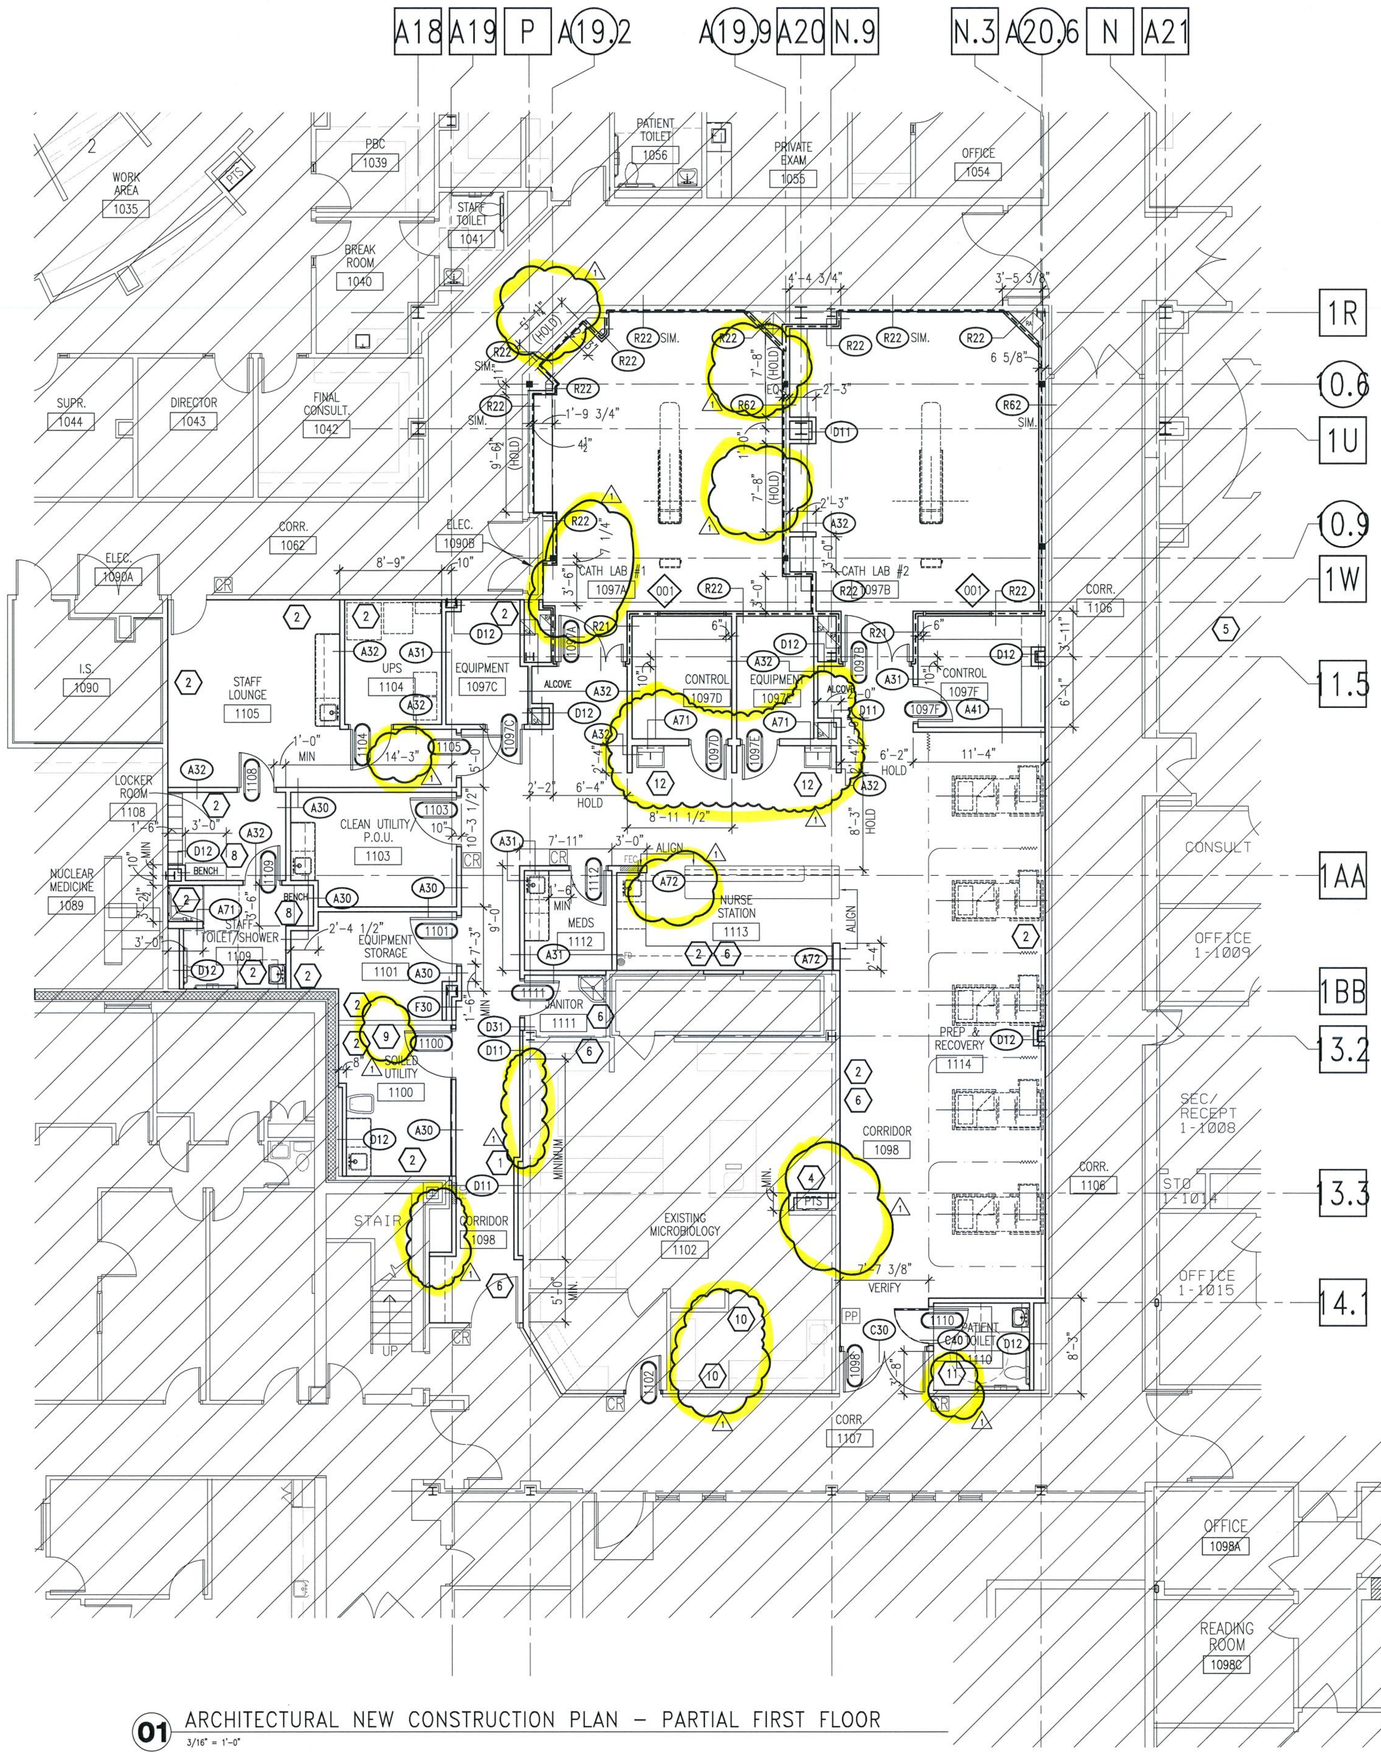

01 ARCHITECTURAL NEW CONSTRUCTION PLAN – PARTIAL FIRST FLOOR

3/16" = 1'-0"

FLOOR PLAN GENERAL NOTES

1. PARTITION TYPES ARE SCHEDULED IN THE A-81 SERIES. RE: A-0101 SHEET FOR GRAPHIC EXTENT OF FIRE RATED PARTITIONS. REFER TO PARTITION TYPE LEGENDS FOR LOCATION OF SOUND ATTENUATION BLANKETS.
2. REFER TO SHEET G-0001 FOR ADDITIONAL GENERAL NOTES.
3. ALL PARTITIONS ARE TYPE "A41" UNLESS OTHERWISE NOTED.
4. DIMENSIONS SHOWN ON THE FLOOR PLANS FOR NEW CONSTRUCTION ARE TO THE FACE OF FINISH OF INTERIOR WALLS, TO CENTER LINE OF COLUMNS AND TO FACE OF CONCRETE OR MASONRY WALLS, UNLESS OTHERWISE INDICATED. DIMENSIONS IN RENOVATED AREAS ARE FROM FINISH FACE OF EXISTING WALLS AND TO FINISH FACE OF NEW STUD WALLS, UNLESS OTHERWISE INDICATED.
5. WHERE NEW GYPSUM BOARD PARTITIONS ARE A CONTINUATION OF AN EXISTING PARTITION OR COLUMN ENCASEMENT, THE FACE OF THE NEW GYPSUM BOARD SHALL BE ALIGNED WITH THE FACE OF THE EXISTING SURFACE. WHERE A ONE HOUR PARTITION IS SHOWN AS A CONTINUATION OF A TWO-HOUR PARTITION OR COLUMN ENCASEMENT, THE FACE OF THE GYPSUM BOARD SHALL BE AUGNED. STUDS SHALL BE OFFSET AND ADDITIONAL LAYERS OF GYPSUM BOARD SHALL BE PROVIDED AS REQUIRED TO PROVIDE FACE ALIGNMENT OF GYPSUM BOARD.
6. CLINICAL SINKS SHALL BE MOUNTED SO THAT THE CENTERLINE OF THE SINK IS 1'-6" MINIMUM TO THE FACE OF THE ADJACENT FIXED EQUIPMENT, SIDE WALL, CASEWORK, ETC.
7. ALL PATIENT CORRIDORS AND PASSAGEWAYS SHALL BE 8'-0" MINIMUM CLEAR WIDTH.
8. SEE SHEET A-5600 FOR TYPICAL MOUNTING HEIGHTS OF PLUMBING FIXTURES AND TOILET ACCESSORIES.
9. LAVATORIES AND SINKS SHALL BE ACCOMPANIED BY A PAPER TOWEL DISPENSER "TA2" AND SOAP DISPENSER "TA8" UNLESS OTHERWISE NOTED ON ENLARGED FLOOR PLANS.
10. REFER TO SHEET A-5500 FOR MISCELLANEOUS DETAILS.
11. PROVIDE 1'-0" CLEAR FLOOR SPACE AT THE PUSH SIDE OF EVERY DOOR WITH A CLOSER. PROVIDE 1'-6" CLEAR AT THE PULL SIDE OF EVERY DOOR (EXCLUDING PATIENT BEDROOMS), UNLESS SPECIFICALLY DIMENSIONED OTHERWISE.
12. PROVIDE 1'-4" CHASE BEHIND SINGLE SIDED TOILETS, AND 1'-8" CHASE BETWEEN BACK TO BACK TOILETS, FOR WALL HUNG FIXTURES.
13. ALL LAVATORIES AND SINKS SHALL BE MOUNTED A MINIMUM OF 1'-3" FROM THE CENTERLINE OF THE FIXTURE TO THE FINISHED FACE OF THE ADJACENT PARTITION.
14. SEE OWNER FURNISHED CATH LAB VENDOR DRAWINGS FOR CRITICAL DIMENSIONS IN THESE AREAS.
15. REFER TO SHEET A-2101, "EQUIPMENT AND MILLWORK PLANS" FOR WALL PROTECTION LOCATIONS.
16. REFER TO SHEET A-5600 FOR ALL TOILET ACCESSORY SPECIFICATIONS AND HEIGHTS.
17. PROVIDE ROOM IDENTIFICATION SIGNAGE TO MATCH THE ROOM IDENTIFICATION SIGNAGE PROVIDED ON THE ADJACENT AURORA BED TOWER ADDITION PROJECT.

FLOOR PLAN LEGEND

- EXISTING PARTITION TO REMAIN
- NEW PARTITION
- EXISTING COLUMN
- F.V. FIELD VERIFY
- 1 / A-4100 SECTION TAG
- 001 INTERIOR WINDOW IDENTIFICATION RE: SHEET A-8200
- 1103 DOOR IDENTIFICATION RE: SHEET A-8200 FOR HEAD, JAMB & SILL DETAILS
- A31 WALL PARTITION TAG RE: SHEET A-8101
- C.T. CURTAIN TRACK RE: 02/A5500
- LEAD LINED WALL
- 01 / A-2000 ENLARGED FLOOR PLAN BUBBLE
- NOT IN SCOPE OF WORK
- CR CARD READER, FIXTURE AND FINAL CONNECTION BY SECURITY VENDOR. CONTRACTOR TO PROVIDE/INSTALL CONDUIT AND CABLE.
- KP KEYPAD BY DOOR HARDWARE SUPPLIER
- PP PUSH PAD DOOR ACTIVATOR BY DOOR HARDWARE SUPPLIER

FLOOR PLAN KEYNOTES

1. CONSTRUCT NEW WALL TO ALIGN W/FACE OF EXISTING WALL ELECTRIC MOUNTED PANELS.
2. ADD NEW LAYER OF 5/8" GYP. BD. TO FACE OF EXISTING WALL TO LIMIT OF 6" ABOVE CEILING. PATCH EXISTING GYP. BD. ABOVE THIS LOCATION.
3. NOT USED.
4. RELOCATE EXISTING PNEAUMATIC TUBE SYSTEM INTO EXISTING MICROBIOLOGY AREA AS SHOW. CONSTRUCT NEW TYPE A31 WALL AROUND RELOCATED TUBE SYSTEM.
5. EXISTING WAITING ROOM TO SERVICE AREA OF NEW CONSTRUCTION.
6. EXTEND EXTERIOR WALL SURFACE OF MICROBIOLOGY AREA TO DECK AND SEAL WITH SMOKE SEAL TO EXISTING STRUCTURE ABOVE.
7. NOT USED
8. PROVIDE NEW 18" HI, 24" DEEP ADA COMPLIANT FIXED BENCH. BENCH TO BE PLASTIC LAMINATE CLAD ON ALL EXPOSED VERTICAL SURFACES WITH SOLID SURFACE SEAT.
9. GENERAL CONTRACTOR TO MAINTAIN 1 HOUR RATING OF THIS WALL.
10. PATCH, REPAIR AND PAINT EXPOSED FRAMING.
11. ENSURE EXISTING 2 HOUR RATING.
12. HOLD SINK EDGE MINIMUM OF 4" FROM WALL.

Code violations found during inspection are required to be corrected. Plan/Permit issuance does not grant approval of code violation. 2006 IBC 105.4

Only highlighted or clouded revisions are approved on this review. All Previous comments apply.

CITY OF AURORA BUILDING DIVISION APPROVED AS NOTED DATE APPROVED JUN 17 2009 2006 IBC

09 399209

NOTE:
REVISED AND ADDED NUMEROUS WALL TYPE TAGS THROUGHOUT THE PLAN.

PERKINS & WILL

10100 North Central Expressway, Suite 300
Dallas, Texas 75231, USA
214.283.8700 Fax: 214.283.8701
www.perkinswill.com

Medical Center of Aurora

1501 S. Potomac
South Campus
Cath Lab
Aurora, Colorado 80012
HCA


Project # 306660005

In association with:

Structrual
TRC International, Ltd.
13800 MONTFORT DRIVE, SUITE 145
DALLAS, TX 75240
T: 972.991.1188
F: 972.991.1192

MEP
CCRD Partners
8301 E. PRENTICE AVENUE, SUITE 200
GREENWOOD VILLAGE, CO 80111
T: 303.694.4755
F: 303.694.5125

KEY PLAN
FIRST FLOOR

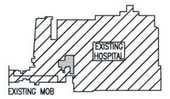

STATE OF COLORADO JULIAN C. MCDOUGAL 203601 LICENSED ARCHITECT
4-22-09

Revisions

1	ADDENDUM #2	04-22-09

NO.	ISSUE	DATE

Sheet Information

Date	03-06-2009
Job Number	142542.000
Drawn	LTS
Checked	JMN
Approved	CG

Title

ARCHITECTURAL NEW CONSTRUCTION PLAN PARTIAL FIRST FLOOR


Sheet

A-2001

Issued for Construction

Copyright © 2005 PERKINS & WILL

Apr 21, 2009 - 2:54pm
P:\Dallas\142542.000 HCA Aurora Cath\CAD\SHEETS\A-2001.dwg
schmidtt

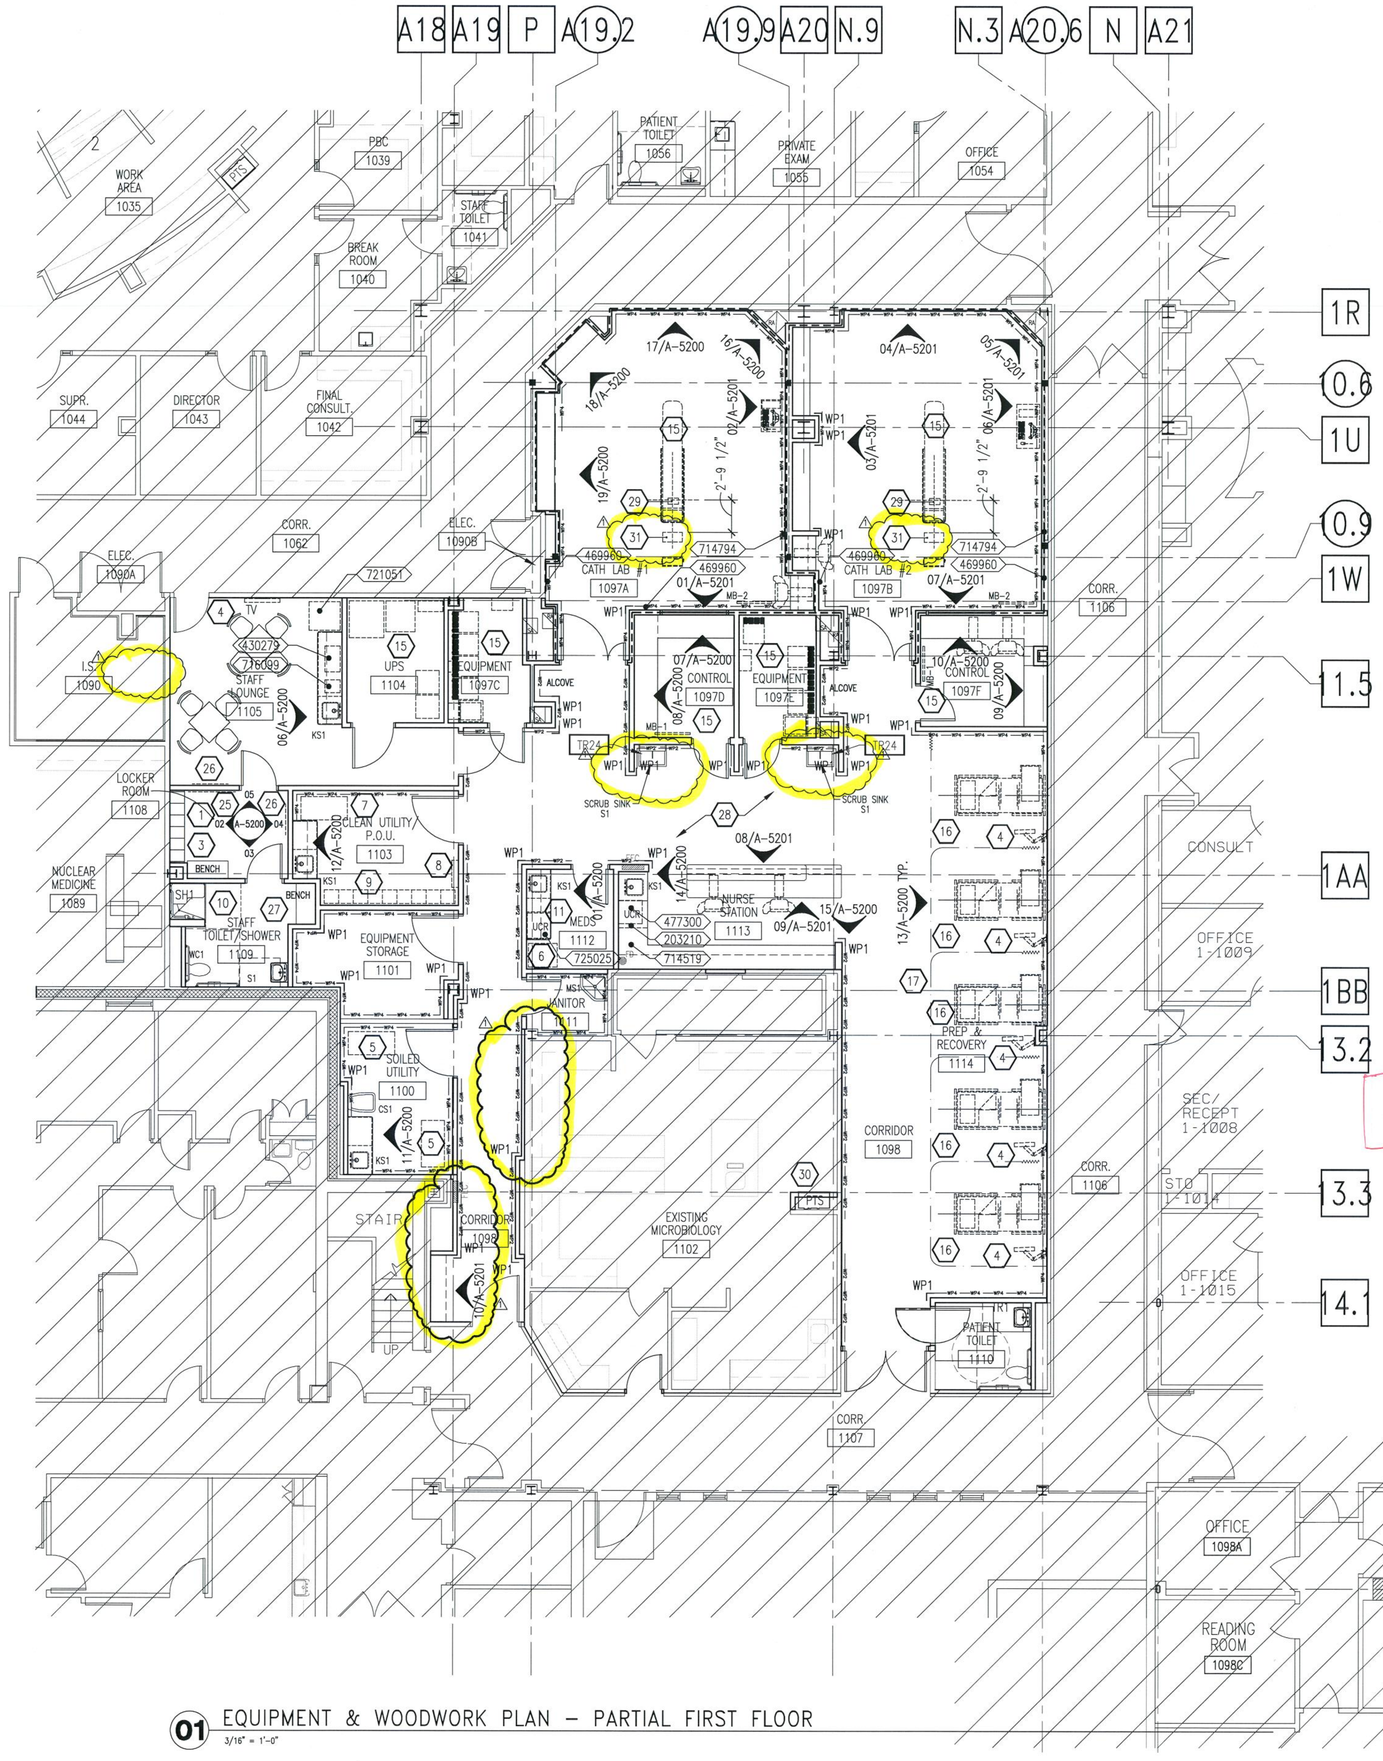

Code violations found during inspection are required to be corrected. Plan/Permit issuance does not grant approval of code violation. 2006 IBC 105.4

CITY OF AURORA
BUILDING DIVISION
APPROVED AS NOTED
DATE APPROVED JUN 17 2009
2006 IBC

09 399209

01 EQUIPMENT & WOODWORK PLAN – PARTIAL FIRST FLOOR

3/16" = 1'-0"

EQUIPMENT PLAN GENERAL NOTES

1. THE CONTRACTOR SHALL VERIFY AND COORDINATE CLEAR DIMENSIONS REQUIRED FOR OWNER FURNISHED EQUIPMENT THAT ARE LOCATED WITHIN OR ADJACENT TO ANY PIECE OF ARCHITECTURAL WOODWORK.
2. REFER TO FLOOR PLAN FOR WALL PROTECTION LOCATIONS.
3. ALL GLOVE DISPENSERS AND SHARPS CONTAINERS TO BE OWNER FURNISHED, OWNER INSTALLED.
4. CONTRACTOR SHALL SUPPLY BLOCKING FOR MOUNTING OF EQUIPMENT UNLESS MOUNTING SUPPORT IS OTHERWISE FURNISHED AS PART OF THE EQUIPMENT.
5. RE: SHEET A-5600 FOR TOILET ACCESSORY LEGEND.
6. RE: SHEET A-5400 FOR TYPICAL ARCHITECTURAL WOODWORK SECTIONS.
7. ALL SINKS TO RECEIVE A TA3 PAPER TOWEL DISPENSER (C.F.C.I.), AND A TAB SOAP DISPENSER (O.F.O.I.), U.N.O.
8. FOR ENLARGED TOILET ROOMS, AND RELATED TOILET ACCESSORIES, RE: SHEET A-5600.
9. ALL CEILING/AND OR WALL MOUNTED EQUIPMENT I.E.– TV'S, PROJECTOR'S ETC., SHALL BE MOUNTED AT 80" CLEAR ABOVE FINISHED FLOOR.
10. CONTRACTOR SHALL COORDINATE WITH OWNER ON DELIVERY AND INSTALLATION OF OWNER FURNISHED EQUIPMENT.
11. ALL KEYBOARD TRAYS SHALL BE C.F.C.I.
12. REFER TO EQUIPMENT RESPONSIBILITY MATRIX IN THE PROJECT MANUAL FOR CLARIFICATION OF RESPONSIBLE PARTY.
13. REFER TO SHEET A-5600 FOR MISCELLANEOUS EQUIPMENT MOUNTING HEIGHTS.
14. ALL CABINETS DRAWN IN PLAN AND SHOWN WITH AN ELEVATION MARK IN THE A-2101 ARE ARCHITECTURAL MILLWORK, EXCEPT FOR CATH LABS. U.N.O.
15. ALL FURNITURE SHOWN IN THESE PLANS IS FOR REFERENCE ONLY. FURNITURE SHALL BE PROVIDED BY END USER.

EQUIPMENT PLAN LEGEND

XXXX	OWNER FURNISHED EQUIPMENT DESIGNATION. REFER TO OWNER EQUIPMENT MANUAL FOR SPECIFICATION AND SHEET A-2101.
TA-X	TOILET ACCESSORY RE: SHEET A-5600 FOR LEGEND
	CONTRACTOR FURNISHED EQUIPMENT/ITEM
	OWNER FURNISHED OWNER INSTALLED EQUIPMENT/ITEM
	OWNER FURNISHED CONTRACTOR INSTALLED EQUIPMENT/ITEM
	NO GROMMETS ARE ALLOWED IN THIS COUNTERTOP SECTION (SHADED)
1/A-5200 WP1	INTERIOR ELEVATION TAG
WP2 WP2	WALL PROTECTION STYLE 1 – RE: SHEET A-5600
WP4 WP4	WALL PROTECTION STYLE 2 – RE: SHEET A-5600
ST1	WALL PROTECTION STYLE 4 – RE: SHEET A-5600
MB	STANDARD TOILET CONFIGURATION RE: SHEET A-5600
	MARKERBOARD

EQUIP. PLAN NOTES BY NUMBER

1. EMPLOYEE LOCKERS – RE: SPECIFICATIONS.
2. NOT USED
3. LOCKER ROOM BENCH – RE: SPECIFICATIONS.
4. TV & BRACKET – OWNER FURNISHED/CONTRACTOR INSTALLED (O.F.C.I.).
5. LINEN CART (O.F.O.I.)
6. MEDICINES DISPENSER (O.F.O.I.).
7. CRASH CART (O.F.O.I.).
8. SCANNER (O.F.O.I.).
9. BINS (O.F.O.I.).
10. SHOWER CURTAIN (O.F.O.I.) AND ROD (C.F.C.I.).
11. NOT USED
12. NOT USED
13. NOT USED
14. GC TO PROVIDE WATER LINE W/SHUTOFF VALVE AND CHROME ESCUTCHION AT WALL FOR COFFEE MAKER.
15. CATH LAB EQUIPMENT, REFER TO VENDOR DRAWINGS.
16. BEDS (O.F.O.I.).
17. CURTAINS (O.F.O.I.).
18. NOT USED
19. NOT USED
20. NOT USED
21. NOT USED
22. NOT USED
23. NOT USED
24. NOT USED
25. PROVIDE NEW 6'-0" HIGH x 24" WIDE TEMPERED PLATE GLASS BODY MIRROR (C.F.C.I.) W/ALUMINUM TRIM, MOUNTED SECURELY TO WALL IN LOCKER ROOM #1108.
26. PROVIDE NEW 4 HOOK COAT RACK (C.F.C.I.) AT 48" A.F.F.
27. REFER TO KEYNOTE #8 ON SHEET A-2001.
28. PROVIDE NEW ROOM IDENTIFICATION SIGNAGE TO MATCH THE ROOM IDENTIFACTION SIGNAGE PROVIDED ON THE ADJACENT AURORA BED TOWER ADDITION PROJECT FOR ENTIRE SUITE.
29. PROVIDE NEW MEDICAL GAS PEDESTAL. PROVIDE (2) 2" BUSHINGS BELOW OUTLETS ON SOUTH SIDE OF PEDESTAL TO PROVIDE CABLE PULL FOR VENDOR/FACILITY EQUIPMENT. COORDINATE EXACT LOCATION WITH VENDOR DRAWINGS.
30. NEW LOCATION FOR EXISTING RELOCATED PNEUMATIC TUBE SYSTEM.
31. NEW LOCATION FOR MEDICAL GAS PEDESTAL. RE: MEP.

Only highlighted or clouded revisions are approved on this review. All Previous comments apply.

NOTE:
REWORKED KEYNOTES TO INCORPORATE EQUIPMENT TAGS.

PERKINS & WILL
10100 North Central Expressway, Suite 300
Dallas, Texas 75231, USA
214.283.8700 Fax: 214.283.8701
www.perkinswill.com


Medical Center of Aurora
1501 S. Potomac
South Campus
Cath Lab
Aurora, Colorado 80012
HCA
Project # 306660005

in association with:

Structrual
TRC International, Ltd.
13800 MONTFORT DRIVE, SUITE 145
DALLAS, TX 75240
T: 972.991.1188
F: 972.991.1192

MEP
CCRD Partners
8301 E. PRENTICE AVENUE, SUITE 200
GREENWOOD VILLAGE, CO 80111
T: 303.694.4755
F: 303.694.5125

KEY PLAN
FIRST FLOOR

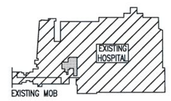

STATE OF COLORADO
TRUDY L. McDOUGAL
203601
LICENSED ARCHITECT
4.22.09

Revisions

NO.	ISSUE	DATE
1	ADDENDUM #2	04-22-09

Sheet Information

Date	03-06-2009
Job Number	142542.000
Drawn	LTS
Checked	JMN
Approved	CG

Title

EQUIPMENT AND WOODWORK PLAN PARTIAL FIRST FLOOR


Sheet

A-2101

Issued for Construction

Copyright © 2005 PERKINS & WILL

Apr 21, 2009 – 2:55pm
P:\Dallas\142542.000 HCA Aurora Cath\CAD\SHEETS\A-2101.dwg
schmidtt

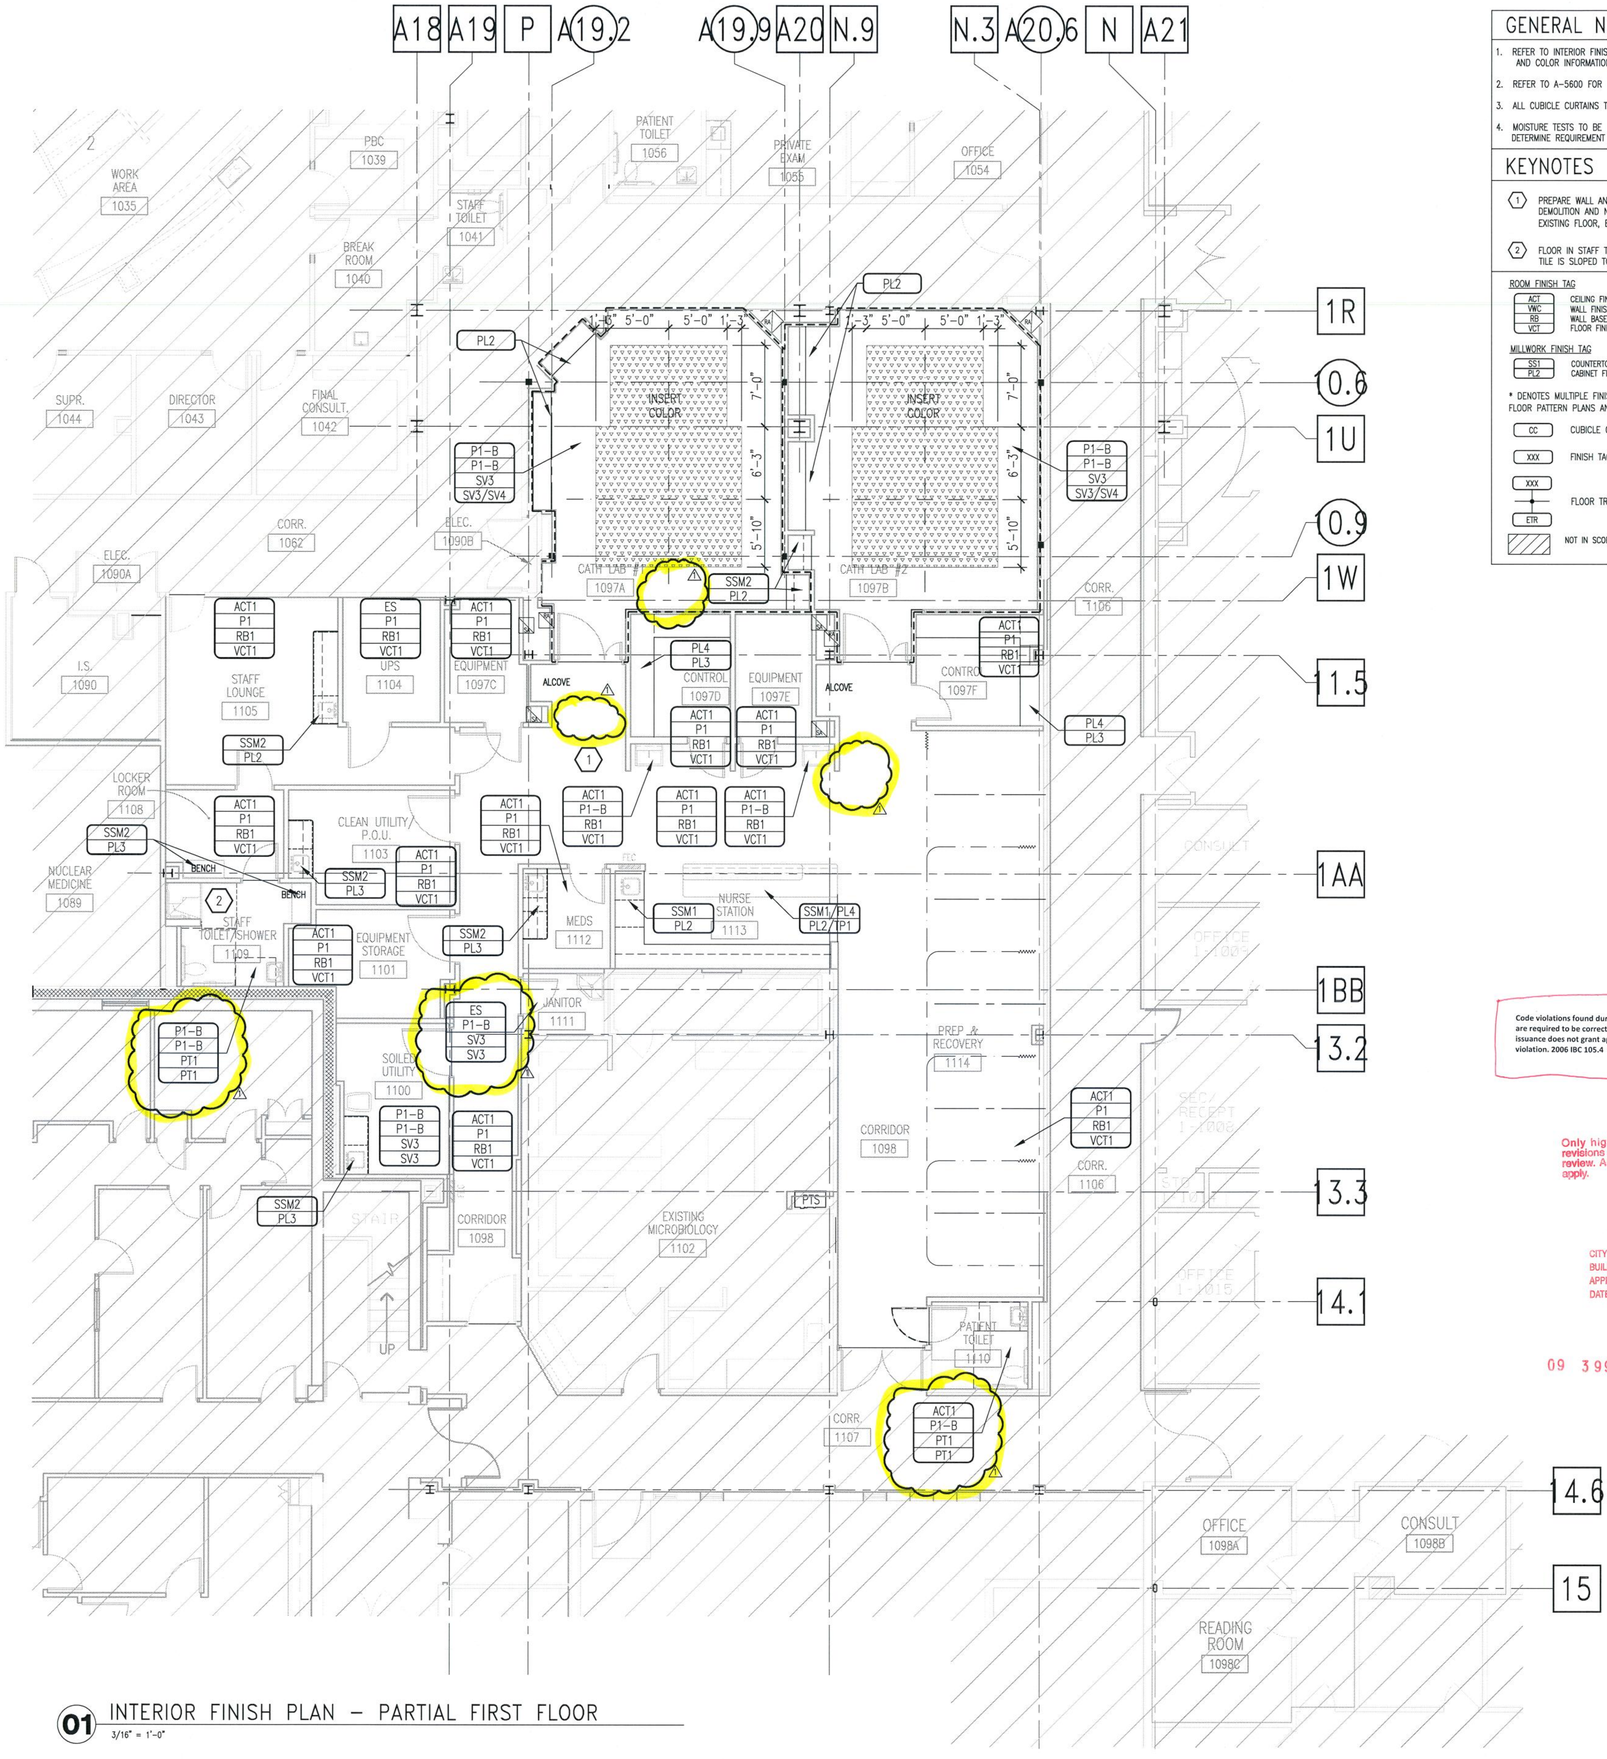

01 INTERIOR FINISH PLAN – PARTIAL FIRST FLOOR

3/16" = 1'-0"

GENERAL NOTES

1. REFER TO INTERIOR FINISH LEGEND A-8000 FOR FINISH MANUFACTURER AND COLOR INFORMATION.
2. REFER TO A-5600 FOR FLOOR TRANSITION DETAILS.
3. ALL CUBICLE CURTAINS TO BE CC1.
4. MOISTURE TESTS TO BE PERFORMED BELOW ALL NEW FLOOR FINISHES TO DETERMINE REQUIREMENT OF WATER VAPOR OMISSION CONTROL SYSTEM.

KEYNOTES

1. PREPARE WALL AND/OR FLOOR TO RECEIVE NEW FINISHES PER DEMOLITION AND NEW CONSTRUCTION PLANS. PATCH TO MATCH EXISTING FLOOR, BASE, WALL AND/OR CEILING FINISHES
2. FLOOR IN STAFF TOILET/SHOWER TO BE FLOATED TO ENSURE THAT TILE IS SLOPED TO FLOOR DRAIN.

ROOM FINISH TAG

ACT	CEILING FINISH
VWC	WALL FINISH
RB	WALL BASE FINISH
VCT	FLOOR FINISH

MILLWORK FINISH TAG

SS1	COUNTERTOP
PL2	CABINET FRONT/ VERTICAL SURFACE

* DENOTES MULTIPLE FINISHES. PLEASE REFER TO ENLARGED PLANS, FLOOR PATTERN PLANS AND/OR ELEVATIONS FOR INFORMATION.

CC	CUBICLE CURTAIN	ETR	EXISTING TO REMAIN
XXX	FINISH TAG	WT	WINDOW TREATMENT
XXX / ETR	FLOOR TRANSITION TAG	X	KEYNOTE
	NOT IN SCOPE OF WORK		

Code violations found during inspection are required to be corrected. Plan/Permit issuance does not grant approval of code violation. 2006 IBC 105.4

Only highlighted or clouded revisions are approved on this review. All Previous comments apply.

CITY OF AURORA
BUILDING DIVISION
APPROVED AS NOTED
DATE APPROVED JUN 17 2009
2006 IBC

09 399209

PERKINS & WILL

10100 North Central Expressway, Suite 300
Dallas, Texas 75231, USA
214.283.8700 Fax: 214.283.8701
www.perkinswill.com

Medical Center of Aurora

1501 S. Potomac
South Campus
Cath Lab
Aurora, Colorado 80012
HCA

Project # 306660005

in association with:

Structrual
TRC International, Ltd.
13800 MONTFORT DRIVE, SUITE 145
DALLAS, TX 75240
T: 972.991.1188
F: 972.991.1192

MEP
CCRD Partners
8301 E. PRENTICE AVENUE, SUITE 200
GREENWOOD VILLAGE, CO 80111
T: 303.694.4755
F: 303.694.5125

KEY PLAN
FIRST FLOOR



STATE OF COLORADO
TIMOTHY J. McDOUGAL
203601
LICENSED ARCHITECT
4-22-09

Revisions

NO.	ISSUE	DATE
1	ADDENDUM #2	04-22-09

Sheet Information

Date	03-06-2009
Job Number	142542.000
Drawn	CR/JB
Checked	JMN
Approved	CG

Title

INTERIOR FINISH PLAN PARTIAL FIRST FLOOR


Sheet

A-2201

Issued for Construction

Copyright © 2005 PERKINS & WILL

Apr 21, 2009 - 2:56pm
P:\Dallas\142542.000 HCA Aurora Cath\CAD\SHEETS\A-2201.dwg
schmidtt

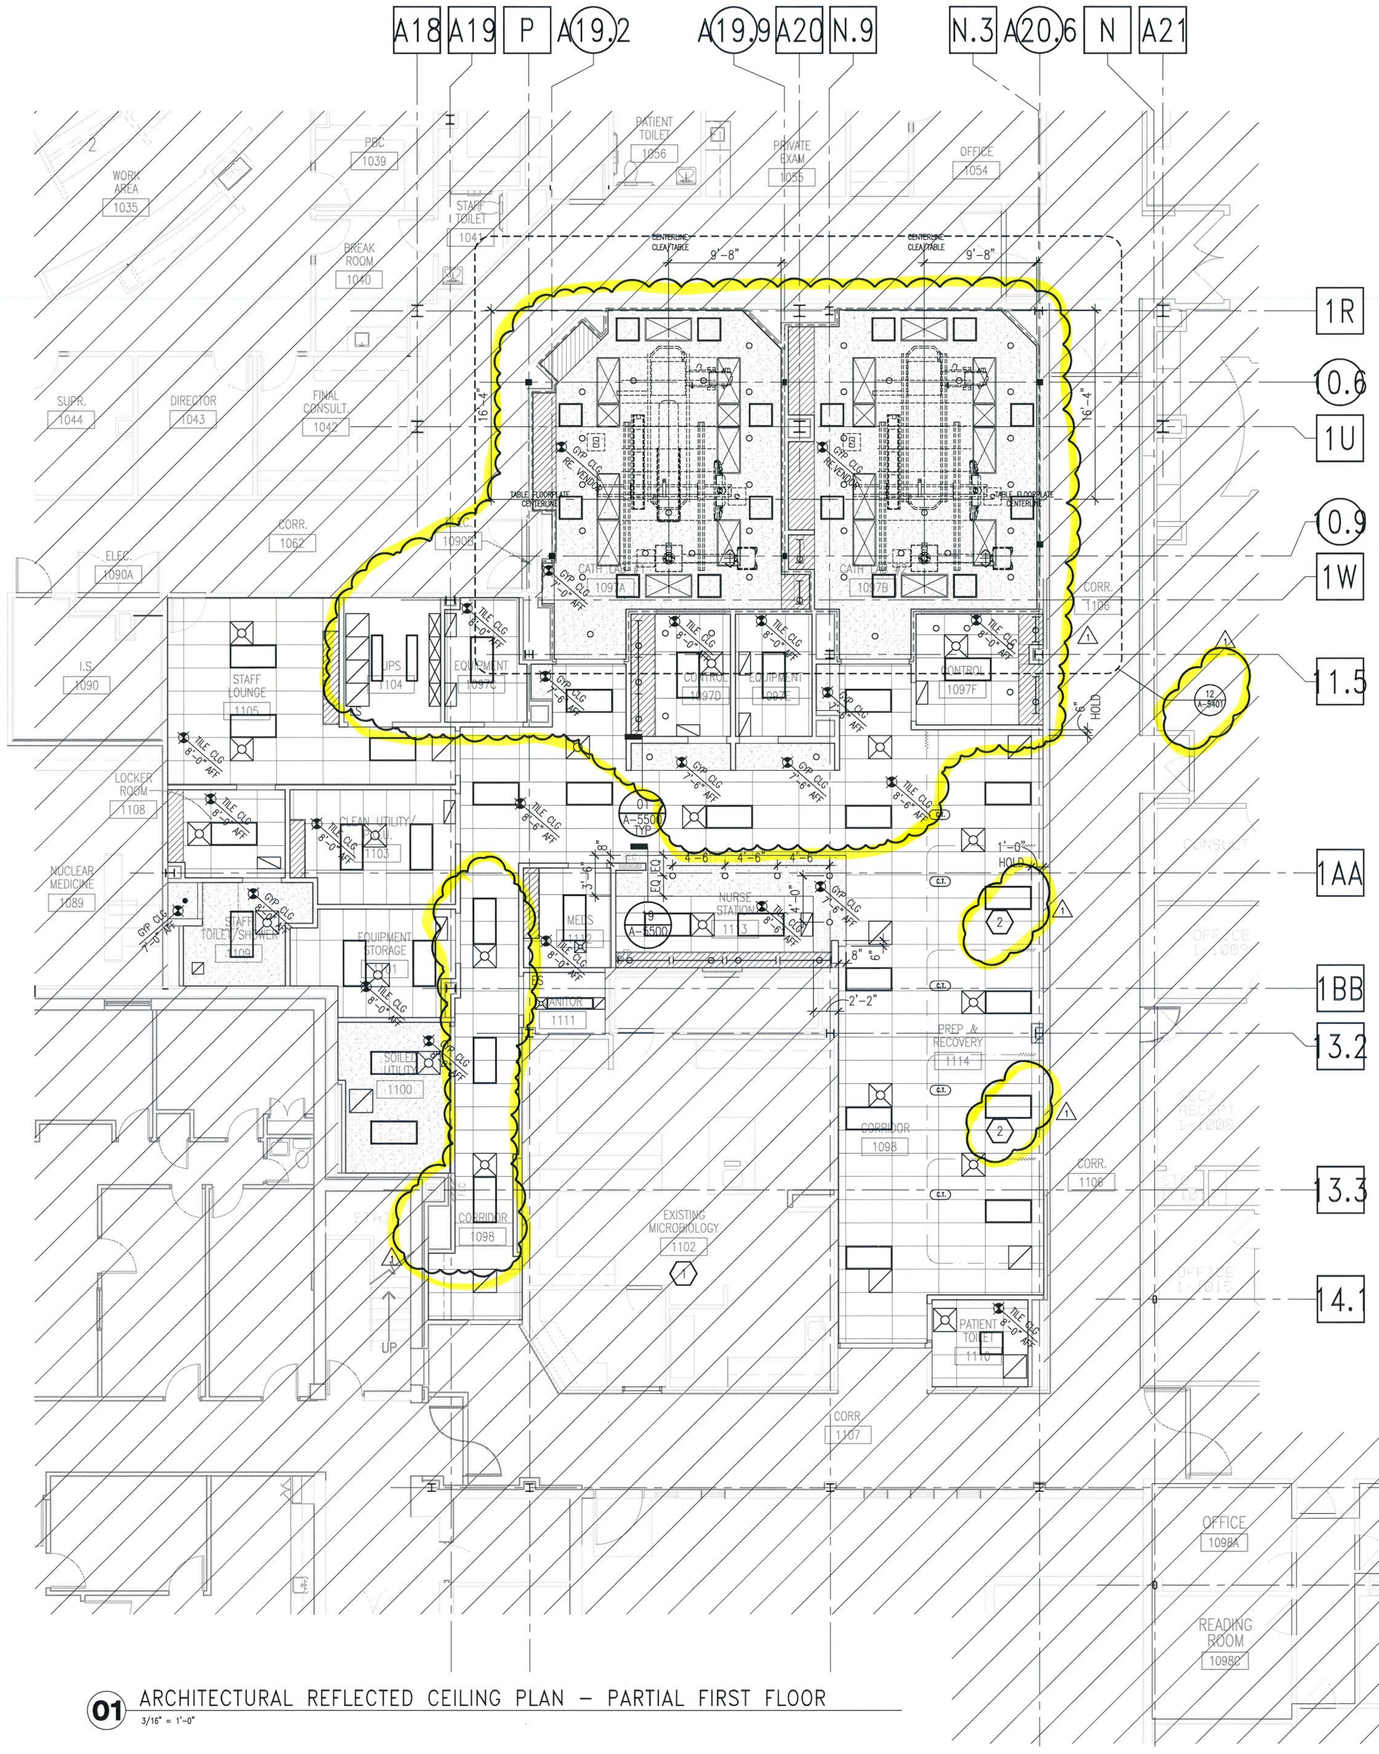

01 ARCHITECTURAL REFLECTED CEILING PLAN – PARTIAL FIRST FLOOR

3/16" = 1'-0"

RCP PLAN GENERAL NOTES

1. THE CONTRACTOR SHALL COMPARE THIS REFLECTED CEILING PLAN WITH ELECTRICAL LIGHTING PLANS, MECHANICAL SUPPLY, RETURN, AND EXHAUST PLANS. THE CONTRACTOR SHALL REPORT ANY OMISSIONS OR INCONSISTENCIES TO THE ARCHITECT.
2. SEE ELECTRICAL DRAWINGS FOR THE LOCATIONS OF CEILING MOUNTED SMOKE DETECTORS, SPEAKERS, NURSE CALL DOME LIGHTS, EXIT SIGNAGE, FIRE ALARM DEVICES, ETC. ALSO SEE ELECTRICAL FOR LOCATIONS OF WALL MOUNTED EXIT LIGHTS.
3. FOR FURTHER DIMENSIONS SEE LARGE SCALE PLANS, SECTIONS, ELEVATIONS, AND DETAILS.
4. SPRINKLER HEAD LOCATIONS ARE NOT SHOWN ON ARCHITECTURAL REFLECTED CEILING PLANS. CONTRACTOR TO INSTALL SUFFICIENT HEADS IN ALL SPACES TO PROVIDE 100% COVERAGE AS REQUIRED UNDER NFPA 13 AND OWNERS INSURANCE COMPANIES' REQUIREMENTS. HEADS SHALL BE LOCATED IN THE CENTER OF CEILING TILES, U.N.O.
5. THE CONTRACTOR SHALL VERIFY THAT ACCESS PANELS OF TYPE SPECIFIED ARE INSTALLED IN NON-ACCESSIBLE TYPE CEILINGS WHERE SERVICE OR ADJUSTMENT TO MECHANICAL, PLUMBING, OR ELECTRICAL ITEMS MAY BE REQUIRED. ACCESS PANELS SHALL BE THE FIRE RATED TYPE EQUAL TO THE RATING OF THE WALL OR CEILING IN WHICH THEY OCCUR.
6. 18" MINIMUM VERTICAL CLEARANCE SHALL BE MAINTAINED BETWEEN THE BOTTOM OF THE EXTENDED SPRINKLER HEADS AND THE TOP OF ANY FILES, SHELVING, LOCKERS, ETC.
7. RELOCATE SUPPLY DRAIN AND VENT PIPES TO MAINTAIN SCHEDULED CEILING HEIGHTS. COORDINATE RELOCATIONS WITH MEP ENGINEERS.
8. WHERE EXISTING LAY-IN CEILINGS ARE TO REMAIN, THE CONTRACTOR SHALL REPLACE ANY TILE THAT HAS BEEN DAMAGED WITH MATERIALS THAT MATCH THE EXISTING FOR COLOR, TEXTURE, PATTERN, ETC. IF UNIFORMITY CANNOT BE ACHIEVED, THE CONTRACTOR SHALL REPLACE THE ENTIRE CEILING WITHIN THE SPACE WITH NEW MATERIAL. GENERAL CONTRACTOR SHALL PROVIDE ENOUGH NEW CEILING TILE TO REPLACE 50% OF TILE TO MATCH EXISTING IN THE MICROBIOLOGY AREA ROOM #1102.

RCP LEGEND

- SUSPENDED 2' X 4' ACOUSTICAL CEILING SYSTEM
- SUPPLY AIR GRILLE RE: MECHANICAL DRAWINGS FOR ADDITIONAL INFORMATION
- RETURN AIR GRILLE RE: MECHANICAL DRAWINGS FOR ADDITIONAL INFORMATION
- EXHAUST AIR GRILLE RE: MECHANICAL DRAWINGS FOR ADDITIONAL INFORMATION
- SUPPLY STRIP DIFFUSER RE: MECHANICAL
- C.J SOFFIT/GYP. BD./PLASTER CONTROL JOINT
- 1 / A-5000 DETAIL TAG
- MATL 8'-0" AFF CEILING HEIGHT DESIGNATION PER AREA IN PUBLIC AND STAFF TOILETS WHERE NO HEIGHT IS DESIGNATED, 8'-0".
- C.T. CUBICLE CURTAIN TRACK
- GYP. BD. FURRDOWN @ CASEWORK (RE: 01/A-5500 TYP.)
- SURFACE MOUNTED FLUORESCENT LIGHT FIXTURE
- RECESSED CAN LIGHT FIXTURE
- SHOWER DOME LIGHT (BY SHOWER MANUFACTURER).
- UNDER CABINET TASK LIGHTING
- GYP. BD. CEILING OR SUSPENDED CEMENT PLASTER SOFFIT
- ES EXPOSED STRUCTURE
- MS MEDICAL SUPPORT SYSTEM. COORDINATE WITH VENDOR. RE. SPECS.

RCP NOTES BY NUMBER

1. GENERAL CONTRACTOR TO PROVIDE ENOUGH CEILING TILE TO MATCH EXISTING, FOR 50% REPLACEMENT OF TILE IN MICROBIOLOGY ROOM #1102.
2. CUT CEILING GRID MAIN TEE TO ALLOW LIGHT FIXTURE TO BE CENTERED OVER BED.

Code violations found during inspection are required to be corrected. Plan/Permit issuance does not grant approval of code violation. 2006 IBC 105.4

Only highlighted or clouded revisions are approved on this review. All Previous comments apply.

09 399209

CITY OF AURORA
BUILDING DIVISION
APPROVED AS NOTED
DATE APPROVED JUN 17 2009
2006 IBC

PERKINS & WILL
10100 North Central Expressway, Suite 300
Dallas, Texas 75231, USA
214.283.8700 Fax: 214.283.8701
www.perkinswill.com

Medical Center of Aurora

1501 S. Potomac
South Campus
Cath Lab
Aurora, Colorado 80012
HCA


Project # 306660005

In association with:

Structrual
TRC International, Ltd.
13800 MONTFORT DRIVE, SUITE 145
DALLAS, TX 75240
T: 972.991.1188
F: 972.991.1192

MEP
CCRD Partners
8301 E. PRENTICE AVENUE, SUITE 200
GREENWOOD VILLAGE, CO 80111
T: 303.694.4755
F: 303.694.5125

KEY PLAN
FIRST FLOOR

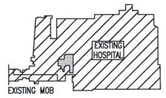

STATE OF COLORADO
TRUDY E. MCDOUGAL
203601
LICENSED ARCHITECT
4-22-09

Revisions

NO.	ISSUE	DATE
1	ADDENDUM #2	04-22-09

Sheet Information

Date	03-06-2009
Job Number	142542.000
Drawn	LTS
Checked	JMN
Approved	CG

Title

ARCHITECTURAL REFLECTED CEILING PLAN PARTIAL FIRST FLOOR


Sheet

A-2401


Issued for Construction

Copyright © 2005 PERKINS & WILL


Apr 21, 2009 - 2:56pm
P:\Jobs\142542.000 HCA Aurora Cath\CAD\SHEETS\A-2401.dwg
schmidt

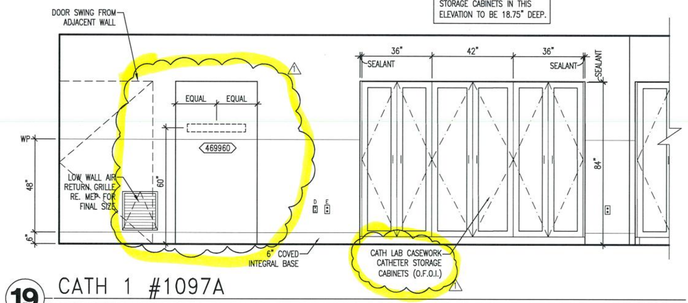


19 CATH 1 #1097A
3/8" = 1'-0"
CATH LAB

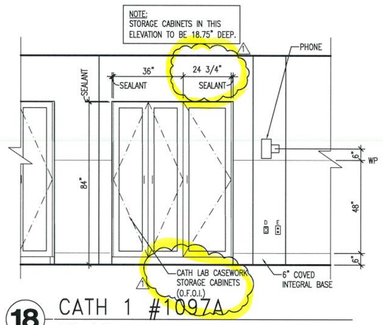

18 CATH 1 #1097A
3/8" = 1'-0"
CATH LAB

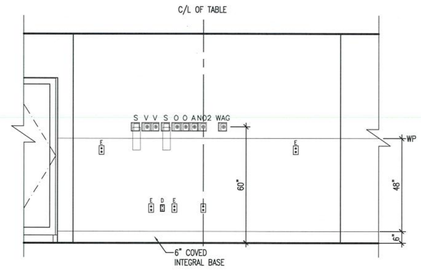


17 CATH 1 #1097A
3/8" = 1'-0"
CATH LAB

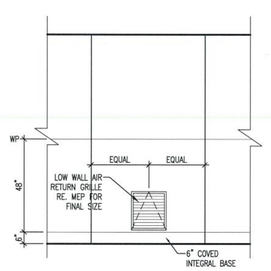


16 CATH 1 #1097A
3/8" = 1'-0"
CATH LAB


Code violations found during inspection are required to be corrected. Plan/Permit issuance does not grant approval of code violation. 2006 IBC 105.4

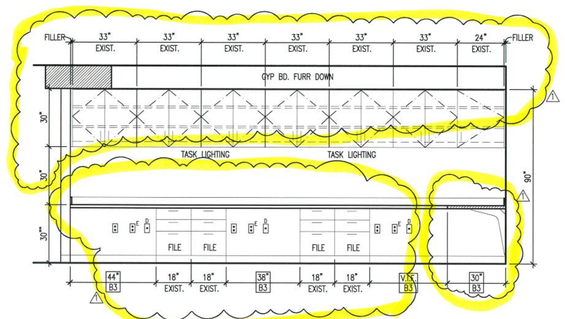


15 NURSE STATION BACK COUNTER #1113
3/8" = 1'-0"

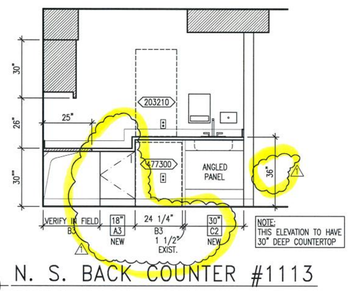


14 N. S. BACK COUNTER #1113
3/8" = 1'-0"

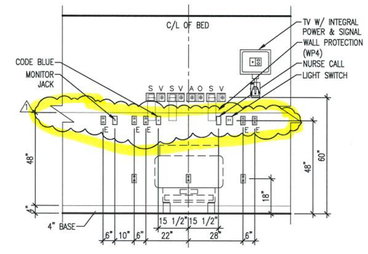


13 RECOVERY ROOM #1098
3/8" = 1'-0"

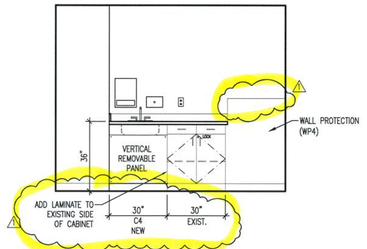


12 POINT OF USE #1103
3/8" = 1'-0"

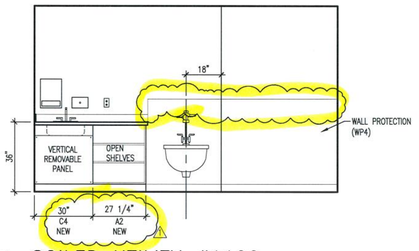


11 SOILED UTILITY #1100
3/8" = 1'-0"

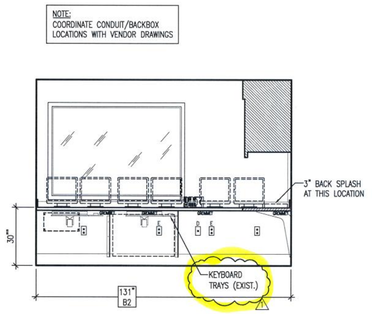


10 CONTROL ROOM #1097F
3/8" = 1'-0"

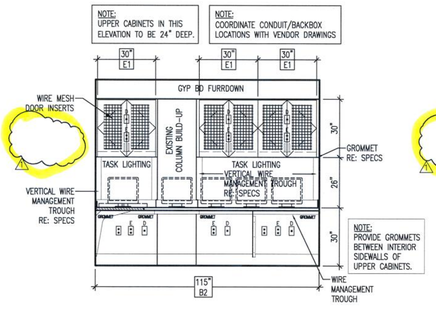


09 CONTROL ROOM #1097F
3/8" = 1'-0"

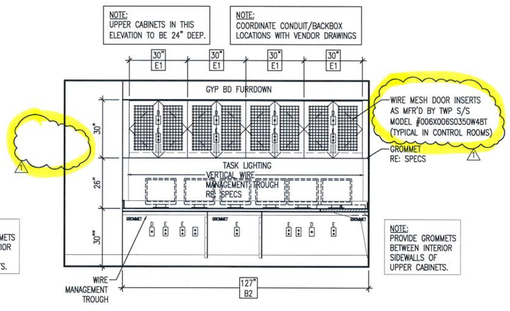

08 CONTROL ROOM #1097D
3/8" = 1'-0"

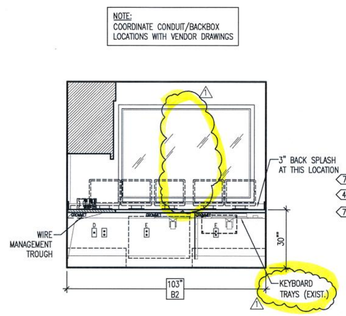


07 CONTROL ROOM #1097D
3/8" = 1'-0"

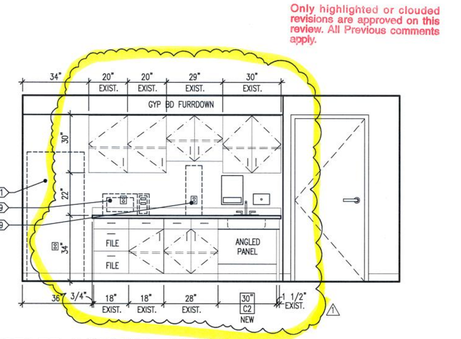


06 STAFF LOUNGE #1105
3/8" = 1'-0"


09 399209

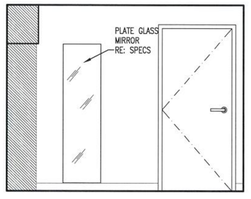


05 LOCKER ROOM #1108
3/8" = 1'-0"

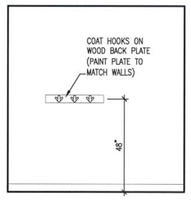


04 LOCKER ROOM #1108
3/8" = 1'-0"

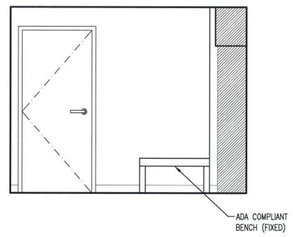

03 LOCKER ROOM #1108
3/8" = 1'-0"

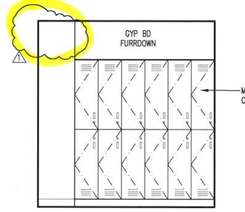

02 LOCKER ROOM #1108
3/8" = 1'-0"

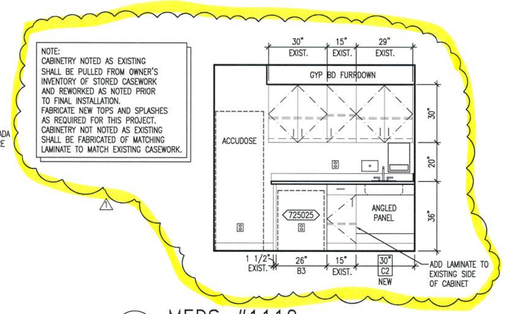

01 MEDS #1112
3/8" = 1'-0"

Only highlighted or clouded revisions are approved on this review. All Previous comments apply.

CITY OF AURORA
BUILDING DIVISION
APPROVED AS NOTED
DATE APPROVED JUN 17 2009
2006 IBC

PERKINS & WILL
10100 North Central Expressway, Suite 300
Dallas, Texas 75231, USA
214.283.8700 Fax: 214.283.8701
www.perkinswill.com

Medical Center of Aurora

1501 S. Potomac
South Campus
Cath Lab
Aurora, Colorado 80012
HCA

Project # 306660005

In association with:

Structrual
TRC International, Ltd.
13800 MONTFORT DRIVE, SUITE 145
DALLAS, TX 75240
T: 972.991.1188
F: 972.991.1192

MEP
CCRD Partners
8301 E. PRENTICE AVENUE, SUITE 200
GREENWOOD VILLAGE, CO 80111
T: 303.694.4755
F: 303.694.5125

STATE OF COLORADO
RUBY MOSQUEDA
203601
LICENSED ARCHITECT
4-22-09

Revisions

1	ADDENDUM #2	04-22-09

NO.	ISSUE	DATE

Sheet Information

Date	03-06-2009
Job Number	142542.000
Drawn	LTS
Checked	JMN
Approved	CG

Title

ARCHITECTURAL INTERIOR ELEVATIONS


Sheet

A-5200


Issued for Construction

Copyright © 2005 PERKINS & WILL


Apr 21, 2009 - 2:57pm
P:\Dallas\142542.000 HCA Aurora Cath\CAD\SHEETS\A-5200.dwg
schmidtt

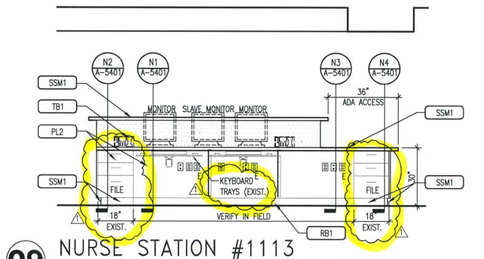


09 NURSE STATION #1113
3/8" = 1'-0"

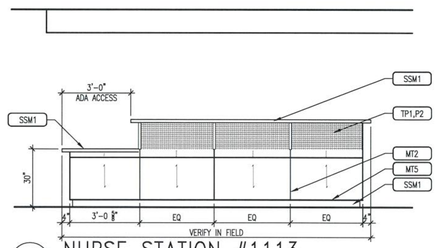

08 NURSE STATION #1113
3/8" = 1'-0"

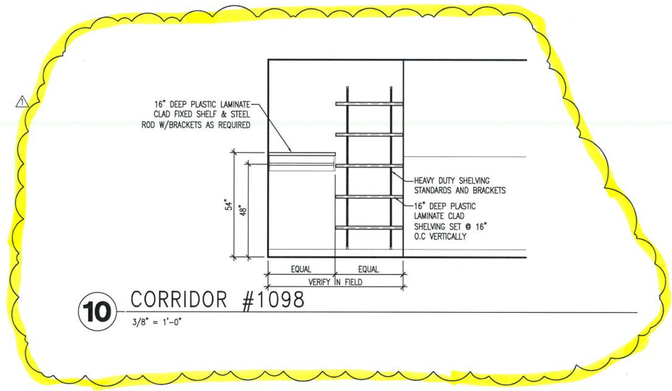


10 CORRIDOR #1098
3/8" = 1'-0"

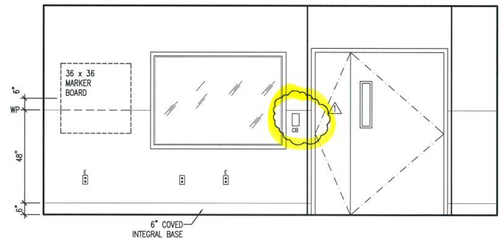


07 CATH 2 #1097B
3/8" = 1'-0"
CATH LAB


Code violations found during inspection are required to be corrected. Plan/Permit issuance does not grant approval of code violation. 2006 IBC 105.4

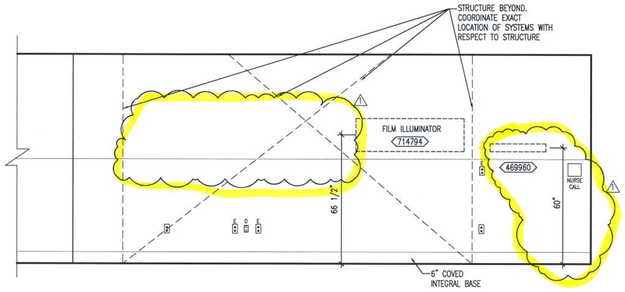

06 CATH 2 #1097B
3/8" = 1'-0"
CATH LAB

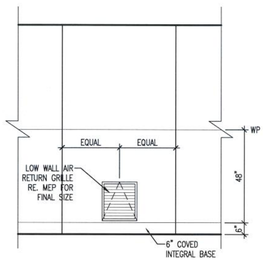


05 CATH 2 #1097B
3/8" = 1'-0"
CATH LAB

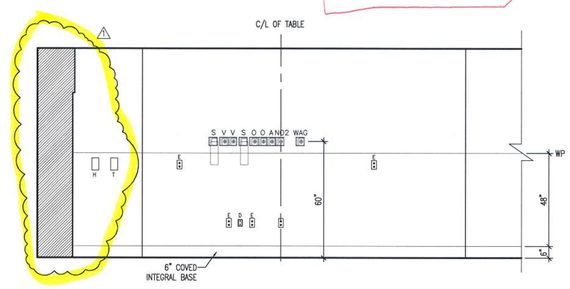


04 CATH 2 #1097B
3/8" = 1'-0"
CATH LAB

Only highlighted or clouded revisions are approved on this review. All Previous comments apply.


09 399209

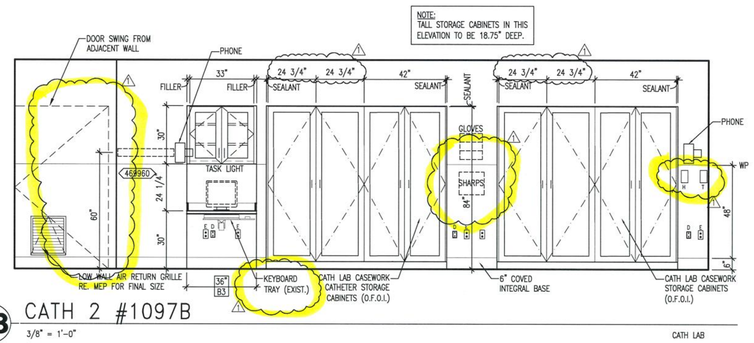

03 CATH 2 #1097B
3/8" = 1'-0"
CATH LAB

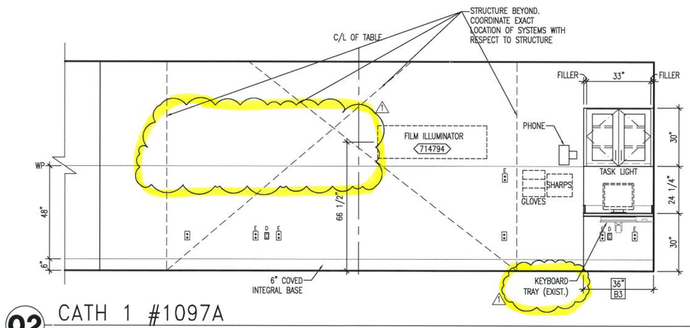

02 CATH 1 #1097A
3/8" = 1'-0"
CATH LAB

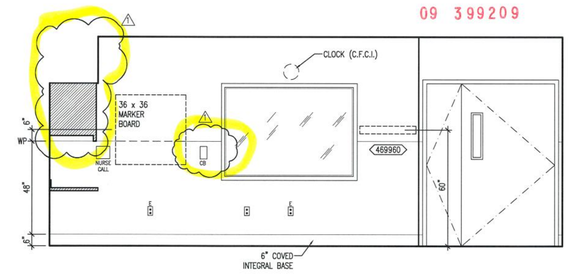

01 CATH 1 #1097A
3/8" = 1'-0"
CATH LAB

CITY OF AURORA
BUILDING DIVISION
APPROVED AS NOTED
DATE APPROVED JUN 17 2009
2006 IBC

PERKINS & WILL
10100 North Central Expressway, Suite 300
Dallas, Texas 75231, USA
214.283.8700 Fax: 214.283.8701
www.perkinswill.com

Medical Center of Aurora

1501 S. Potomac
South Campus
Cath Lab
Aurora, Colorado 80012
HCA

Project # 306660005

In association with:

Structrual
TRC International, Ltd.
13800 MONTFORT DRIVE, SUITE 145
DALLAS, TX 75240
T: 972.991.1188
F: 972.991.1192

MEP
CCRD Partners
8301 E. PRENTICE AVENUE, SUITE 200
GREENWOOD VILLAGE, CO 80111
T: 303.694.4755
F: 303.694.5125

STATE OF COLORADO
TRUDY L. McDOUGAL
203601
LICENSED ARCHITECT
4.23.09

Revisions

NO.	ISSUE	DATE
1	ADDENDUM #2	04-22-09

Sheet Information

Date	03-06-2009
Job Number	142542.000
Drawn	LTS
Checked	JMN
Approved	CG

Title

ARCHITECTURAL INTERIOR ELEVATIONS


Sheet

A-5201


Issued for Construction

Copyright © 2005 PERKINS & WILL

Apr 21, 2009 - 2:59pm
P:\Dallas\142542.000 HCA Aurora Cath\CAD\SHEETS\A-5201.dwg
schmidtt

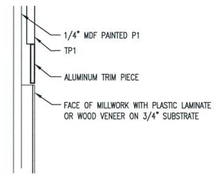


11 METAL DETAIL (MT6)
6" = 1'-0"

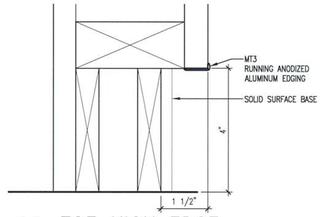


08 TOE KICK EDGE
6" = 1'-0"




05 METAL @ THERMAL PLASTIC (MT7)
6" = 1'-0"

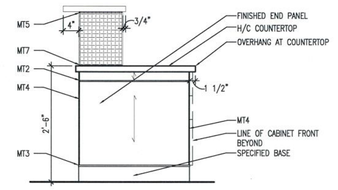


02 H/C COUNTER SIDE
3/4" = 1'-0"

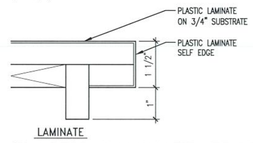


10 PLASTIC LAMINATE EDGE
6" = 1'-0"

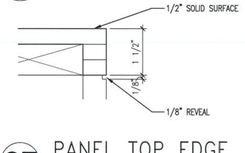


07 PANEL TOP EDGE
6" = 1'-0"

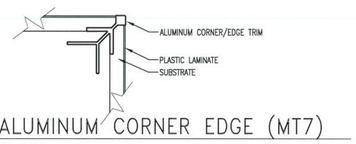


04 ALUMINUM CORNER EDGE (MT7)
6" = 1'-0"

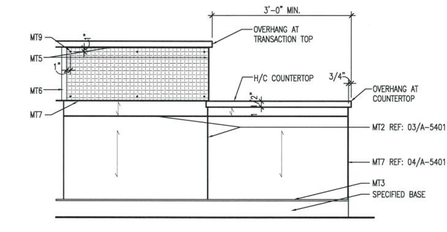

01 H/C COUNTER FRONT
3/4" = 1'-0"

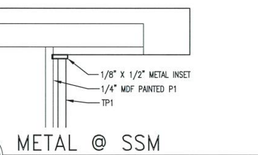


06 SOLID SURFACE EDGE
6" = 1'-0"

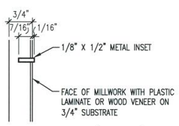


03 METAL INSET (MT2)
6" = 1'-0"


09 METAL @ SSM
6" = 1'-0"

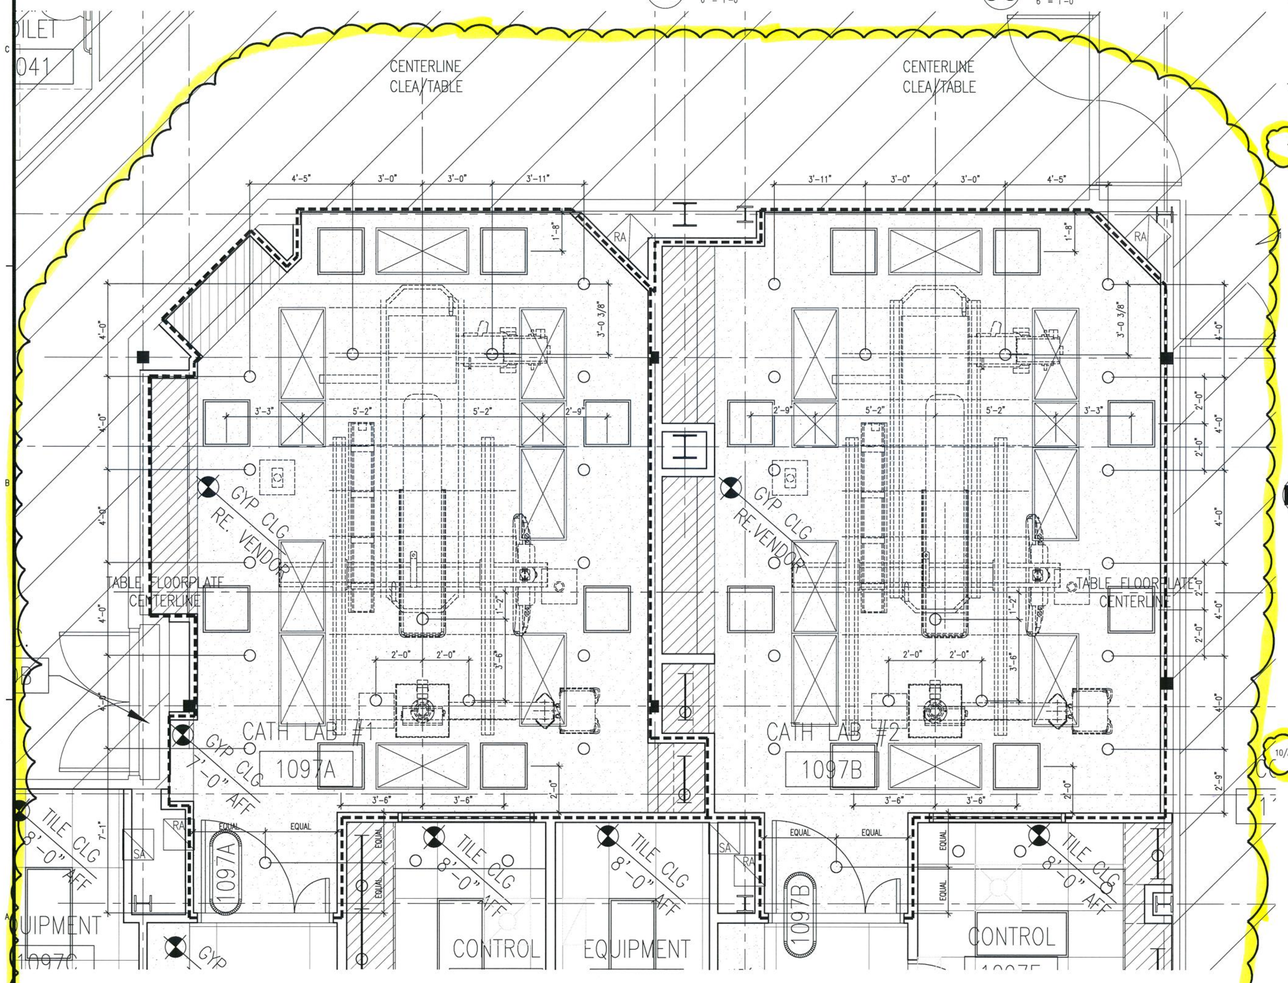

12 ENLARGED RCP LAYOUT FOR LABS
3/8" = 1'-0"

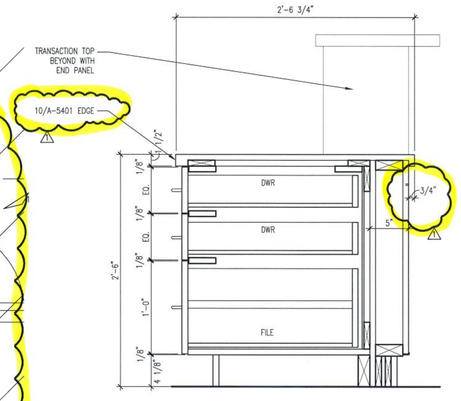


N4 SECTION @ NURSE'S STATION
1 1/2" = 1'-0"

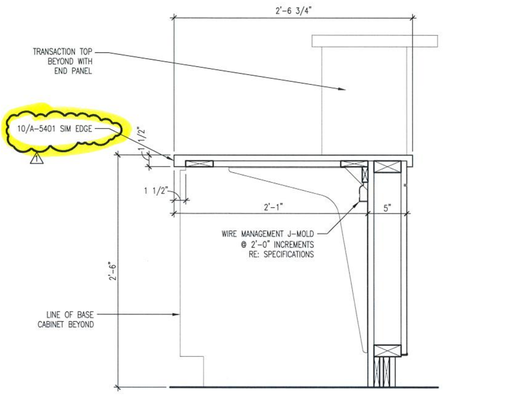


N3 SECTION @ NURSE'S STATION
1 1/2" = 1'-0"

Code violations found during inspection are required to be corrected. Plan/Permit issuance does not grant approval of code violation. 2006 IBC 105.4

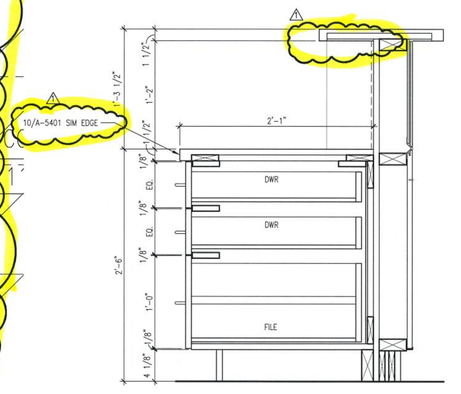

N2 SECTION @ NURSE'S STATION
1 1/2" = 1'-0"

Only highlighted or clouded revisions are approved on this review. All Previous comments apply.

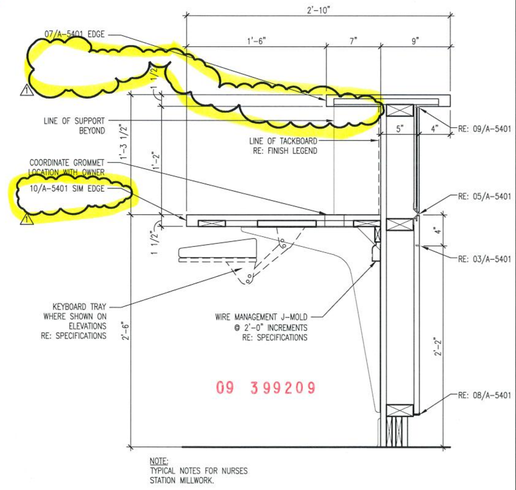

09 399209

NOTE:
TYPICAL NOTES FOR NURSES STATION MILLWORK.

N1 SECTION @ NURSE'S STATION
1 1/2" = 1'-0"

CITY OF AURORA
BUILDING DIVISION
APPROVED AS NOTED
DATE APPROVED JUN 17 2009
2006 IBC

PERKINS & WILL

10100 North Central Expressway, Suite 300
Dallas, Texas 75231, USA
214.283.8700 Fax: 214.283.8701
www.perkinswill.com

Medical Center of Aurora
1501 S. Potomac
South Campus
Cath Lab
Aurora, Colorado 80012
HCA

Project # 306660005

in association with:

Structrual
TRC International, Ltd.
13800 MONTFORT DRIVE, SUITE 145
DALLAS, TX 75240
T: 972.991.1188
F: 972.991.1192

MEP
CCRD Partners
8301 E. PRENTICE AVENUE, SUITE 200
GREENWOOD VILLAGE, CO 80111
T: 303.694.4755
F: 303.694.5125

STATE OF COLORADO
TRUDY MARIE DOUGAN
203601
LICENSED ARCHITECT
4-22-09

Revisions

NO.	ISSUE	DATE
1	ADDENDUM #2	04-22-09

Sheet Information

Date	03-06-2009
Job Number	142542.000
Drawn	LTS
Checked	JMN
Approved	CG

Title

ARCHITECTURAL WOODWORK SECTIONS

Sheet

A-5401

Issued for Construction


Copyright © 2005 PERKINS & WILL


Apr 21, 2009 - 3:09pm
P:\Dallas\142542.000 HCA Aurora Cath\CAD\SHEETS\A-5401.dwg
schmidtt

ENLARGED PLAN GENERAL NOTES


1. ALL WATER CLOSETS SHALL BE MOUNTED 1'-6" FROM THE CENTER OF THE WATER CLOSET TO THE FINISHED SURFACE OF THE SIDE WALL.
2. ALL SINKS AND LAVATORIES SHALL BE 1'-3" MINIMUM FROM THEIR CENTER LINE TO THE FINISHED SURFACE OF THE SIDE WALL.
3. "WALL HUNG" TOILET CHASES FROM FINISH TO FACE OF FINISH SHALL BE 1'-8" FOR BACK-TO-BACK TOILETS AND 1'-4" FOR A SINGLE SIDED CHASE.
4. "FLOOR MOUNTED" TOILETS SHALL HAVE A 6" STUD WALL BEHIND THEM.
5. REFER TO SHEET A-0102 FOR DETAIL AT RECESSED TOILET ACCESSORIES IN A FIRE RATED WALL.
6. CENTER MIRRORS OVER THE LAVATORY.
7. ALL FLUSH CONTROLS SHALL BE MOUNTED ON THE WIDE SIDE OF TOILET AREAS, NO MORE THAN 44 INCHES ABOVE FINISHED FLOOR.
8. ALL DIMENSIONS SHOWN ARE CLEAR DIMENSIONS TO THE FACE OF THE FINISHED WALL.
9. ALL SOAP DISPENSERS TO BE OWNER FURNISHED, OWNER INSTALLED.
10. SEE SPECIFICATION SECTION 10801 FOR THE DESCRIPTION OF EACH TOILET AND RELATED ACCESSORY LISTED ON THIS DRAWING.

TOILET ACCESSORIES LEGEND & MOUNTING HEIGHTS (ANSI)

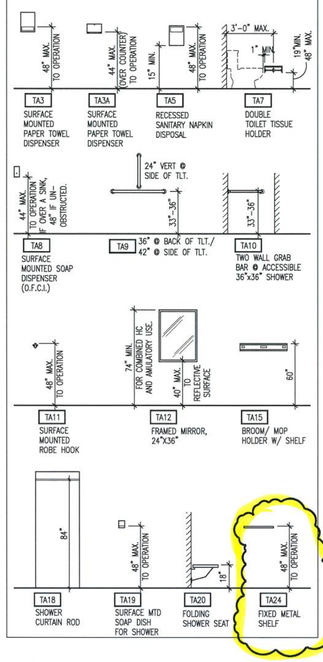


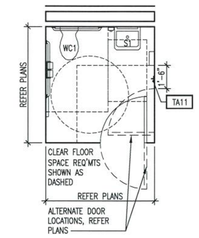


TR1 TYPICAL HC TOILET ROOM
1/4" = 1'-0"

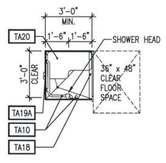


SH1 TYPICAL SHOWER
1/4" = 1'-0"

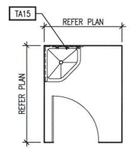


MS1 MOP SINK
1/4" = 1'-0"

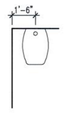


CS1 CLINICAL SERVICE SINK
1/4" = 1'-0"

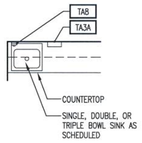


KS1 KITCHEN SINK
1/4" = 1'-0"

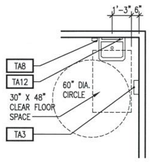


S1 TYPICAL HC HANDWASH SINK
1/4" = 1'-0"

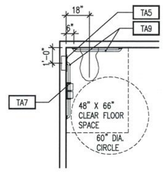


WC1 TYPICAL HC ACCESSIBLE WATER CLOSET
1/4" = 1'-0"

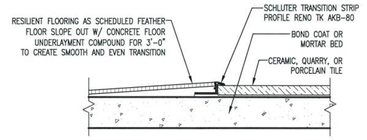

06 TILE OR RESILIENT TRANSITION
6" = 1'-0"

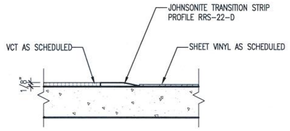


05 SHEET VINYL/VCT TRANSITION
6" = 1'-0"

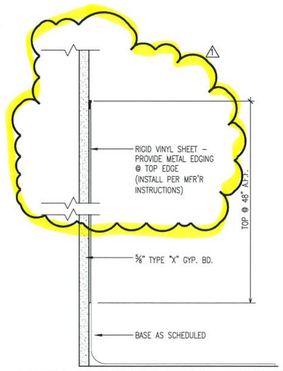


04 WALL PROTECTION - WP4
3" = 1'-0"

10 NOT USED
3" = 1'-0"

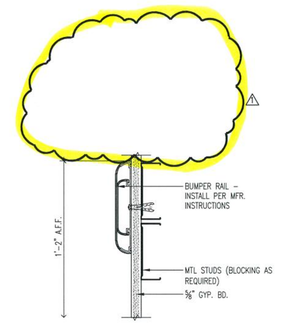

09 WALL PROTECTION - WP2
3" = 1'-0"


Only highlighted or clouded revisions are approved on this review. All Previous comments apply.

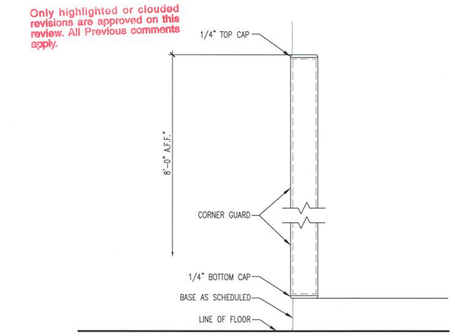

Code violations found during inspection are required to be corrected. Plan/Permit issuance does not grant approval of code violation. 2006 IBC 105.4

CITY OF AURORA
BUILDING DIVISION
APPROVED AS NOTED
DATE APPROVED JUN 17 2009
2006 IBC

09 399209

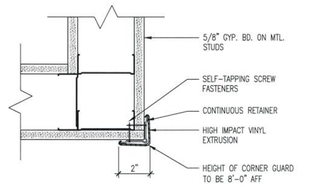

NOTE:
REFERENCE A-8000 (INTERIOR FINISH LEGEND) FOR ADDITIONAL WALL PROTECTION (WPx) INFORMATION. EXTENT AND LOCATIONS OF WALL PROTECTION IS SHOWN ON SHEET A-2101.

08 WALL PROTECTION - WP1
3" = 1'-0"

PERKINS & WILL
10100 North Central Expressway, Suite 300
Dallas, Texas 75231, USA
214.283.8700 Fax: 214.283.8701
www.perkinswill.com

Medical Center of Aurora
1501 S. Potomac
South Campus
Cath Lab
Aurora, Colorado 80012
HCA

Project # 306660005

in association with:

Structrual
TRC International, Ltd.
13800 MONTFORT DRIVE, SUITE 145
DALLAS, TX 75240
T: 972.991.1166
F: 972.991.1192

MEP
CCRD Partners
8301 E. PRENTICE AVENUE, SUITE 200
GREENWOOD VILLAGE, CO 80111
T: 303.694.4755
F: 303.694.5125

STATE OF COLORADO
TRUDY L. MCDOUGAL
203601
LICENSED ARCHITECT
4-22-09

Revisions

NO.	ISSUE	DATE
1	ADDENDUM #2	04-22-09

Sheet Information

Date	03-06-2009
Job Number	142542.000
Drawn	LTS
Checked	JMN
Approved	CG

Title

TOILET ACCESSOIES & MISCELLANEOUS INTERIOR DETAILS

Sheet

A-5600

Issued for Construction

Copyright © 2005 PERKINS & WILL

Apr 21, 2009 - 3:02pm
P:\Dallas\142542.000 HCA Aurora Cath\CAD\SHEETS\A-5600.dwg
schmidtl

VENDOR LIST

SAMPLES AND ORDER INFORMATION

NOTE: HCA HAS NEGOTIATED PURCHASING AGREEMENTS FOR FINISH PRODUCTS. THE CONTRACTOR/SUB-CONTRACTOR MUST PRICE AND PURCHASE ALL MATERIALS THROUGH THE VENDORS LISTED. MINIMUM QUANTITIES ARE STATED. ALL ORDERS UNDER BOLT/ROLL ARE SUBJECT TO A CUTTING CHARGE. ALL MATERIALS MAY NOT BE READILY IN STOCK. CONTRACTOR/SUB-CONTRACTOR ORDERS SHOULD ALLOW ENOUGH TIME TO RECEIVE GOODS BEFORE INSTALLATION DATE. ALL ORDERS MUST BE PROPERLY TAGGED WITH THE HCA ACCOUNT/QUOTE NUMBER AND THE NAME OF THE HCA FACILITY.

ARMSTRONG WORLD INDUSTRIES
SAMPLES:
ARMSTRONG COMMERCIAL FLOORING
2500 COLUMBIA AVENUE
LANCASTER, PA 17604
800-356-9301, EXT. 8788
800-599-9335 FAX
EMAIL: www.armstrong.com
ORDERS:
ORDERS THROUGH LOCAL DISTRIBUTORS
QUOTE: HCA FACILITY NAME FOR NATIONAL ACCOUNT PRICING, QUOTE HCA 615001
QUESTIONS:
GWEN BOGLE
800-356-9301, EXT. 8788
615-781-8592
EMAIL: glbogle@armstrong.com

DALTILE CORPORATION
SAMPLES AND ORDERS AND REPRESENTATIVE:
RANDY HOFFMAN
2520 BRANSFORD AVENUE
NASHVILLE, TN 37204
PHONE (615) 297-7518
800-521-8865, EXT. 224
615-292-0426 FAX
EMAIL: randy.hoffman@daltile.com
QUOTE: NA-1320

EYKON WALL SOURCE
SAMPLES:
MARIA MILLER
5675 E. SHELBY DR.
MEMPHIS, TN 38141
800-222-7866, EXT. 1002
901-366-0447 FAX
ORDERS:
GINA POWELL
5675 E. SHELBY DR.
MEMPHIS, TN 38141
800-222-7866, EXT. 1012
901-366-0447 FAX
EMAIL: gina@eykon.net
QUOTE: HCA AND NAME OF HCA FACILITY
REPRESENTATIVE:
KATHY MARTIN
5675 E. SHELBY DR.
MEMPHIS, TN 38141
800-222-7866, EXT. 1109
901-366-0447 FAX

MDC WALLCOVERINGS - BOLTAWALL
SAMPLES AND ORDERS:
SHAUNA MIMBS OR KAREN BUSH
3200 HIGHLANDS PKWY. SUITE 106
SMYRNA, GA 30082
770-319-5700
770-319-5756 FAX
EMAIL: smimbs@mdcwall.com
REPRESENTATIVE:
MONICA FOX
1445 STATION FOUR LANE
OLD HICKORY, TN 37138
615-847-5202
615-847-4110 FAX
EMAIL: mfox@mdcwall.com

MURASPEC NORTH AMERICA
SAMPLES AND ORDERS:
67 PACELLA PARK DRIVE
RANDOLPH, MA 02368
800-679-5120, EXT. 7494
781-963-4975 FAX
EMAIL: laf@muraspecna.com
QUOTE: #19928
REPRESENTATIVE:
RICHARD COLE
67 PACELLA PARK DRIVE
RANDOLPH, MA 02368
800-679-5120, EXT. 7752
781-963-4975 FAX
EMAIL: rco@muraspecna.com

SEABROOK WALLCOVERINGS
SAMPLES AND ORDERS:
GREG MARX
1325 FARMVILLE ROAD
MEMPHIS, TN 38122
800-972-3492
901-320-3674 FAX
EMAIL: Marx.greg@seabrk.com
REPRESENTATIVE
PAULA THOMAS
3615 BOYDS BRIDGE PIKE
KNOXVILLE, TN 37914
888-416-1080
865-673-9499 FAX
QUOTE: G4799 AND NAME OF HCA FACILITY

GENESYS INTERIORS, LLC
SAMPLES AND ORDERS:
VAL DAWSON
1825 MACARTHUR BLVD., NW
ATLANTA, GA 30318
877-812-8311
404-351-7893 FAX
EMAIL: val@genesysinteriors.com
REPRESENTATIVE:
STEVE BRADEN
1825 MACARTHUR BLVD., NW
ATLANTA, GA 30318
800-647-3633, EXT. 203
404-351-7893 FAX
EMAIL: steve@genesysinteriors.com
QUOTE: 190210 AND NAME OF HCA FACILITY

IPC
LEN OLDHAM PHONE
615-822-6001
615-822-6001 FAX

JOHNSONITE
SAMPLES:
JOYCE EVANS, DEPT. MGR.
800-899-8916, OPTION 5 (SAMPLES)
www.johnsonite.com
ORDERS:
PLACE ORDERS WITH LOCAL FLOORING DISTRIBUTOR
HCA CONTRACT 3SPA-22702
MICHELLE BALDWIN, BPI
800-621-9810, EXT. 1253
QUESTIONS:
PAM RUSSELL, BPI
800-621-9810, EXT. 1662

LEES CARPETS
SAMPLES AND CONTRACT PRICING:
3330 WEST FRIENDLY AVENUE
GREENSBORO, NC 27409
800-523-5647
336-379-2466 FAX
REPRESENTATIVE:
AARON ELLER
2007 STOKES LANE
NASHVILLE, TN 37215
615-297-5699
615-269-0695 FAX
aaron_eller@leescarpets.com
QUOTE: FY AND NAME OF HCA FACILITY

LOUISVILLE TILE
SAMPLES:
NEIL HONAKER
LOUISVILLE TILE DISTRIBUTORS
4250 BISHOP LANE
LOUISVILLE, TN 40218
502-452-2317
800-369-7671
502-451-6519 FAX
EMAIL: nhonaker@louisville-tile.com
ORDERS AND REPRESENTATIVE:
PATTI SMITH
650 MELROSE AVE.
NASHVILLE, TN 37211
(615) 248-8453
(615) 248-6055 FAX
EMAIL: psmith@louisville-tile.com
QUOTE: HCA AND NAME OF HCA FACILITY

MAHARAM
SAMPLES AND ORDERS:
MELISSA SLOTERDIJK
5120 WOODWAY
SUITE 7016
HOUSTON, TX 77056
713-623-6272
713-623-8864 FAX
EMAIL: msloterdijk@maharam.com
REPRESENTATIVE:
JEAN MARIE HINTON
1138 N. GERMANTOWN PARKWAY, SUITE 101
CORDOVA, TN 38013
901-756-2800
901-756-2862 FAX
EMAIL: jhinton@maharam.com
QUOTE: 6011 AND NAME OF HCA FACILITY FOR WALLCOVERINGS AND BORDERS
QUOTE: 6012 AND NAME OF HCA FACILITY FOR PRIVACY CURTAINS

SINGER WALLCOVERINGS
SAMPLES
ATTN: LISA HALMI
SINGER WALLCOVERINGS
3143 WESTERN ROW ROAD
KINGS ISLAND, OH 45034
800-543-0412
513-398-3246 FAX
EMAIL: samples@singerwallcoverings.com
ORDERS:
ATTN: JACKIE RIMLE
SINGER WALLCOVERINGS
3143 WESTERN ROW ROAD
KINGS ISLAND, OHIO 45034
800-543-0412
513-398-3246 FAX
EMAIL: singerwall@bellsouth.net
QUOTE: NAHCA-03

BENDHEIM DECORATIVE GLASS
SAMPLES AND ORDERS AND REPRESENTATIVE
GINGER BLAIR
P.O. BOX 2318A
SOUTH SHEPHERD #454
HOUSTON, TX 77019
713-869-1141
713-869-1143 FAX
EMAIL: ginger@idesignsolutions.net

JOEL BERMAN GLASS
SAMPLES AND ORDERS AND REPRESENTATIVE
BETTY HASKER
4701 CHARLES PLACE #1526
PLANO, TX 75093
214-505-0346
972-943-8146 FAX
EMAIL: bhasker@jbermanglass.com

INTERIOR FINISH LEGEND

ACOUSTICAL CEILING TILE
ACT1
Manf: ARMSTRONG
Tile Style: DUNE 1773
Color: WHITE
Size: 2'x4' SQUARE LAY-IN
Grid Style: 15/16" PRELUDE XL EXPOSED TEE
Color: WHITE

PORCELION TILE
PT1
Manf: MASTER TILE
Style/Series: CUMBERLAND BY ESQUIRE
Color: WALNUT CP27
Size: 18" x 18" x 9/16"
Grout Color: CUSTOM BUILDING PRODUCTS, EPOXY, #380 HAYSTOCK

1

CUBICLE CURTAINS (Not in Contract)
CC1
Manf: MAHARAM
Pattern: 511360 FROLIC
Color: 003 BREEZE
Width/Repeat: 72"W, 29-3/8"V x 37"H
Mesh: FANTAGRAPH SAPOR MESH 9119, 00 WHITE

EXPOSED STRUCTURE
ES
Note: PAINT TO MATCH ADJ. SURFACE

PAINT
TYPE "A": PX Eggshell
TYPE "B": PX-B Epoxy Paint

P1
Manf: BENJAMIN MOORE
Color: SHAKER BEIGE

P2
Manf: BENJAMIN MOORE
Color: AC-2 BERKSHIRE BEIGE

PLASTIC LAMINATE
PL2
Manf: WILSONART
Color/Style: 7935-07 SHAKER CHERRY

PL3
Manf: PIONITE
Color/Style: ST606 TAUPE, SUEDE
3mm Edge Band: WOODTAPE 2226 DESERT SAND

PL4
Manf: WILSONART
Color/Style: 4841-60 DESERT ZEPHYR

RESILIENT WALL BASE & ACCESSORIES
RB1 (Wall Base)
Manf: JOHNSONITE
Color: 22 PEARL
Size: 4"x 120'-0" ROLL

SEALED CONCRETE
SC1
Color: CLEAR

SHEET VINYL
SV3 (FIELD)
Manf: ARMSTRONG
Pattern: MEDINTECH
Color: #58470 JASMINE
Size: 6'-0" ROLL x 0.080" GAUGE
Rod Color: HEAT WELD W/ MANUFACTURER RECOMMENDED WELD ROD

1

SV4 (ACCENT)
Manf: ARMSTRONG
Pattern: MEDINTECH
Color: #58446 MELON
Size: 6'-0" ROLL x 0.080" GAUGE
Rod Color: HEAT WELD W/ MANUFACTURER RECOMMENDED WELD ROD

1

SHOWER CURTAIN (Not in Contract)
SHC1
Manf: FANTAGRAPH
Style: SC4040 SURECHEK (LINENWEAVE)
Color: 24 FROSTY

SOLID SURFACE
SSM1 (BROWN)
Manf: CORIAN
Color: EARTH
Size: 1/2"THICK
Finish: MATTE

SSM2
Manf: CORIAN
Color: BONE
Size: 1/2"THICK
Finish: MATTE

TACKBOARD IN NURSES STATION
TB1
Manf: FORBO
Color: 2166

VINYL COMPOSITION TILE
VCT1
Manf: ARMSTRONG
Pattern: IMPERIAL TEXTURE
Color: 51811 ANTIQUE WHITE
Size: 12" x 12" x 1/8"

WALL PROTECTION
WP1 (CORNER GUARD)
Manf: IPC
Style: 160
Color: MONTERREY
Size: 2"W x 8'-0"H
Note: CUT IN FIELD PER WALL HEIGHT

WP2 (HANDRAIL/CRASHRAIL)
Manf: IPC
Style: 1200
Color: MONTERREY
Size: 6-3/4"H

Manf: IPC
Style: 1600
Color: MONTERREY
Size: 6"H

WP4 (RIGID SHEET)
Manf: IPC
Style: 200
Color: MONTERREY
Size: 1-3/8"H

Manf: IPC
Style: 406
Color: MONTERREY
Size: 4' x 8' x .060 THICK

WOOD
WD1
Cut: QUARTER
Species: MAPLE
Finish: SATIN
Color: TO MATCH PL1

WD2
Cut: QUARTER
Species: CHERRY
Finish: SATIN
Color: TO MATCH PL2

GENERAL NOTES

FLOOR FINISH:
A. ALL FLOOR TRANSITIONS ARE TO OCCUR AT THE CENTERLINE OF DOOR WHEN DOOR IS IN CLOSED POSITION.

B. REFER TO SHEET A-5600 FOR TRANSITION AND THRESHOLD DETAILS.

C. RESILIENT FLOOR TRANSITION COLOR TO BE: RB1

D. SCHLUTER FLOOR TRANSITION COLOR TO BE: AKB 80 BRIGHT COPPER/BRONZE ANODIZED ALUMINUM.

E. REFER TO INTERIOR FINISH PLAN FOR ALL FLOOR PATTERNS.

WALL BASE:
A. ALL RUBBER BASE SHALL BE SEALED TIGHT TO FINISHED FLOOR.

B. PROVIDE SCHEDULED BASE ALONG BOTTOM OF EXPOSED FRONTS, BACKS, SIDES, AND ENDS OF ALL FIXED CABINETS, PEDESTALS, VERTICAL SUPPORT PANELS, KNEE SPACES, ETC., U.N.O. ON THE INTERIOR ELEVATIONS.

B. SHEET VINYL WITH INTEGRAL COVE BASE SHALL BE 6" A.F.F. WITH ALUMINUM METAL CAP, UNLESS NOTED OTHERWISE.

WALL FINISH:
A. WALL TEXTURE SHALL BE LIGHT ORANGE PEEL, UNLESS NOTED OTHERWISE.

B. PAINT ALL WALLS TYPE "A", UNLESS NOTED OTHERWISE. SEE FINISH LEGEND FOR DEFINITION.

CEILING FINISH:
A. FURR-DOWN FINISH: P1 U.N.O.
VERTICAL SURFACES OF FURR-DOWN TO MATCH ADJACENT WALLS. HORIZONTAL SURFACES OF FURR-DOWN TO BE PAINTED TO MATCH CEILING COLOR, UNLESS NOTED OTHERWISE.

B. REFER TO REFLECTED CEILING PLAN FOR ALL CEILING HEIGHTS.

C. PAINT ALL ACCESS PANELS IN CEILING TO MATCH ADJACENT CEILING FINISH.

DOORS/WINDOWS:
A. DOOR FINISH TO BE WD2 U.N.O., REFER TO DOOR SCHEDULE ON SHEET A-8200.

B. INTERIOR HOLLOW METAL DOOR & FRAME TO BE PAINTED: P1, UNLESS NOTED OTHERWISE.

C. ALL VISION PANEL FRAMES SHALL BE P1, UNLESS NOTED OTHERWISE.

MILLWORK:
A. REFER TO INTERIOR FINISH PLAN FOR CHEMICAL RESISTANT PLASTIC LAMINATE LOCATION.

B. SOLID SURFACE INTEGRAL BOWL COLOR TO BE SSM2, REFER TO SPECIFICATION AND MEP DOCUMENTS FOR BOWL INFORMATION.

ACCESSORIES:
A. CUBICLE CURTAIN TO BE INSTALLED WITH BOTTOM AT 12" A.F.F. (BY SOFT GOODS CONTRACTOR). VERIFY CEILING HEIGHT FOR CEILING MOUNTED TRACK; CUBICLE CURTAIN TRACK TO BE INSTALLED BY GENERAL CONSTRUCTION CONTRACTOR.

B. REFER TO SHEET A-2101 AND DETAILS FOR WALL PROTECTION (WP) LOCATIONS. REFER TO INTERIOR FINISH LEGEND FOR SPECIFIC PROFILES AND COLORS.

C. SHOWER CURTAIN TO BE SHC1, UNLESS NOTED OTHERWISE.

Code violations found during inspection are required to be corrected. Plan/Permit issuance does not grant approval of code violation. 2006 IBC 105.4

Only highlighted or clouded revisions are approved on this review. All Previous comments apply.

CITY OF AURORA
BUILDING DIVISION
APPROVED AS NOTED
DATE APPROVED JUN 17 2009
2006 IBC

09 399209

PERKINS & WILL
10100 North Central Expressway, Suite 300
Dallas, Texas 75231, USA
214.283.8700 Fax: 214.283.8701
www.perkinswill.com

Medical Center of Aurora
1501 S. Potomac
South Campus
Cath Lab
Aurora, Colorado 80012
HCA

Project # 306660005

in association with:

Structural
TRC International, Ltd.
13800 MONTFORT DRIVE, SUITE 145
DALLAS, TX 75240
T: 972.991.1188
F: 972.991.1192

MEP
CCRD Partners
8301 E. PRENTICE AVENUE, SUITE 200
GREENWOOD VILLAGE, CO 80111
T: 303.694.4755
F: 303.694.5125

STATE OF COLORADO
TRUDY C. MCDOUGAL
203601
LICENSED ARCHITECT
4.22.09

Revisions

1	ADDENDUM #2	04-22-09

NO.	ISSUE	DATE

Sheet Information

Date	03-06-2009
Job Number	142542.000
Drawn	LTS
Checked	JMN
Approved	CG

Title

INTERIOR FINISH LEGEND


Sheet

A-8000


Issued for Construction

Copyright © 2005 PERKINS & WILL


Apr 21, 2009 - 3:02pm
P:\Dallas\142542.000 HCA Aurora Cath\CAD\SHEETS\A-8000.dwg
schmidtt

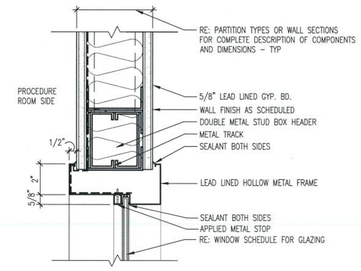


10 HEAD DETAIL–LEAD LINED–HM
3" = 1'-0"

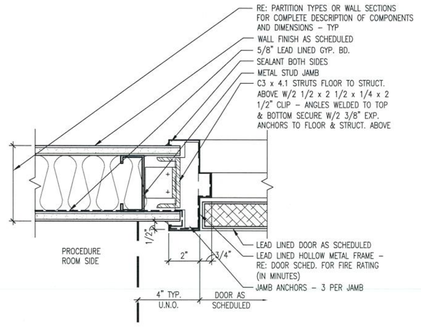


07 JAMB DETAIL–LEAD LINED–HM
3" = 1'-0"

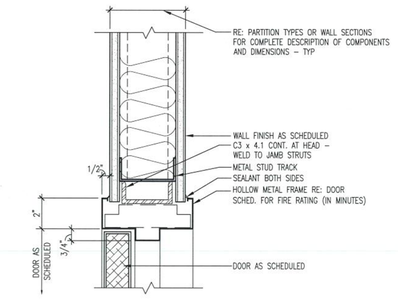


04 HEAD DETAIL–DOUBLE DOOR–HM
3" = 1'-0"

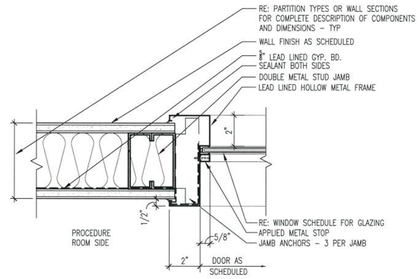

09 JAMB DETAIL–LEAD LINED–HM
3" = 1'-0"

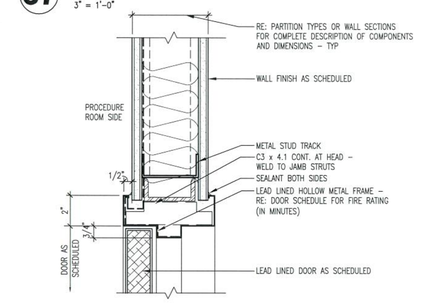


06 HEAD DETAIL–LEAD LINED–HM
3" = 1'-0"

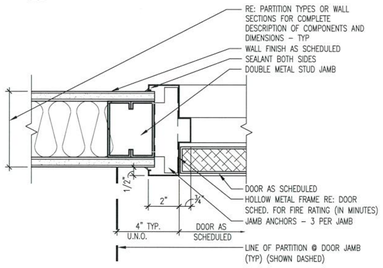


@ TYP. RATED/NON-RATED DOORS


03 JAMB DETAIL–STANDARD–HM
3" = 1'-0"

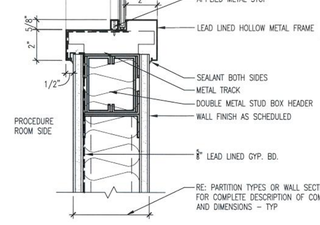

08 SILL DETAIL–LEAD LINED–HM
3" = 1'-0"

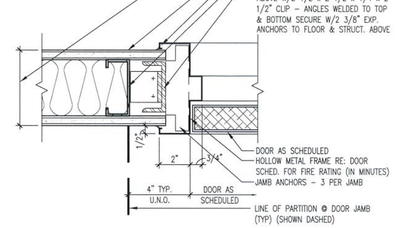

05 JAMB DETAIL–DOUBLE DOOR–HM
3" = 1'-0"

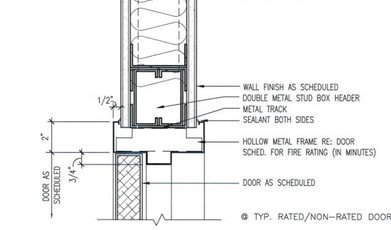

@ TYP. RATED/NON-RATED DOORS


02 HEAD DETAIL–STANDARD–HM
3" = 1'-0"

DOOR SCHEDULE GENERAL NOTES

1. REFER TO SPECIFICATIONS FOR DESCRIPTIONS OF THE HARDWARE SETS.
2. PROVIDE A PAIR OF 14 GAGE STUDS AT THE SIDE OF AND HEAD OF ALL DOORS (U.N.O.).
3. ALL DOORS IN SMOKE RESISTANT PARTITIONS TO HAVE POSITIVE LATCHING (U.N.O.).
4. FIRE-RATING GLAZING IN DOORS SHALL MATCH THE FIRE-RATING OF THE DOORS TO WHICH THEY ARE INSTALLED.
5. "SWING CLEAR" HINGES SHALL BE PROVIDED AT ALL CATH PROCEDURE ROOM DOORS.


DOOR TYPES
Scale: NTS

NOTE:
3" @ EACH SIDE OF DOOR W/A HOSPITAL LATCH OR PANIC HARDWARE.
5" @ EACH SIDE OF 4'-0" DOORS OR WIDER.
6" @ EACH SIDE OF ALL OTHER DOORS.

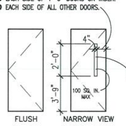

FLUSH F | NARROW VIEW NV

FRAME TYPES
Scale: NTS

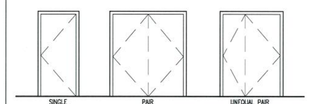

SINGLE A | PAIR C | UNEQUAL PAIR D

DOOR SCHEDULE REMARKS

1. PROVIDE WITH MECHANICAL HOLD OPEN ON EACH LEAF
2. VIEW WINDOWS IN LARGER LEAF ONLY
3. DOUBLE ACTING DOOR – OMIT FRAME STOPS
4. AUTOMATIC CARD SWIPE DOOR
5. NOT USED
6. NOT USED
7. DOOR SWINGS BOTH WAYS
8. NOT USED
9. LEAD LINED DOOR
10. NOT USED
11. NOT USED
12. POWER ASSISTED DOOR
13. NOT USED
14. 5-BUTTON COMBINATION LOCK
15. NOT USED
16. NOT USED
17. UNEQUAL DOOR PAIR (4'-0" & 1'-6")
18. NOT USED

DOOR SCHEDULE LEGEND

+– REFER TO MANUFACTURER
WD – SOLID CORE WOOD WITH STAINED FINISH
PL – SOLID CORE WOOD WITH PLASTIC LAMINATE FINISH
HM – STEEL
Sr – SMOKE RESISTANT
ALUM – ANODIZED ALUMINUM
ALUM1– CUSTOM ALUMINUM COLOR

GLAZING LEGEND


TYPE	GLAZING
GL-10	LEAD GLASS

NOTES:
1. CONFIRM ALL WINDOW SIZES IN FIELD

DOOR SCHEDULE

	DOOR							FRAME								
			SIZE							DETAIL						
Room Number	NUMBER	ROOM NAME	WIDTH	HEIGHT	TYPE	MATL	FINISH	TYPE	MAT.	HEAD	JAMB	SILL	RATING	REMARKS	Frame Finish	Hardware Set No.
1097A	1097A	CATH LAB #1	5'-6"	7'-0"	NV	WD	WD2	D	HM	06/A-8200	07/A-8200	--		1,9,17	PT	6.01
1097B	1097B	CATH LAB #2	5'-6"	7'-0"	NV	WD	WD2	D	HM	06/A-8200	07/A-8200	--		1,9,17	PT	6.01
1097C	1097C	EQUIPMENT	3'-0"	7'-0"	F	WD	WD2	A	HM	02/A-8200	03/A-8200	--		--	PT	2.04
1097D	1097D	CONTROL	3'-0"	7'-0"	NV	WD	WD2	A	HM	02/A-8200	03/A-8200	--		--	PT	5.01
1097E	1097E	EQUIPMENT	3'-0"	7'-0"	F	WD	WD2	A	HM	02/A-8200	03/A-8200	--		--	PT	2.04
1097F	1097F	CONTROL	3'-0"	7'-0"	NV	WD	WD2	A	HM	02/A-8200	03/A-8200	--		--	PT	5.01
1098	1098	CORRIDOR	7'-0"	7'-0"	NV	WD	WD2	C	HM	04/A-8200	03/A-8200	--	90/SR	4,12	PT	7.01
1100	1100	SOILED UTILITY	4'-0"	7'-0"	F	WD	WD2	A	HM	02/A-8200	03/A-8200	--	45/SR	14	PT	9.01
1101	1101	EQUIPMENT STORAGE	4'-0"	7'-0"	F	WD	WD2	A	HM	02/A-8200	03/A-8200	--	45/SR	--	PT	2.01
1102	1102	MICROBIOLOGY	3'-0"	7'-0"	F	WD	WD2	A	HM	02/A-8200	03/A-8200	--	90/SR	4	PT	2.02
1103	1103	CLEAN UTILITY/P.O.U.	4'-0"	7'-0"	F	WD	WD2	A	HM	02/A-8200	03/A-8200	--	45/SR	4	PT	2.02
1104	1104	UPS	3'-6"	7'-0"	F	WD	WD2	A	HM	02/A-8200	03/A-8200	--	--	--	PT	2.05
1105	1105	STAFF LOUNGE	3'-6"	7'-0"	F	WD	WD2	A	HM	02/A-8200	03/A-8200	--	--	--	PT	5.01
1108	1108	LOCKER ROOM	3'-0"	7'-0"	F	WD	WD2	A	HM	02/A-8200	03/A-8200	--	--	--	PT	8.01
1109	1109	STAFF TOILET/SHOWER	3'-0"	7'-0"	F	WD	WD2	A	HM	02/A-8200	03/A-8200	--	--	--	PT	3.01
1110	1110	PATIENT TOILET	3'-0"	7'-0"	F	WD	WD2	A	HM	02/A-8200	03/A-8200	--	--	3,7	PT	3.02
1111	1111	JANITOR	3'-0"	7'-0"	F	WD	WD2	A	HM	02/A-8200	03/A-8200	--	--	--	PT	2.04
1112	1112	MEDS	3'-0"	7'-0"	F	WD	WD2	A	HM	02/A-8200	03/A-8200	--	--	4	PT	2.03

01 FIRST FLOOR DOOR SCHEDULE
NTS

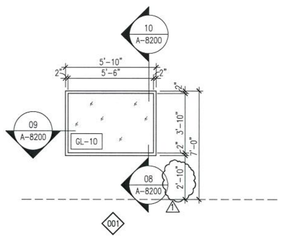

INTERIOR HOLLOW METAL W/SHIELDED GLAZING

1A WINDOW SCHEDULE
1/4"=1'-0"

CITY OF AURORA
BUILDING DIVISION
APPROVED AS NOTED
DATE APPROVED JUN 17 2009
2006 IBC

09 399209

Only highlighted or clouded revisions are approved on this review. All Previous comments apply.

Code violations found during inspection are required to be corrected. Plan/Permit issuance does not grant approval of code violation. 2006 IBC 105.4

PERKINS & WILL
10100 North Central Expressway, Suite 300
Dallas, Texas 75231, USA
214.283.8700 Fax: 214.283.8701
www.perkinswill.com

Medical Center of Aurora
1501 S. Potomac
South Campus
Cath Lab
Aurora, Colorado 80012
HCA
Project # 306660005

in association with:

Structural
TRC International, Ltd.
13800 MONTFORT DRIVE, SUITE 145
DALLAS, TX 75240
T: 972.991.1188
F: 972.991.1192

MEP
CCRD Partners
8301 E. PRENTICE AVENUE, SUITE 200
GREENWOOD VILLAGE, CO 80111
T: 303.694.4755
F: 303.694.5125

STATE OF COLORADO
TRUDY L. McDOUGH
203601
LICENSED ARCHITECT
4-22-09

Revisions

NO.	ISSUE	DATE
1	ADDENDUM #2	04-22-09

Sheet Information

Date	03-06-2009
Job Number	142542.000
Drawn	LTS
Checked	JMN
Approved	CG

Title

DOOR/WINDOW SCHEDULE AND DETAILS

Sheet

A-8200

Issued for Construction

Copyright © 2005 PERKINS & WILL

Apr 21, 2009 – 3:03pm
P:\Dallas\142542.000 HCA Aurora Cath\CAD\SHEETS\A-8200.dwg
schmidtt