City of Aurora
Building Codes Division
15151 E Alameda Pkwy
Aurora, CO 80012
(303) 739-7420

# Notice

## This material is subject to copyright protection pursuant to Federal Law: 17 United States Code Section 106.

Date: 6-14-12

# PLAN REVIEW REVISION SUBMITTAL

**This form should be completed and submitted with all building plan revisions. All changes from the previously approved drawings must be clearly shown by clouding, circling, etc.**

Project address 1501 S. Potomac St. Aurora
Unit #
Project name ED & Trauma Renovation
Valuation $ ~~210,000~~ 0 -
Contractor ~~BFC~~ BRENT FLEETWOOD CONST Construction
Contractor License Class A 2011-563045 CL
Contact Name Brent Fleetwood
Phone # 303-210-3851
Fax
Email bfc.brent@comcast.net
Owner The Medical Center of Aurora
Phone # 303-338-7869
Address 1501 S. Potomac St., Aurora Co 80012
Fax 303-695-2860
Have there been any permits issued for this job? Yes ✓ No
If yes, what is the permit number?
What type of work is being proposed in the attached plans being submitted? This is a re-submittal of the proper smoke damper locations according to approved original construction documents.

---

## - - - - - - - - THIS SPACE FOR OFFICE USE ONLY - - - - - - - -

Plan Location Stellent
Parent RSN 652035

| Reviews | Review | Review time: Total Review | PE |
|---|---|---|---|
| Mechanical | ✓ | | |
| Plumbing | | | |
| Electrical | | | |
| Structural | | | |
| Bldg Life Safety | | | |
| Fire Life Safety | | | |
| **Total review time** | | | |

**One half hour minimum collected at Plan intake.**

Permit Number
Permit Type Limited (LT)
Subtype Plan Revisions
Intake by K (P.E.)

Limited (LT)
Plan Revisions

**PT INPUT: PLANS PICKED UP BY:**

| |
|---|
| Company: |
| Name: (Print) |
| Phone: |

- .50 (= $55.50) Minimum plan fee paid (1/2 hour)


$

RSN 663071

**BOARD OF APPEALS**
The City of Aurora has created a Building Code and Contractor's Appeals and Standards Board. Applicants have the right to have the board hear appeals of orders, decisions or determinations made by the building official relative to the application and interpretation of the building code. Any application for appeal to the board shall be based on a claim that the true intent of the code or the rules legally adopted thereunder have been incorrectly interpreted, the provisions of the building code do not fully apply or an equally good or better form of construction is



12-604350

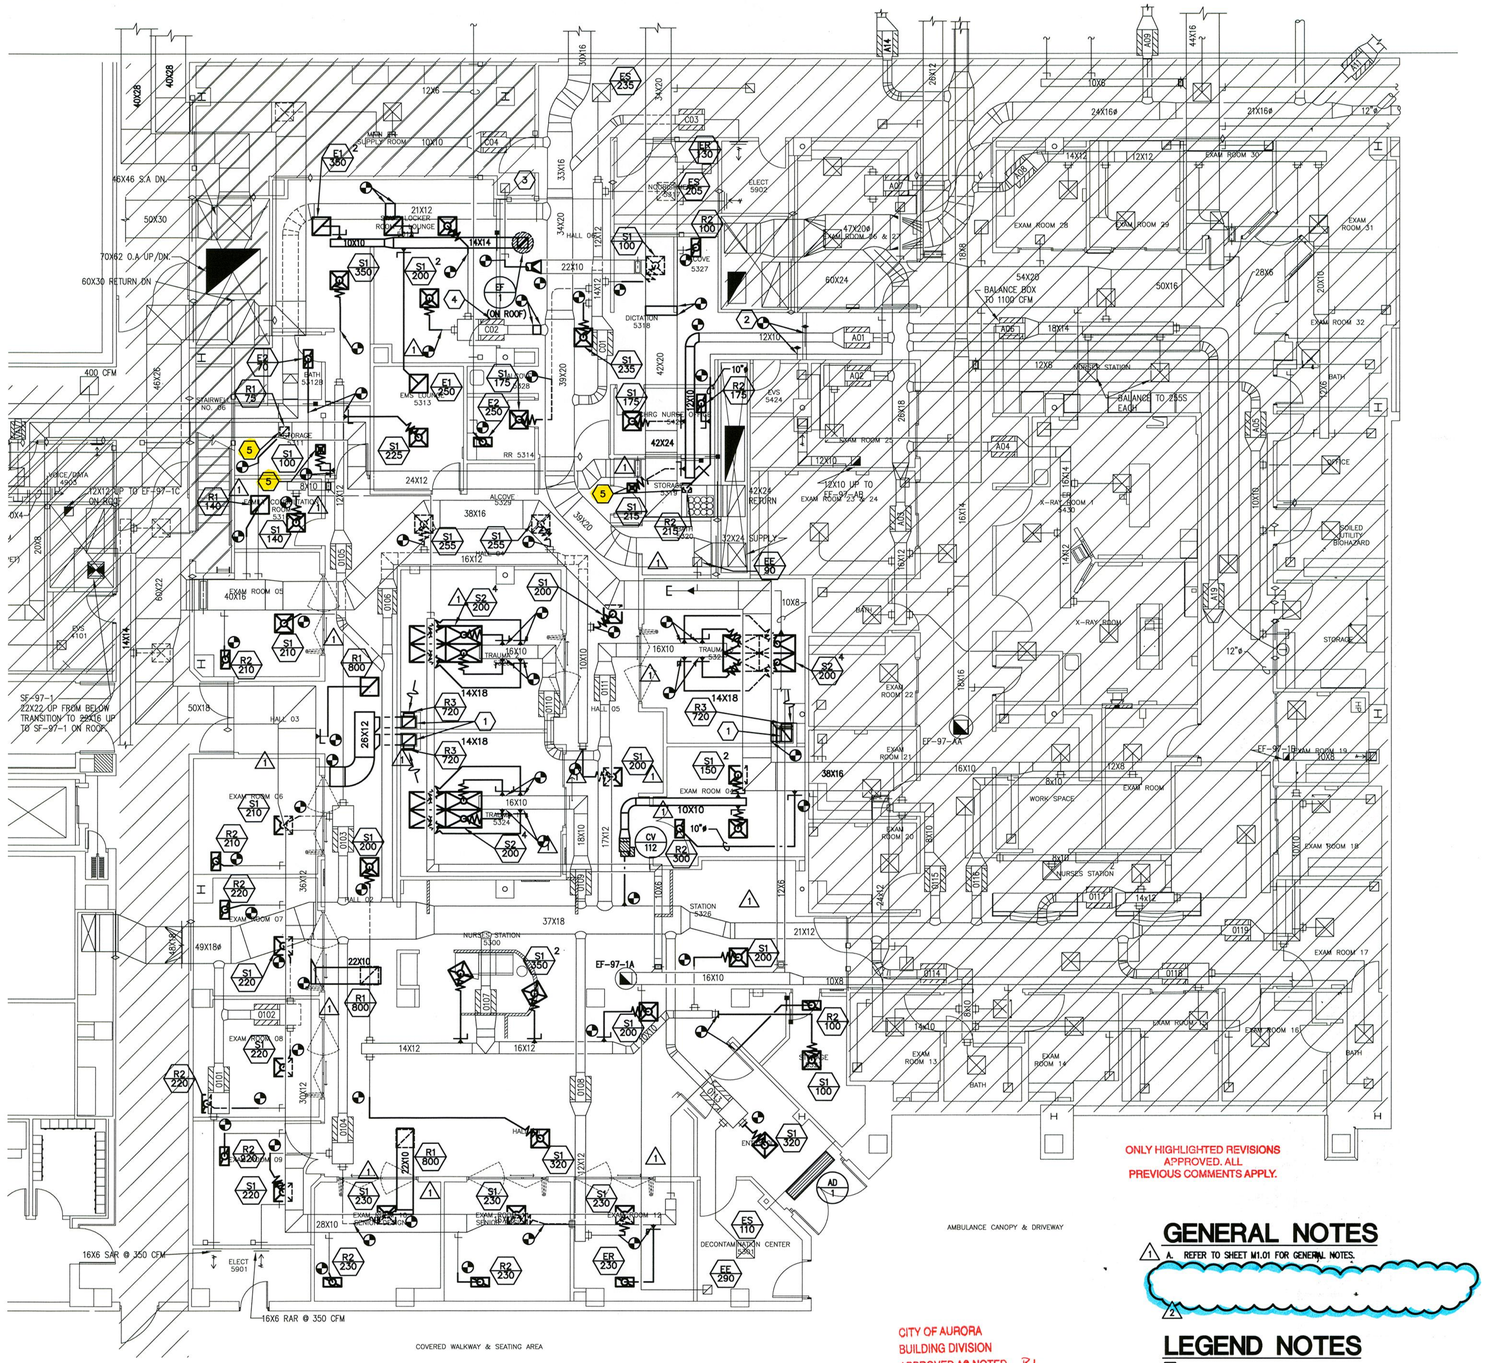


# 01 MECHANICAL HVAC PLAN

SCALE: 1/8" = 1'-0"

CITY OF AURORA BUILDING DIVISION PLAN REVIEW DOES NOT GRANT APPROVAL FOR ANY VIOLATIONS OF ADOPTED BUILDING CODES. CODE VIOLATIONS UNCOVERED IN FIELD INSPECTIONS MUST BE CORRECTED.

CITY OF AURORA
BUILDING DIVISION
APPROVED AS NOTED RL
DATE JUL 03 2012

12-604350

ONLY HIGHLIGHTED REVISIONS APPROVED. ALL PREVIOUS COMMENTS APPLY.

## GENERAL NOTES

1 A. REFER TO SHEET M1.01 FOR GENERAL NOTES.

2

## LEGEND NOTES

1. 18X14 RETURN AIR DUCT DN TO SIDE-WALL RETURN AIR GRILLE MIN 6" AFF.
2. PROVIDE FIRE/SMOKE DAMPER IN EXISTING DUCTWORK AT NEW RATED WALL.
3. FIRE WRAP DUCT FROM EXISTING FIRE DAMPER TO NEW RATED WALL, OR PROVIDE NEW FIRE DAMPER AT RATED WALL.
4. COORDINATE EXISTING VAV TERMINAL LOCATION WITH NEW RATED WALL. RELOCATE TERMINAL AND EXTEND SERVICES AS NECESSARY IF NEW WALL CONFLICTS WITH WALL. PROVIDE FIRE DAMPER IN DUCT AT WALL LOCATION.
5. PROVIDE FIRE DAMPER IN DUCT AT RATED CEILING.

1


The Medical Center of Aurora Health

ED-TRAUMA

MEDICAL CENTER OF AURORA

1501 S. POTOMAC ST
AURORA, COLORADO 80012

TOM THOMPSON ARCHITECT
2510 SOUTH OSCEOLA STREET
DENVER, COLORADO 80219
720.989.6084
TomThompsonArchitect@gmail.com

Project #:
CCRD Professional Consulting Engineers
6400 South Fiddler's Green Circle
Suite 1150
Greenwood Village, CO 80111
phone: 303.694.4755
fax: 303.694.5125
Austin • Dallas • Denver • Houston • Kansas City • Miami
Nashville • Phoenix • Richmond • Washington D.C.



All drawings and written material appearing herein constitute the original and unpublished work of Tom Thompson, Architect. These documents are strictly proprietary and confidential. They are not to be disclosed to third parties, distributed or reproduced without the express written permission of Tom Thompson, Architect.


COLORADO LICENSED PROFESSIONAL ENGINEER
45834
7/2/12

PROJECT NO.: 12-01

DRAWN BY: RH
CHECKED BY:
SCALE: 1/8" = 1'-0"
DATE: 05/13/2012
ISSUED FOR: CONSTRUCTION
REVISIONS:

1 PERMIT REVISION
2 PERMIT REVISION

SHEET TITLE: MECHANICAL HVAC PLAN

SHEET NO.: M2.01