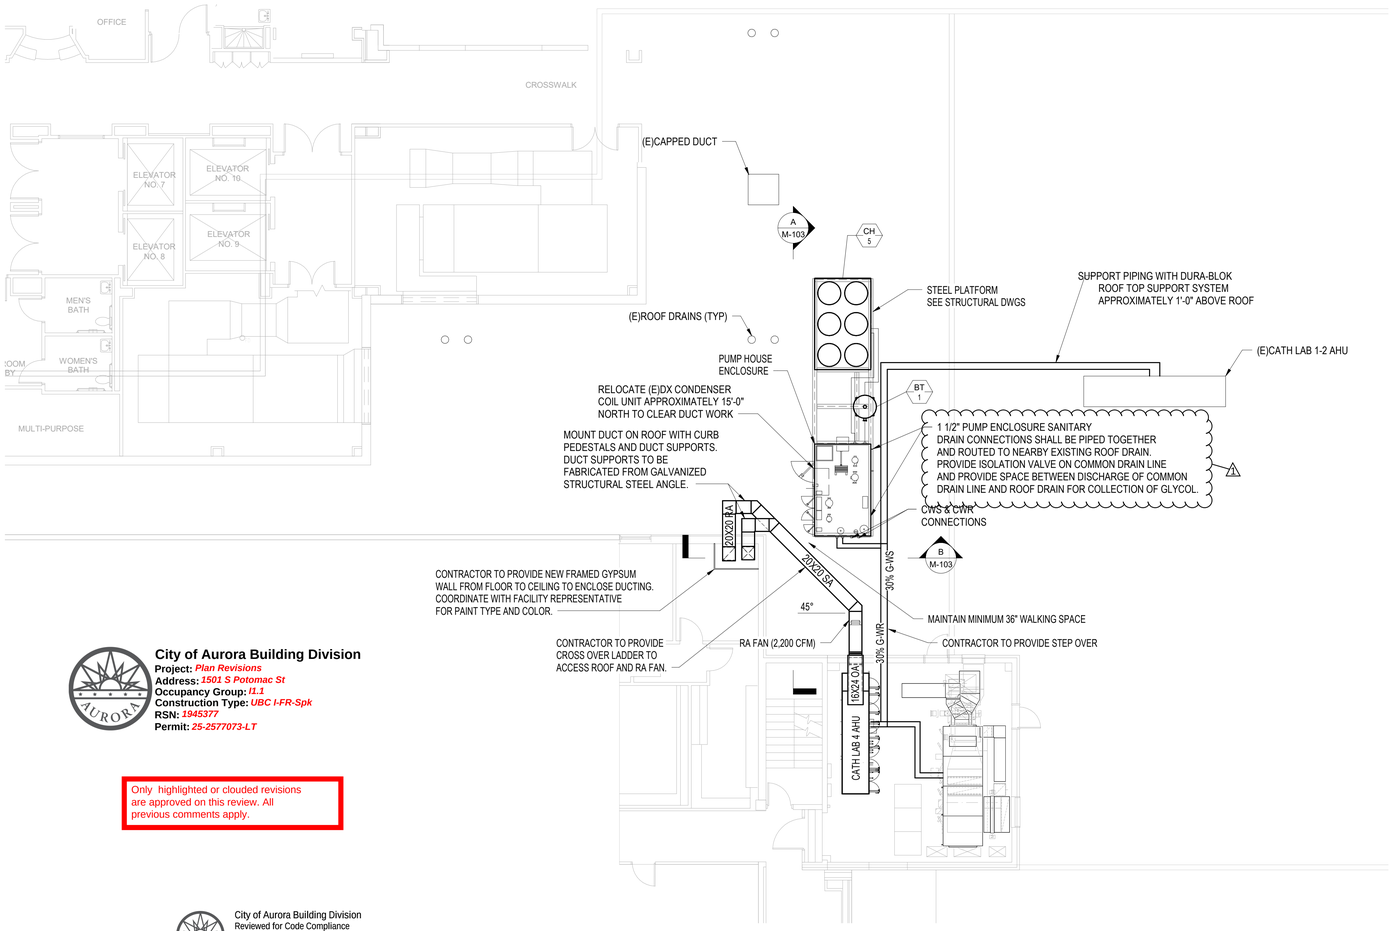



City of Aurora Building Division
Project: *Plan Revisions*
Address: *1501 S Potomac St*
Occupancy Group: *I1.1*
Construction Type: *UBC I-FR-Spk*
RSN: *1945377*
Permit: *25-2577073-LT*

Only highlighted or clouded revisions are approved on this review. All previous comments apply.


City of Aurora Building Division
Reviewed for Code Compliance
Approved as Noted: jlocke
Date: Dec 18, 2025
2021 INTERNATIONAL CODES & 2023 NEC

N

MECHANICAL PARTIAL SECOND FLOOR ROOF PLAN
SCALE: 1/8" = 1'-0"

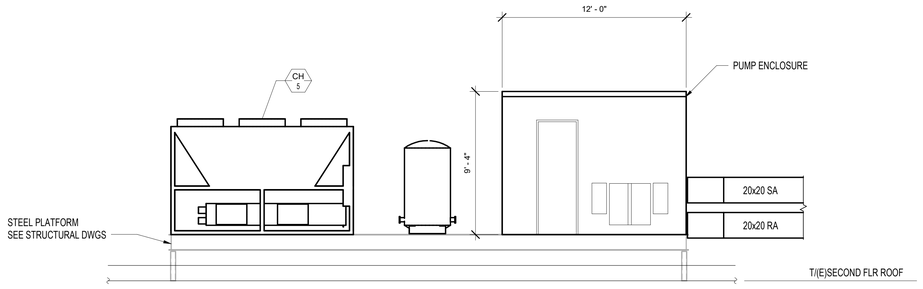

SECTION A
SCALE: 1/4" = 1'-0"

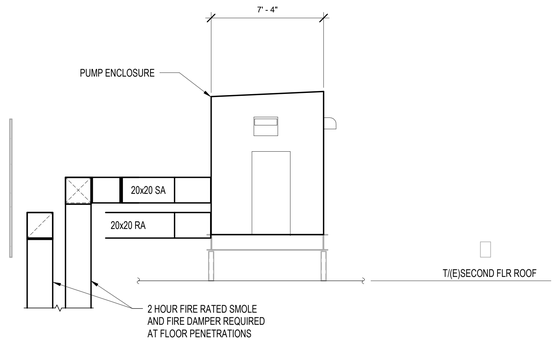

SECTION B
SCALE: 1/4" = 1'-0"

Salas O'Brien
salasobrien.com
Dublin
2751 Tuller Pkwy
Dublin, OH 43017
Registration:

CONFIDENTIAL
THIS DRAWING AND ASSOCIATED DESIGN ELEMENTS ARE CONFIDENTIAL AND THE PROPERTY OF SALAS O'BRIEN, WHICH RETAINS ALL COMMON LAW, COPYRIGHT, STATUTORY AND OTHER RIGHTS THERETO. COPYING, USE OR DISCLOSURE WITHOUT WRITTEN PERMISSION IS PROHIBITED, UNLESS OTHERWISE AGREED TO BY SALAS O'BRIEN, THIS DRAWING (AS WELL AS ANY COPIES) SHALL BE RETURNED TO SALAS O'BRIEN UPON REQUEST.

PROFESSIONAL SEAL

COLORADO LICENSED MICHAEL P THOMPSON 50150 PROFESSIONAL ENGINEER
12/11/2025

ISSUE DATE	DESCRIPTION
08/01/2023	100% CD

2023-00034-00
HEALTHTRUST FACILITIGROUP

TMCA CATH LAB HVAC DEHUMIDIFICATION

1501 S. POTOMAC ST,
AURORA, CO 80012

REVISIONS

Δ	DESCRIPTION	DATE
0	ISSUED FOR CONSTRUCTION	08/01/23
1	PERMIT REVISIONS	12/11/25

CHECKED BY	DRAWN BY
EBM	KDR

SHEET NAME

MECHANICAL PARTIAL SECOND FLOOR ROOF PLAN

SHEET NUMBER	REVISION
M-103	0

RSN:1945377
Permit #: 25-2577073-LT

Autodesk Docs://080-2023-0034 TMCA Cathlab Dehumidification Upgrades/2023-00034 TMCA Cathlab-Mech_R22_R2.rvt
8/1/2023 11:40:30 AM