
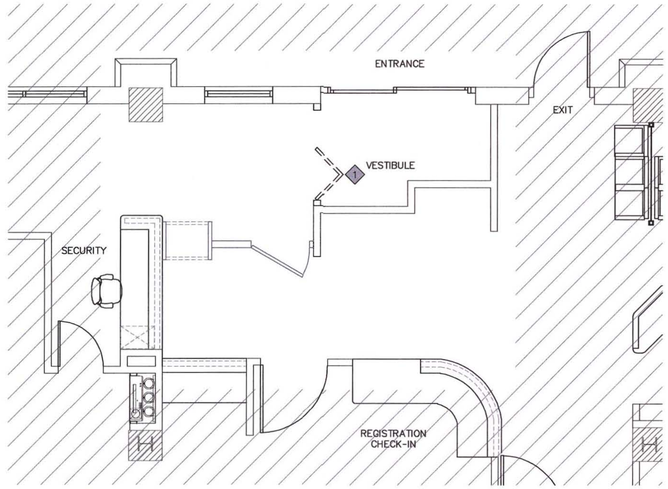


DEMOLITION PLAN
1/4" = 1'

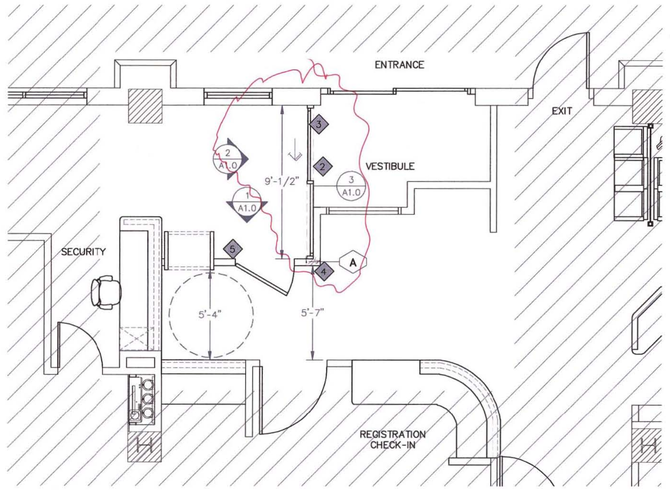

FLOOR PLAN
1/4" = 1'


Rev 12660086

CITY OF AURORA
BUILDING DIVISION
APPROVED AS NOTED JC
DATE 2/6/18

STRUCTURAL PLAN REVIEW IS LIMITED TO GENERAL SURVEY FOR CODE COMPLIANCE. NO REVIEW IS IMPLIED NOR WAS UNDERTAKEN TO VERIFY STRUCTURAL ADEQUACY.


KEY NOTES	
1	REMOVE & DISPOSE OF EXISTING ACCORDION STYLE DOOR ASSEMBLY.
2	CONSTRUCT DOOR HEADER FOR ROUGH OPENING OF NEW SLIDING DOOR ASSEMBLY.
3	INSTALL NEW ENTRE-MATIC SLIDING DOOR SYSTEM. RE: DOOR DETAILS & SPECIFICATIONS.
4	EXTEND WING WALL TO REQUIRED LENGTH SHOWN FOR NEW DOOR ROUGH-IN.
5	MOVE EXISTING HALF WALL, DOOR & METAL DETECTOR TO END OF NEW WALL AS SHOWN. KEEP MINIMUM 5'-0" TURNING DIAMETER FOR ADA COMPLIANCE.

Subject to Elec. Field Inspection

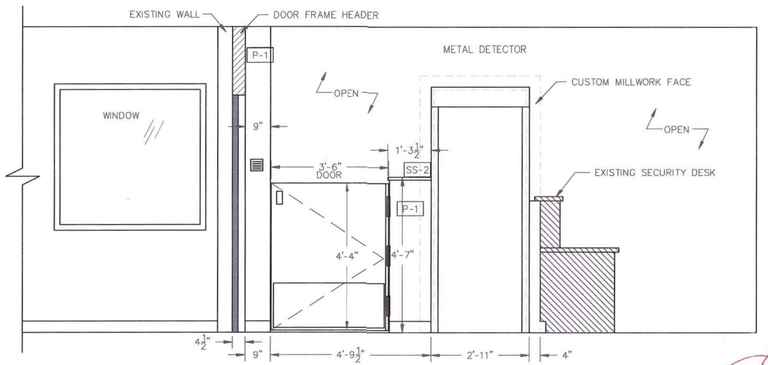


1 / A1.0 ELEVATION
SCALE: 1/2" = 1'


Temp Glazing Rigid Isc 2406.

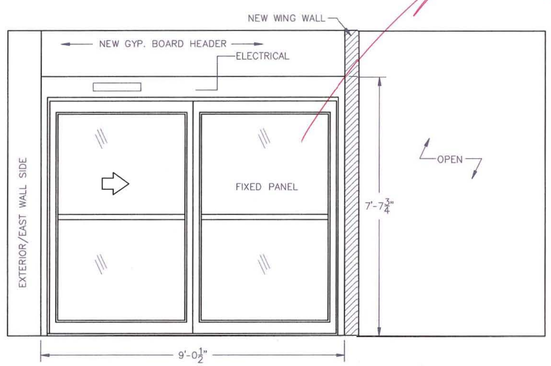

2 / A1.0 DOOR ELEVATION
SCALE: 1/2" = 1'

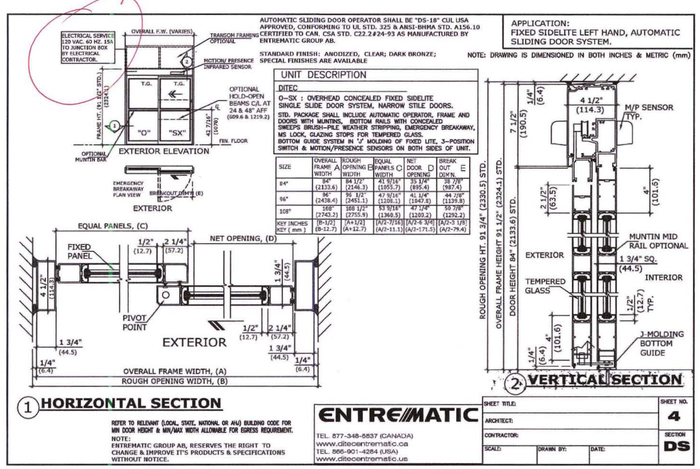

SIZE	OVERALL FRAME A WIDTH	ROUGH OPENING B WIDTH	EQUAL PANELS C WIDTH	NET DOOR D OPENING	BREAK OUT E DIM'N.
84"	90" (2333.6)	84 1/2" (2146.7)	41 9/16" (1055.7)	33 1/4" (855.4)	38 7/8" (987.4)
96"	102" (2641.6)	96" (2451.1)	47 9/16" (1208.1)	45 1/4" (1147.6)	44 7/8" (1139.8)
108"	114" (2743.2)	108 1/2" (2755.9)	53 9/16" (1360.5)	51 1/4" (1202.2)	50 7/8" (1291.2)
KEY INCHES KEY (mm)	B=1/2 (B-12.7)	A=1/2 (A+12.7)	(A/2-7/16) (A/2-11.1)	(A/2-2 3/4) (A/2-69.8)	(A/2-1 7/8) (A/2-79.4)

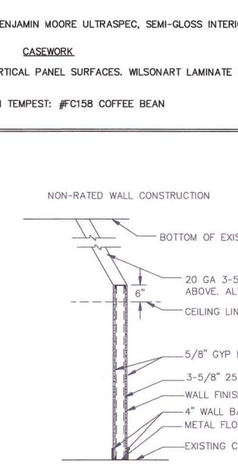

3 / A1.0 DOOR DETAIL
SCALE: NTS

A / A1.0 NON-RATED PARTITION
1/2" = 1'-0"

FINISH SPECIFICATIONS

WALLS

P-1: (FIELD COLOR ROOM AREA) BENJAMIN MOORE ULTRASPEC, SEMI-GLOSS INTERIOR PAINT, 2 COATS ON WALLS. COLOR: 958 (OCEAN BEACH)

P-2: (DOOR FRAMES) BENJAMIN MOORE ULTRASPEC, SEMI-GLOSS INTERIOR PAINT, 2 COATS. COLOR: HC-45 (SHAKER BEIGE).

CASEWORK

PL-1: APPLY TO ALL VERTICAL PANEL SURFACES. WILSONART LAMINATE COLOR: SHAKER CHERRY, 7935-07. USE 3MM EDGING TO MATCH.

SS-1: SAMSUNG, STARON TEMPEST: #FC158 COFFEE BEAN

DWG SHEET SIZE: 36" x 24"

The Medical Center of Aurora
HealthONE

TRIAGE DOOR REPLACEMENT

MEDICAL CENTER OF AURORA
1501 SOUTH POTOMAC STREET
AURORA, COLORADO 80012

TOM THOMPSON ARCHITECT
2510 SOUTH OSCEOLA STREET
DENVER, COLORADO 80219
720.989.6084
TomThompsonArchitect@gmail.com

ASSOCIATIONS

dp DESIGN LOT
dpteam@thedesignplot.com
(303) 565-7282

All drawings and written material appearing herein constitute the original and unpublished work of Tom Thompson, Architect. These documents are strictly proprietary and confidential. They are not to be disclosed to third parties, distributed or reproduced without the express written permission of Tom Thompson, Architect.

STATE OF COLORADO
TOM THOMPSON
305692
1.30.18
LICENSED ARCHITECT

PROJECT NO.: 18-01

DRAWN BY: TH
CHECKED BY: TT
SCALE:
DATE: 1/30/2018
ISSUED FOR: CONSTRUCTION
REVISIONS:
1
2
3
4
5

SHEET TITLE:
DEMOLITION PLAN
FLOOR PLAN
ELEVATIONS/DETAILS

SHEET NO.:
A1.0