Medical Center of Aurora

South Campus - Private Room Expansion

1501 SOUTH POTOMAC STREET
AURORA, CO 80012


ISSUED FOR PERMIT AND CONSTRUCTION

July 14, 2008

Construction Documents
ASI #18

PW PROJECT # 142228.000
HCA #306660001

FACILITY	OWNER	ARCHITECT	INTERIOR DESIGN	STRUCT. ENGINEER	MEP ENGINEER	CIVIL ENGINEER	LANDSCAPE
MEDICAL CENTER OF AURORA SOUTH CAMPUS 1501 SOUTH POTOMAC STREET AURORA, CO 80012 (303) 695-2603 (303) 337-9773 FAX CONTACT: MARY BERRIGAN CONTACT: DENNIS SOBOLIK	HCA HEALTHCARE CORP. ONE PARK PLAZA, BLDG. 2 , EAST, 3RD FLR NASHVILLE, TENNESSEE 37203 (615) 344-1137 (615) 944-4520 FAX CONTACT: CLINT RUSSELL	PERKINS & WILL - CRA 10100 N. CENTRAL EXPWY DALLAS, TX 75231 (214) 283-8700 (214) 283-8701 FAX CONTACT: CARY GARNER CONTACT: DIMITRI ENGLERT	PERKINS & WILL - CRA 10100 N. CENTRAL EXPWY DALLAS, TX 75231 (214) 283-8700 (214) 283-8701 FAX CONTACT: CHANDANA NARAYAN CONTACT: JOY BARTOLOTTA	TRC International, Ltd. 5050 QUARUM DRIVE, SUITE 700 Dallas, TX 75254 T: 214.722.6452 F: 214.722.6552 CONTACT: ANDY HAMMER	CCRD PARTNERS 3625 N. HALL STREET SUITE 1300, LB 139 DALLAS, TX-75219 T: 214.521.1661 F: 214.521.1664 CONTACT: JEFF BLACK	MARTIN/MARTIN INC 12499 WEST COLFAX AVE LAKEWOOD, CO 80215 T: 303.431.6100 F: 303.431.4028 CONTACT: DUANE JANSEN	DAVIS PARTNERSHIP 2310 BLAKE STREET, SUITE 100 DENVER, CO 80205 T: 303.861.8555 F: 303.861.3027 CONTACT: LYNN MOORE

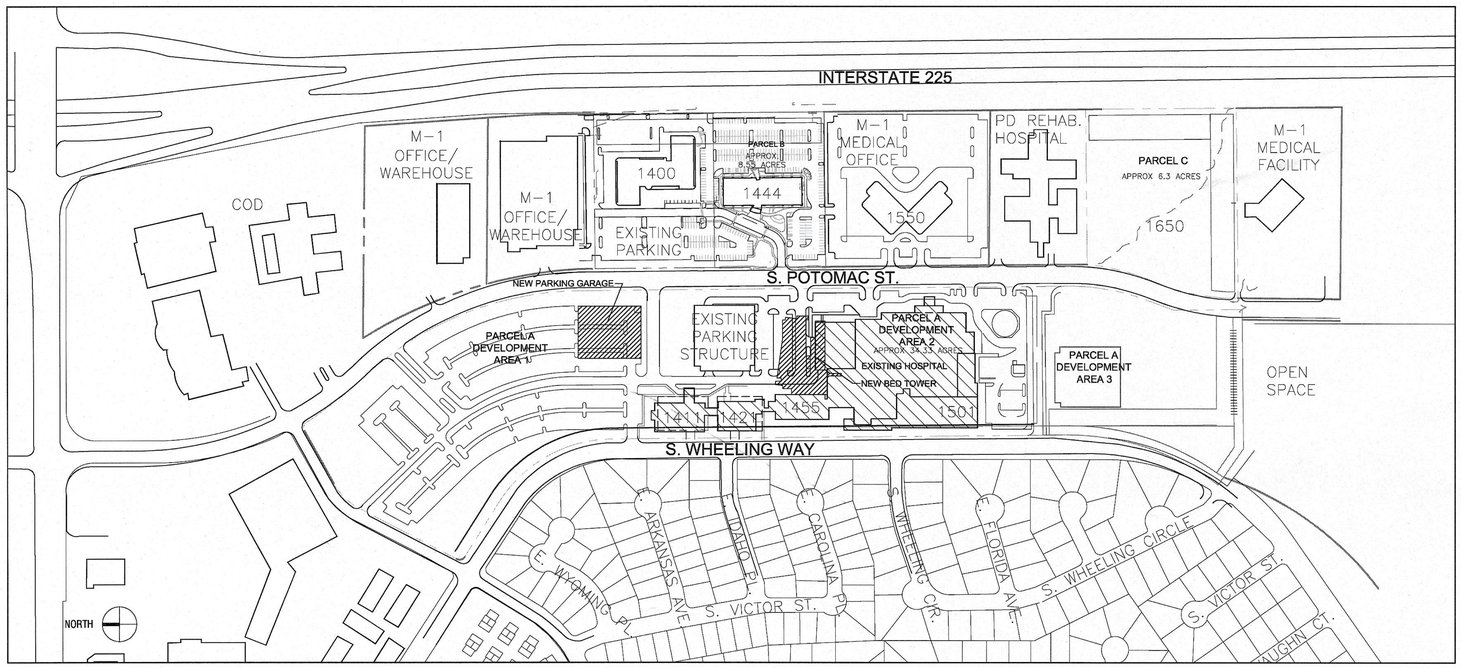


01 EXISTING SITE PLAN
0 8' 16' 32'
SCALE: 1" = 200'



ISSUE DATES


04/06/06 - 75% DD
04/20/06 - 100% DD
06/01/06 - EARLY RELEASE PKG #1
06/09/06 - 50% CD
07/13/06 - 75% CD
08/03/06 - 95% CD
08/24/06 - IRP #1, ADDEND. #1
08/24/06 - 100% CD
10/31/06 - 100% CD, ADDEND. #2
01/16/07 - 100% CD ASI #002
03/12/07 - 100% CD ASI #003
03/27/07 - 100% CD ASI #004
04/06/07 - 100% CD ASI #005
04/27/07 - 100% CD PR #01
05/21/07 - 100% CD PR #03
06/08/07 - 100% CD ASI #007
07/09/07 - 100% CD ASI #009
07/09/07 - 100% CD PR #06
08/02/07 - 100% CD PR #07
08/16/07 - 100% CD PR #08
08/17/07 - 100% CD PR #09
09/14/07 - 100% CD PR #12
10/26/07 - 100% CD PR #11
10/29/07 - 100% CD PR #14
11/05/07 - 100% CD PR #15
11/12/07 - 100% CD PR #13
11/14/07 - 100% CD PR #18
12/13/07 - 100% CD PR #16
01/25/08 - 100% CD PR #12R
02/08/08 - 100% CD PR #12R2
03/03/08 - 100% CD PR #21
05/13/08 - 100% CD PR #26
05/27/08 - 100% CD PR #27
07/14/08 - 100% CD ASI #18

OVERALL MAP

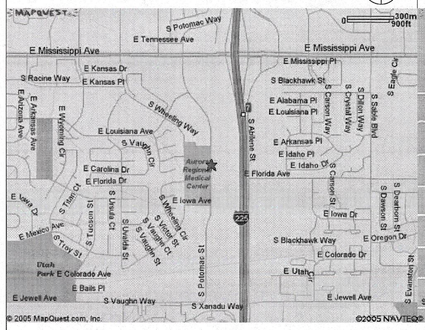

VICINITY MAP

Only highlighted or clouded revisions are approved on this review. All Previous comments apply.

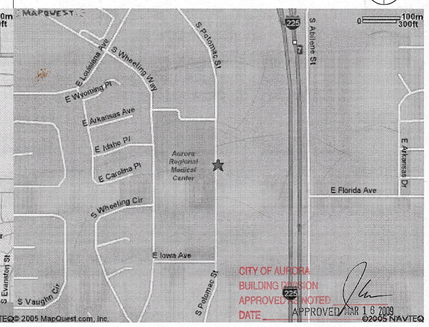

PERKINS & WILL
10100 North Central Expressway, Suite 300
Dallas, Texas 75231, USA
214.283.8700 Fax: 214.283.8701
www.perkinswill.com

Medical Center of Aurora
South Campus
Private Room Expansion
Aurora, Colorado

HCA
Project # 306660001

In association with:

CIVIL
Martin Martin, Inc.
4251 Kipling Street
Wheat Ridge, CO 80033
T: 303.431.6100
F: 303.431.4028

Structrual
TRC International, Ltd.
5050 QUARUM DRIVE, SUITE 700
Dallas, TX 75254
T: 214.722.6452
F: 214.722.6552

MEP
CCRD Partners
3625 N. HALL STREET
SUITE 1300, LB 139
DALLAS, TX-75219
T: 214.521.1661
F: 214.521.1664

LANDSCAPE
Davis Partnership
2310 BLAKE STREET, SUITE 100
DENVER, CO 80205
T: 303.861.8555
F: 303.861.3027

STATE OF COLORADO
TRUBY L. BOUCAL
203601
LICENSED ARCHITECT
07.14.08

Revisions

NO.	ISSUE	DATE
1	PR #16	12.13.07
2	PR #12R	01.25.08
3	PR #12R2	02.08.08
4	PR #21	03.03.08
5	PR #26	05.13.08
6	PR #27	05.27.08
7	ASI #18	07.14.08

Sheet Information

Date	08-24-2006
Job Number	142228.000
Drawn	DcE
Checked	DCE
Approved	CG

Title

08-309286

SITE PLAN
VICINITY MAP

Sheet

G-0000

Issued for Permit & Construction

Copyright © 2005 PERKINS & WILL

Jul 14, 2008 - 5:06pm
P:\Jobs\142228 Med Ctr of Aurora - Bed Tower Expan\CAD\SHEETS\G-0000-4SqF18.dwg
kimsott

Medical Center of Aurora

South Campus - Private Room Expansion

1501 SOUTH POTOMAC STREET
AURORA, CO 80012

July 14, 2008

PWCRA PROJECT # 142228.000
HCA #306660001

Construction Documents
ASI #18

SYMBOLS KEY

DRAWING NUMBER KEY

DISCIPLINE
A – ARCHITECTURAL
C – CIVIL
L – LANDSCAPE
M – MECHANICAL
E – ELECTRICAL
P – PLUMBING
S – STRUCTURAL
K – KITCHEN
R – RADIOLOGY

15/A-2010
NUMBER OF PLAN, DETAIL, ETC. ON SHEET
DRAWING SERIES

INITIAL ISSUE DATE → MAY 17, 2006
INITIAL ISSUE NAME → FOR CONSTRUCTION
REVISION NAME → CITY COMMENTS #1
ISSUE DATE → MAY 17, 2006

Volume 2


Volume 3

INDEX OF DRAWINGS

MEP

		ISSUE	DATE
		CD 100% Construction Issue	08.24.06
		Addendum #1 Issue	10.12.06
		AD #01 Issue	01.18.07
		AD #02 Issue	03.13.07
		AD #03 Issue	04.27.07
		PR #01 Issue	06.08.07
		PR #02 Issue	08.21.07
		AD #04 Issue	07.06.07
		PR #03 Issue	09.14.07
		PR #04 Issue	10.12.07
		PR #05 Issue	11.14.07
		PR #06 Issue	01.25.08
		PR #07 Issue	03.03.08
		PR #08 Issue	05.13.08
		PR #09 Issue	05.27.08
		AD #05 Issue	07.14.08

| | | |

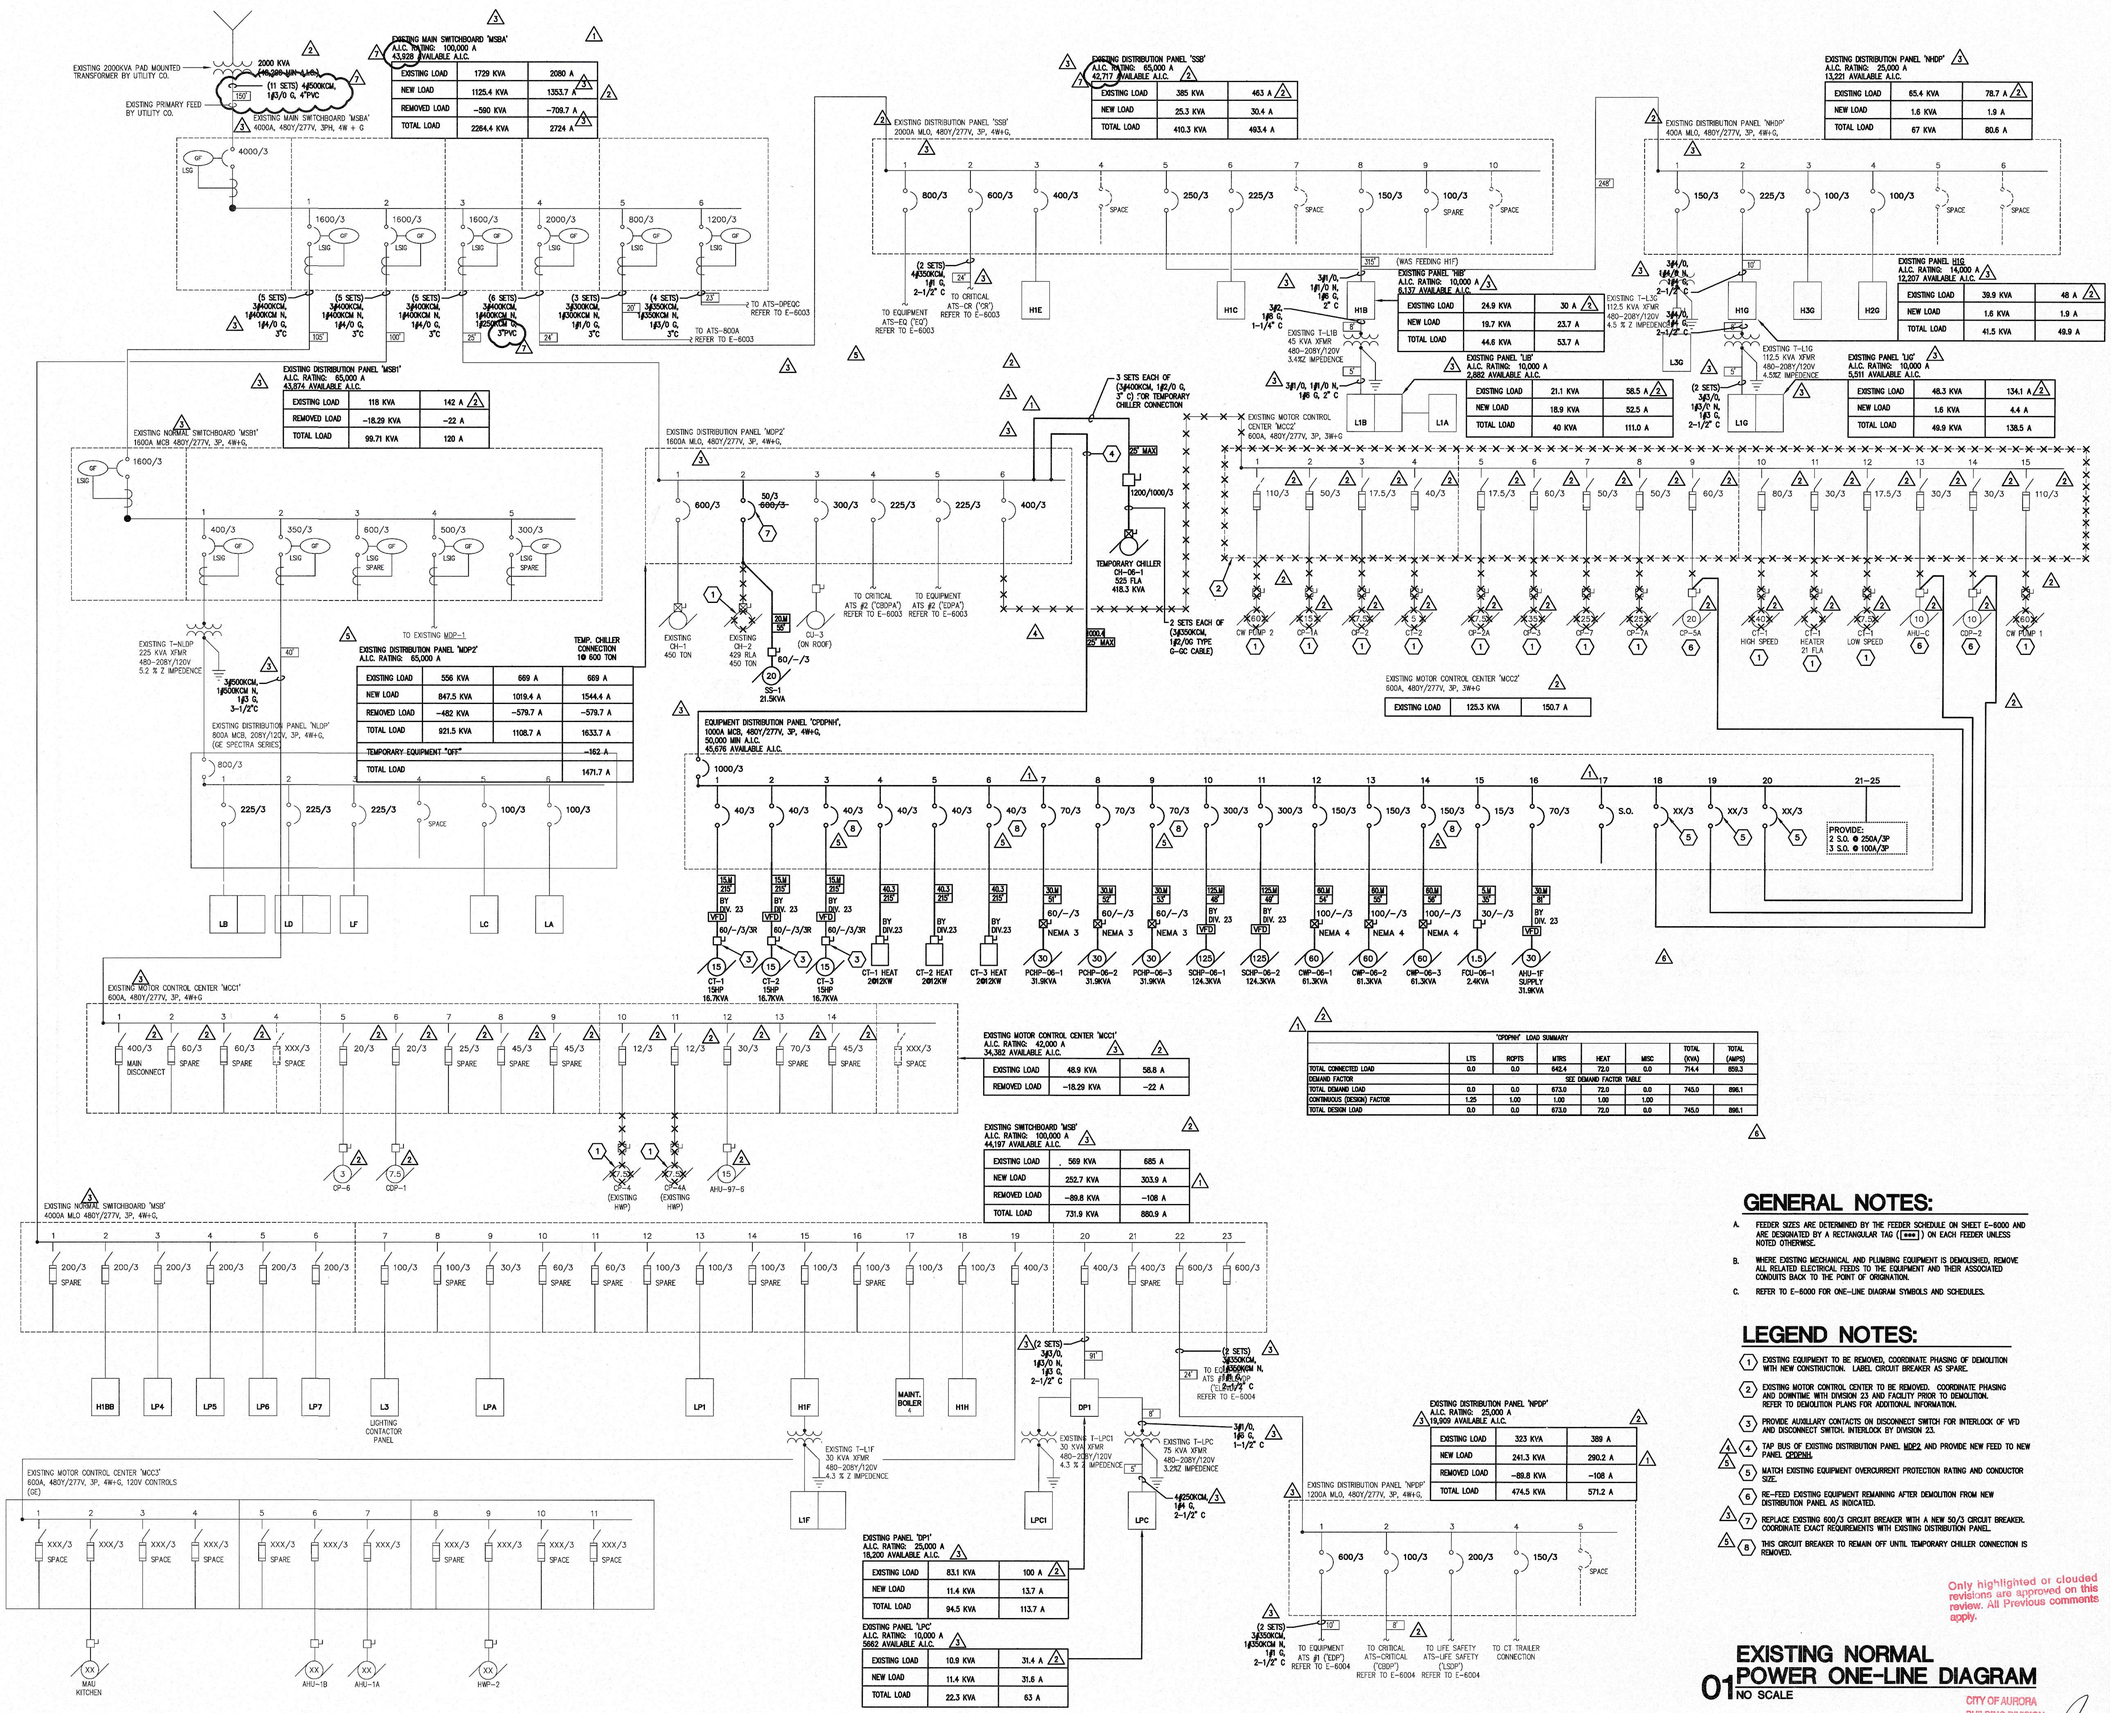

GENERAL NOTES:

A. FEEDER SIZES ARE DETERMINED BY THE FEEDER SCHEDULE ON SHEET E-6000 AND ARE DESIGNATED BY A RECTANGULAR TAG ([•••]) ON EACH FEEDER UNLESS NOTED OTHERWISE.

B. WHERE EXISTING MECHANICAL AND PLUMBING EQUIPMENT IS DEMOLISHED, REMOVE ALL RELATED ELECTRICAL FEEDS TO THE EQUIPMENT AND THEIR ASSOCIATED CONDUITS BACK TO THE POINT OF ORIGINATION.

C. REFER TO E-6000 FOR ONE-LINE DIAGRAM SYMBOLS AND SCHEDULES.

LEGEND NOTES:

1. EXISTING EQUIPMENT TO BE REMOVED, COORDINATE PHASING OF DEMOLITION WITH NEW CONSTRUCTION. LABEL CIRCUIT BREAKER AS SPARE.
2. EXISTING MOTOR CONTROL CENTER TO BE REMOVED. COORDINATE PHASING AND DOWNTIME WITH DIVISION 23 AND FACILITY PRIOR TO DEMOLITION. REFER TO DEMOLITION PLANS FOR ADDITIONAL INFORMATION.
3. PROVIDE AUXILLARY CONTACTS ON DISCONNECT SWITCH FOR INTERLOCK OF VFD AND DISCONNECT SWITCH. INTERLOCK BY DIVISION 23.
4. TAP BUS OF EXISTING DISTRIBUTION PANEL MDP2 AND PROVIDE NEW FEED TO NEW PANEL CPDPNH.
5. MATCH EXISTING EQUIPMENT OVERCURRENT PROTECTION RATING AND CONDUCTOR SIZE.
6. RE-FEED EXISTING EQUIPMENT REMAINING AFTER DEMOLITION FROM NEW DISTRIBUTION PANEL AS INDICATED.
7. REPLACE EXISTING 600/3 CIRCUIT BREAKER WITH A NEW 50/3 CIRCUIT BREAKER. COORDINATE EXACT REQUIREMENTS WITH EXISTING DISTRIBUTION PANEL.
8. THIS CIRCUIT BREAKER TO REMAIN OFF UNTIL TEMPORARY CHILLER CONNECTION IS REMOVED.

Only highlighted or clouded revisions are approved on this review. All Previous comments apply.

01 EXISTING NORMAL POWER ONE-LINE DIAGRAM

NO SCALE

CITY OF AURORA
BUILDING DIVISION
APPROVED AS NOTED
DATE APPROVED MAR 1 6 2009

PERKINS & WILL
8200 North Central Expressway
Dallas, Texas 75206 USA
214.775.6200 Fax: 214.775.6201
www.perkinswill.com

Medical Center of Aurora

South Campus
Private Room Expansion
Aurora, Colorado

HCA

Project # 306660001

In association with:

Civil
Martin Martin, INc.
4251 Kipling Street
Wheat Ridge, CO 80033
T: 303.431.6100
F: 303.431.4028

Structrual
TRC International, Ltd.
5050 QUARUM DRIVE, SUITE 700
Dallas, TX 75254
T: 214.722.8452
F: 214.722.6552

MEP
CCRD Partners
3625 N. HALL STREET
SUITE 1300, LB 139
DALLAS, TX-75219
T: 214.521.1661
F: 214.521.1664

LANDSCAPE
Davis Partnership
2310 BLAKE STREET, SUITE 100
DENVER, CO 80205
T: 303.861.8555
F: 303.861.3027

AUGUST 24, 2006 - 100% CD'S ISSUED FOR PERMIT & CONSTRUCTION

COLORADO LICENSED 41031 PROFESSIONAL ENGINEER 03-06

NO.	ISSUE	DATE
	Revisions	
1	ADDENDUM #2	10/31/06
2	ASI #2	01/18/07
3	ASI #3	03/12/07
4	RFI #67	03/22/07
5	PR #3	05/21/07
6	PR #27	05/27/08
7	ASI #18	07/09/08

Sheet Information

Date 08-24-2006
Job Number 142228.000
Drawn SG
Checked SG
Approved SG

Title: EXISTING NORMAL POWER ONE-LINE DIAGRAM

Sheet: 08-309286

E-6001

Issued for Permit & Construction

Copyright © 2005 PERKINS & WILL

F:\2005 Projects\2005555 Medical Center of Aurora Expansion\Drawings\Construction Documents\5555E-6001.dwg 06/20/2008 - 3:27PM Ty Shafner, CCRD Partners

GENERAL NOTES:

A. FEEDER SIZES ARE DETERMINED BY THE FEEDER SCHEDULE ON SHEET E-6000 AND ARE DESIGNATED BY A RECTANGULAR TAG ([###]) ON EACH FEEDER UNLESS NOTED OTHERWISE.

B. REFER TO E-6000 FOR ONE-LINE DIAGRAM SYMBOLS AND SCHEDULES.

LEGEND NOTES:

1. EXISTING DISTRIBUTION PANEL TO BE DEMOLISHED AND REPLACED WITH NEW DISTRIBUTION PANEL IN SAME LOCATION AS INDICATED. IF EXISTING DISTRIBUTION PANEL CAN BE MODIFIED TO ACCOMODATE NEW LOADS, EXISTING DISTRIBUTION PANEL MAY BE RE-USED.
2. 1200A TEMPORARY GENERATOR CONNECTION CABINET EQUAL TO CUTLER-HAMMER LOW VOLTAGE "GENERATOR QUICK CONNECT SWITCHBOARD", NEMA 3R CONSTRUCTION, WITH EXTRA TALL DOOR TO ACCOMMODATE (8) PARALLELED SETS OF CABLE FROM TEMPORARY GENERATOR. REFER TO E-1001B FOR EXACT LOCATION.
3. PROVIDE MECHANICAL AND ELECTRONIC LOCK OUT TO ALLOW ONLY ONE CIRCUIT BREAKER TO BE IN THE CLOSED POSITION AT ANY TIME.
4. EXISTING FEEDERS TO BE REMOVED AND RE-PULLED TO ACCOMODATE NEW GARAGE DOOR IN CENTRAL PLANT. REFER TO ENLARGED CENTRAL PLANT PLAN, 02/E-5001 FOR ADDITIONAL INFORMATION.

EXISTING 600KW/750KVA, 480V, .8PF, 902A, W/GROUND FAULT INDICATION EMERGENCY DIESEL ENGINE GENERATOR B (CUMMINS)

EXISTING 1250KW/1600KVA, 480V, .8PF W/GROUND FAULT INDICATION EMERGENCY DIESEL ENGINE GENERATOR C (CUMMINS)

EXISTING 600KW/750KVA, 480V, .8PF, 902A W/GROUND FAULT INDICATION EMERGENCY DIESEL ENGINE GENERATOR A (CUMMINS)

GEN B — 1200/3

GEN C — 1200/3, 800/3

GEN A — 1200/3

(4 SETS) 3#350KCM, 1#350KCM N, 1#3/0 G, 3"C

EXISTING DISTRIBUTION PANEL 'DPQC' 1200A MLO, 480Y/277V, 3P, 4W+G

NEW MAIN DISTRIBUTION PANEL 'DPGC', 1200A MLO, 480Y/277V, 3P, 4W+G, 42,000 MIN A.I.C. 16,514 AVAILABLE A.I.C.

PROVIDES: 1 S.O. @ 800A/3P, 2 S.O. @ 600A/3P, 1 S.O. @ 400A/3P

600KW TEMP GEN SET AT .8PF

1200 AMP NEMA 3R TAP CAN WITH FULLY RATED BUSBARS FOR TEMPORARY GENERATOR CONNECTION.

FEEDERS ROUTED FROM EXISTING CENTRAL PLANT TO NEW MAIN EMERGENCY ELECTRICAL ROOM IN CONCRETE ENCASED DUCTBANK ARRANGEMENT

TO ATS-1DPEQH REFER TO SHEET E-6005

TO ATS-1DPLSH REFER TO SHEET E-6002

TO ATS-1DPCRH REFER TO SHEET E-6002

TO FIRE PUMP TRANSFER SWITCH REFER TO SHEET E-6002

TO MSBA-6 REFER TO E-6001

TO MSBA-5 REFER TO E-6001

EQUIPMENT BRANCH OPEN TRANSITION 4-POLE 1200A (CUMMINS) ATS DPEQC

EQUIPMENT BRANCH OPEN TRANSITION 4-POLE 800A (CUMMINS) ATS-800A

TO 'QHTF'

EXISTING DISTRIBUTION PANEL 'MTSB' 1200A MLO, 480Y/277V, 3P, 4W+G 5,302 AVAILABLE A.I.C.

EXISTING DISTRIBUTION PANEL 'MTSA' 1200A MLO, 480Y/277V, 3P, 4W+G 5,984 AVAILABLE A.I.C.

'DPQC' LOAD SUMMARY

	LTS	RCPTS	MTRS	HSPTL	X-RAY	ELEV	KTCH	HEAT	MISC	TOTAL (KVA)	TOTAL (AMPS)
TOTAL CONNECTED LOAD	23.3	44.7	569.0	513.4	0.0	143.0	0.0	0.0	50.0	1343.4	1615.9
DEMAND FACTOR	SEE DEMAND FACTOR TABLE										
TOTAL DEMAND LOAD	23.0	27.5	563.8	112.8	0.0	121.6	0.0	0.0	50.0	928.4	1116.7
CONTINUOUS (DESIGN) FACTOR	1.25	1.00	1.00	1.00	1.00	1.00	1.00	1.00	1.00		
TOTAL DESIGN LOAD	28.8	27.5	563.8	112.8	0.0	121.6	0.0	0.0	50.0	934.2	1123.6

EXISTING EMERGENCY DISTRIBUTION PANEL 'DPEQC' 1200A MLO, 480Y/277V, 3PH, 4W + G

EXISTING DISTRIBUTION PANEL DPEQC — A.I.C. RATING: 100,000 A, 48,471 AVAILABLE A.I.C.

EXISTING LOAD	97.8 KVA	117.7 A

EXISTING DISTRIBUTION PANEL 'SGDP' — A.I.C. RATING: 25,000 A, 5,289 AVAILABLE A.I.C.

EXISTING LOAD	250 KVA	300.7 A
NEW LOAD	245.3 KVA	295.0 A
TOTAL LOAD	495.3 KVA	595.7 A

EXISTING EMERGENCY DISTRIBUTION PANEL 'SGDP' 1200A MLO, 480Y/277V, 3PH, 4W + G

XXX/3 SPARE; 60/3 KH; 175/3 GENERATOR C HEATER; 20/3 GENERATOR C HEATER; 20/3 EHPNL; 175/3 LPB

EXISTING T-LPB 112.5 KVA XFMR 480-208/120V 4.5 % Z IMPEDENCE

EXISTING EMERGENCY DISTRIBUTION PANEL 'GPDPA' 1200A MLO, 480Y/277V, 3PH, 4W + G

EXISTING DISTRIBUTING PANEL 'GPDPA' — A.I.C. RATING: 42,000 A, 6,984 AVAILABLE A.I.C.

EXISTING LOAD	420.7 KVA	506 A
NEW LOAD	242.3 KVA	291.4 A
REMOVED LOAD	-89.8 KVA	-108 A
TOTAL LOAD	573.1 KVA	689.4 A

EXISTING DISTRIBUTION PANEL 'GPDP' — A.I.C. RATING: 10,000 A, 6,757 AVAILABLE A.I.C.

EXISTING LOAD	360 KVA	433 A
NEW LOAD	241.3 KVA	290.2 A
REMOVED LOAD	-89.8 KVA	-108 A
TOTAL LOAD	511.5 KVA	615.2 A

EXISTING DISTRIBUTION PANEL EQ — A.I.C. RATING: 42,000 A, AVAILABLE A.I.C. 37,273 A

EXISTING LOAD	131.9 KVA	158.7 A
NEW LOAD	241.3 KVA	290.2 A
TOTAL LOAD	373.2 KVA	449.0 A

EXISTING DISTRIBUTION PANEL 'EQ' 800A MLO, 480Y/277V, 3P, 4W+G, 42,000 A.I.C.

ATS-EQ — EQUIPMENT BRANCH OPEN TRANSITION 4-POLE 800A (ZENITH)

ATS-CR — CRITICAL BRANCH OPEN TRANSITION 4-POLE 600A (ZENITH)

(2 SETS) 4#500KCM, 1#1/0 G, 3" EMT

(2 SETS) 4#500KCM, 1#1/0 G, 3" PVC

EXISTING DISTRIBUTION PANEL 'GPDP' 1200A MLO, 480Y/277V, 3P, 4W+G

TO EQUIPMENT ATS #1 ("EDP") REFER TO E-6004

TO CRITICAL ATS CRITICAL ("CBDP") REFER TO E-6004

TO LIFE SAFETY ATS LIFE SAFETY ("LSDP") REFER TO E-6004

400A FUSED DISCONNECT. MAX. LET-THRU CURRENT: 25KA SERIES RATED TO 150KA W/ DOWNSTREAM DEVICES.

TO 'CPDPSGH' REF:E-6004

EXISTING DISTRIBUTION PANEL 'EDPA' 225A MLO, 480Y/277V, 3P, 4W+G, 65,000 A.I.C. (GE)

AHU-A; AHU-B; UP-1; MAC-1; QHH

ATS #2 (2A) — EQUIPMENT BRANCH OPEN TRANSITION 4-POLE 225A (KOHLER)

ATS #2 (1A) — CRITICAL BRANCH OPEN TRANSITION 4-POLE 225A (KOHLER)

EXISTING DISTRIBUTION PANEL 'CBDPA' 250A, 480Y/277V, 3P, 4W+G,

EXISTING DISTRIBUTION PANEL 'CBDPA' — A.I.C. RATINGS: 25,000 A, 12,553 AVAILABLE A.I.C.

EXISTING LOAD	60.7 KVA	73 A
NEW LOAD	1.0 KVA	1.2 A
TOTAL LOAD	61.7 KVA	74.2 A

EXISTING T-LCBDPA 112.5 KVA XFMR 480-208/120V 4.5%Z IMPEDENCE

EXISTING DISTRIBUTION PANEL 'LCBDPA' — A.I.C. RATING: 10,000 A, 3,540 AVAILABLE A.I.C.

EXISTING LOAD	26.3 KVA	73 A
NEW LOAD	1.0 KVA	2.8 A
TOTAL LOAD	27.3 KVA	75.8 A

EXISTING DISTRIBUTION PANEL 'LCBDPA' 400A MCB, 208/120V, 3P, 4W+G,

400/3; 100/3 LCB1A; 100/3 LCB3A; 100/3 LCB2A; 100/3 LCB4A; SPACE

EXISTING DISTRIBUTION PANEL 'QR' — A.I.C. RATING: 50,000 A, 44,117 AVAILABLE A.I.C.

EXISTING LOAD	117.8 KVA	141.7 A
NEW LOAD	4.0 KVA	4.8 A
TOTAL LOAD	121.8 KVA	146.5 A

EXISTING DISTRIBUTION PANEL 'CR' 800A MLO, 480Y/277V, 3P, 4W+G,

125/3 SPACE; 150/3 SPACE; 225/3 CRCH-H (BLDG 1455); 400/3 CH1C; CH1B; CH2B

EXISTING T-QL1B 15 KVA XFMR 480-208Y/120V 2.8 % Z IMPEDENCE

EXISTING T-L1G 75 KVA XFMR 480-208Y/120V 3.25Z IMPEDENCE

EXISTING DISTRIBUTION PANEL 'CHDP' 400A MLO, 480Y/277V, 3P, 4W+G,

XXX/3 SPARE; XXX/3 SPARE; XXX/3 SPARE; XXX/3 SPARE; 100/3 CH2G; 100/3 CH3G; 175/3 CL3G; 175/3 CL1G; CL2GG; CL2G

EXISTING T-CL1G 112.5 KVA XFMR 480-208/120V 4.5% Z IMPEDENCE

EXISTING DISTRIBUTION PANEL 'CHDP' — A.I.C. RATING: 42,000 A, 17,157 AVAILABLE A.I.C.

EXISTING LOAD	65.4 KVA	78.7 A
NEW LOAD	0.8 KVA	0.96 A
TOTAL LOAD	66.2 KVA	79.66 A

EXISTING PANEL CH1B — A.I.C. RATING: 42,000 A, 6,155 AVAILABLE A.I.C.

EXISTING LOAD	48 KVA	57.7 A
NEW LOAD	3.2 KVA	3.8 A
TOTAL LOAD	51.2 KVA	61.5 A

EXISTING PANEL CL1B — A.I.C. RATING: 10,000 A, 2,912 AVAILABLE A.I.C.

EXISTING LOAD	22 KVA	61.1 A
NEW LOAD	2.8 KVA	7.8 A
TOTAL LOAD	24.8 KVA	68.9 A

EXISTING PANEL CL1G — A.I.C. RATING: 10,000 A, 5,729 AVAILABLE A.I.C.

EXISTING LOAD	31 KVA	86 A
NEW LOAD	0.8 KVA	2.2 A
TOTAL LOAD	31.8 KVA	88.2 A

EXISTING PANEL 'LCB3A' — A.I.C. RATING: 10,000 A, 2,629 AVAILABLE A.I.C.

EXISTING LOAD	7 KVA	19.4 A
NEW LOAD	1.0 KVA	2.8 A
TOTAL LOAD	8 KVA	22.2 A

01 EXISTING EMERGENCY POWER ONE-LINE DIAGRAM

NO SCALE

Only highlighted or clouded revisions are approved on this review. All Previous comments apply.

CITY OF AURORA BUILDING DIVISION APPROVED AS NOTED DATE APPROVED MAR 16 2009

PERKINS & WILL

6200 North Central Expressway
Dallas, Texas 75206 USA
214.775.6200 Fax 214.775.6201
www.perkinswill.com

Medical Center of Aurora
South Campus
Private Room Expansion
Aurora, Colorado

HCA
Project # 306660001

In association with:

CM#
Martin Martin, INc.
4251 Kipling Street
Wheat Ridge, CO 80033
T: 303.431.6100
F: 303.431.4028

Structural
TRC International, Ltd.
5050 QUARUM DRIVE, SUITE 700
Dallas, TX 75254
T: 214.722.6452
F: 214.722.6552

MEP
CCRD Partners
3625 N. HALL STREET
SUITE 1300, LB 139
DALLAS, TX-75219
T: 214.521.1661
F: 214.521.1664

LANDSCAPE
Davis Partnership
2310 BLAKE STREET, SUITE 100
DENVER, CO 80205
T: 303.861.8555
F: 303.861.3027

AUGUST 24, 2006 - 100% CD'S ISSUED FOR PERMIT & CONSTRUCTION

COLORADO LICENSED 31031 PROFESSIONAL ENGINEER 07-09-08

Revisions

NO.	ISSUE	DATE
1	ADDENDUM #2	10/31/06
2	ASI #2	01/18/07
3	ASI #3	03/12/07
4	PR #6	07/24/07
5	PR #13	10/12/07
6	PR #6r	10/22/07
7	PR #21	03/03/08
8	ASI #18	07/09/08

Sheet Information

Date	08-24-2006
Job Number	142228.000
Drawn	SG
Checked	SG
Approved	SG

Title: EXISTING EMERGENCY POWER ONE-LINE DIAGRAM

Sheet: 08-309286 — **E-6003**

Issued for Permit & Construction

Copyright © 2005 PERKINS & WILL

F:\2005 Projects\205555 Medical Center of Aurora Expansion\Drawings\Construction Documents\05SE-6003.dwg
Ty Shaffer, CCRD Partners 08/20/2008 - 3:27PM

Medical Center of Aurora

South Campus - Private Room Expansion

1501 SOUTH POTOMAC STREET
AURORA, CO 80012


ISSUED FOR PERMIT AND CONSTRUCTION

March 3, 2008

Construction Documents
PR #21

PW PROJECT # 142228.000
HCA #306660001

FACILITY	OWNER	ARCHITECT	INTERIOR DESIGN	STRUCT. ENGINEER	MEP ENGINEER	CIVIL ENGINEER	LANDSCAPE
MEDICAL CENTER OF AURORA SOUTH CAMPUS 1501 SOUTH POTOMAC STREET AURORA, CO 80012 (303) 695-2603 (303) 337-9773 FAX CONTACT: MARY BERRIGAN CONTACT: DENNIS SOBOLIK	HCA HEALTHCARE CORP. ONE PARK PLAZA, BLDG. 2 , EAST, 3RD FLR NASHVILLE, TENNESSEE 37203 (615) 344-1137 (615) 944-4520 FAX CONTACT: CLINT RUSSELL	PERKINS & WILL - CRA 10100 N. CENTRAL EXPWY DALLAS, TX 75231 (214) 283-8700 (214) 283-8701 FAX CONTACT: CARY GARNER CONTACT: DIMITRI ENGLERT	PERKINS & WILL - CRA 10100 N. CENTRAL EXPWY DALLAS, TX 75231 (214) 283-8700 (214) 283-8701 FAX CONTACT: CHANDANA NARAYAN CONTACT: JOY BARTOLOTTA	TRC International, Ltd. 5050 QUARUM DRIVE, SUITE 700 Dallas, TX 75254 T: 214.722.6452 F: 214.722.6552 CONTACT: ANDY HAMMER	CCRD PARTNERS 3625 N. HALL STREET SUITE 1300, LB 139 DALLAS, TX-75219 T: 214.521.1661 F: 214.521.1664 CONTACT: JEFF BLACK	MARTIN/MARTIN INC 12499 WEST COLFAX AVE LAKEWOOD, CO 80215 T: 303.431.6100 F: 303.431.4028 CONTACT: DUANE JANSEN	DAVIS PARTNERSHIP 2310 BLAKE STREET, SUITE 100 DENVER, CO 80205 T: 303.861.8555 F: 303.861.3027 CONTACT: LYNN MOORE

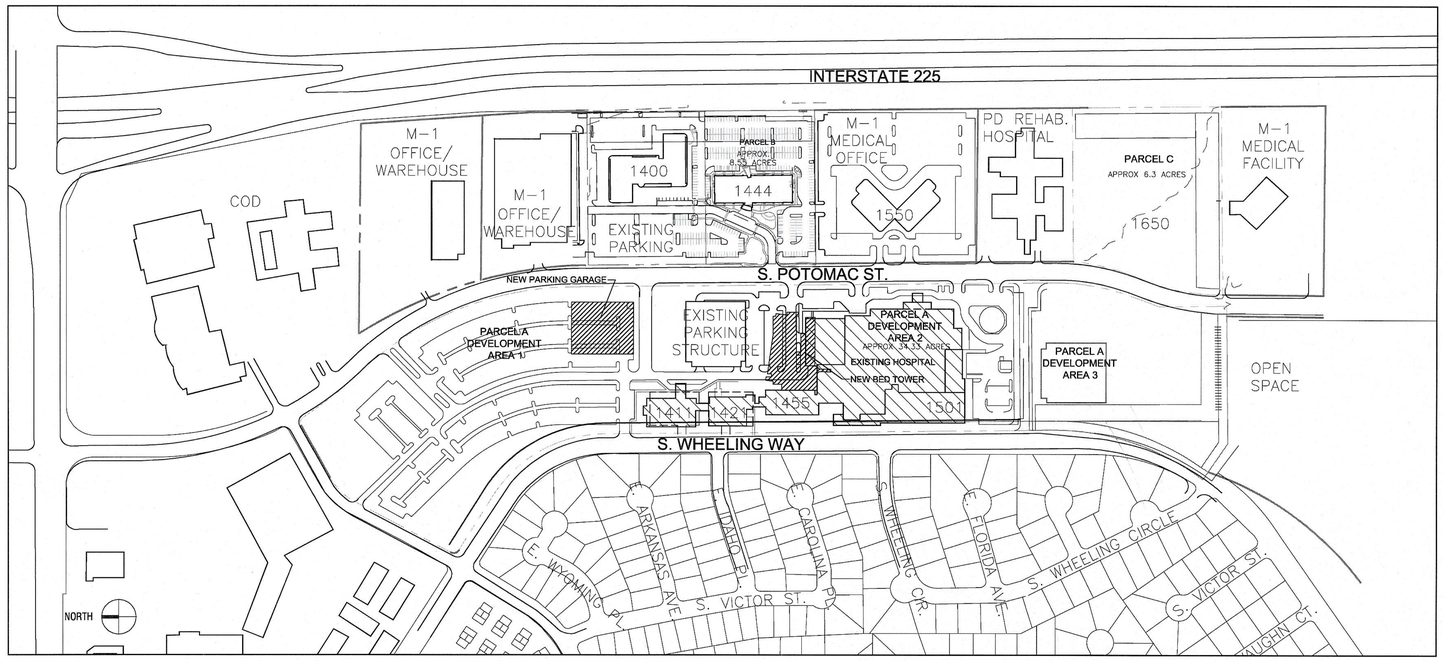

01 EXISTING SITE PLAN
0 8' 16' 32'
SCALE: 1" = 200'


EXTERIOR IMAGE




ISSUE DATES

04/06/06 - 75% DD
04/20/06 - 100% DD
06/01/06 - EARLY RELEASE PKG #1
06/09/06 - 50% CD
07/13/06 - 75% CD
08/03/06 - 95% CD
08/24/06 - ERP #1, ADDEND. #1
08/24/06 - 100% CD
10/31/06 - 100% CD, ADDEND. #2
01/18/07 - 100% CD ASI #002
03/12/07 - 100% CD ASI #003
03/27/07 - 100% CD ASI #004
04/06/07 - 100% CD ASI #005
04/27/07 - 100% CD PR #01
05/21/07 - 100% CD PR #03
06/08/07 - 100% CD ASI #007
07/09/07 - 100% CD ASI #009
07/09/07 - 100% CD PR #06
08/02/07 - 100% CD PR #07
08/16/07 - 100% CD PR #08
08/17/07 - 100% CD PR #09
09/14/07 - 100% CD PR #12
10/29/07 - 100% CD PR #11
10/29/07 - 100% CD PR #14
11/05/07 - 100% CD PR #15
11/14/07 - 100% CD PR #18
12/13/07 - 100% CD PR #16
01/25/08 - 100% CD PR #12R
02/08/08 - 100% CD PR #12R2
03/03/08 - 100% CD PR #21

OVERALL MAP

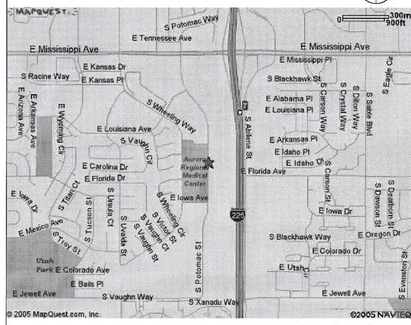

VICINITY MAP

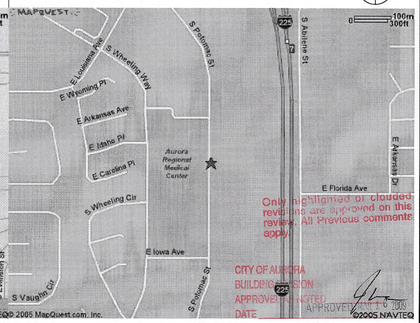

Only highlighted or clouded revisions are reviewed on this review. All previous comments apply.

CITY OF AURORA
BUILDING DIVISION
APPROVED NOTED
DATE _____ APPROVED WITH CON

PERKINS & WILL
10100 North Central Expressway, Suite 300
Dallas, Texas 75231, USA
214.283.8700 Fax: 214.283.8701
www.perkinswill.com

Medical Center of Aurora
South Campus
Private Room Expansion
Aurora, Colorado

HCA
Project # 306660001

In association with:

Civil
Martin Martin, Inc.
4251 Kipling Street
Wheat Ridge, CO 80033
T: 303.431.6100
F: 303.431.4028

Structrual
TRC International, Ltd.
5050 QUARUM DRIVE, SUITE 700
Dallas, TX 75254
T: 214.722.6452
F: 214.722.6552

MEP
CCRD Partners
3625 N. HALL STREET
SUITE 1300, LB 139
DALLAS, TX-75219
T: 214.521.1661
F: 214.521.1664

LANDSCAPE
Davis Partnership
2310 BLAKE STREET, SUITE 100
DENVER, CO 80205
T: 303.861.8555
F: 303.861.3027

STATE OF COLORADO
TRUBY L. DOUCET
203601
LICENSED ARCHITECT
3.03.08

NO.	ISSUE	DATE
	Revisions	
1	PR #16	12.13.07
2	PR #12R	01.25.08
3	PR #12R2	02.08.08
4	PR #21	03.03.08

Sheet Information

Date	08-24-2006
Job Number	142228.000
Drawn	DcE
Checked	DCE
Approved	CG

Title

SITE PLAN
VICINITY MAP

Sheet

G-0000

Issued for Permit & Construction

Copyright © 2005 PERKINS & WILL

Mar 11, 2008 - 2:40pm
P:\Dallas\142228 Med Ctr of Aurora - Bed Tower Expan\CAD\SHEETS\G-0000-PR#21.dwg
kimbalt

Medical Center of Aurora

South Campus - Private Room Expansion

1501 SOUTH POTOMAC STREET
AURORA, CO 80012

March 3, 2008

PWCRA PROJECT # 142228.000
HCA #306660001

Construction Documents
PR #21

SYMBOLS KEY

DRAWING NUMBER KEY

DISCIPLINE
A – ARCHITECTURAL
C – CIVIL
L – LANDSCAPE
M – MECHANICAL
E – ELECTRICAL
P – PLUMBING
S – STRUCTURAL
K – KITCHEN
R – RADIOLOGY

15/A-2010
- NUMBER OF PLAN, DETAIL, ETC. ON SHEET
- DRAWING SERIES
- INITIAL ISSUE DATE
- INITIAL ISSUE NAME
- REVISION NAME

ISSUE DATE
FOR CONSTRUCTION MAY 17, 2006
CITY COMMENTS #1 MAY 17, 2006

Volume 2

Volume 3

INDEX OF DRAWINGS

MEP

		ISSUE	DATE
		CD 100% Construction Issue	09-24-06
		Addendum #1 Issue	10-27-06
		AD #1 Issue	11-14-07
		AD #2 Issue	12-13-07
		AD #3 Issue	02-21-07
		PR #1 Issue	04-27-07
		PR #2 Issue	05-25-07
		AD #4 Issue	06-08-07
		PR #3 Issue	07-09-07
		AD #5 Issue	08-02-07
		PR #4 Issue	09-14-07
		PR #5 Issue	10-12-07
		PR #6 Issue	11-14-07
		PR #7 Issue	12-13-07
		PR #8 Issue	01-25-08
		PR #9 Issue	03-03-08

M1P-1000	SITE PLAN - MEP	●
M1P-1001	ROOF PLAN - MEP	● ●
M2-2001A	DUCTWORK DEMO PLAN FIRST FLOOR AREA 'A'	●
M2-2001B	DUCTWORK DEMO PLAN FIRST FLOOR AREA 'B'	●
M2-2001C	DUCTWORK DEMO PLAN FIRST FLOOR AREAS 'C' & 'D'	●
M2-2001D	DUCTWORK DEMO PLAN FIRST FLOOR ENGINEERING	●
M2-2001A	HVAC PIPING DEMO PLAN FIRST FLOOR AREA 'A'	●
M2-2001B	HVAC PIPING DEMO PLAN FIRST FLOOR AREA 'B'	
M2-2001C	HVAC PIPING DEMO PLAN FIRST FLOOR AREAS 'C' & 'D'	●
M2-2001D	HVAC PIPING DEMO PLAN FIRST FLOOR ENGINEERING	●
M-0003	GENERAL INFORMATION MECHANICAL	
M2-2001	ENLARGED MECHANICAL ROOMS DEMO	●
M-1301	CONTROLS DIAGRAMS MECHANICAL	●
M-1302	CONTROLS DIAGRAMS MECHANICAL	●
M-1303	CONTROLS DIAGRAMS MECHANICAL	●
M-1304	CONTROLS DIAGRAMS MECHANICAL	●
M-1305	CONTROLS DIAGRAMS MECHANICAL	●
M-1306	CONTROLS DIAGRAMS MECHANICAL	● ●
M-1307	CONTROLS DIAGRAMS MECHANICAL	● ●
M-2001A	DUCTWORK PLAN FIRST FLOOR AREA 'A'	● ●
M-2001B	DUCTWORK PLAN FIRST FLOOR AREA 'B'	●
M-2001C	DUCTWORK PLAN FIRST FLOOR AREAS 'C' & 'D'	●
M-2001E	DUCTWORK PLAN FIRST FLOOR ENGINEERING, MECHANICAL ROOM, AND BASEMENT	●
M-2002	DUCTWORK PLAN SECOND FLOOR	●
M-2003	DUCTWORK PLAN THIRD FLOOR	●
M-2004	DUCTWORK PLAN FOURTH FLOOR	●
M-2005	DUCTWORK PLAN FIFTH FLOOR	●
M-3001A	HVAC PIPING PLAN FIRST FLOOR AREA 'A'	● ●
M-3001B	HVAC PIPING PLAN FIRST FLOOR AREA 'B'	●
M-3001C	HVAC PIPING PLAN FIRST FLOOR AREAS 'C' & 'D'	●
M-3001D	HVAC PIPING PLAN FIRST FLOOR ENGINEERING AND MECHANICAL ROOM	●
M-3002	HVAC PIPING PLAN SECOND FLOOR	●
M-3003	HVAC PIPING PLAN THIRD FLOOR	●
M-3004	HVAC PIPING PLAN FOURTH FLOOR	●
M-3005	HVAC PIPING PLAN FIFTH FLOOR	●
M-4001	MECHANICAL SECTIONS	● ●
M-0001	ENLARGED MECHANICAL ROOMS	● ●
M-0001T	ENLARGED MECHANICAL, TEMP CHILLER PLAN	
M-0002	ENLARGED MECHANICAL ROOMS	●
M-0003	ENLARGED MECHANICAL ROOMS	● ●
M-0004	ENLARGED MECHANICAL PLANS	
M-0001	CENTRAL PLANT CHILLED WATER FLOW DIAGRAM	●
M-0002	MECHANICAL FLOW DIAGRAMS	●
M-0003	MECHANICAL FLOW DIAGRAMS	●
M-0004	CHILLED WATER FLOW DIAGRAM	●
M-0005	STEAM AND HEATING WATER FLOW DIAGRAM	●
M-0006	AIR RISER SCHEMATIC FLOW DIAGRAM	●
M-7001	MECHANICAL DETAILS	●
M-7002	MECHANICAL DETAILS	●
M-7003	MECHANICAL DETAILS	●
M-7004	MECHANICAL DETAILS	●
M-7005	MECHANICAL DETAILS	●
M-7006	MECHANICAL DETAILS	●
M-7007	MECHANICAL DETAILS	●
M-6001	MECHANICAL SCHEDULES	●
M-6002	MECHANICAL SCHEDULES	● ●
M-6003	MECHANICAL SCHEDULES	● ●
M-6004	MECHANICAL SCHEDULES	●
P0-1001A	UNDERFLOOR DEMO UNDERFLOOR PLAN FIRST FLOOR AREA 'A'	●
P0-1001B	UNDERFLOOR DEMO UNDERFLOOR PLAN FIRST FLOOR AREA 'B'	●
P0-1001C	UNDERFLOOR DEMO UNDERFLOOR PLAN FIRST FLOOR AREAS 'C' & 'D'	● ●
P0-1001D	UNDERFLOOR DEMO PLAN FIRST FLOOR ENGINEERING	●
P0-2001C	PLUMBING DEMO UNDERFLOOR PLAN FIRST FLOOR AREA 'C' & 'D'	● ●
P0-2001A	PLUMBING DEMO PLAN FIRST FLOOR AREA 'A'	
P0-2001B	PLUMBING DEMO PLAN FIRST FLOOR AREA 'B'	
P0-2001C	PLUMBING DEMO PLAN FIRST FLOOR AREAS 'C' & 'D'	●
P0-2001D	PLUMBING DEMO PLAN FIRST FLOOR ENGINEERING	
P0-5001	ENLARGED CENTRAL PLANT DEMO	● ●
P-1001A	UNDERFLOOR PLAN FIRST FLOOR AREA 'A'	● ●
P-1001B	UNDERFLOOR PLAN FIRST FLOOR AREA 'B'	● ●
P-1001C	UNDERFLOOR PLAN FIRST FLOOR AREAS 'C' & 'D'	● ●
P-1001D	UNDERFLOOR PLAN FIRST FLOOR ENGINEERING AND BASEMENT	● ●

		ISSUE	DATE
		CD 100% Construction Issue	09-24-06
		Addendum #1 Issue	10-27-06
		AD #1 Issue	11-14-07
		AD #2 Issue	12-13-07
		AD #3 Issue	02-21-07
		PR #1 Issue	04-27-07
		PR #2 Issue	05-25-07
		AD #4 Issue	06-08-07
		PR #3 Issue	07-09-07
		AD #5 Issue	08-02-07
		PR #4 Issue	09-14-07
		PR #5 Issue	10-12-07
		PR #6 Issue	11-14-07
		PR #7 Issue	12-13-07
		PR #8 Issue	01-25-08
		PR #9 Issue	03-03-08

P-2001	OVERALL PLUMBING FIRST FLOOR PLAN	●
P-2001A	PLUMBING PLAN FIRST FLOOR AREA 'A'	● ●
P-2001B	PLUMBING PLAN FIRST FLOOR AREA 'B'	● ●
P-2001C	PLUMBING PLAN FIRST FLOOR AREAS 'C' & 'D'	● ●
P-2001D	PLUMBING PLAN FIRST FLOOR ENGINEERING AND BASEMENT	●
P-2002	PLUMBING PLAN SECOND FLOOR	● ●
P-2003	PLUMBING PLAN THIRD FLOOR	● ●
P-2004	PLUMBING PLAN FOURTH FLOOR	● ●
P-2005	PLUMBING PLAN FIFTH FLOOR	● ●
P-2006	OVERALL ROOF PLAN PLUMBING	●
P-3001A	MEDICAL GAS PLAN FIRST FLOOR AREA 'A'	●
P-3001B	MEDICAL GAS PLAN FIRST FLOOR AREA 'B'	●
P-3001C	MEDICAL GAS PLAN FIRST FLOOR AREA 'C' & 'D'	●
P-3001E	MEDICAL GAS PLAN FIRST FLOOR ENGINEERING AND BASEMENT	●
P-3002	MEDICAL GAS PLAN SECOND FLOOR	●
P-3003	MEDICAL GAS PLAN THIRD FLOOR	●
P-3004	MEDICAL GAS PLAN FOURTH FLOOR	●
P-3005	MEDICAL GAS PLAN FIFTH FLOOR	●
P-5001	ENLARGED PLANS	● ●
P-5002	ENLARGED PLANS	● ●
P-6001	PLUMBING DETAILS	● ●
P-6002	PLUMBING DETAILS	● ●
P-6003	FIRE PROTECTION DETAILS	●
P-7001	DOMESTIC WATER FLOW DIAGRAM	● ●
P-7002	FIRE PROTECTION WATER FLOW DIAGRAM	●
P-7003	MEDICAL GAS RISER DIAGRAM	● ●
P-7004	PLUMBING RISER DIAGRAM	● ●
P-7005	FUEL OIL SYSTEM PIPING DIAGRAM	●
P-8001	PLUMBING FIXTURE SCHEDULE	● ●
P-8002	PLUMBING EQUIPMENT SCHEDULES	● ●
E-1000	OVERALL SITE ELECTRICAL PLAN	● ●
E-1002A	PARTIAL SITE ELECTRICAL PLAN	●
E-1001B	PARTIAL SITE ELECTRICAL PLAN	● ●
E-1002	PHOTOMETRICS PLAN	●
ED-2001A	POWER DEMO PLAN FIRST FLOOR AREA 'A'	●
ED-2001B	POWER DEMO PLAN FIRST FLOOR AREA 'B'	●
ED-2001C	POWER DEMO PLAN FIRST FLOOR AREAS 'C' & 'D'	● ●
ED-2001D	POWER DEMO PLAN FIRST FLOOR ENGINEERING	●
ED-3001A	LIGHTING DEMO PLAN FIRST FLOOR AREA 'A'	●
ED-3001B	LIGHTING DEMO PLAN FIRST FLOOR AREA 'B'	●
ED-3001C	LIGHTING DEMO PLAN FIRST FLOOR AREAS 'C' & 'D'	●
ED-3001D	LIGHTING DEMO PLAN FIRST FLOOR ENGINEERING	●
E-2001A	POWER PLAN FIRST FLOOR AREA 'A'	●
E-2001B	POWER PLAN FIRST FLOOR AREA 'B'	●
E-2001C	POWER PLAN FIRST FLOOR AREAS 'C' & 'D'	●
E-2001D	POWER PLAN FIRST FLOOR ENGINEERING, MECHANICAL ROOM, AND BASEMENT	● ●
E-2002	POWER PLAN SECOND FLOOR	● ●
E-2003	POWER PLAN THIRD FLOOR	●
E-2004	POWER PLAN FOURTH FLOOR	●
E-2005	POWER PLAN FIFTH AND SIXTH FLOOR	● ● ●
E-3001A	LIGHTING PLAN FIRST FLOOR AREA 'A'	●
E-3001B	LIGHTING PLAN FIRST FLOOR AREA 'B'	●
E-3001C	LIGHTING PLAN FIRST FLOOR AREA 'C'	●
E-3001D	LIGHTING PLAN FIRST FLOOR ENGINEERING AND BASEMENT	●
E-3002	LIGHTING PLAN SECOND FLOOR	● ●
E-3003	LIGHTING PLAN THIRD FLOOR	● ●
E-3004	LIGHTING PLAN FOURTH FLOOR	● ●
E-3005	LIGHTING PLAN FIFTH AND SIXTH FLOOR	● ●
E-4000	SPECIAL SYSTEMS PLAN FIRST FLOOR AREA 'A'	●
E-4001A	SPECIAL SYSTEMS PLAN FIRST FLOOR AREA 'A'	●
E-4001B	SPECIAL SYSTEMS PLAN FIRST FLOOR AREA 'B'	●
E-4001C	SPECIAL SYSTEMS PLAN FIRST FLOOR AREAS 'C' & 'D'	●
E-4001D	SPECIAL SYSTEMS PLAN FIRST FLOOR ENGINEERING	●
E-4002	SPECIAL SYSTEMS PLAN SECOND FLOOR	●
E-4003	SPECIAL SYSTEMS PLAN THIRD FLOOR	●
E-4004	SPECIAL SYSTEMS PLAN FOURTH FLOOR	●
E-4005	SPECIAL SYSTEMS PLAN FIFTH AND SIXTH FLOOR	●
E-5001	ENLARGED CENTRAL PLANT AND MAIN ELECTRICAL ROOM PLANS	● ● ● ● ● ● ● ●
E-5001T	ENLARGED ELECTRICAL TEMP CHILLER PLAN	●
E-5002	ENLARGED MECHANICAL ROOM PLANS	● ●
E-5003	ENLARGED MECHANICAL AND PBX ROOMS	● ●
E-5004	ENLARGED I.E. AND ELECTRICAL ROOM PLANS	●
E-5005	ENLARGED EXISTING ELECTRICAL ROOM PLANS	●
E-5006	ENLARGED PATIENT AND ICU ELECTRICAL ROOMS	●

		ISSUE	DATE
		CD 100% Construction Issue	09-24-06
		Addendum #1 Issue	10-27-06
		AD #1 Issue	11-14-07
		AD #2 Issue	12-13-07
		AD #3 Issue	02-21-07
		PR #1 Issue	04-27-07
		PR #2 Issue	05-25-07
		AD #4 Issue	06-08-07
		PR #3 Issue	07-09-07
		AD #5 Issue	08-02-07
		PR #4 Issue	09-14-07
		PR #5 Issue	10-12-07
		PR #6 Issue	11-14-07
		PR #7 Issue	12-13-07
		PR #8 Issue	01-25-08
		PR #9 Issue	03-03-08

E-0000	ONE LINE DIAGRAM SYMBOLS & SCHEDULES (ERP #2 SHEET)	●
E-0001	EXISTING NORMAL POWER ONE-LINE DIAGRAM	● ● ● ● ● ● ● ●
E-0002	NEW NORMAL POWER ONE-LINE DIAGRAM	● ● ● ● ● ● ● ●
E-0003	EXISTING EMERGENCY POWER ONE-LINE DIAGRAM	● ● ● ● ● ● ● ●
E-0004	PARTIAL EXISTING & NEW EMERGENCY POWER ONE-LINE DIAGRAM	● ● ● ● ● ● ● ●
E-0005	HOSPITAL ELECTRICAL RISER DIAGRAM	● ● ● ●
E-0006	NEW EXPANSION ELECTRICAL RISER DIAGRAM	●
E-0007	NEW EXPANSION STACKING RISER DIAGRAM	●
E-0008	DOOR ACCESS RISER DIAGRAMS	●
E-7001	ELECTRICAL DETAILS	●
E-7002	ELECTRICAL DETAILS	●
E-7003	ELECTRICAL DETAILS	●
E-7004	ELECTRICAL DETAILS	● ●
E-6001	ELECTRICAL LIGHTING SCHEDULES	●
E-6002	ELECTRICAL LIGHTING SCHEDULES	●
E-6003	ELECTRICAL PANEL SCHEDULES	●
E-6004	ELECTRICAL PANEL SCHEDULES	●
E-6005	ELECTRICAL PANEL SCHEDULES	● ● ● ●
E-6006	ELECTRICAL PANEL SCHEDULES	● ●
E-6007	ELECTRICAL PANEL SCHEDULES	● ●
E-6008	ELECTRICAL PANEL SCHEDULES	● ● ● ●
E-6009	ELECTRICAL PANEL SCHEDULES	●
CM-0000	GENERAL INFORMATION COMMUNICATION	● ●
CM-1000	OVERALL SITE COMMUNICATIONS PLAN	●
CM-1100	OVERALL PLAN COMMUNICATIONS	●
CM-2001A	COMMUNICATION PLAN FIRST FLOOR AREA 'A'	●
CM-2001B	COMMUNICATION PLAN FIRST FLOOR AREA 'B'	●
CM-2001C	COMMUNICATION PLAN FIRST FLOOR AREAS 'C' & 'D'	●
CM-2001D	COMMUNICATION PLAN FIRST FLOOR ENGINEERING	●
CM-2002	COMMUNICATION PLAN SECOND FLOOR	●
CM-2003	COMMUNICATION PLAN THIRD FLOOR	●
CM-2004	COMMUNICATION PLAN FOURTH FLOOR	●
CM-2005	COMMUNICATION PLAN FIFTH FLOOR	●
CM-2006	COMMUNICATION PLAN SIXTH FLOOR	●
CM-3000	LOW VOLTAGE INFORMATION SHEET	●
CM-3001A	LOW VOLTAGE PLAN FIRST FLOOR AREA 'A'	● ●
CM-3001B	LOW VOLTAGE PLAN FIRST FLOOR AREA 'B'	●
CM-3001C	LOW VOLTAGE PLAN FIRST FLOOR AREAS 'C' & 'D'	●
CM-3001D	LOW VOLTAGE PLAN FIRST FLOOR ENGINEERING	●
CM-3002	LOW VOLTAGE PLAN SECOND FLOOR	● ●
CM-3003	LOW VOLTAGE PLAN THIRD FLOOR	● ●
CM-3004	LOW VOLTAGE PLAN FOURTH FLOOR	● ●
CM-3005	LOW VOLTAGE PLAN FIFTH FLOOR	● ●
CM-5001	ENLARGED COMMUNICATION ROOM PLAN AND ELEVATIONS	●
CM-5002	ENLARGED COMMUNICATION ROOM PLAN AND ELEVATIONS	●
CM-5003	ENLARGED COMMUNICATION ROOM PLAN AND ELEVATIONS	●
CM-5004	ENLARGED COMMUNICATION ROOM PLAN AND ELEVATIONS	●
CM-5005	ENLARGED COMMUNICATION ROOM PLAN AND ELEVATIONS	●
CM-5006	ENLARGED COMMUNICATION ROOM PLAN AND ELEVATIONS	●
CM-5007	ENLARGED COMMUNICATION ROOM PLAN AND ELEVATIONS	●
CM-5008	ENLARGED COMMUNICATION ROOM PLAN AND ELEVATIONS	●
CM-5009	ENLARGED COMMUNICATION ROOM PLAN AND ELEVATIONS	●
CM-6001	RISER DIAGRAM & DETAILS COMMUNICATION	●

		ISSUE	DATE
		CD 100% Construction Issue	09-24-06
		Addendum #1 Issue	10-27-06
		AD #1 Issue	11-14-07
		AD #2 Issue	12-13-07
		AD #3 Issue	02-21-07
		PR #1 Issue	04-27-07
		PR #2 Issue	05-25-07
		AD #4 Issue	06-08-07
		PR #3 Issue	07-09-07
		AD #5 Issue	08-02-07
		PR #4 Issue	09-14-07
		PR #5 Issue	10-12-07
		PR #6 Issue	11-14-07
		PR #7 Issue	12-13-07
		PR #8 Issue	01-25-08
		PR #9 Issue	03-03-08

PHILIPS CARDIAC AND MONITORING SYSTEMS

PAGE 1	INDEX	●
PAGE 2	2ND FLOOR TELEMETRY PLAN	●
PAGE 3	EQUIPMENT ELEVATIONS	●
PAGE 4	3RD FLOOR MONITORING PLAN	●
PAGE 5	EQUIPMENT ELEVATIONS	●
PAGE 6	4TH FLOOR TELEMETRY PLAN	●
PAGE 7	EQUIPMENT ELEVATIONS	●
PAGE 8	6TH FLOOR TELEMETRY PLAN	●
PAGE 9	EQUIPMENT ELEVATIONS	●
PAGE 10	WALL MOUNTING INSTRUCTIONS	●

PHILIPS NUCLEAR MEDICINE SYSTEM

C1	INDEX	●
A0	GENERAL NOTES	●
A1	EQUIPMENT PLAN	●

STORAGE SYSTEMS

SS-1	STORAGE SYSTEMS LAYOUT	●
SS-2	STORAGE SYSTEMS LAYOUT	●
SS-3	STORAGE SYSTEMS LAYOUT	●
SS-4	STORAGE SYSTEMS LAYOUT	●
SS-5	STORAGE SYSTEMS LAYOUT	●
SS-6	STORAGE SYSTEMS ELEVATIONS	●

TELEVISIONS

1	TELEVISION LAYOUT - FIRST FLOOR	●
2	TELEVISION LAYOUT - SECOND FLOOR	●
3	TELEVISION LAYOUT - THIRD FLOOR	●
4	TELEVISION LAYOUT - FOURTH FLOOR	●
5	TELEVISION LAYOUT - FIFTH FLOOR	●
6	LEGENDS, NOTES AND DETAILS	●

PNEUMATIC TUBE SYSTEMS

PT-1.00	MECHANICAL RISER DIAGRAM	●

PERKINS & WILL
10100 North Central Expressway, Suite 300
Dallas, Texas 75231, USA
214.283.8700 Fax: 214.283.8701
www.perkinswill.com

Medical Center of Aurora
South Campus
Private Room Expansion
Aurora, Colorado

HCA
Project # 306660001

in association with:

Civil
Martin Martin, Inc.
4251 Kipling Street
Wheat Ridge, CO 80033
T: 303.431.6100
F: 303.431.4028

Structrual
TRC International, Ltd.
5050 QUARUM DRIVE, SUITE 700
Dallas, TX 75254
T: 214.722.6452
F: 214.722.6552

MEP
CCRD Partners
3625 N. HALL STREET
SUITE 1300, LB 139
DALLAS, TX 75219
T: 214.521.1661
F: 214.521.1664

LANDSCAPE
Davis Partnership
2310 BLAKE STREET, SUITE 100
DENVER, CO 80205
T: 303.861.8555
F: 303.861.3027

STATE OF COLORADO
TRUBY J. [illegible]
23560
LICENSED ARCHITECT
3.03.08

Revisions

1	PR #12	09.14.07
2	PR #13	10.12.07
3	PR #18	11.14.07
4	PR #16	12.13.07
5	PR #12R	01.25.08
6	PR #21	03.03.08

NO.	ISSUE	DATE

Sheet Information

Date	08-24-2006
Job Number	142228.000
Drawn	LTS
Checked	DE
Approved	CG

Title

INDEX OF DRAWINGS

Sheet

G-0002

Issued for Permit & Construction

Copyright © 2005 PERKINS & WILL

Only highlighted or clouded revisions are approved on this review. All Previous commente apply.

CITY OF AURORA
BUILDING DIVISION
APPROVED AS NOTED
DATE APPROVED MAR 16 2009

Mar 11, 2008 - 2:46pm
P:\Dallas\142228 Med Ctr of Aurora - Red Tower Expan\CAD\SHEETS\G-0002-PR#21.dwg
kimbolt