City of Aurora
Building Codes Division
15151 E Alameda Pkwy
Aurora, CO 80012
(303) 739-7420

Notice

This material is subject to copyright protection pursuant to Federal Law: 17 United States Code Section 106.

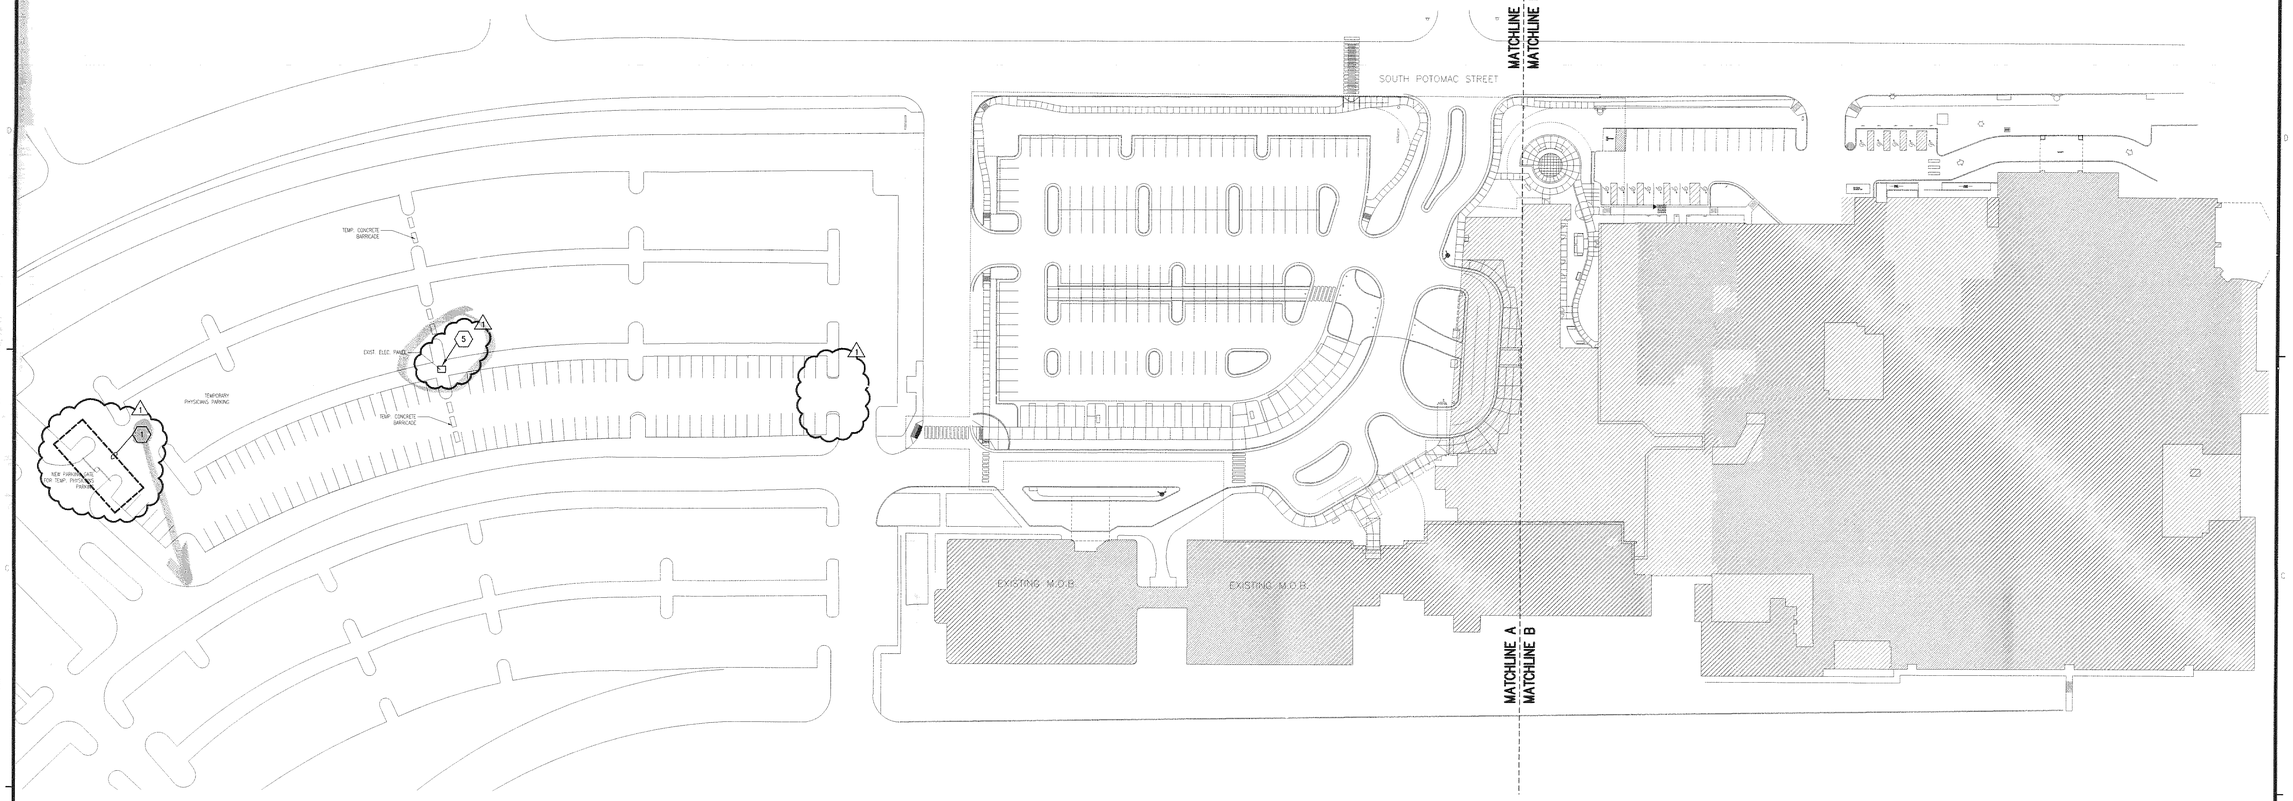

01 OVERALL SITE ELECTRICAL PLAN
SCALE: 1"=50'

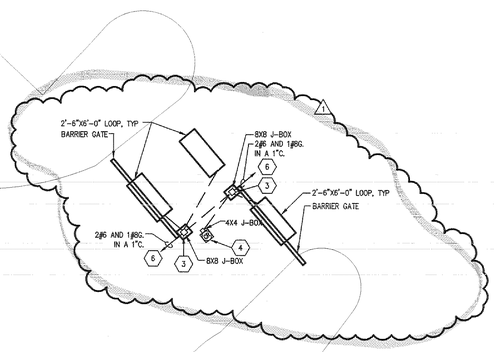

02 ENLARGED PARKING GATE
SCALE: 1/8" = 1'-0"

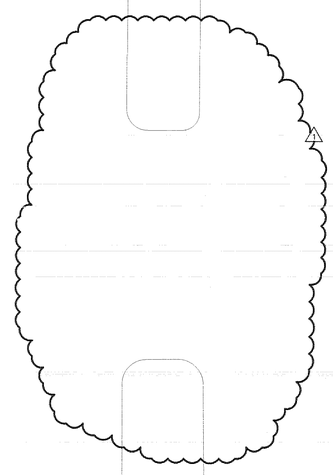

03 ENLARGED PARKING GATE
SCALE: 1/8" = 1'-0"

*ELECTRICAL INSTALLATIONS SHALL ALSO COMPLY WITH AURORA ZONING DEPT. APPROVED SITE PLAN PRIOR TO COMMENCEMENT

LEGEND NOTES

1. REFER TO 02/E-1000 FOR ENLARGED ELECTRICAL PLAN IN THIS AREA.
2. NOT USED.
3. PROVIDE WEATHER PROOF JUNCTION BOX FOR LOW POWER TO PARKING BARRIER GATE.
4. PROVIDE WEATHER PROOF JUNCTION BOX FOR TELECOMMUNICATIONS WIRING FOR PARKING GATE CONTROL. PROVIDE (1) 1" CONDUIT FOR TELECOMMUNICATIONS WIRING TO COMM ROOM 1090 IN BUILDING VIA SURVEY AS REQUIRED BY SECURITY VENDOR.
5. EXISTING SITE ELECTRICAL PANEL. CONTRACTOR TO VERIFY EXACT LOCATION.
6. CONNECT TO AN EXISTING 20/1 CIRCUIT BREAKER IN EXISTING SITE ELECTRICAL PANEL.

AURORA BUILDING INSPECTION
ELECTRICAL SECTION
APPROVED
SUBJECT TO COMMENTS AS NOTED
AND FIELD INSPECTIONS
Electrical only

CITY OF AURORA
BUILDING DIVISION
APPROVED AS NOTED 12-18-06
DATE Not Approved For Electrical Work Only

2006167815

PERKINS & WILL
6200 North Central Expressway
Dallas, Texas 75206 USA
214.775.6200 Fax: 214.775.6201
www.perkinswill.com

Medical Center of Aurora
South Campus
Private Room Expansion
Aurora, Colorado

HCA
Project # 306660001

In association with:

CIVIL
Martin Martin, INc.
4251 Kipling Street
Wheat Ridge, CO 80033
T: 303.431.6100
F: 303.431.4028

Structural
TRC International, Ltd.
5050 QUARUM DRIVE, SUITE 700
Dallas, TX 75254
T: 214.722.8452
F: 214.722.8552

MEP
CCRD Partners
3625 N. HALL STREET
SUITE 1300, LB 139
DALLAS, TX-75219
T: 214.521.1661
F: 214.521.1664

LANDSCAPE
Davis Partnership
2310 BLAKE STREET, SUITE 100
DENVER, CO 80205
T: 303.861.8555
F: 303.861.3027

AUGUST 24, 2006 - 100% CD'S ISSUED FOR PERMIT & CONSTRUCTION

COLORADO LICENSED 31031 PROFESSIONAL ENGINEER

Revisions		
1	ADDENDUM #2	10/31/06
NO.	ISSUE	DATE

Sheet Information	
Date	08-24-2006
Job Number	142228.000
Drawn	AL
Checked	AL
Approved	SG

Title
OVERALL SITE ELECTRICAL PLAN

Sheet
E-1000

Issued for Permit & Construction

Copyright © 2005 PERKINS & WILL

F:\2005 Projects\205555 Medical Center of Aurora Expansion\Drawings\Construction Documents\55SE-1000.dwg
Dan Seeley, ccrd partners
08/23/2006 - 3:36PM