
City of Aurora
Building Codes Division
15151 E Alameda Pkwy
Aurora, CO 80012
(303) 739-7420

# Notice

## This material is subject to copyright protection pursuant to Federal Law: 17 United States Code Section 106.

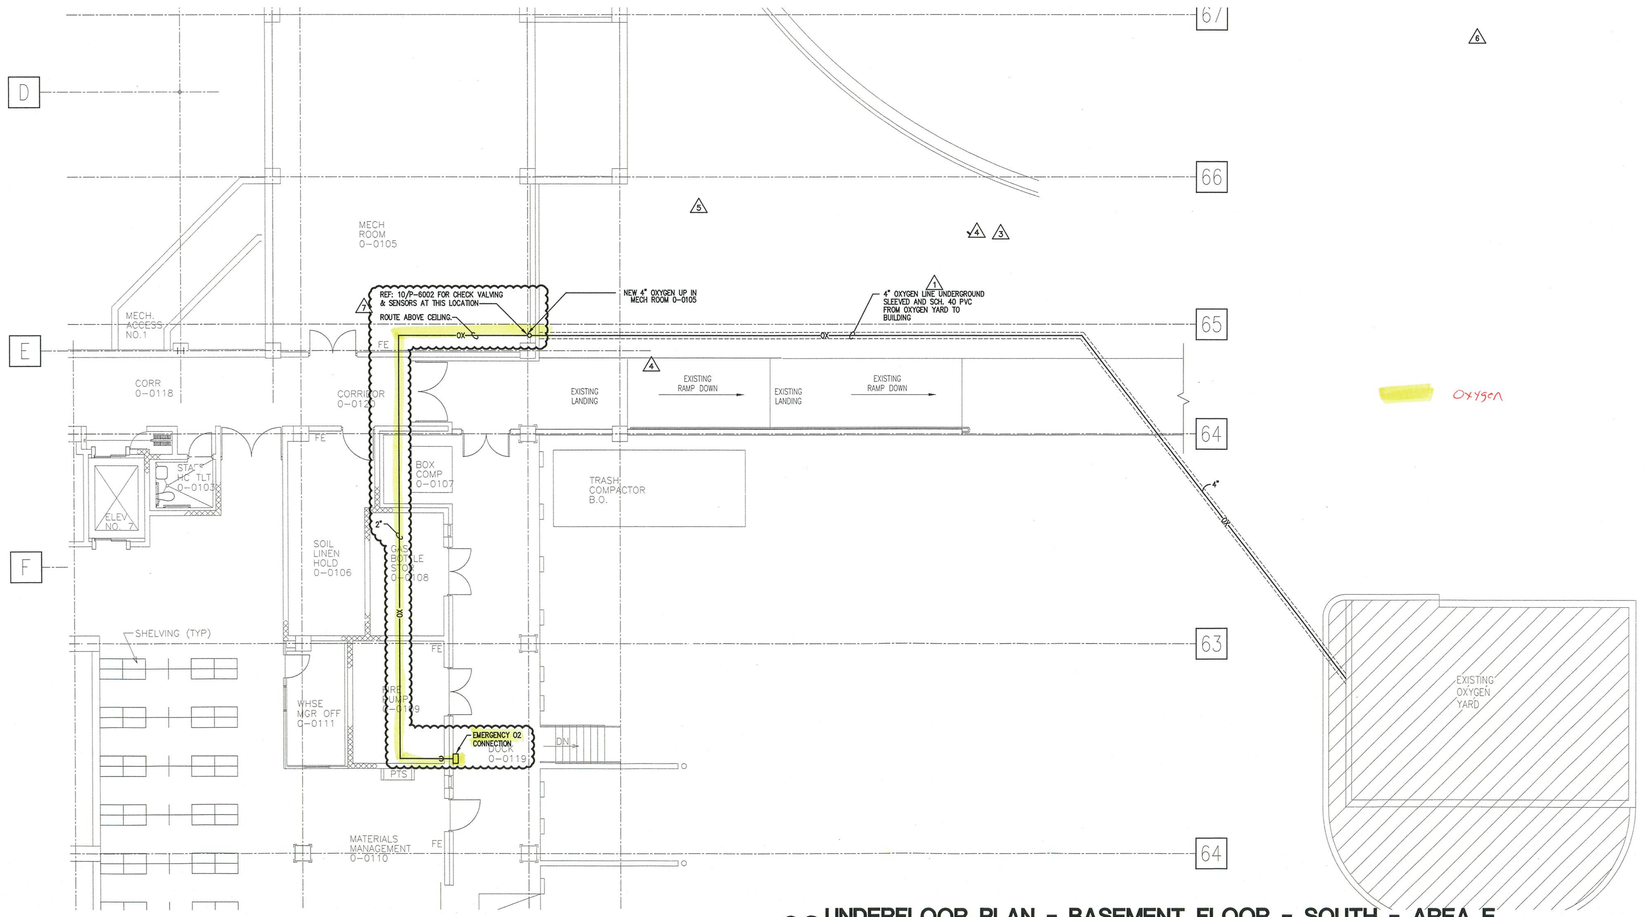


## 02 UNDERFLOOR PLAN - BASEMENT FLOOR - SOUTH - AREA E

SCALE: 1/8" = 1'-0"

Parent RSN # 453245

RSN # 453245

permit # 09 381877 LT

**Only highlighted or clouded revisions are approved on this review. All Previous comments apply.**

CITY OF AURORA
BUILDING DIVISION
APPROVED AS NOTED
DATE APPROVED FEB 13 2009
2006


**PERKINS & WILL**

6200 North Central Expressway
Dallas, Texas 75206 USA
214.775.6200 Fax: 214.775.6201
www.perkinswill.com


# Medical Center of Aurora

**South Campus**
**Private Room Expansion**
**Aurora, Colorado**

## HCA

**Project # 306660001**

**In association with:**

CIVIL
**Martin Martin, INc.**
4251 Kipling Street
Wheat Ridge, CO 80033
T: 303.431.6100
F: 303.431.4028


Structural
**TRC International, Ltd.**
5050 QUARUM DRIVE, SUITE 700
Dallas, TX 75254
T: 214.722.6452
F: 214.722.6552

MEP
**CCRD Partners**
3625 N. HALL STREET
SUITE 1300, LB 139
DALLAS, TX-75219
T: 214.521.1661
F: 214.521.1664

LANDSCAPE
**Davis Partnership**
2310 BLAKE STREET, SUITE 100
DENVER, CO 80205
T: 303.861.8555
F: 303.861.3027

**AUGUST 24, 2006 - 100% CD'S ISSUED FOR PERMIT & CONSTRUCTION**

## KEY PLAN
**FIRST FLOOR**

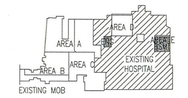


COLORADO LICENSED 31031 PROFESSIONAL ENGINEER
12/12/08

**Revisions**

| NO. | ISSUE | DATE |
|---|---|---|
| 2 | ADDENDUM #2 | 10/31/06 |
| 3 | PR #12 | 09/14/07 |
| 4 | PR #16 | 12/13/07 |
| 5 | PR #12R3 | 7/29/08 |
| 6 | PR #35 | 8/1/08 |
| 7 | PR #44 - | 12/12/08 |

**Sheet Information**

| | |
|---|---|
| Date | 08-24-2006 |
| Job Number | 142228.000 |
| Drawn | RR |
| Checked | TK |
| Approved | TK |

**Title**

UNDERFLOOR PLAN FIRST FLOOR ENGINEERING

**Sheet**

# P-1001D

**Issued for Permit & Construction**


Copyright © 2005 PERKINS & WILL


F:\2005 Projects\205555 Medical Center of Aurora Expansion\Drawings\Construction Documents\555P-1001D.dwg
ty Slotter, CCRD Partners 08/26/2008 - 4:29PM